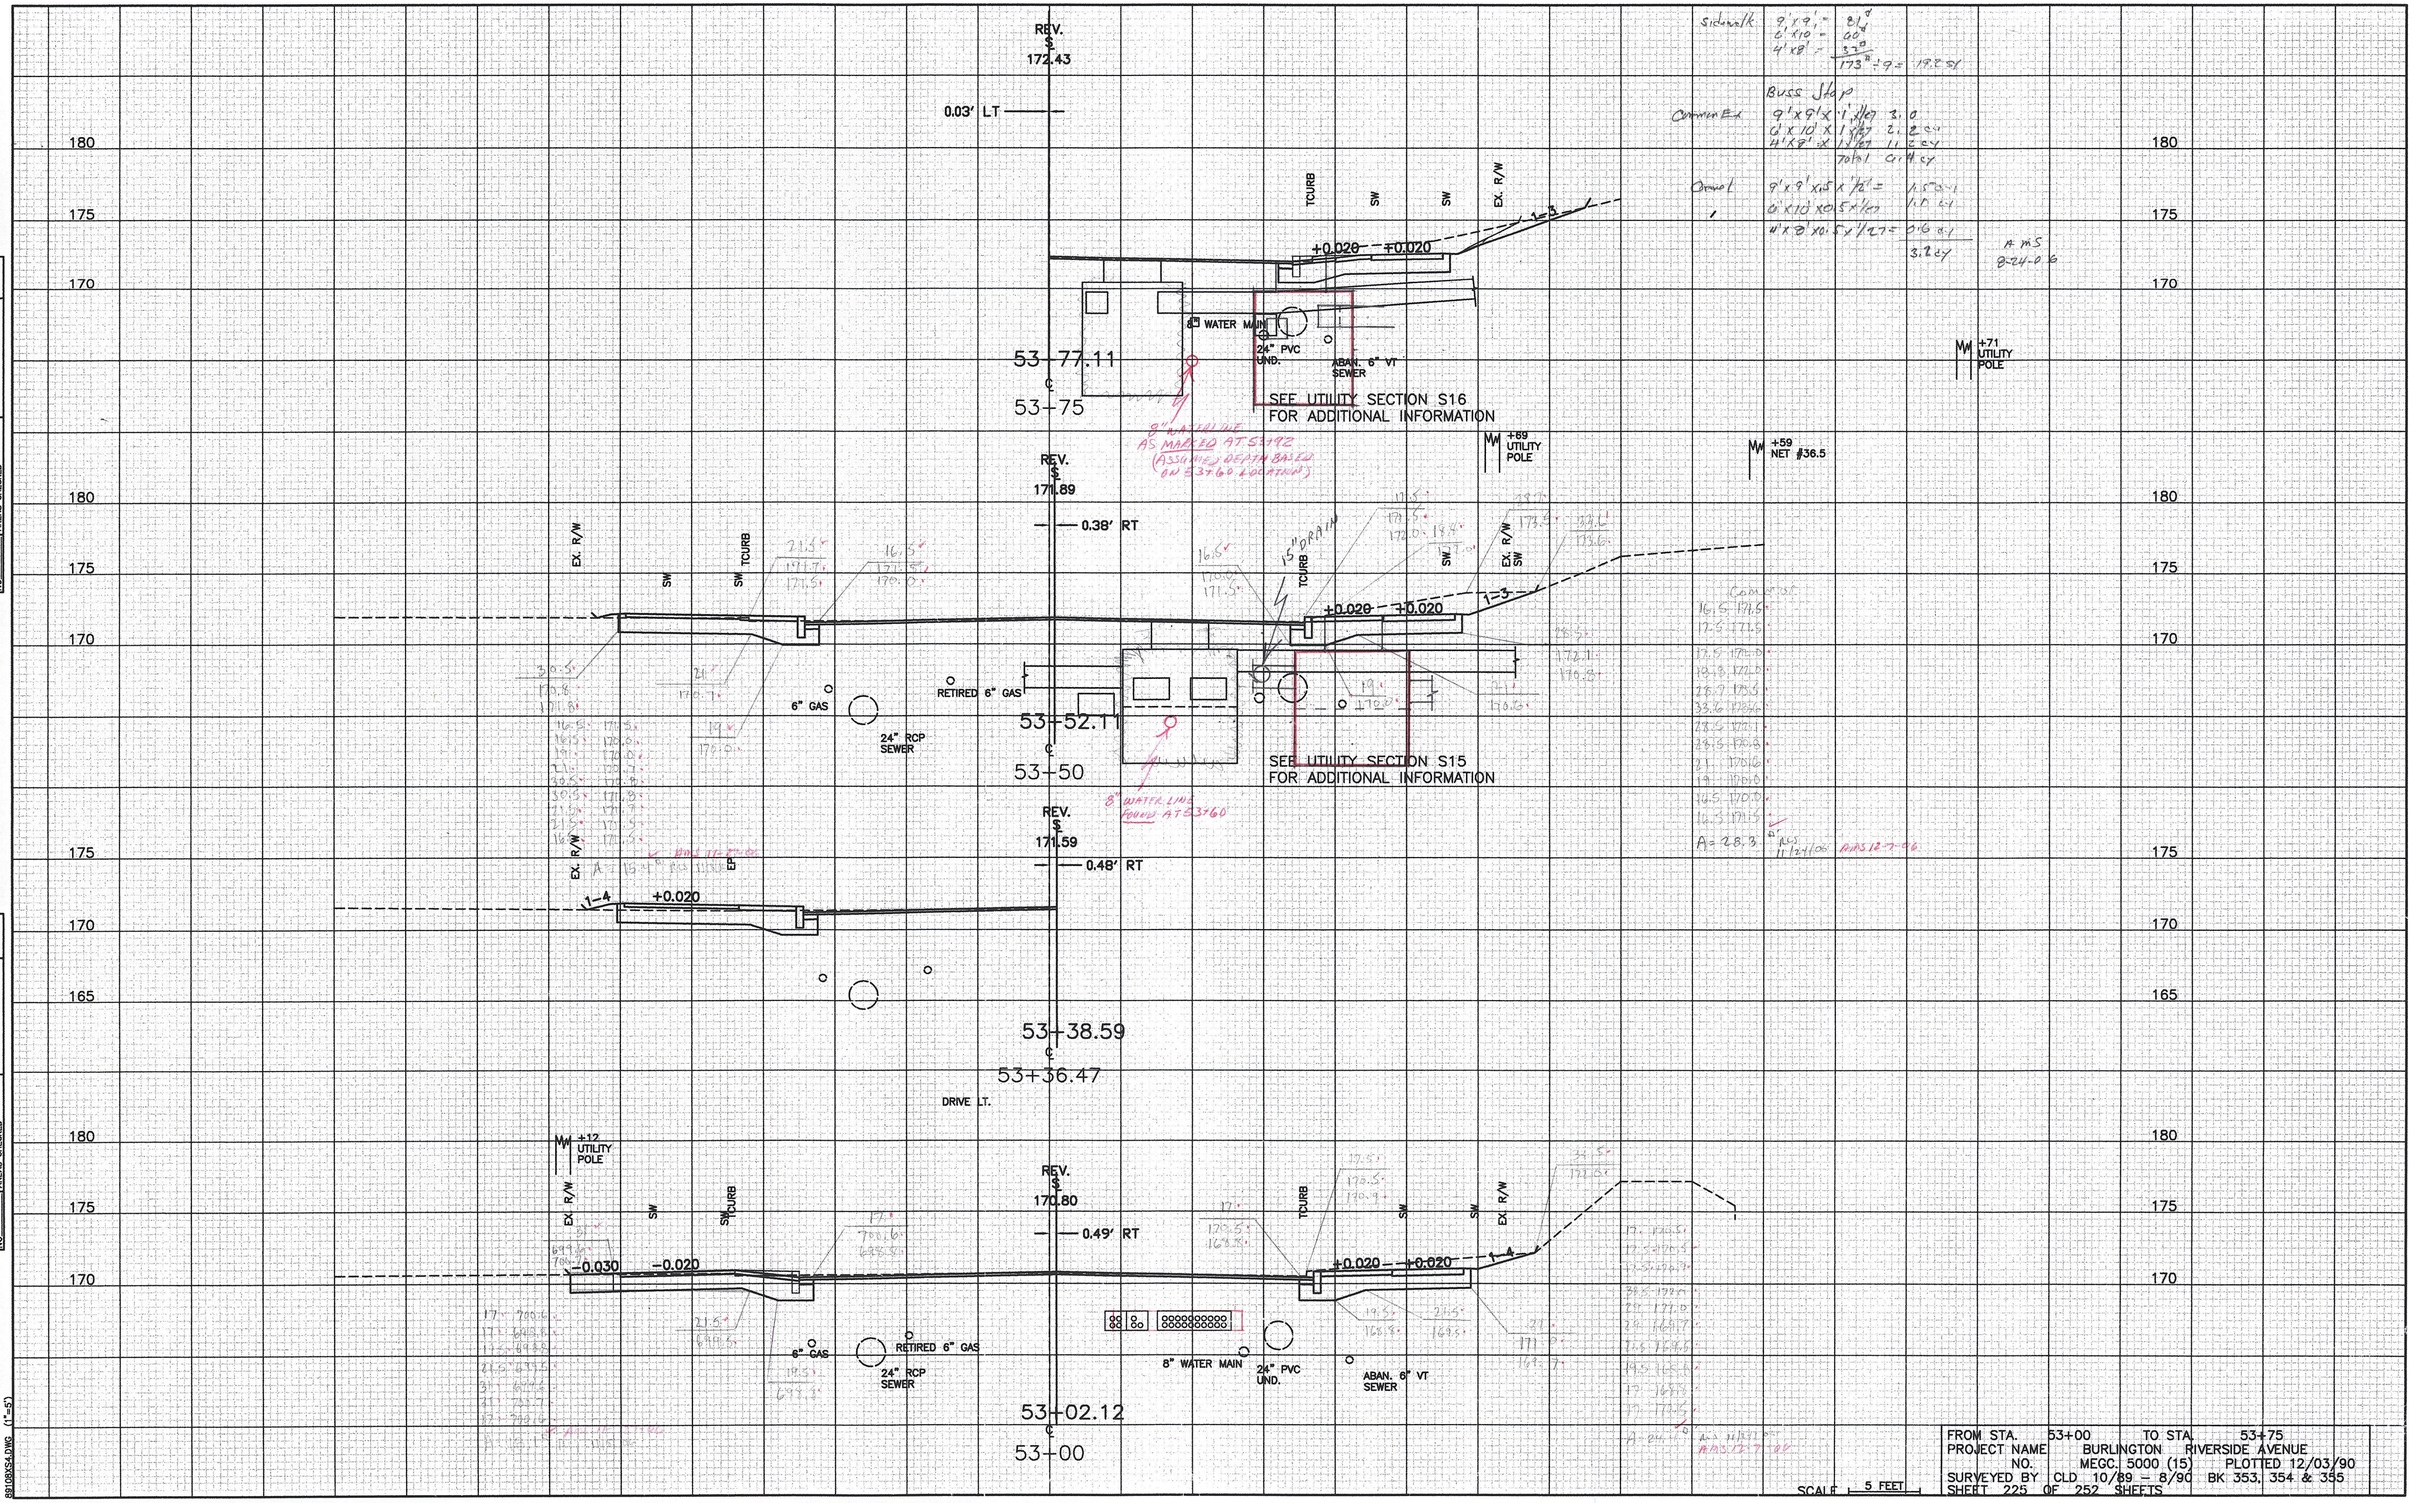

FROM STA. 53+00	TO STA. 53+75
PROJECT NAME BURLINGTON RIVERSIDE AVENUE	
NO. MEGC. 5000 (15)	PLOTTED 12/03/90
SURVEYED BY CLD 10/89 – 8/90	BK 353, 354 & 355
SHEET 225 OF 252 SHEETS	

FINAL SURVEY — SURVEYED, PLOTTED, TRIANGULATE, AREAS, AREAS CHECKED — NOTEBOOK — NO. — BY — DATE

ORIGINAL SURVEY — SURVEYED, PLOTTED, TRIANGULATE, AREAS, AREAS CHECKED — NOTEBOOK — NO. — BY — DATE

89108KS4.DWG (1"=5')