


DATE	
BY	
NO.	
FINAL SURVEY	
SURVEY	
PLOTTED	
TEMPLATE	
AREAS	
NOTED	
CHECKED	

DATE	
BY	
NO.	
ORIGINAL SURVEY	
SURVEY	
PLOTTED	
TEMPLATE	
AREAS	
NOTED	
CHECKED	

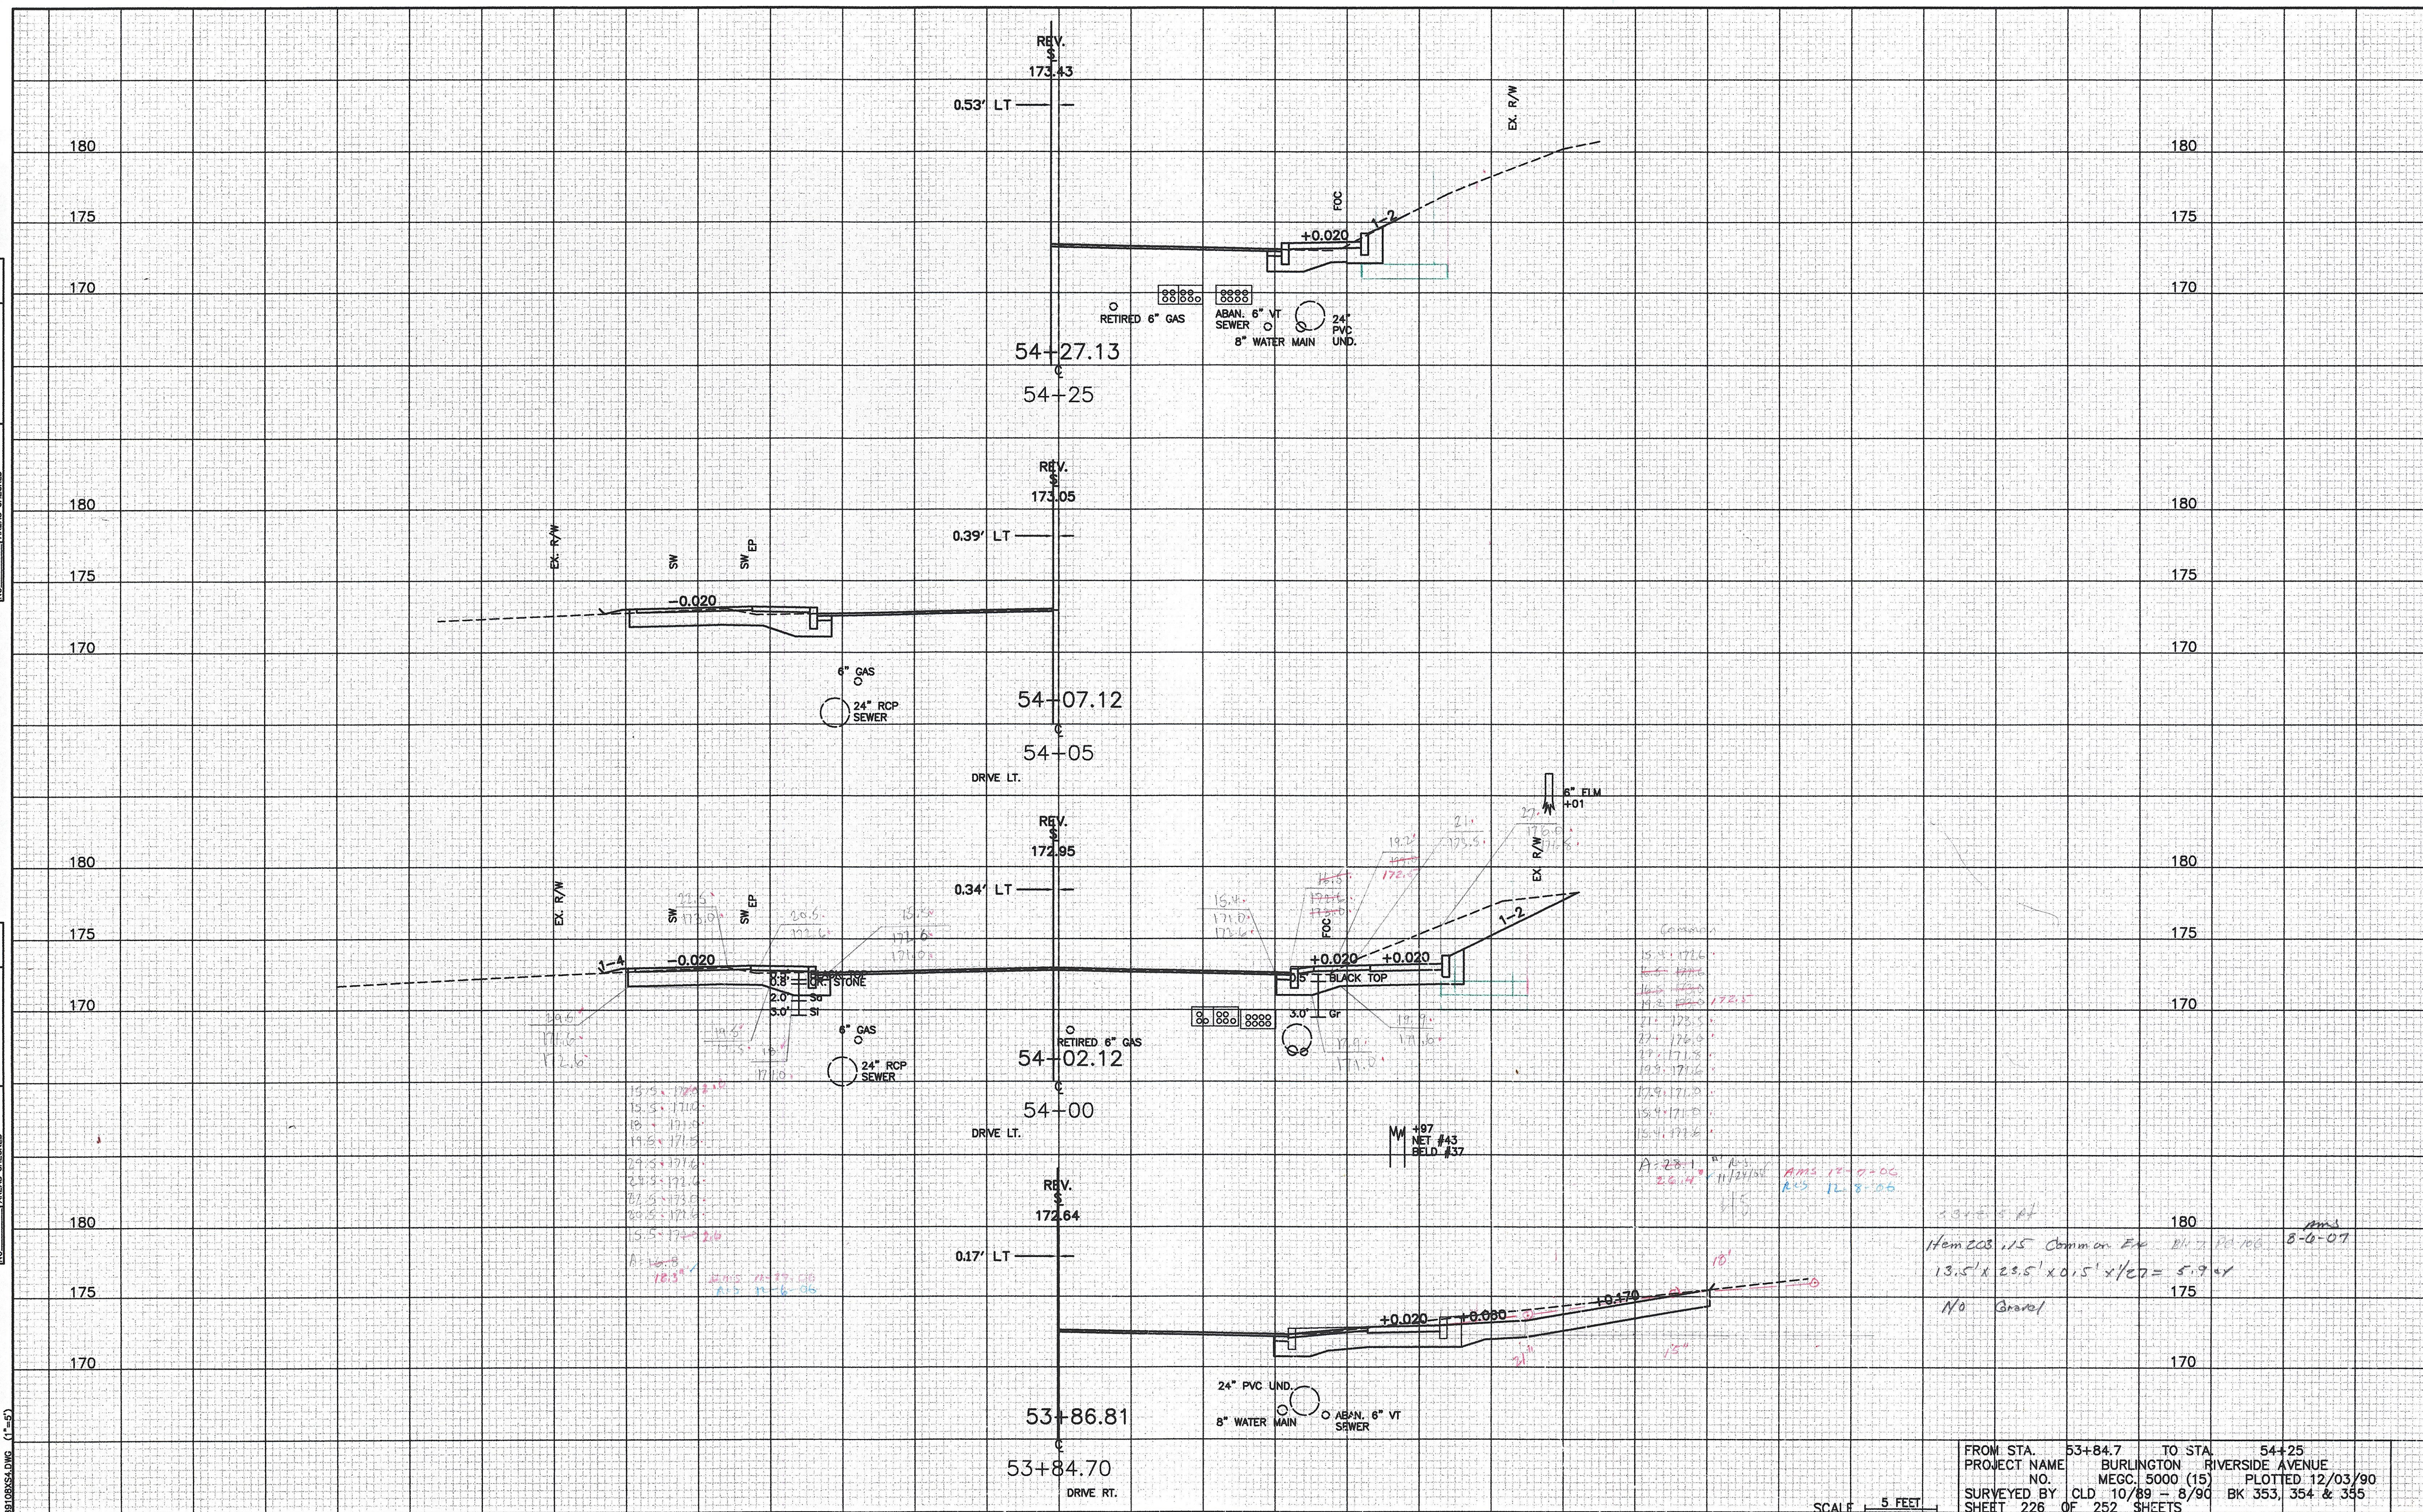

8910854.DWG (1-5)

FROM STA. 53+84.7 TO STA. 54+25
 PROJECT NAME BURLINGTON RIVERSIDE AVENUE
 NO. MEGC. 5000 (15) PLOTTED 12/03/90
 SURVEYED BY CLD 10/89 - 8/90 BK 353, 354 & 355
 SHEET 226 OF 252 SHEETS

SCALE 1" = 5 FEET

Common
 15.5' 172.6
 16.5' 172.6
13.5' x 29.5' x 0.15' x 1/2" = 5.9' x
 No Gravel