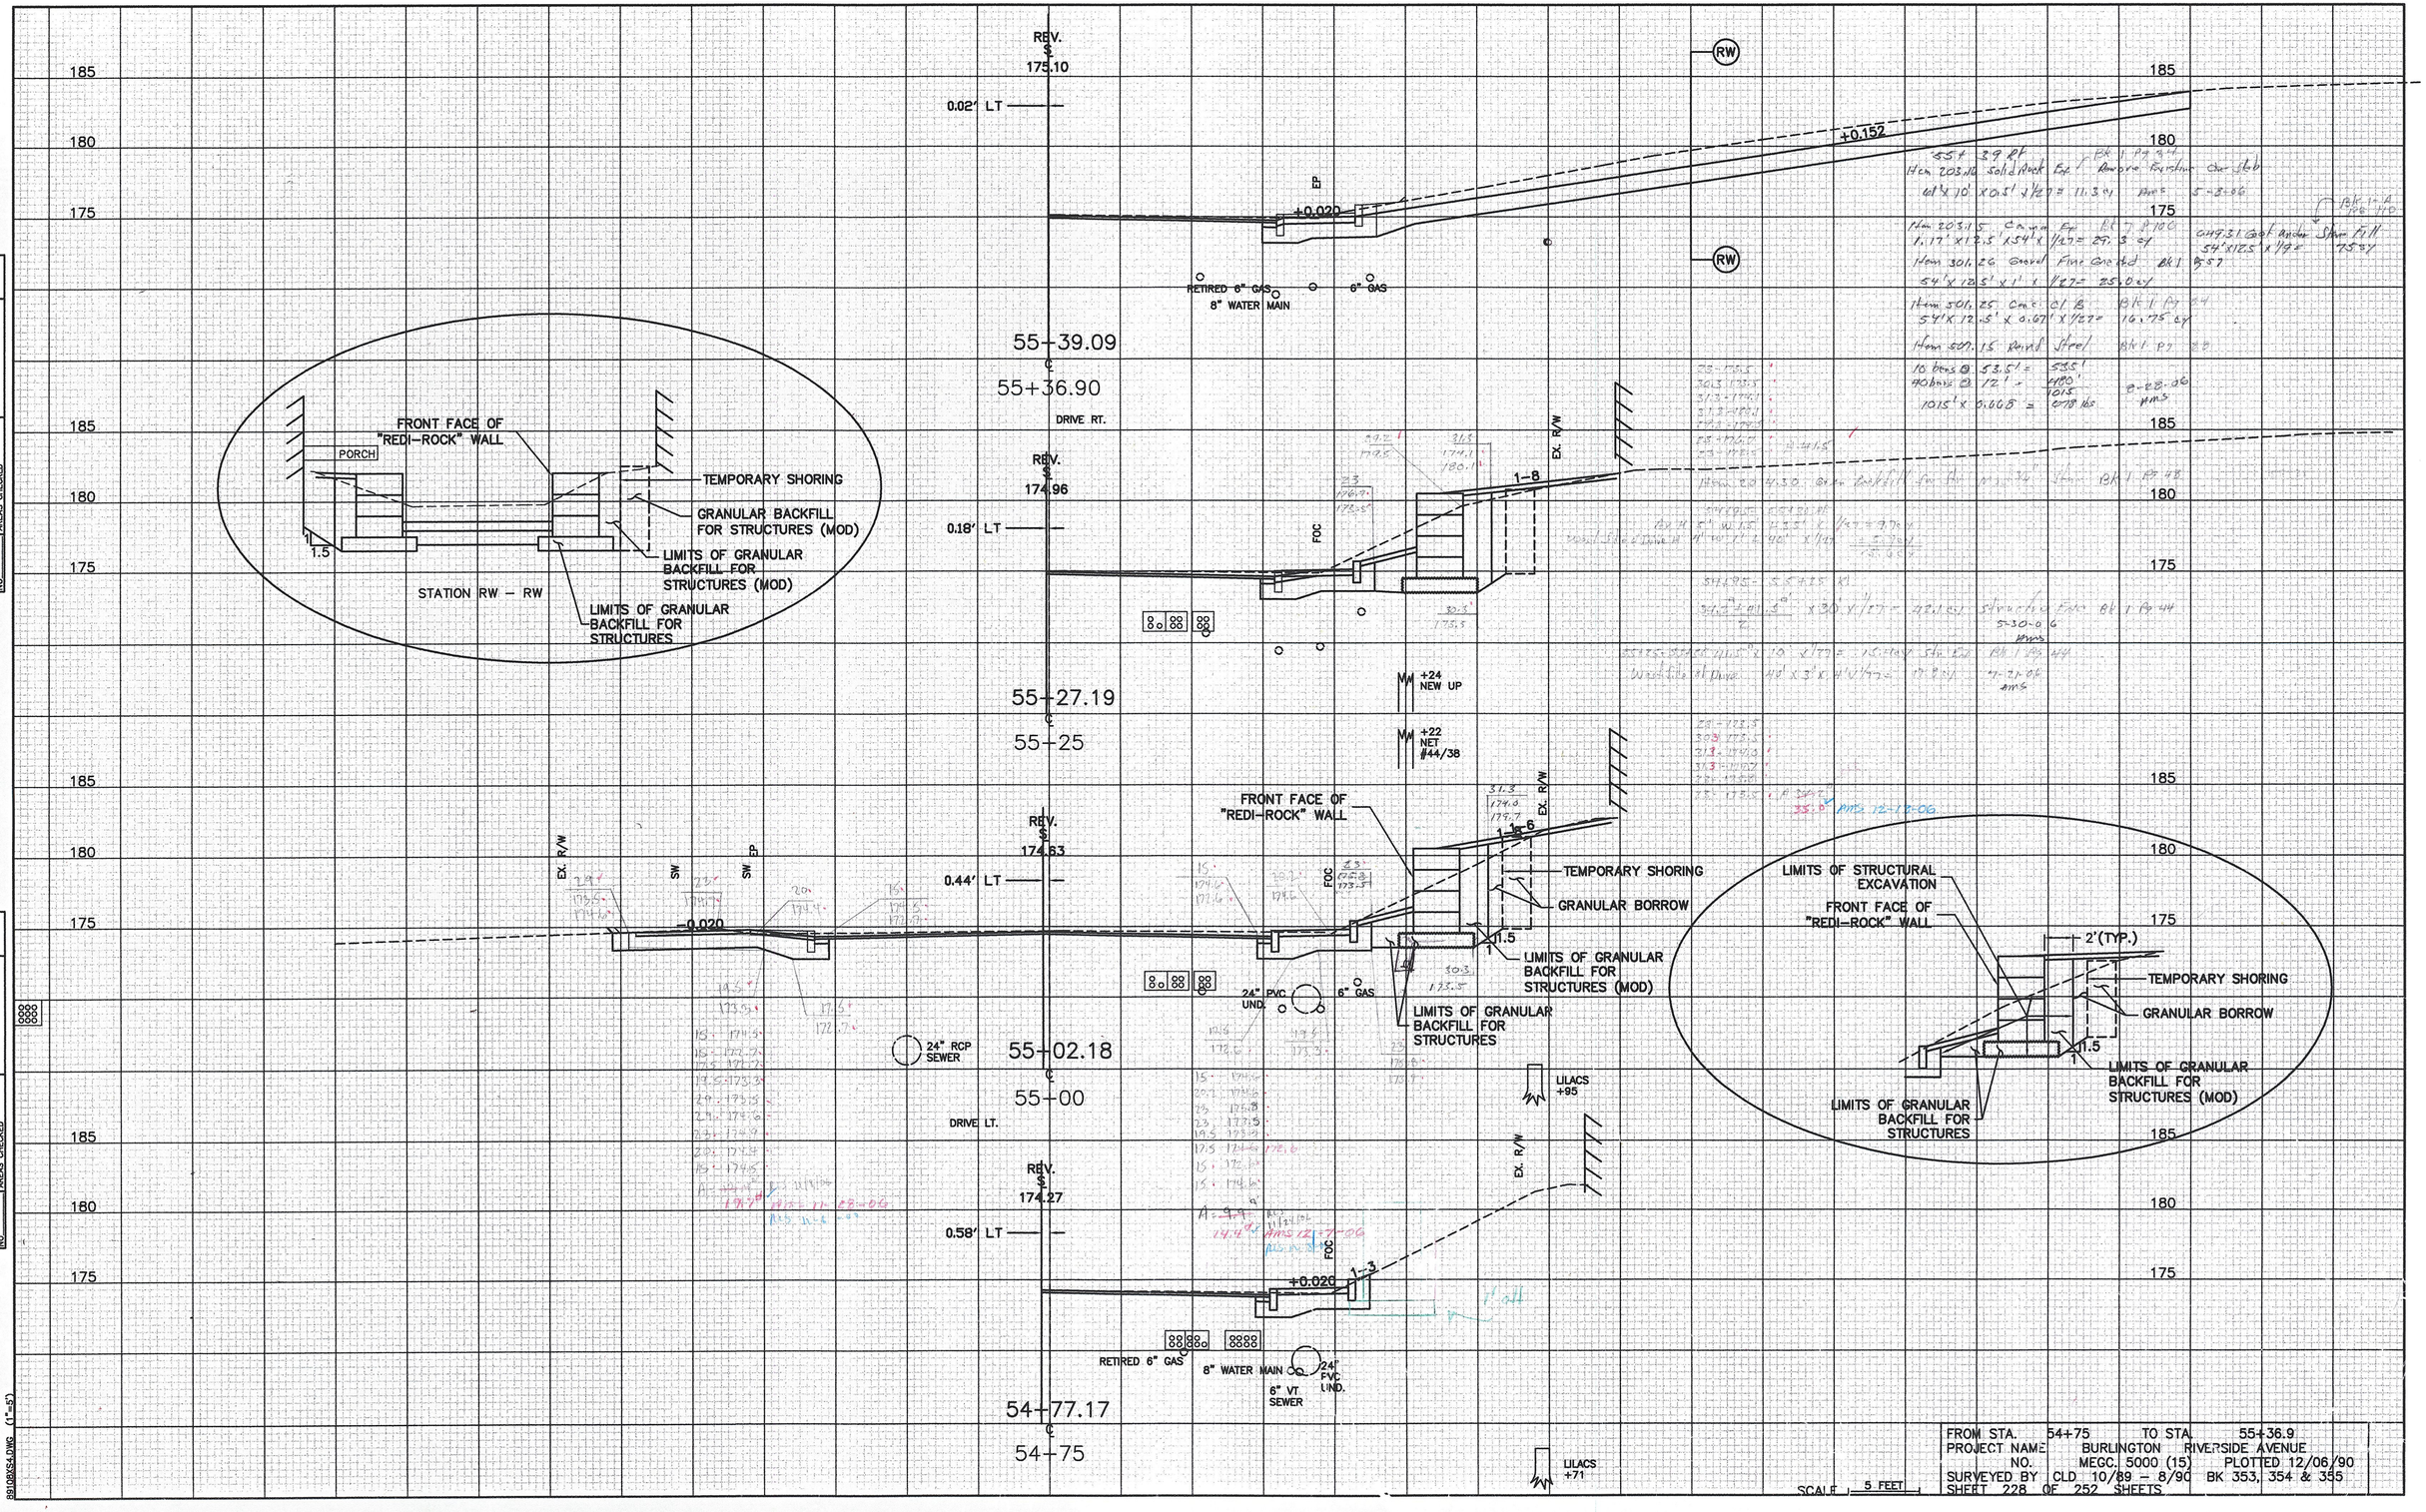
REV.
175.10
0.02' LT
+0.020
+0.152
EP
RW
RETIRED 6" GAS
8" WATER MAIN
6" GAS
55-39.09
55+36.90
DRIVE RT.
REV.
174.96
0.18' LT
FOC
1-8
EX. R/W
+24
NEW UP
+22
NET
#44/38
55-27.19
55-25
FRONT FACE OF
"REDI-ROCK" WALL
REV.
174.63
0.44' LT
-0.020
SW
TEMPORARY SHORING
GRANULAR BORROW
LIMITS OF GRANULAR
BACKFILL FOR
STRUCTURES (MOD)
LIMITS OF GRANULAR
BACKFILL FOR
STRUCTURES
24" PVC
UND.
6" GAS
24" RCP
SEWER
55-02.18
55-00
DRIVE LT.
LILACS
+95
REV.
174.27
0.58' LT
+0.020
RETIRED 6" GAS
8" WATER MAIN
24" PVC
UND.
6" VT
SEWER
54+77.17
54-75
LILACS
+71
LIMITS OF STRUCTURAL
EXCAVATION
FRONT FACE OF
"REDI-ROCK" WALL
2'(TYP.)
TEMPORARY SHORING
GRANULAR BORROW
LIMITS OF GRANULAR
BACKFILL FOR
STRUCTURES (MOD)
LIMITS OF GRANULAR
BACKFILL FOR
STRUCTURES
PORCH
FRONT FACE OF
"REDI-ROCK" WALL
TEMPORARY SHORING
GRANULAR BACKFILL
FOR STRUCTURES (MOD)
LIMITS OF GRANULAR
BACKFILL FOR
STRUCTURES (MOD)
LIMITS OF GRANULAR
BACKFILL FOR
STRUCTURES
STATION RW – RW
SCALE 5 FEET
FROM STA. 54+75 TO STA. 55+36.9
PROJECT NAME BURLINGTON RIVERSIDE AVENUE
NO. MEGC. 5000 (15) PLOTTED 12/06/90
SURVEYED BY CLD 10/89 – 8/90 BK 353, 354 & 355
SHEET 228 OF 252 SHEETS
FINAL SURVEY
ORIGINAL SURVEY
SURVEYED
PLOTTED
COMPUTED
AREAS
AREAS CHECKED
NOTEBOOK
NO.
DATE
BY
8910R2S4.DWG (1"=5')