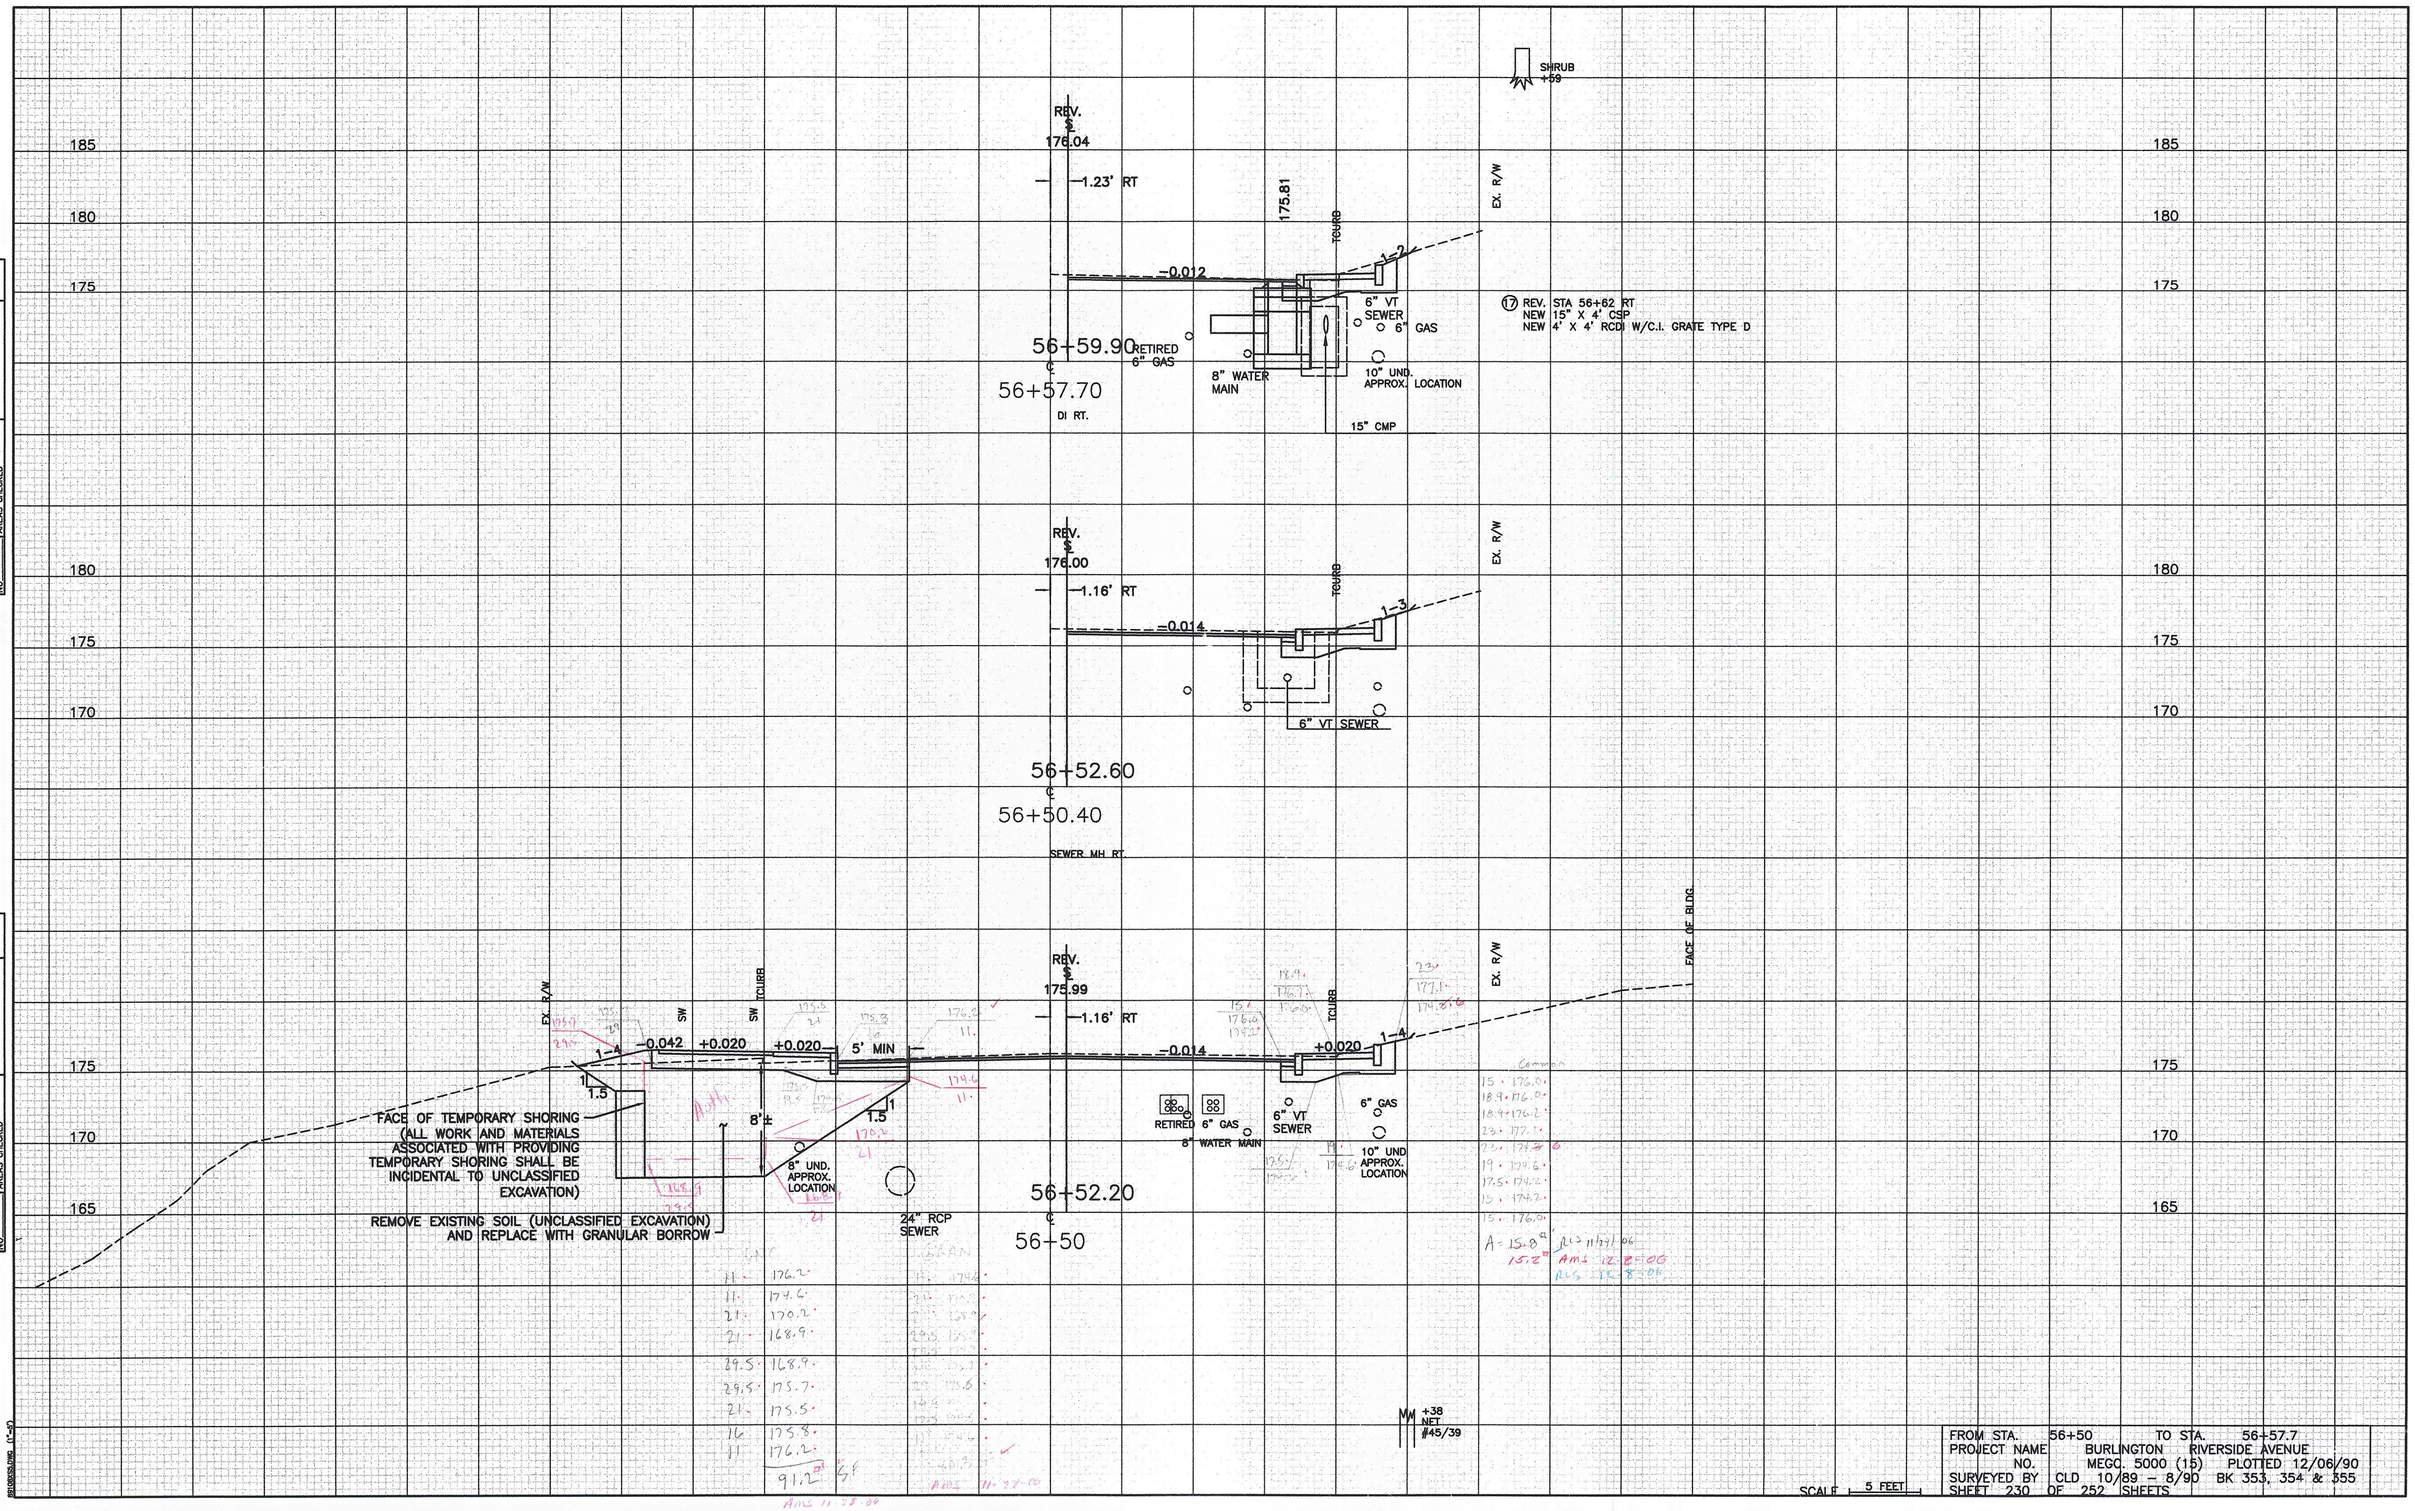


| FROM STA. 56+50 | TO STA. 56+57.7 | |
|---|---|---|
| PROJECT NAME | BURLINGTON RIVERSIDE AVENUE | |
| NO. | MEGC. 5000 (15) | PLOTTED 12/06/90 |
| SURVEYED BY | CLD 10/89 – 8/90 | BK 353, 354 & 355 |
| SHEET 230 OF 252 SHEETS | | |

| FINAL SURVEY | | BY | DATE |
|---|---|---|---|
| NOTEBOOK | SURVEYED | | |
| | PLOTTED | | |
| | TEMPLATE | | |
| | AREAS | | |
| NO. | AREAS CHECKED | | |

| ORIGINAL SURVEY | | BY | DATE |
|---|---|---|---|
| NOTEBOOK | SURVEYED | | |
| | PLOTTED | | |
| | TEMPLATE | | |
| | AREAS | | |
| NO. | AREAS CHECKED | | |

R8106SS.DWG (1"=5')