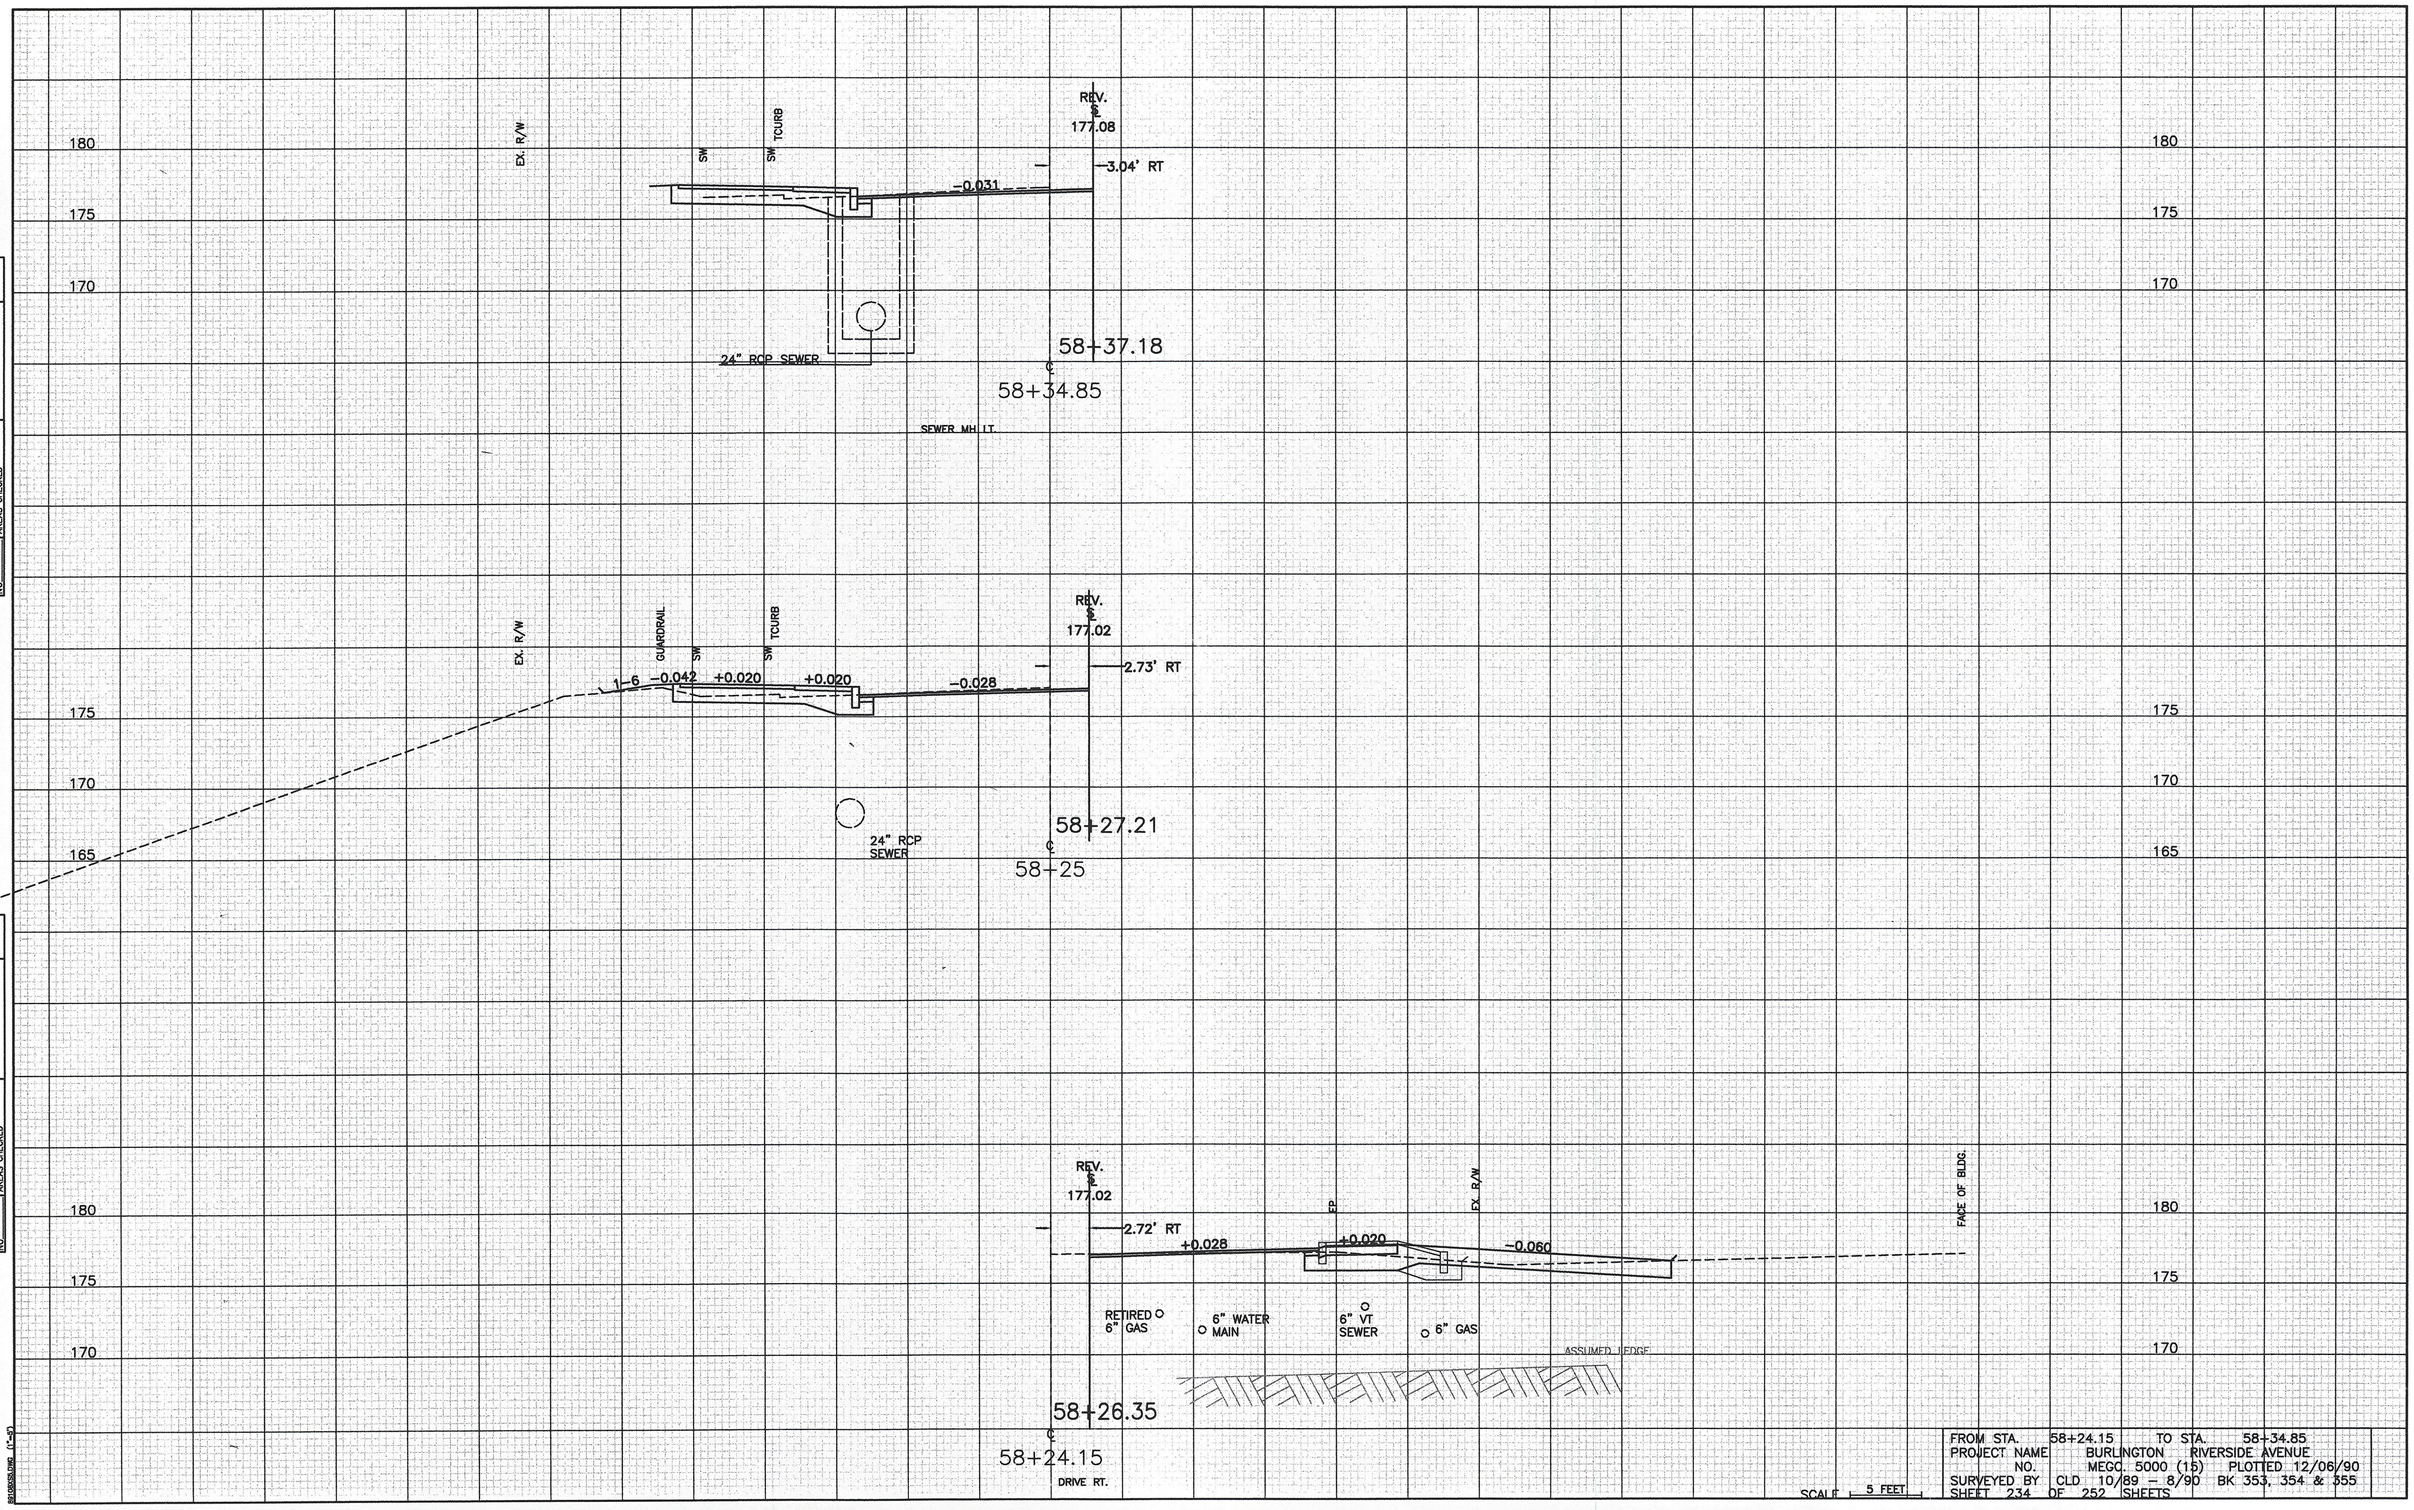

FROM STA. 58+24.15	TO STA. 58+34.85
PROJECT NAME	BURLINGTON RIVERSIDE AVENUE
NO.	MEGC. 5000 (15) PLOTTED 12/06/90
SURVEYED BY	CLD 10/89 – 8/90 BK 353, 354 & 355
SHEET 234 OF 252 SHEETS	

FINAL SURVEY		BY	DATE
NOTEBOOK	SURVEYED		
	PLOTTED		
	TRIMMED		
	AREAS		
NO	AREAS CHECKED		

ORIGINAL SURVEY		BY	DATE
NOTEBOOK	SURVEYED		
	PLOTTED		
	TRIMMED		
	AREAS		
NO	AREAS CHECKED		

B18585.DWG (1"=5')