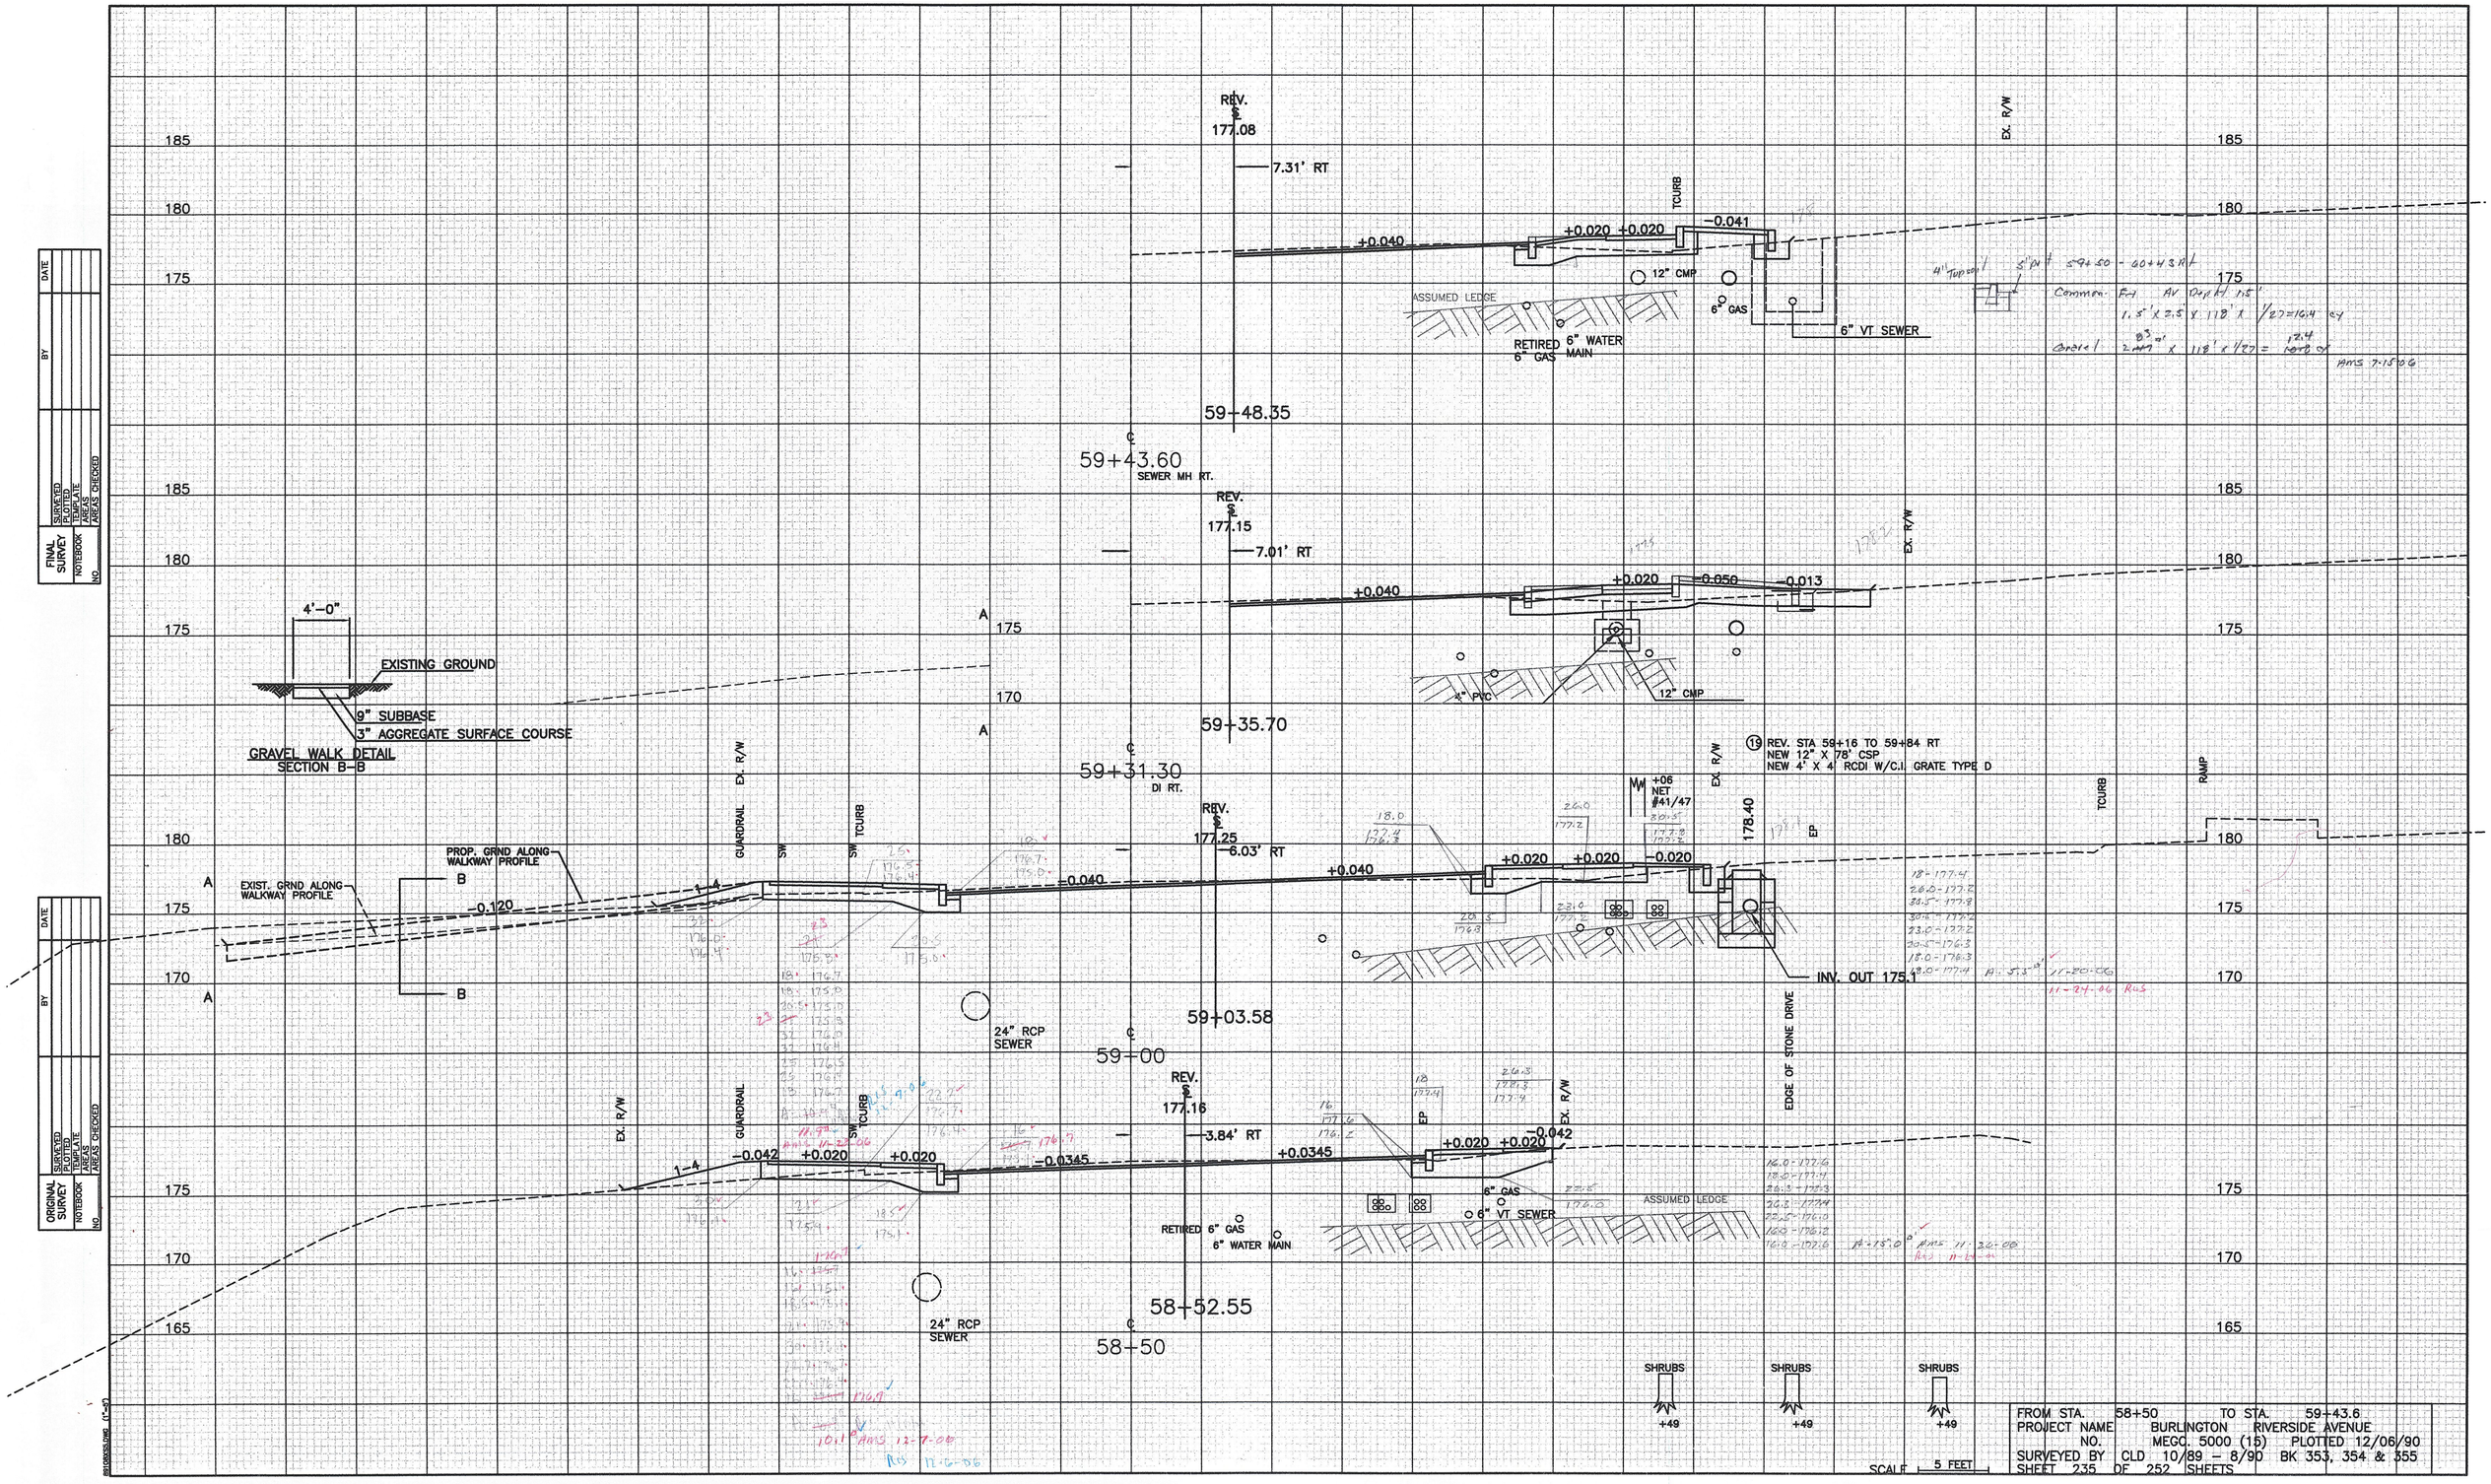
REV. @ 177.08
7.31' RT
+0.040
+0.020 +0.020
TCURB
-0.041
12" CMP
ASSUMED LEDGE
6" GAS
RETIRED 6" WATER
6" GAS MAIN
6" VT SEWER
EX. R/W
59+48.35
59+43.60
SEWER MH RT.
REV. @ 177.15
7.01' RT
+0.040
+0.020
-0.050
-0.013
4" PVC
12" CMP
4'-0"
EXISTING GROUND
9" SUBBASE
3" AGGREGATE SURFACE COURSE
GRAVEL WALK DETAIL
SECTION B-B
59+35.70
59+31.30
DI RT.
REV. @ 177.25
6.03' RT
GUARDRAIL
SW
SW TCURB
PROP. GRND ALONG WALKWAY PROFILE
EXIST. GRND ALONG WALKWAY PROFILE
-0.120
-0.040
+0.040
+0.020 +0.020
-0.020
+06 NET #41/47
178.40
EP
(19) REV. STA 59+16 TO 59+84 RT
NEW 12" X 78' CSP
NEW 4' X 4' RCDI W/C.I. GRATE TYPE D
TCURB
RAMP
INV. OUT 175.1
EDGE OF STONE DRIVE
24" RCP SEWER
59+03.58
59+00
REV. @ 177.16
3.84' RT
-0.042
+0.020
+0.020
-0.0345
+0.0345
+0.020 +0.020
-0.042
6" GAS
6" VT SEWER
ASSUMED LEDGE
RETIRED 6" GAS
6" WATER MAIN
24" RCP SEWER
58+52.55
58+50
SHRUBS
+49
SCALE 5 FEET
FROM STA. 58+50 TO STA. 59+43.6
PROJECT NAME BURLINGTON RIVERSIDE AVENUE
NO. MEGC. 5000 (15) PLOTTED 12/06/90
SURVEYED BY CLD 10/89 – 8/90 BK 353, 354 & 355
SHEET 235 OF 252 SHEETS
FINAL SURVEY
ORIGINAL SURVEY
NOTEBOOK
NO.
SURVEYED
PLOTTED
TRIANGULATE
AREAS
AREAS CHECKED
BY
DATE