21' x 0.04 = +0.84
7" CURB = +0.58
10' x 0.02 = +0.20
7" CURB = +0.58
18.5' x 0.041 = -0.55

59+77 45' RT
FINISHED GROUND
+1.65 ABOVE ℄

179.5
178.0
1.5

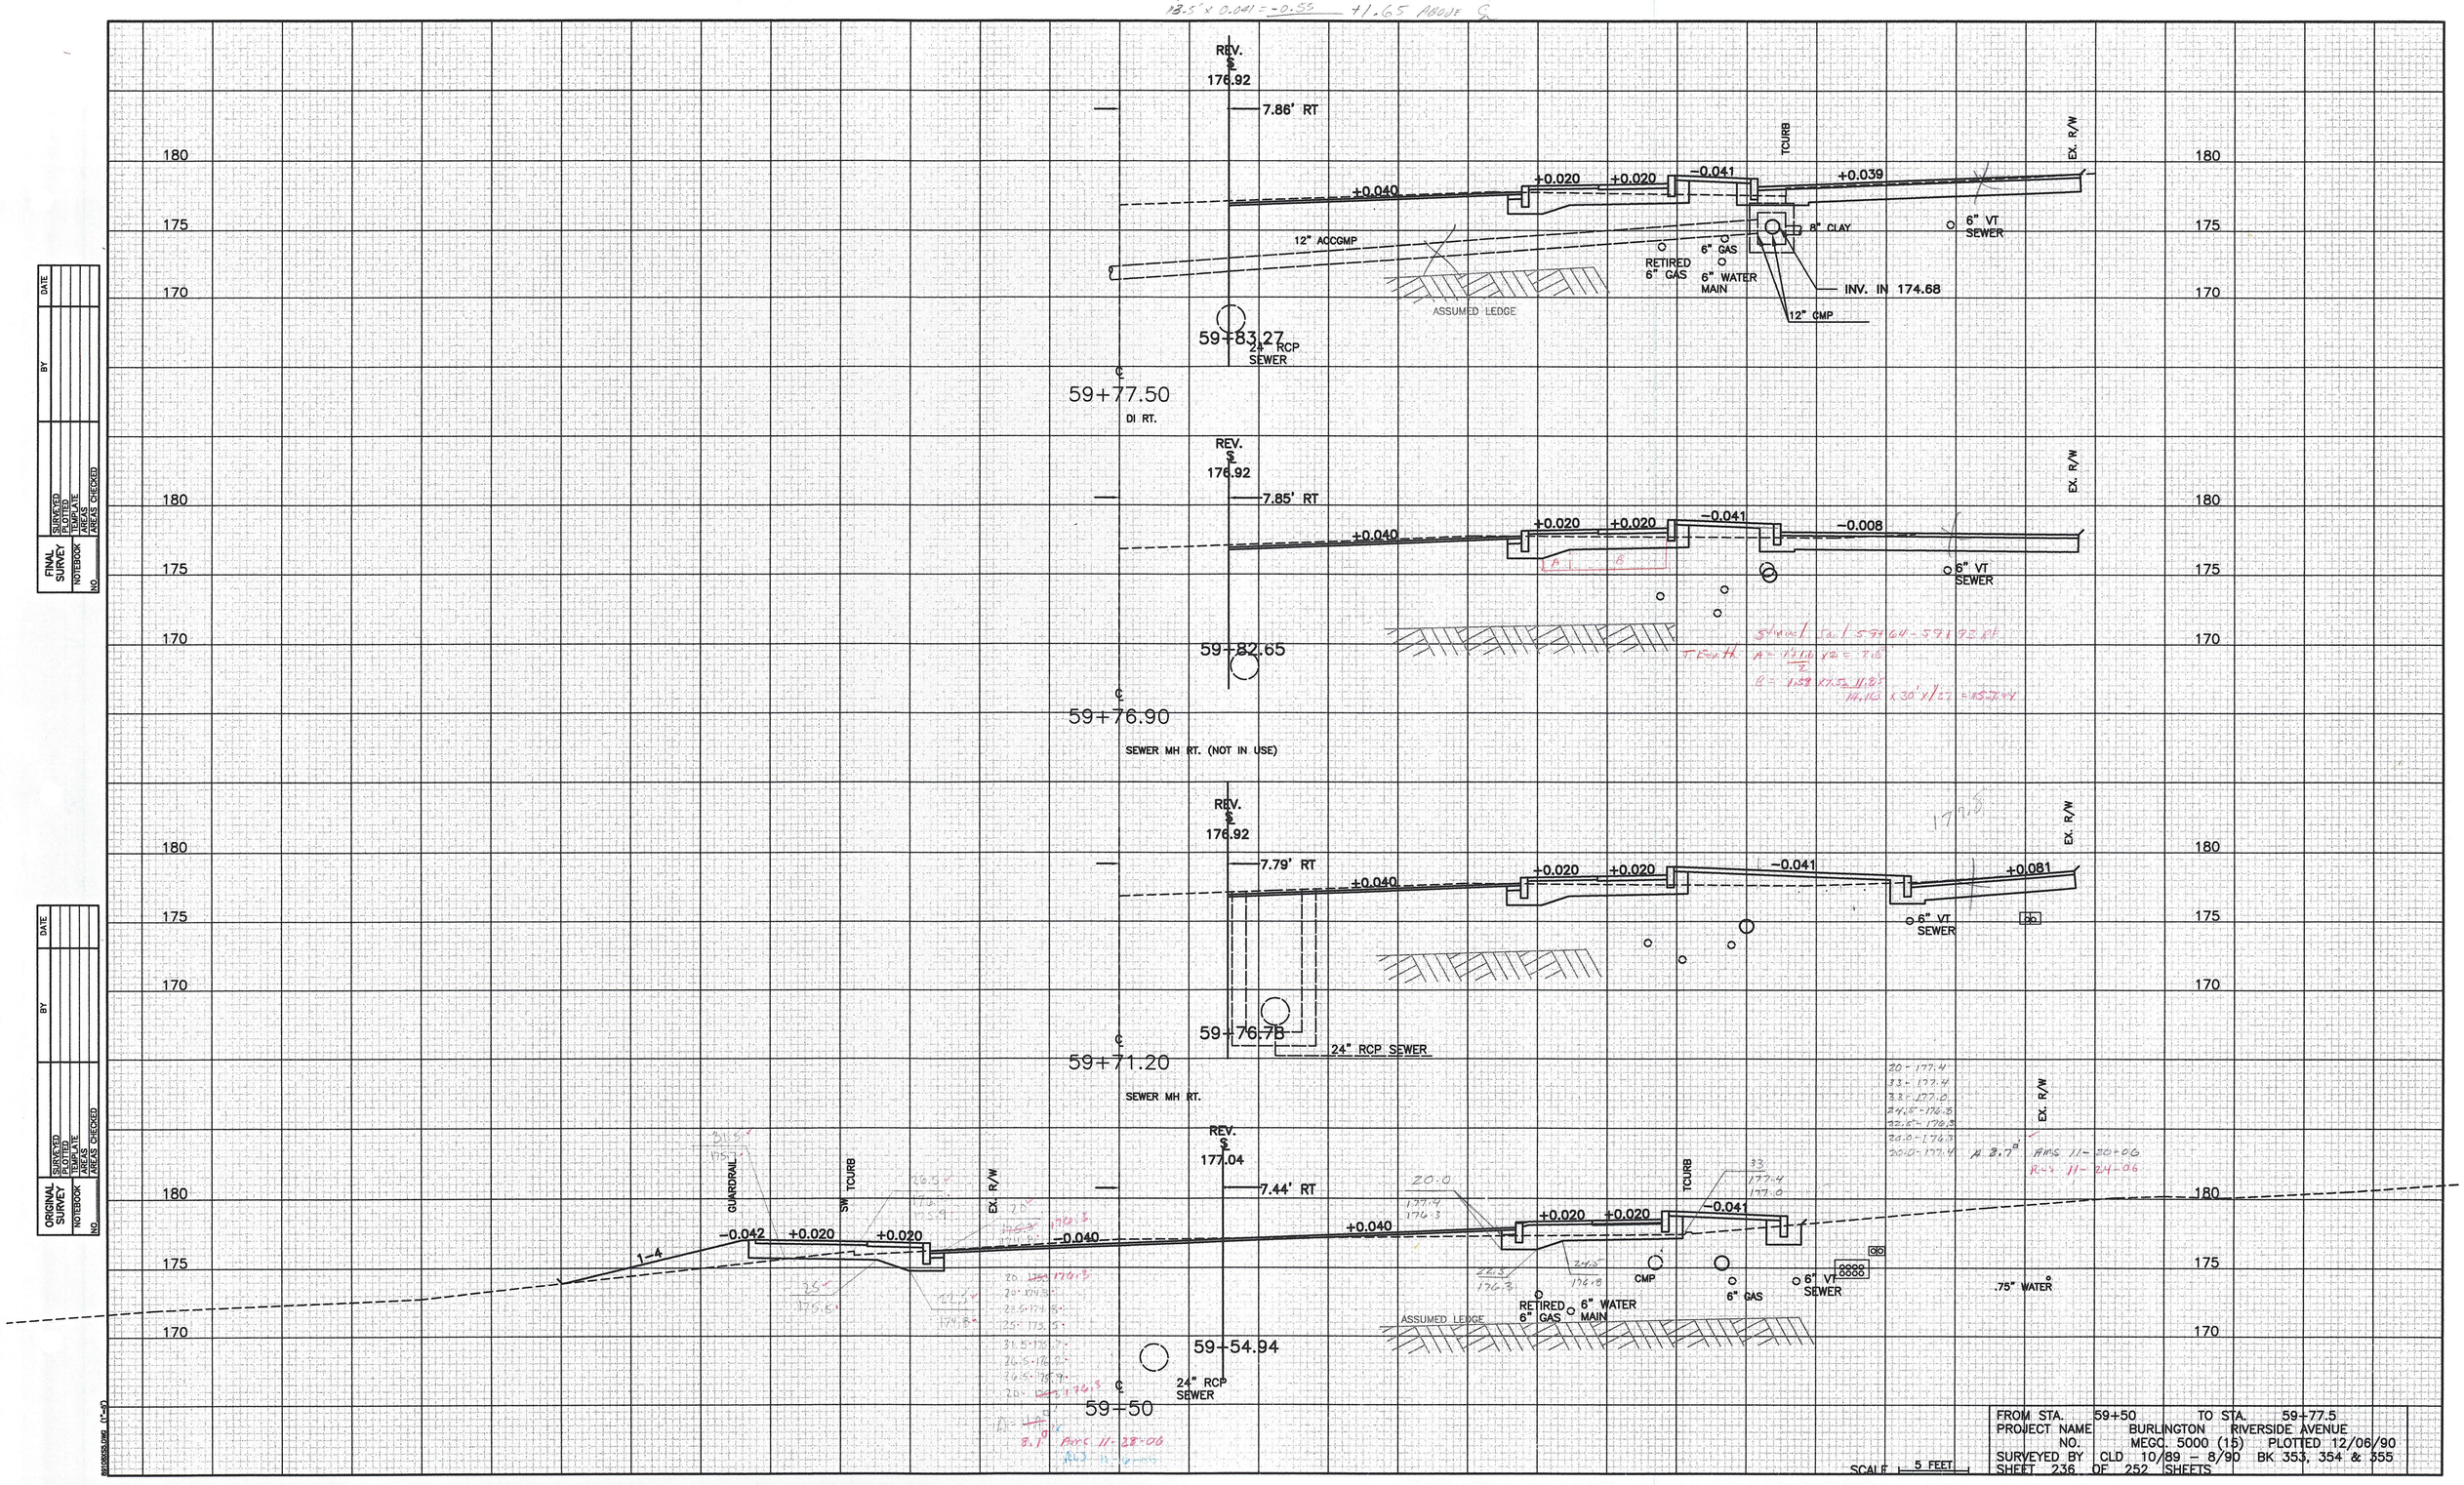

FINAL SURVEY				
NOTEBOOK	SURVEYED		BY	DATE
	PLOTTED			
	TEMPLATE			
	AREAS			
NO.	AREAS CHECKED			

ORIGINAL SURVEY				
NOTEBOOK	SURVEYED		BY	DATE
	PLOTTED			
	TEMPLATE			
	AREAS			
NO.	AREAS CHECKED			

FROM STA. 59+50 TO STA. 59+77.5
PROJECT NAME BURLINGTON RIVERSIDE AVENUE
NO. MEGC. 5000 (15) PLOTTED 12/06/90
SURVEYED BY CLD 10/89 – 8/90 BK 353, 354 & 355
SHEET 236 OF 252 SHEETS

SCALE 5 FEET