


DATE	
BY	
FINAL SURVEY PLOTTED	
NOTES	
AREAS CHECKED	
NO.	

DATE	
BY	
ORIGINAL SURVEY PLOTTED	
NOTES	
AREAS CHECKED	
NO.	

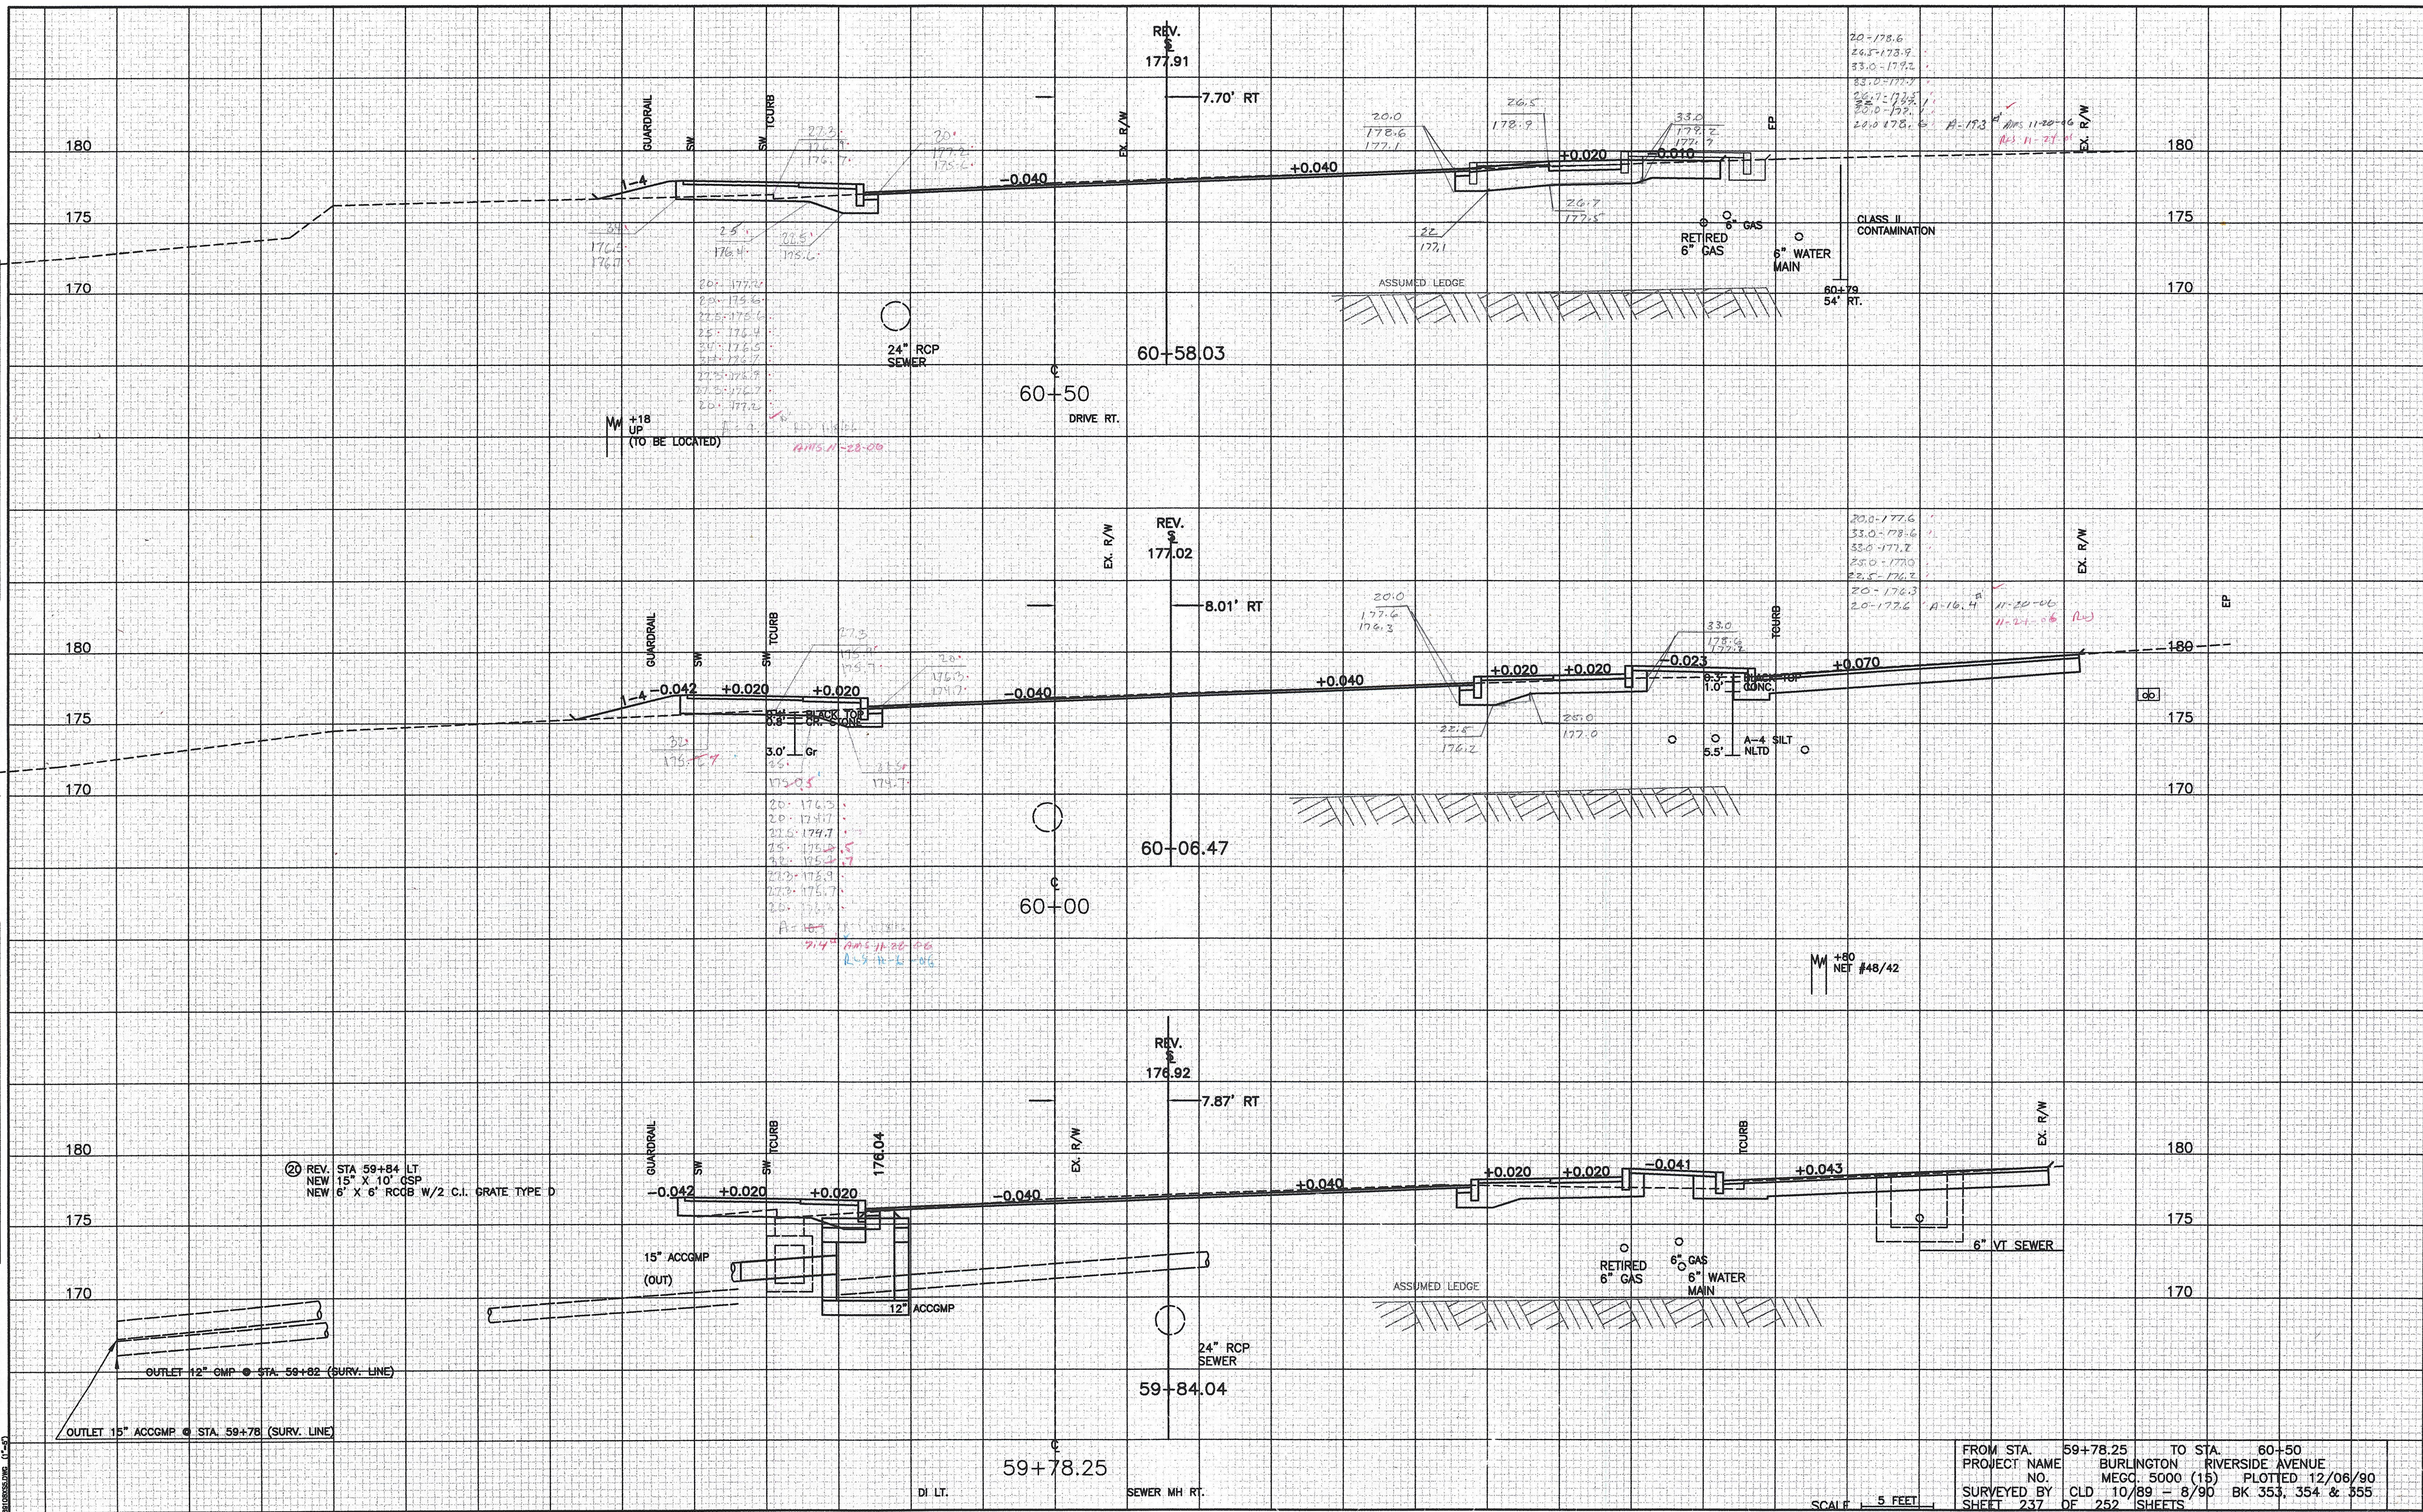

20 REV. STA 59+84 LT  
 NEW 15" X 10" GSP  
 NEW 6" X 6" RCBG W/2 C.I. GRATE TYPE D

FROM STA. 59+78.25 TO STA. 60+50  
 PROJECT NAME BURLINGTON RIVERSIDE AVENUE  
 NO. MEGG. 5000 (15)  
 SURVEYED BY CLD 10/89 - 8/90 BK 353, 354 & 355  
 SHEET 237 OF 252 SHEETS

SCALE 5 FEET