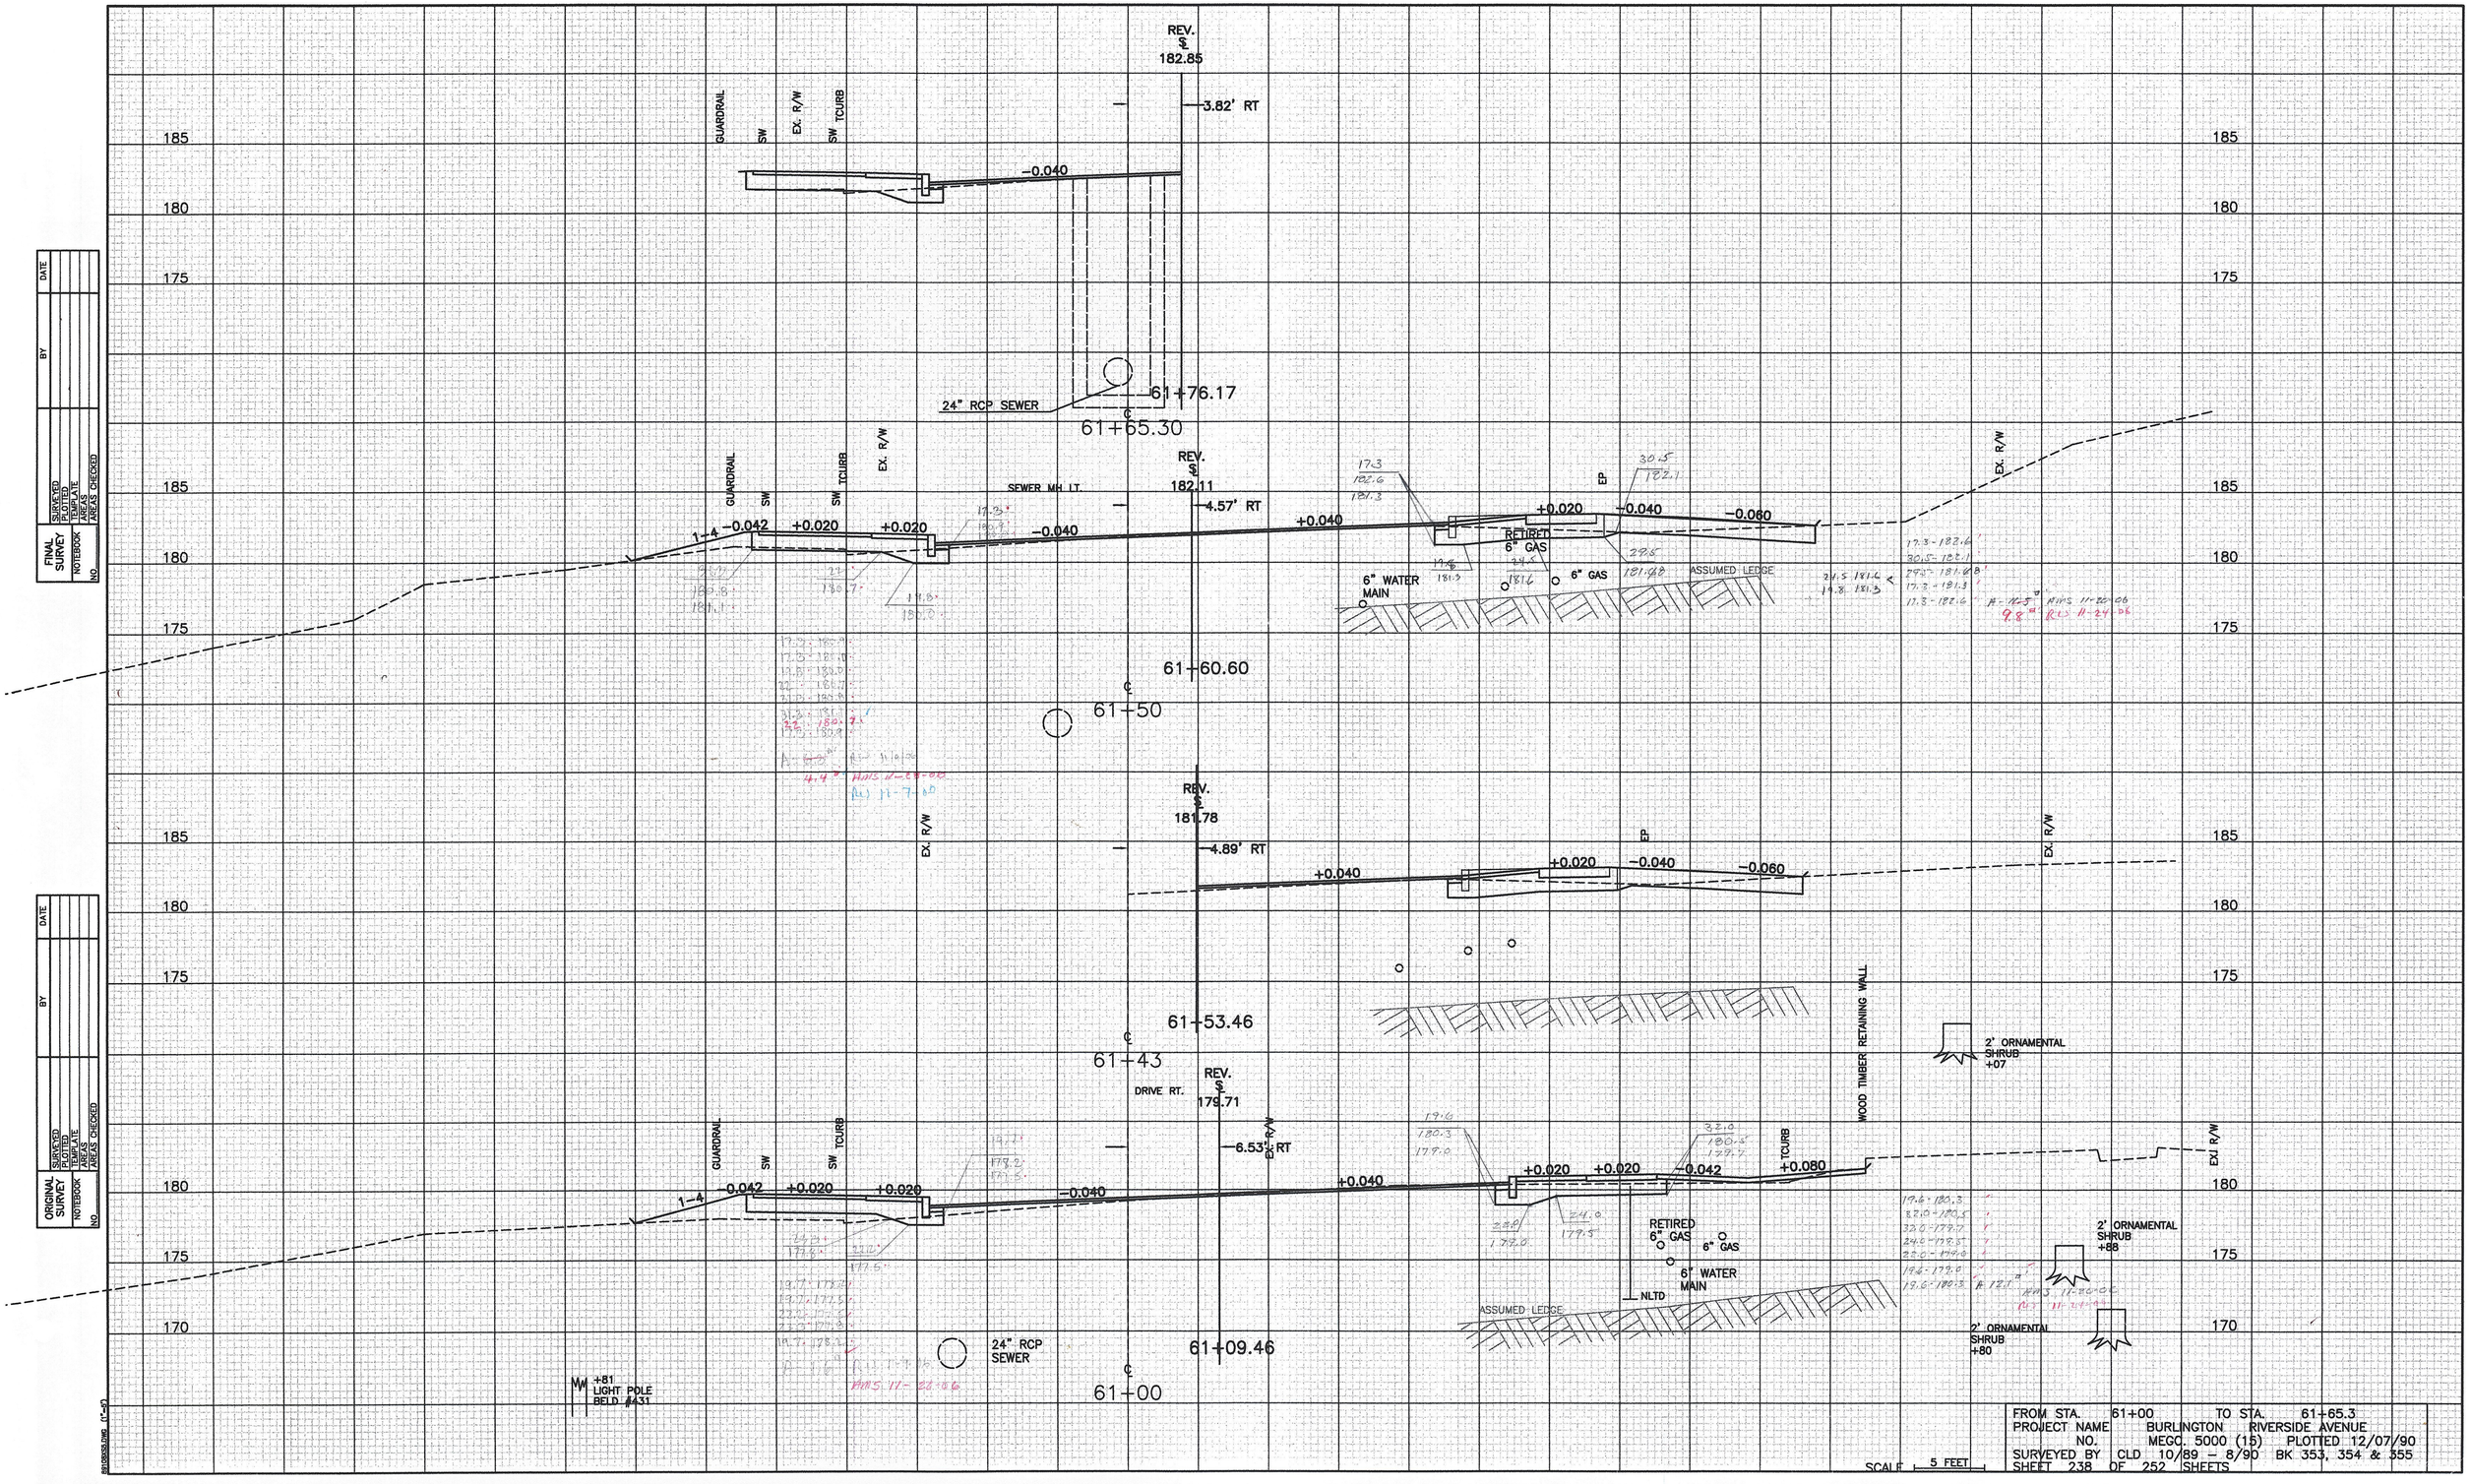

FROM STA. 61+00 TO STA. 61+65.3
PROJECT NAME BURLINGTON RIVERSIDE AVENUE
NO. MEGC. 5000 (15) PLOTTED 12/07/90
SURVEYED BY CLD 10/89 - 8/90 BK 353, 354 & 355
SHEET 238 OF 252 SHEETS