FINAL SURVEY		BY	DATE
NOTEBOOK	SURVEYED		
	PLOTTED		
	TEMPLATE		
	AREAS		
NO.	AREAS CHECKED		
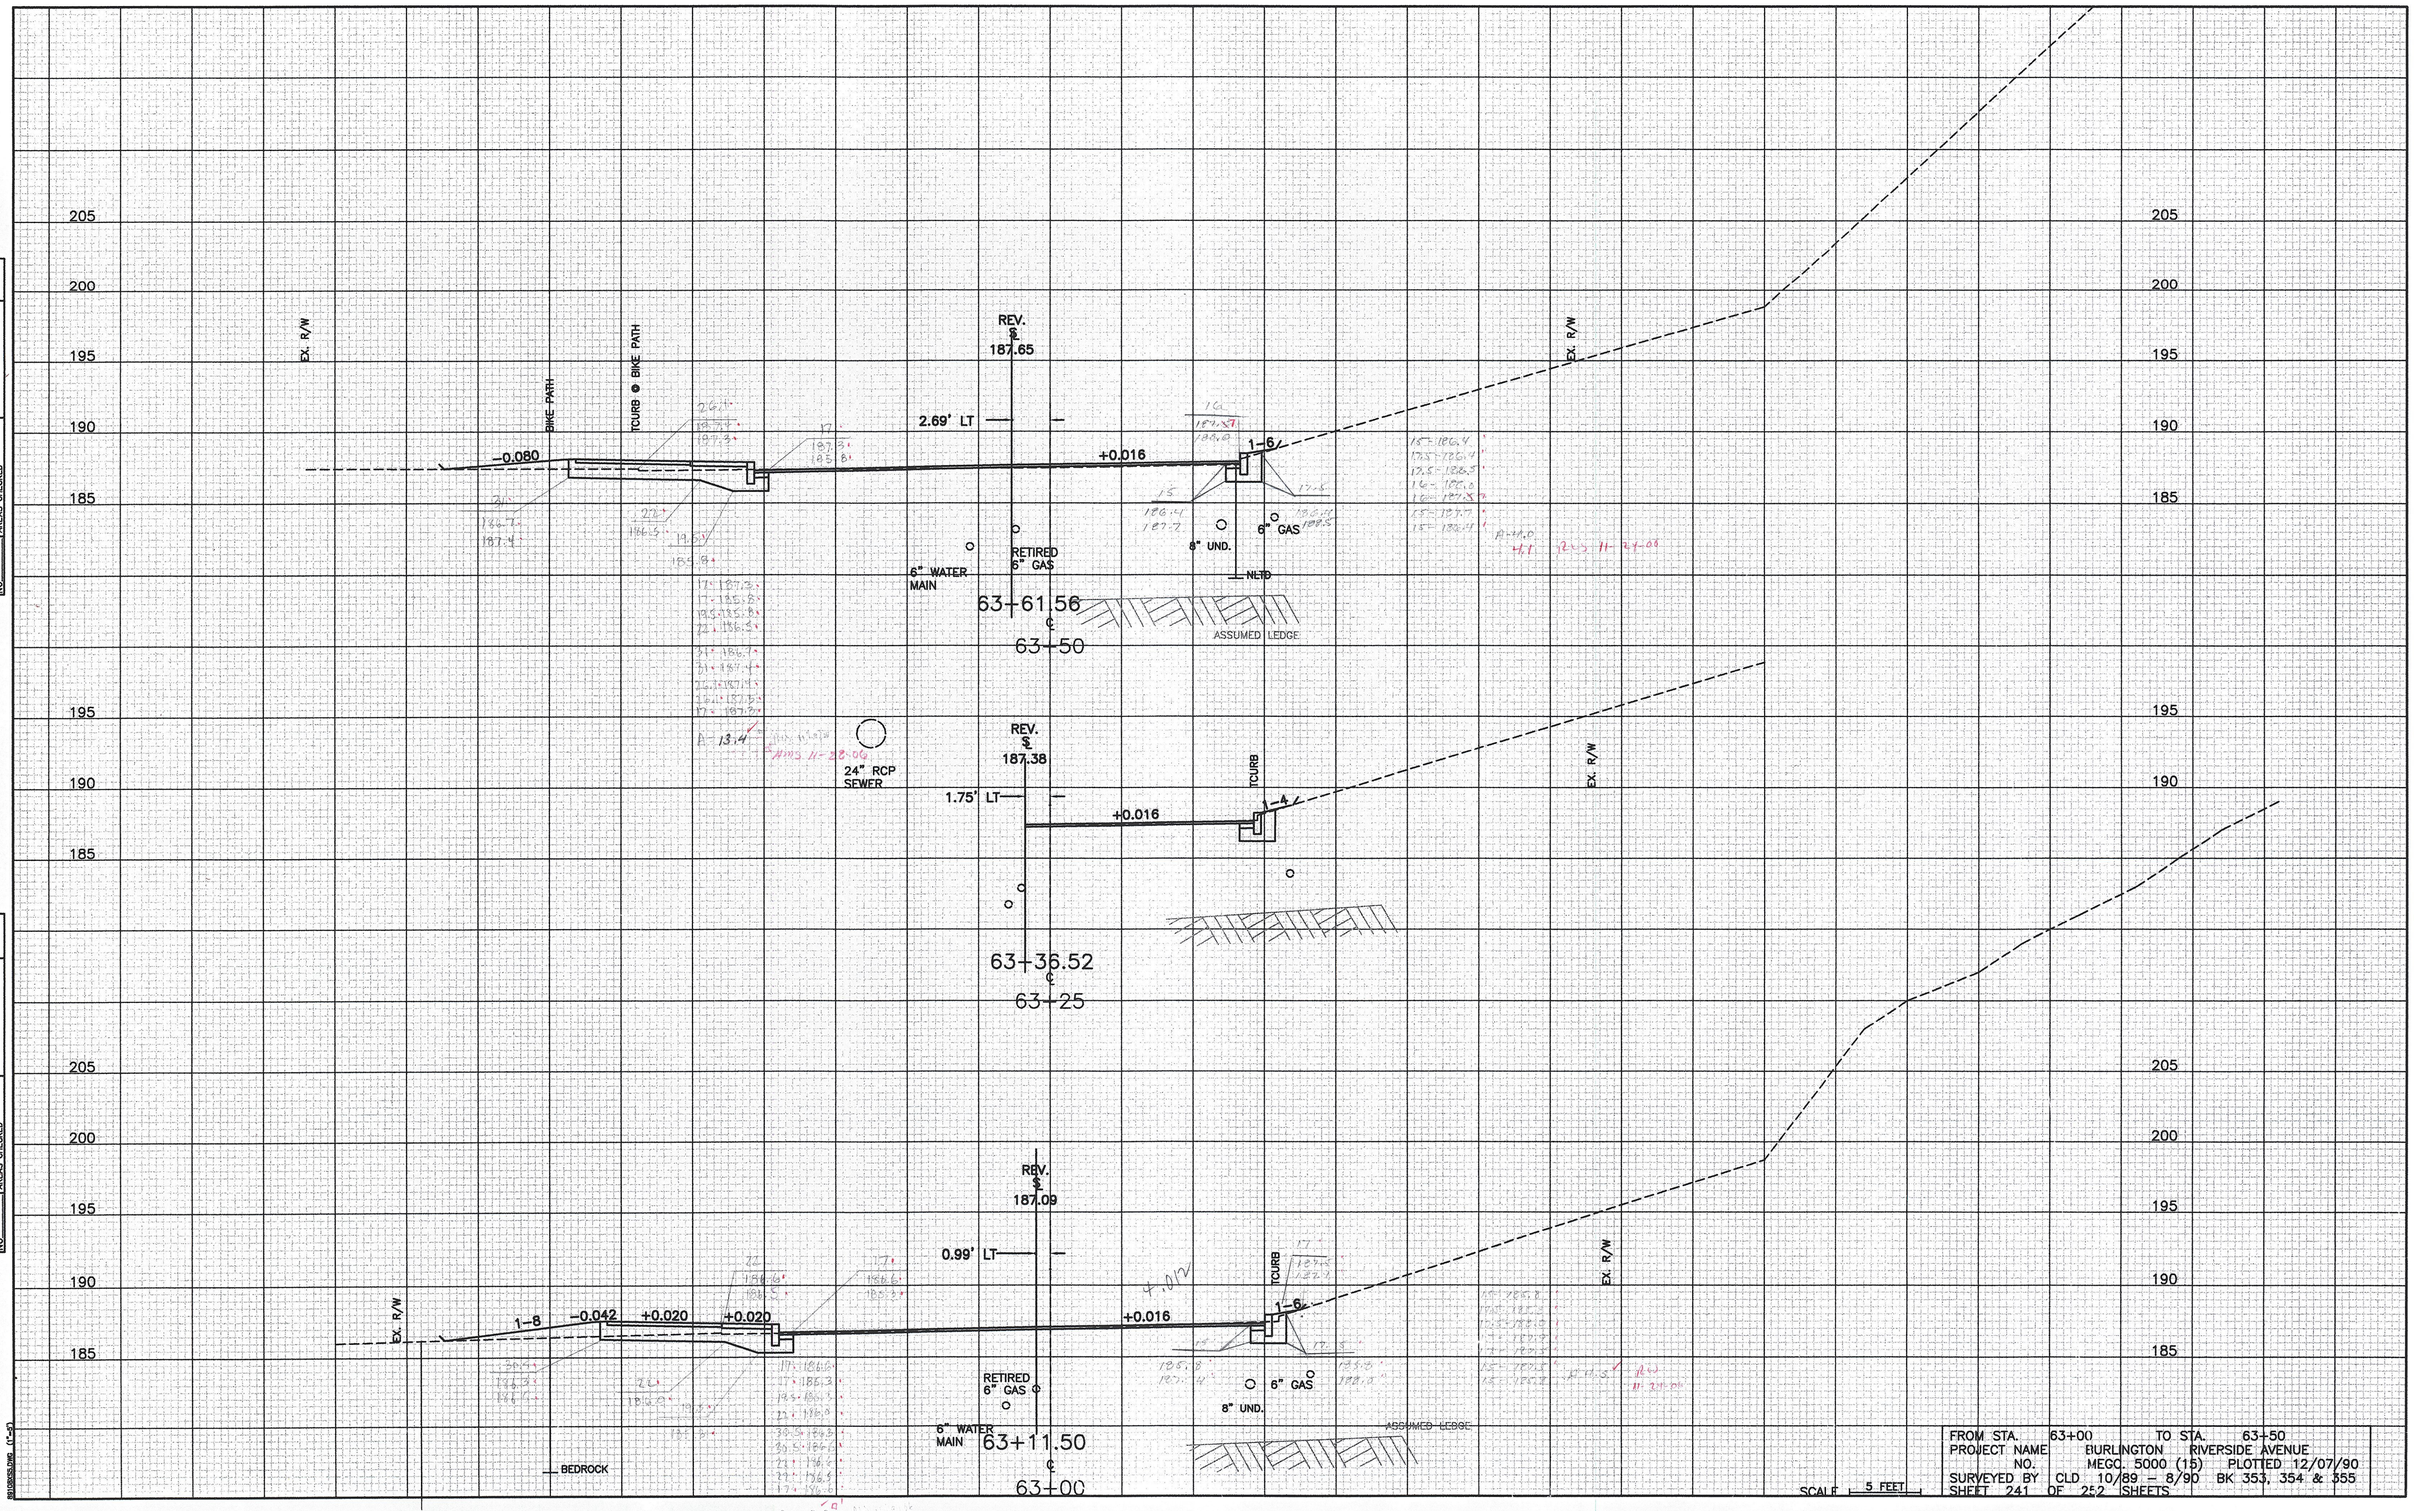
ORIGINAL SURVEY		BY	DATE
NOTEBOOK	SURVEYED		
	PLOTTED		
	TEMPLATE		
	AREAS		
NO.	AREAS CHECKED