


DATE	
BY	
FINAL SURVEY	
NOTED	
NO.	
AREAS CHECKED	

DATE	
BY	
ORIGINAL SURVEY	
NOTED	
NO.	
AREAS CHECKED	

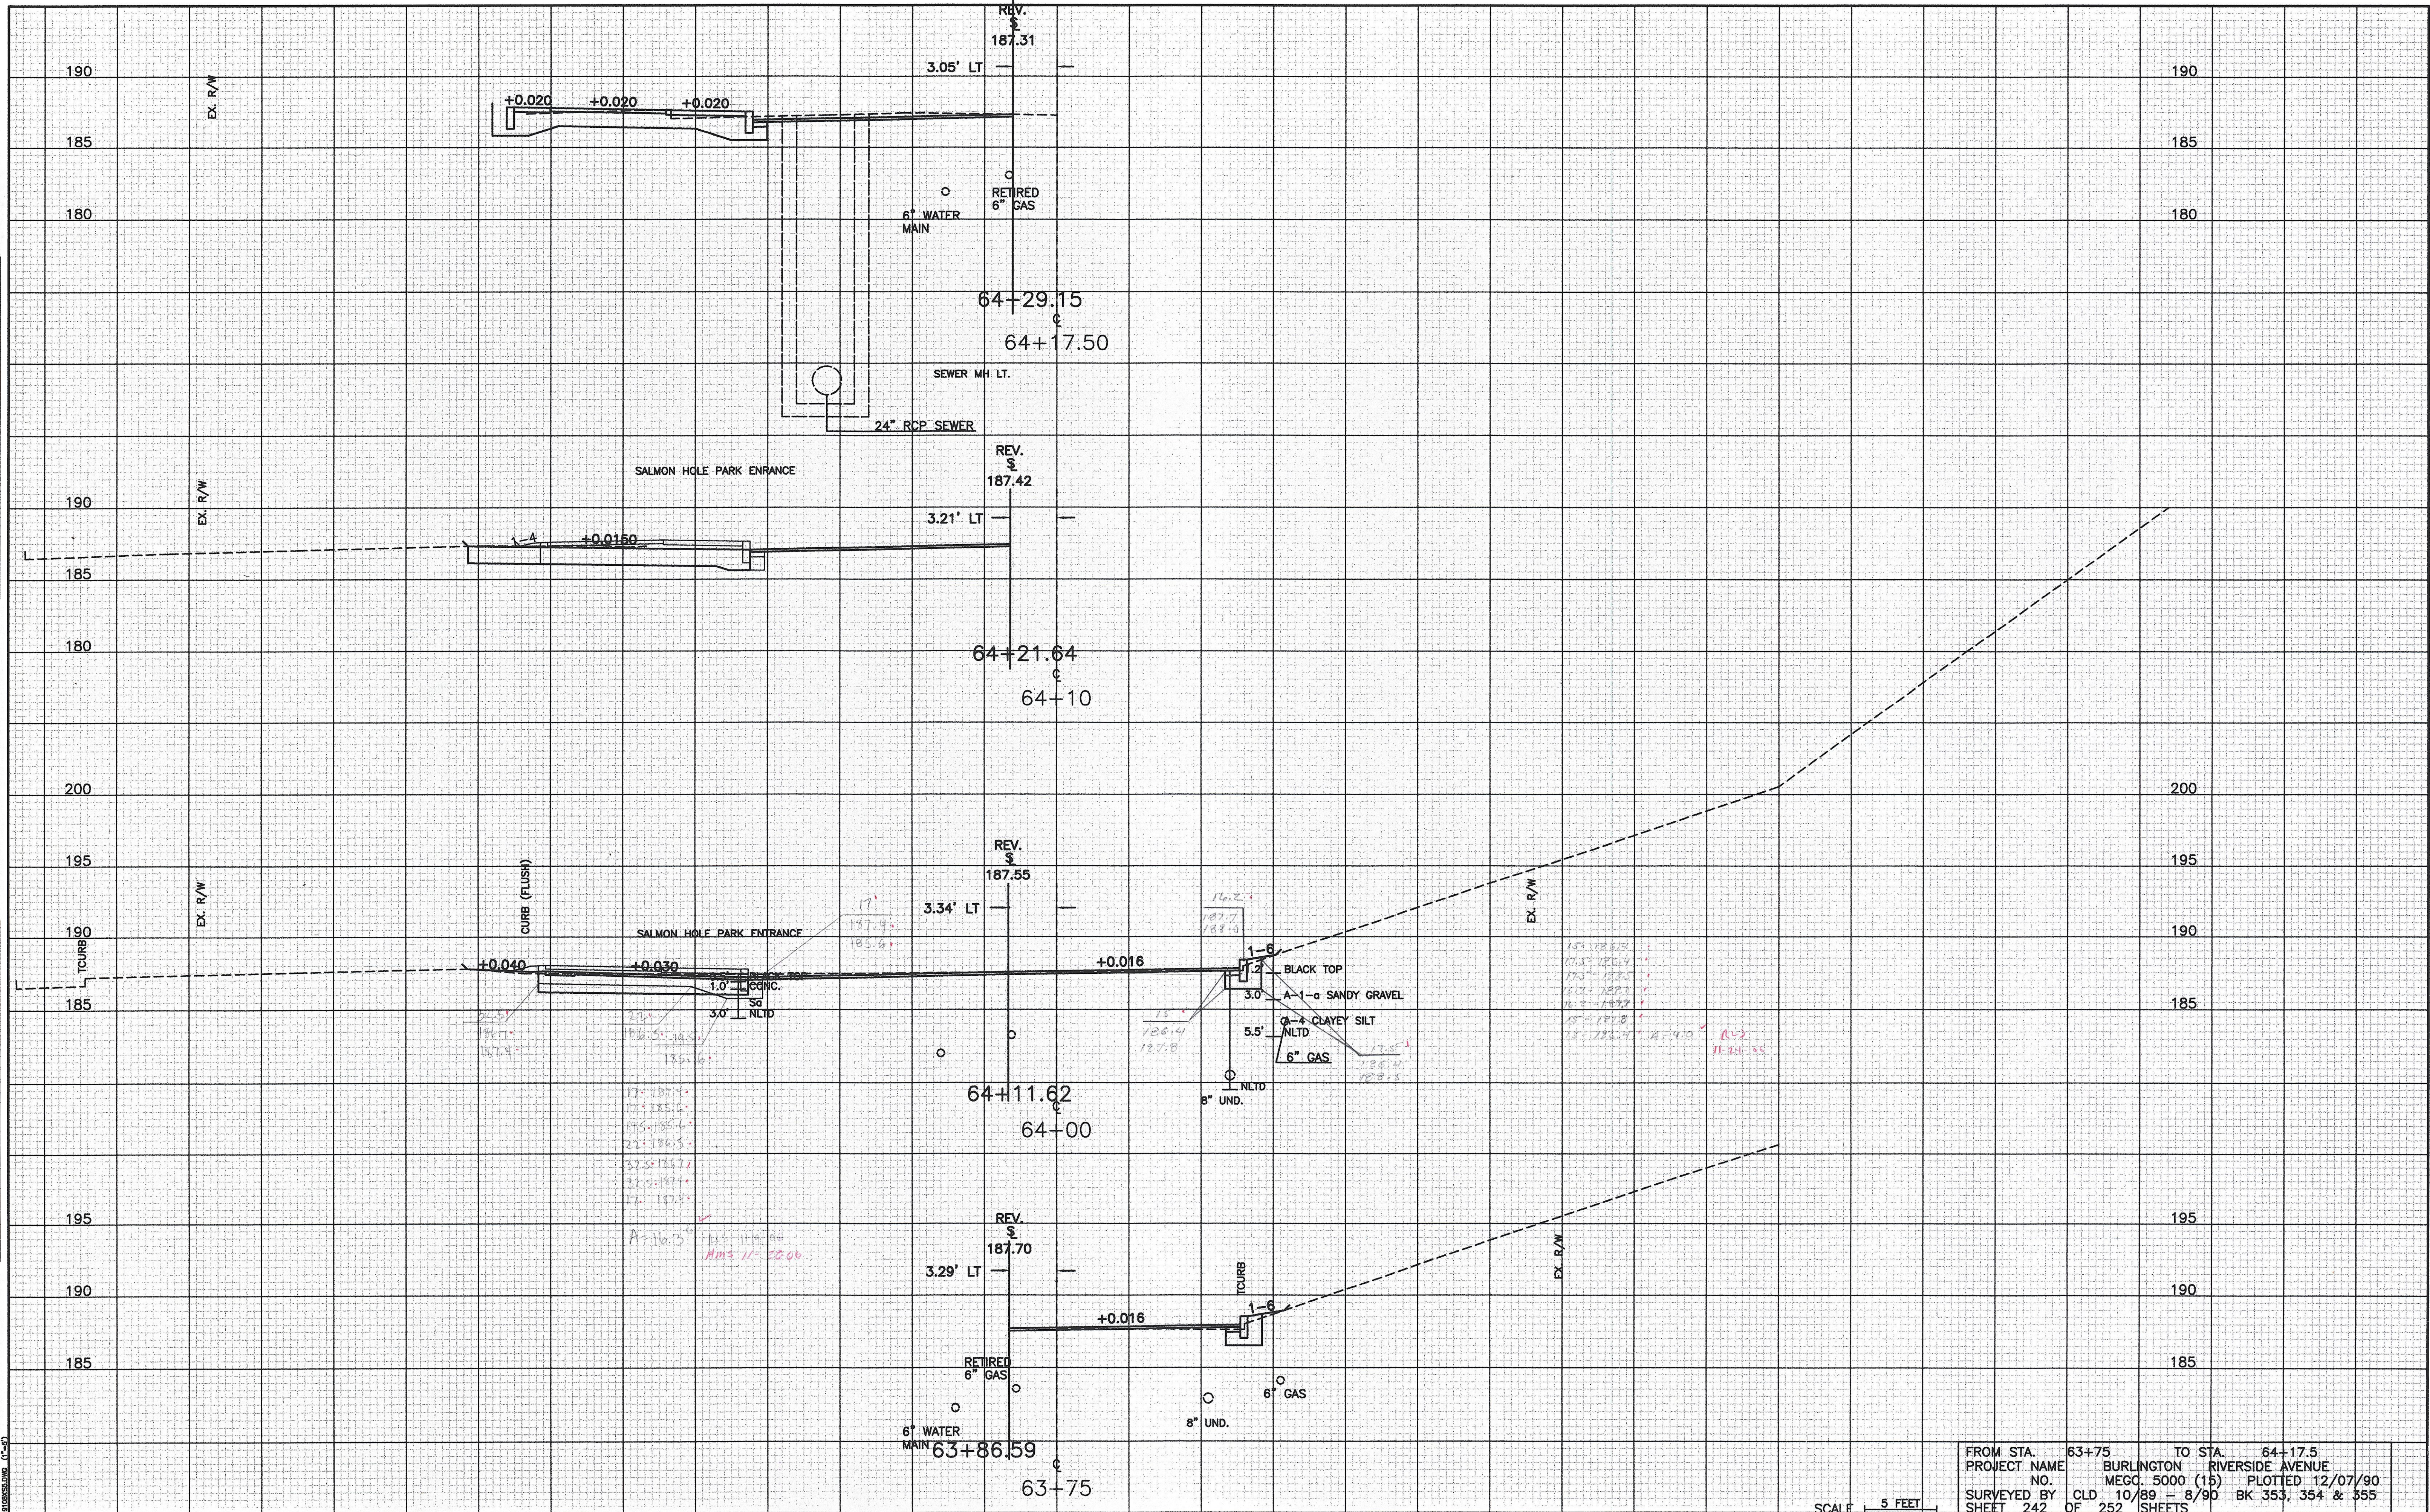

FROM STA. 63+75 TO STA. 64+17.5
 PROJECT NAME BURLINGTON RIVERSIDE AVENUE
 NO. MECG. 5000 (15) PLOTTED 12/07/90
 SURVEYED BY CLD 10/89 = 8/90 BK 353, 354 & 355
 SHEET 242 OF 252 SHEETS

SCALE 1" = 5 FEET

PROVISIONAL (C-5)