


DATE	
BY	
NO.	
AREAS CHECKED	
AREAS	
TEMPLATE	
SURVEY	
FINAL	

DATE	
BY	
NO.	
AREAS CHECKED	
AREAS	
TEMPLATE	
SURVEY	
ORIGINAL	

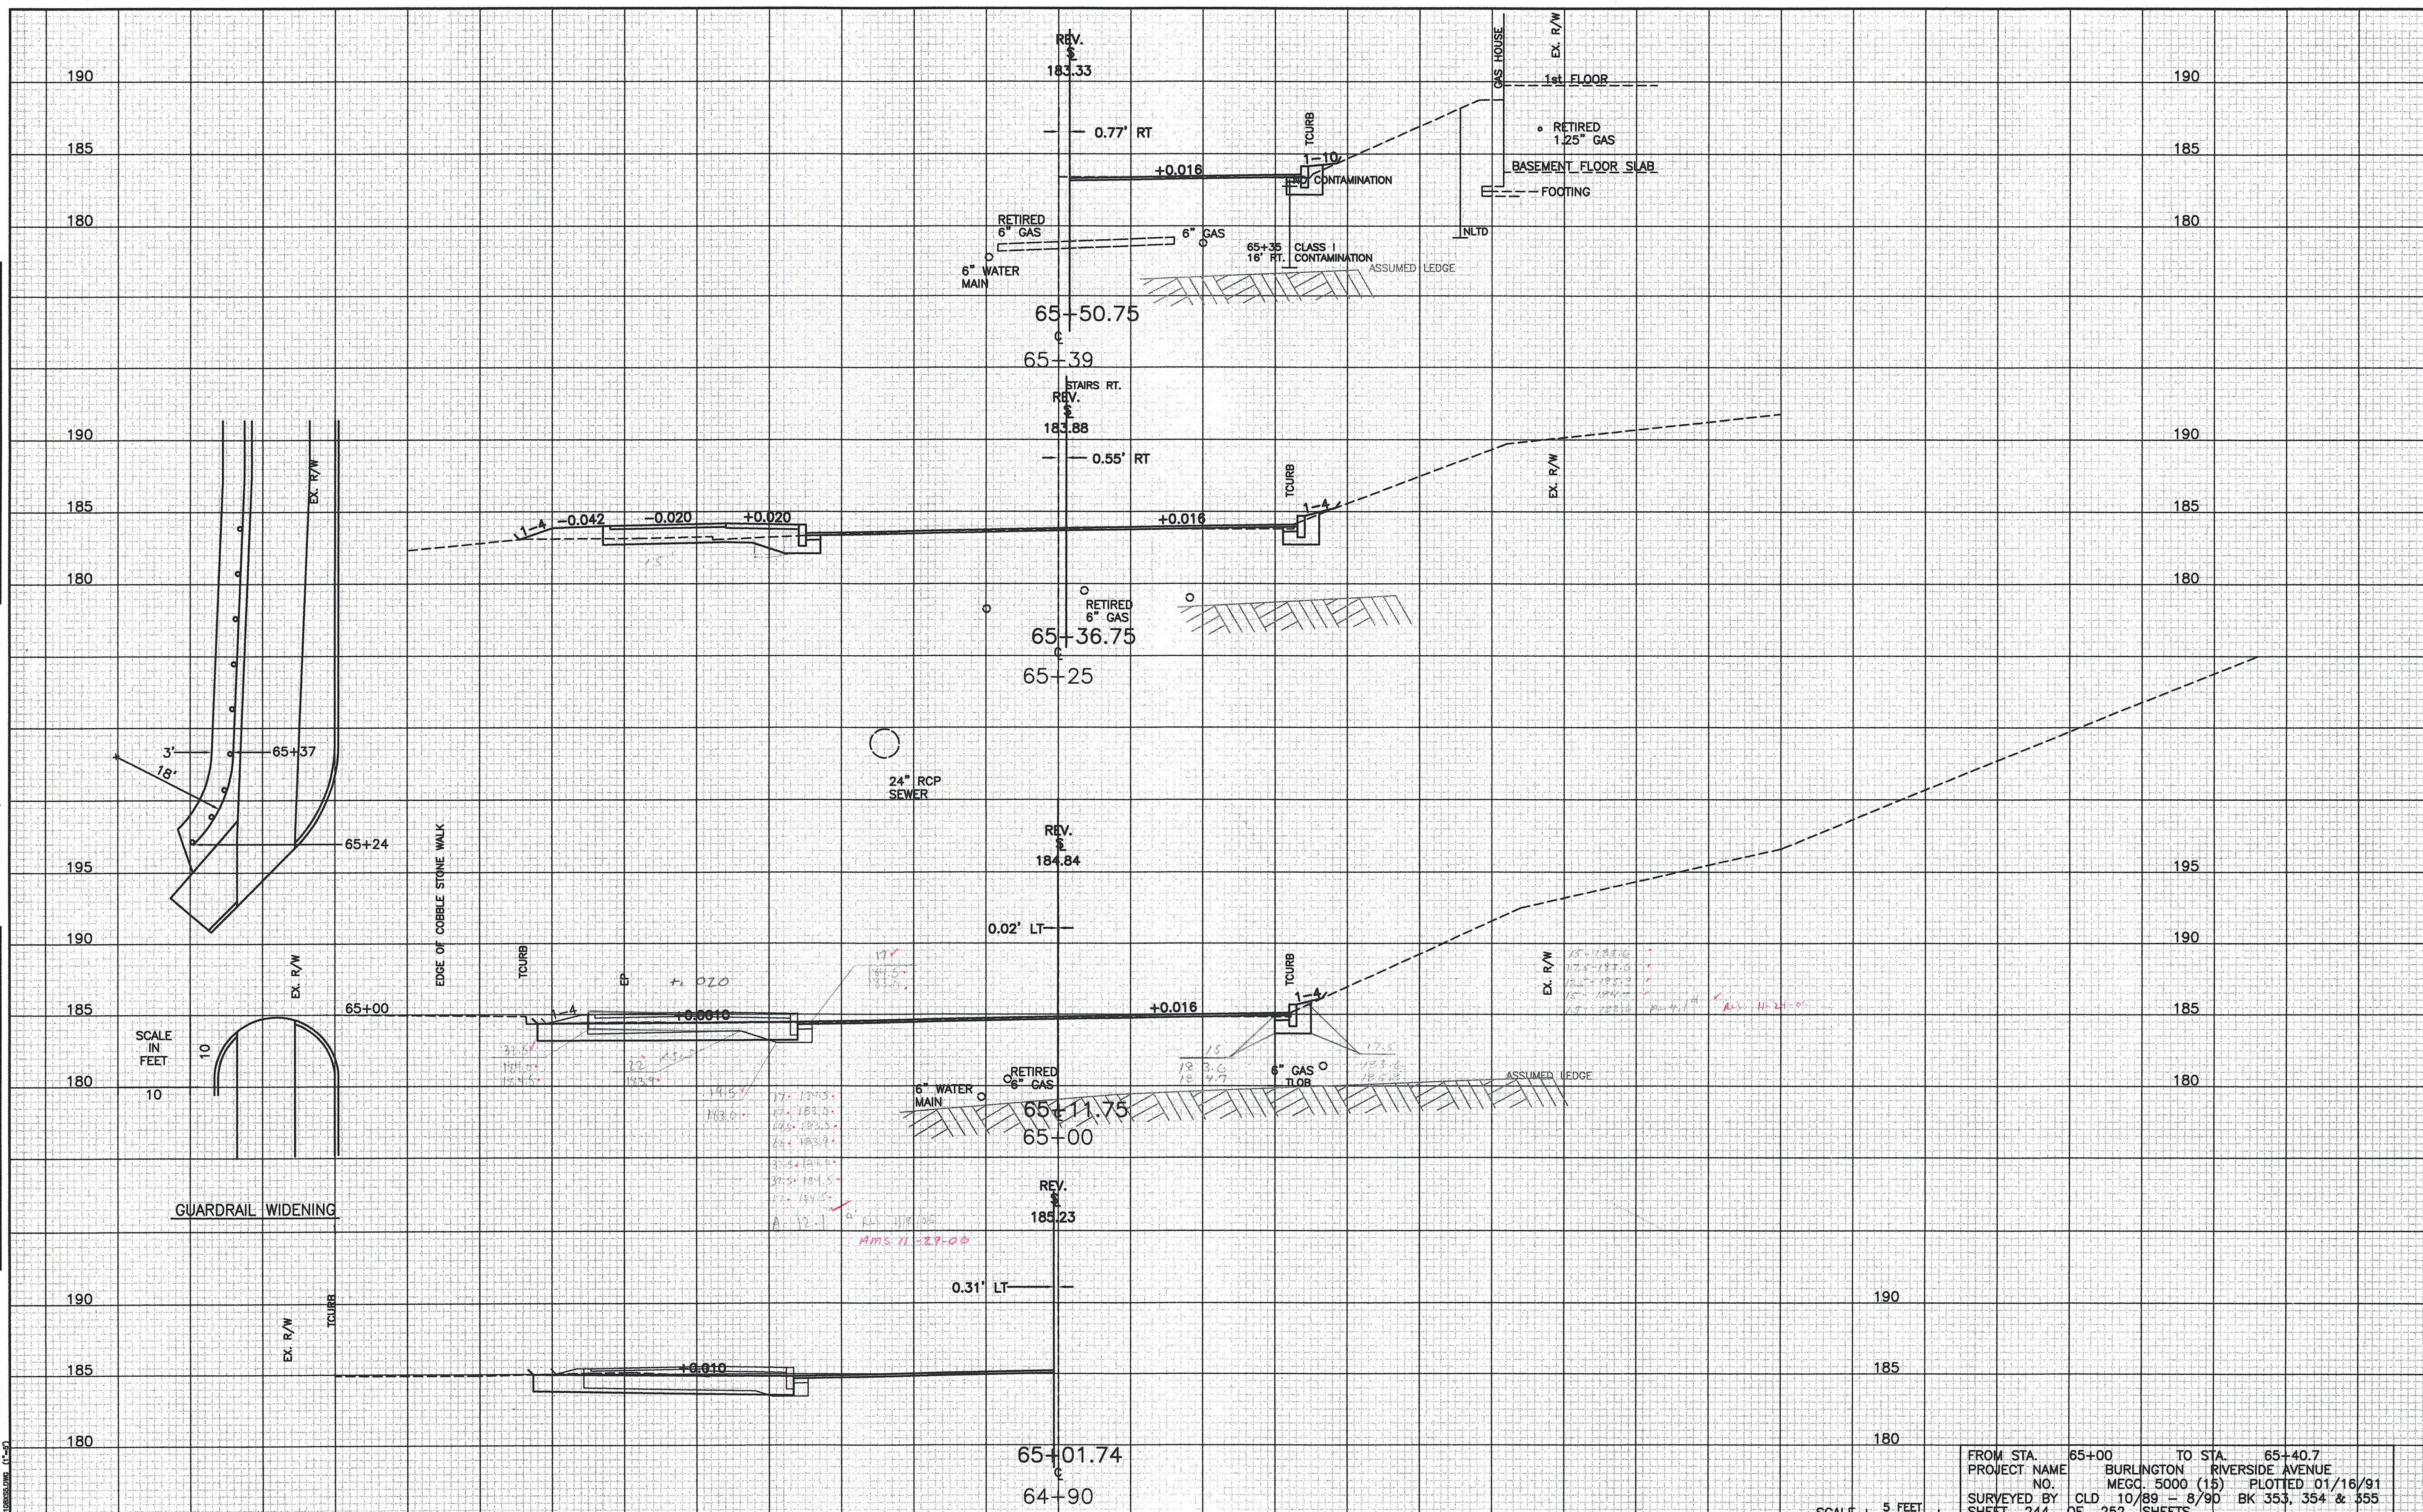

FROM STA. 65+00 TO STA. 65+40.7
 PROJECT NAME BURLINGTON RIVERSIDE AVENUE
 NO. MECC. 5000 (15) PLOTTED 01/16/91
 SURVEYED BY CLD 10/89 - 8/90 BK 353, 354 & 355
 SHEET 244 OF 252 SHEETS

SCALE 5 FEET