


DATE	
BY	
FINAL SURVEY NO.	
SURVEY PLOTTED DATE	
TEMPLATE NO.	
AREAS CHECKED	

DATE	
BY	
ORIGINAL SURVEY NO.	
SURVEY PLOTTED DATE	
TEMPLATE NO.	
AREAS CHECKED	

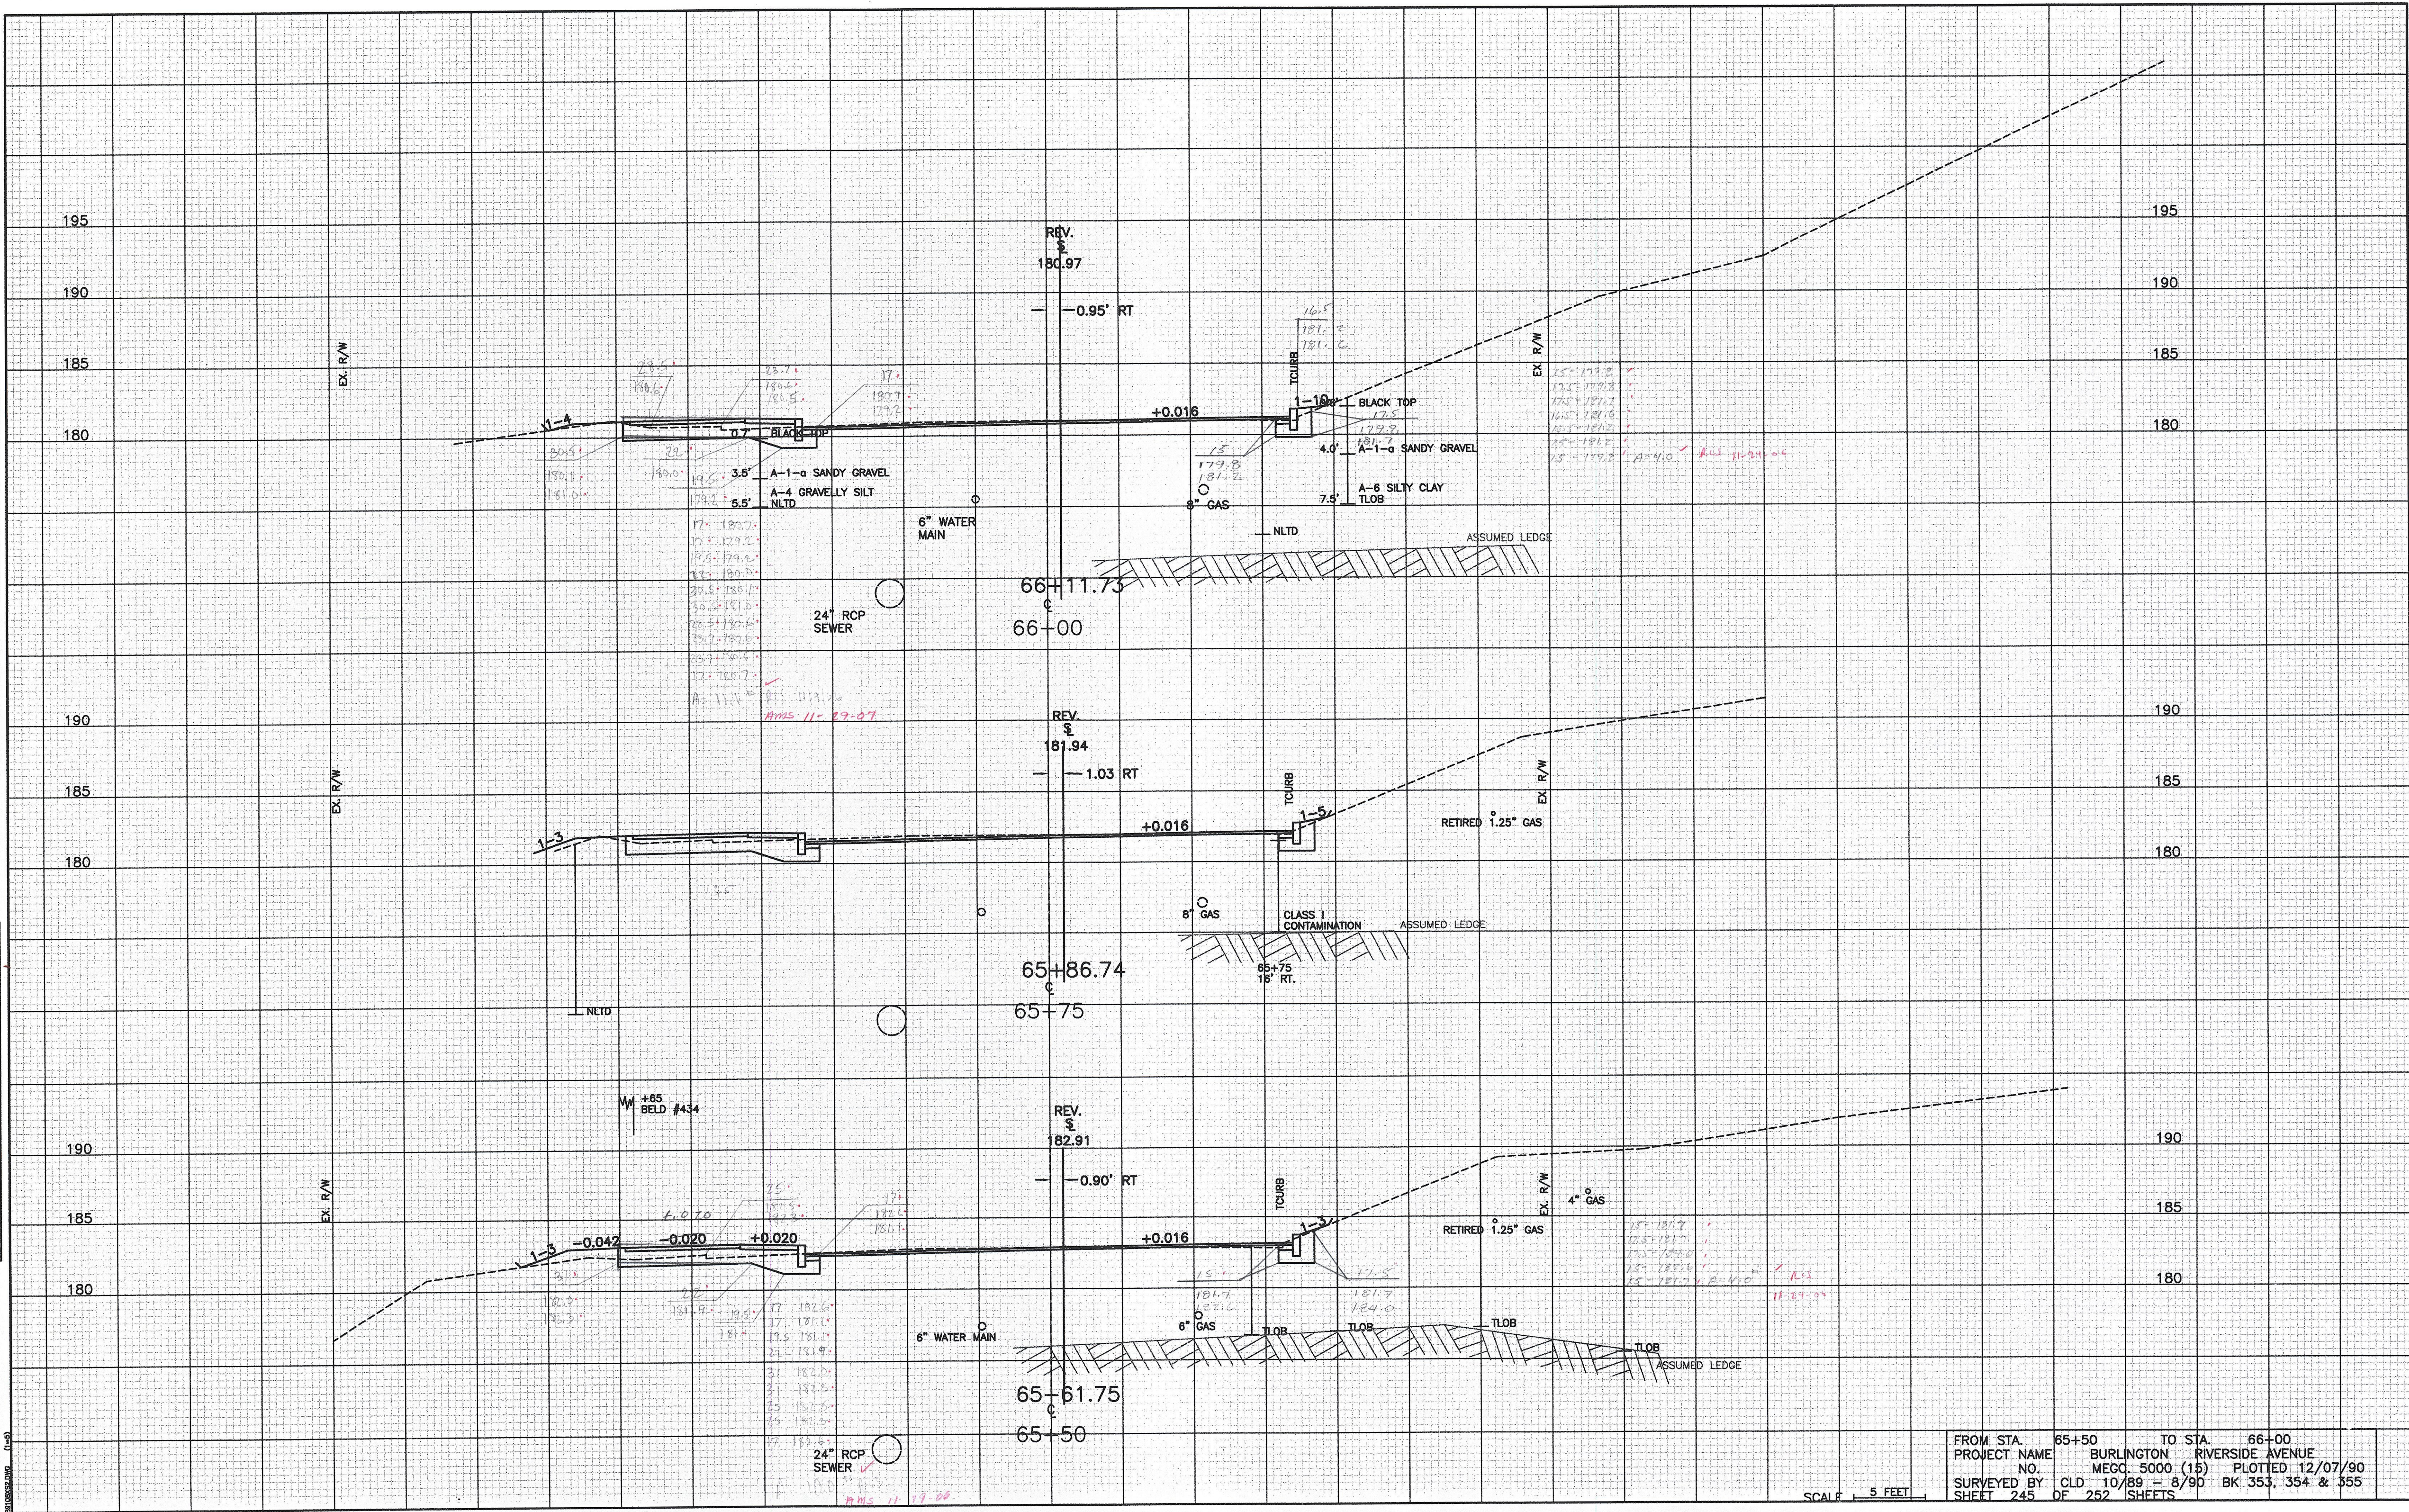

FROM STA. 65+50 TO STA. 66+00
 PROJECT NAME BURLINGTON RIVERSIDE AVENUE
 NO. MEGC. 5000 (15) PLOTTED 12/07/90
 SURVEYED BY CLD 10/89 - 8/90 BK 353, 354 & 355
 SHEET 245 OF 252 SHEETS

SCALE 1" = 5 FEET