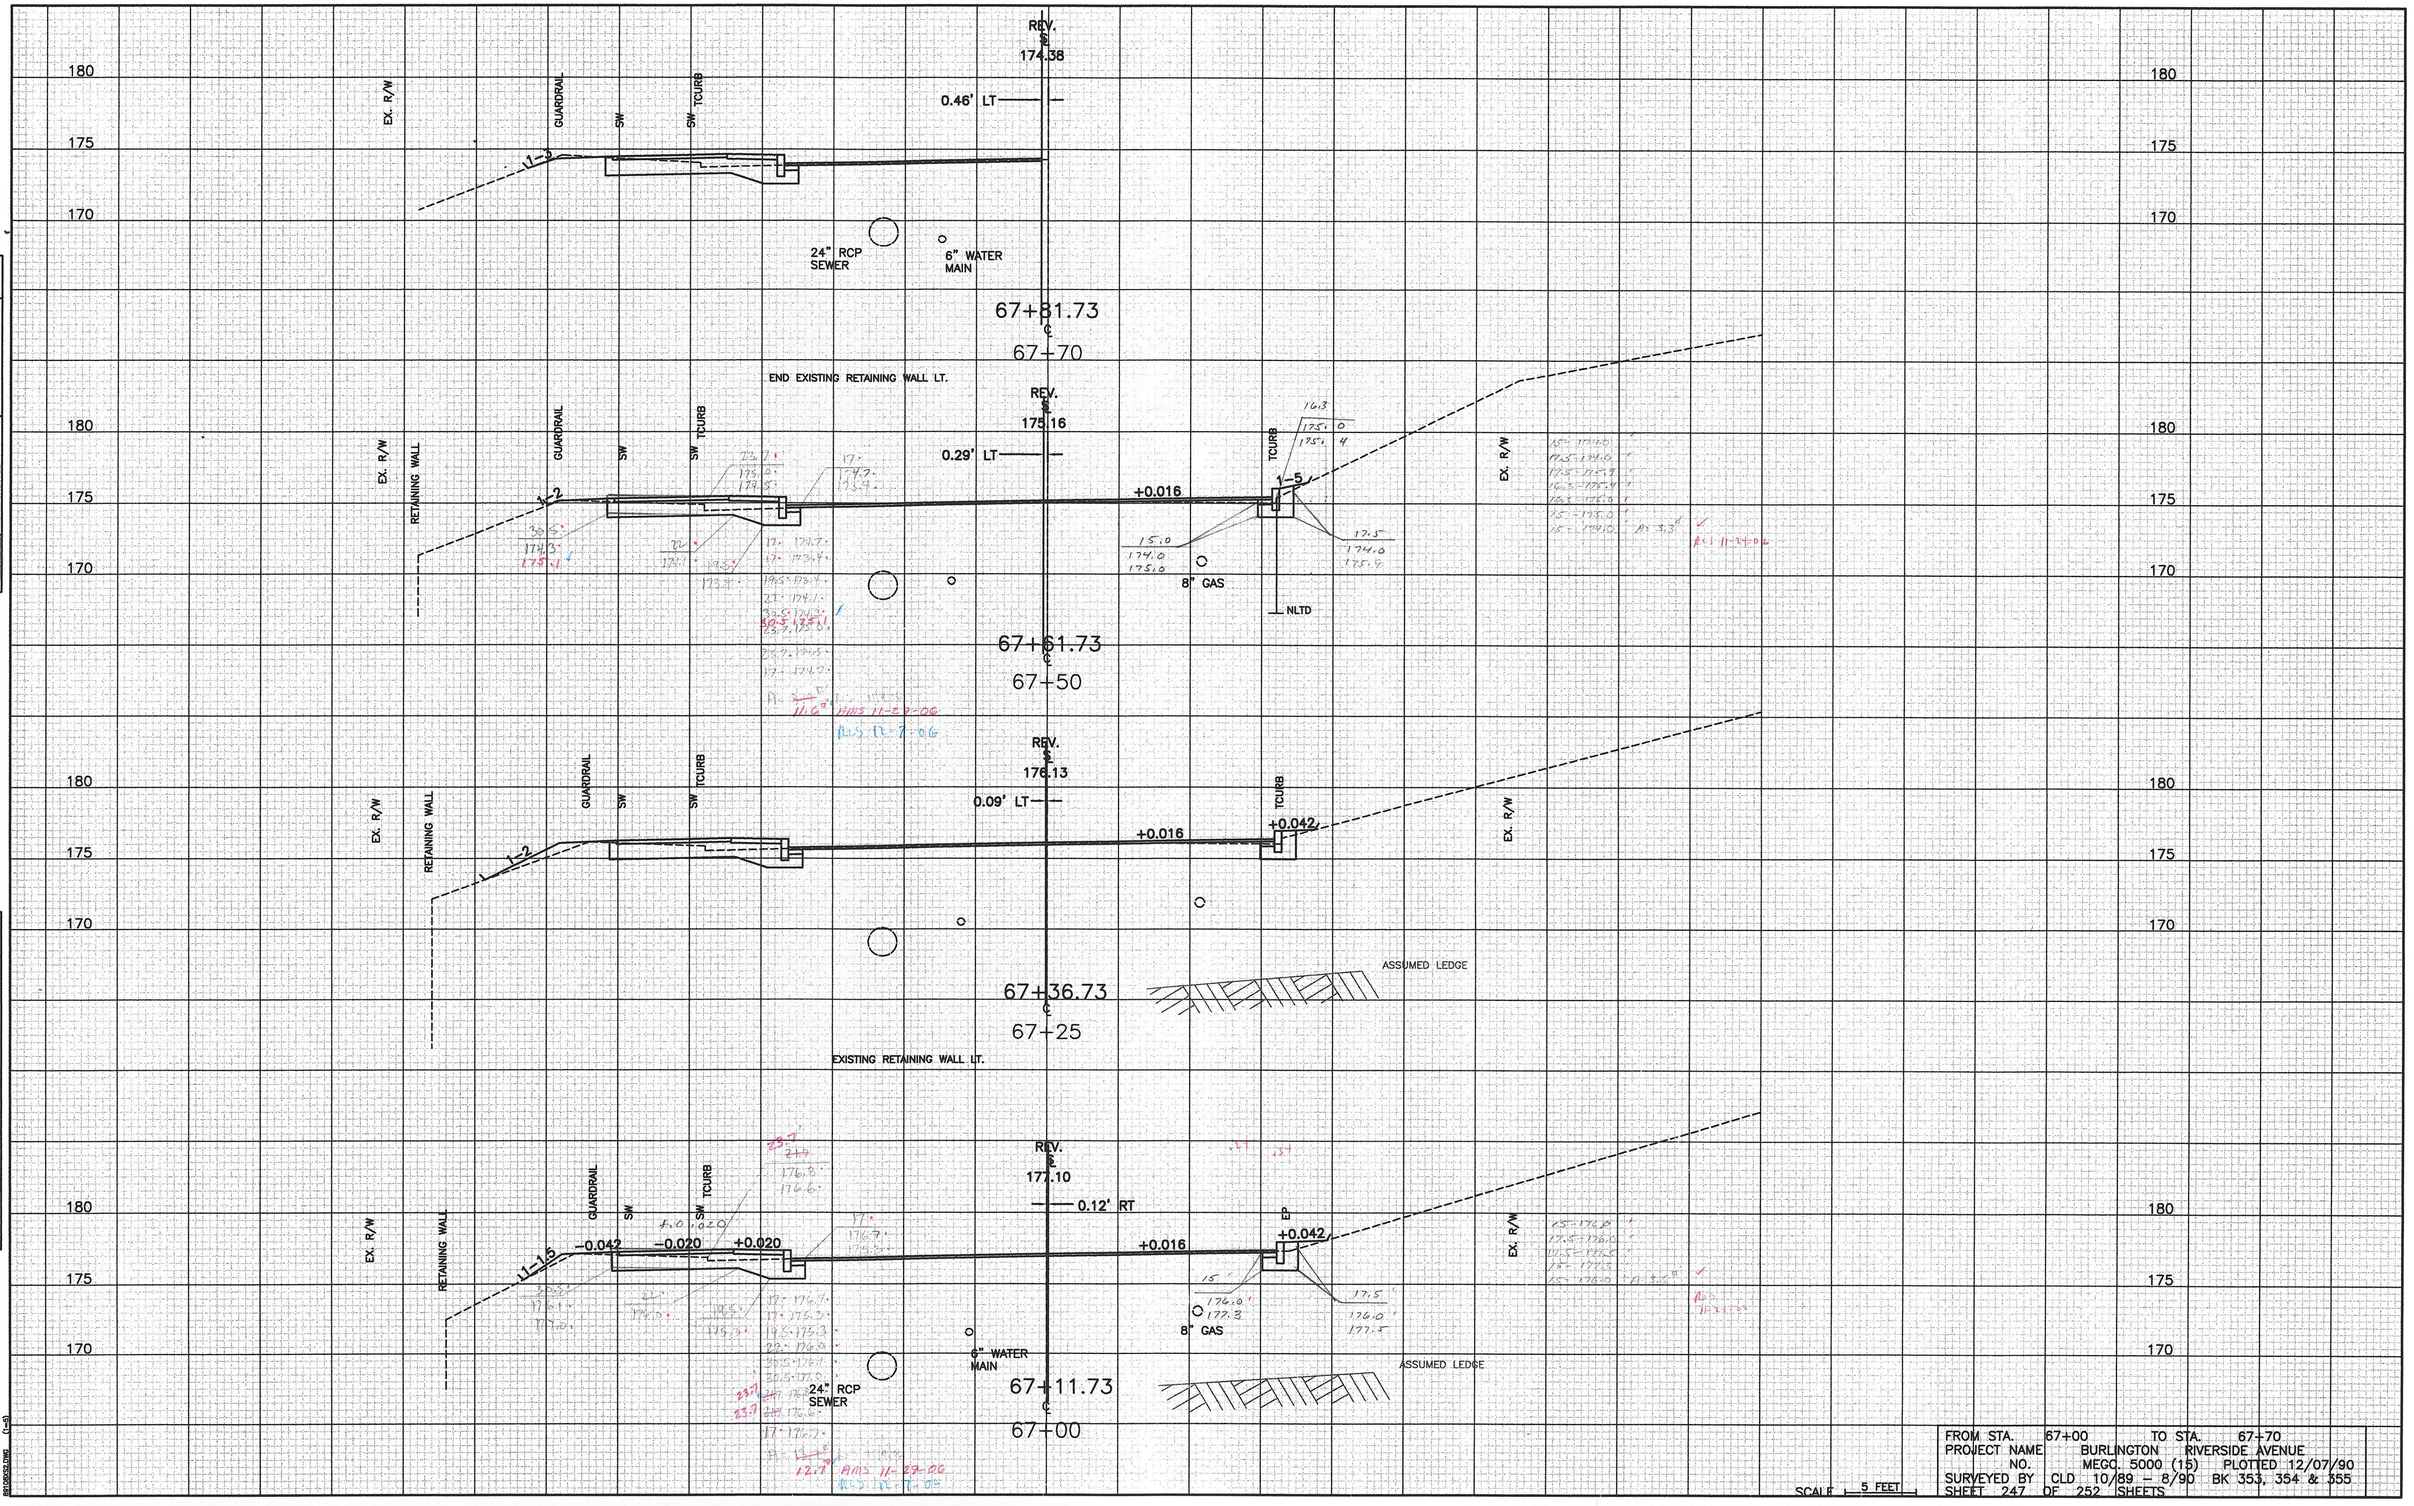

FINAL SURVEY		BY	DATE
SURVEYED			
PLOTTED			
TEMPLATE			
AREAS			
AREAS CHECKED			
NOTEBOOK			
NO.			

ORIGINAL SURVEY		BY	DATE
SURVEYED			
PLOTTED			
TEMPLATE			
AREAS			
AREAS CHECKED			
NOTEBOOK			
NO.			

FROM STA. 67+00 TO STA. 67-70
PROJECT NAME BURLINGTON RIVERSIDE AVENUE
NO. MEGC. 5000 (15) PLOTTED 12/07/90
SURVEYED BY CLD 10/89 – 8/90 BK 353, 354 & 355
SHEET 247 OF 252 SHEETS

SCALE 5 FEET

+1.35