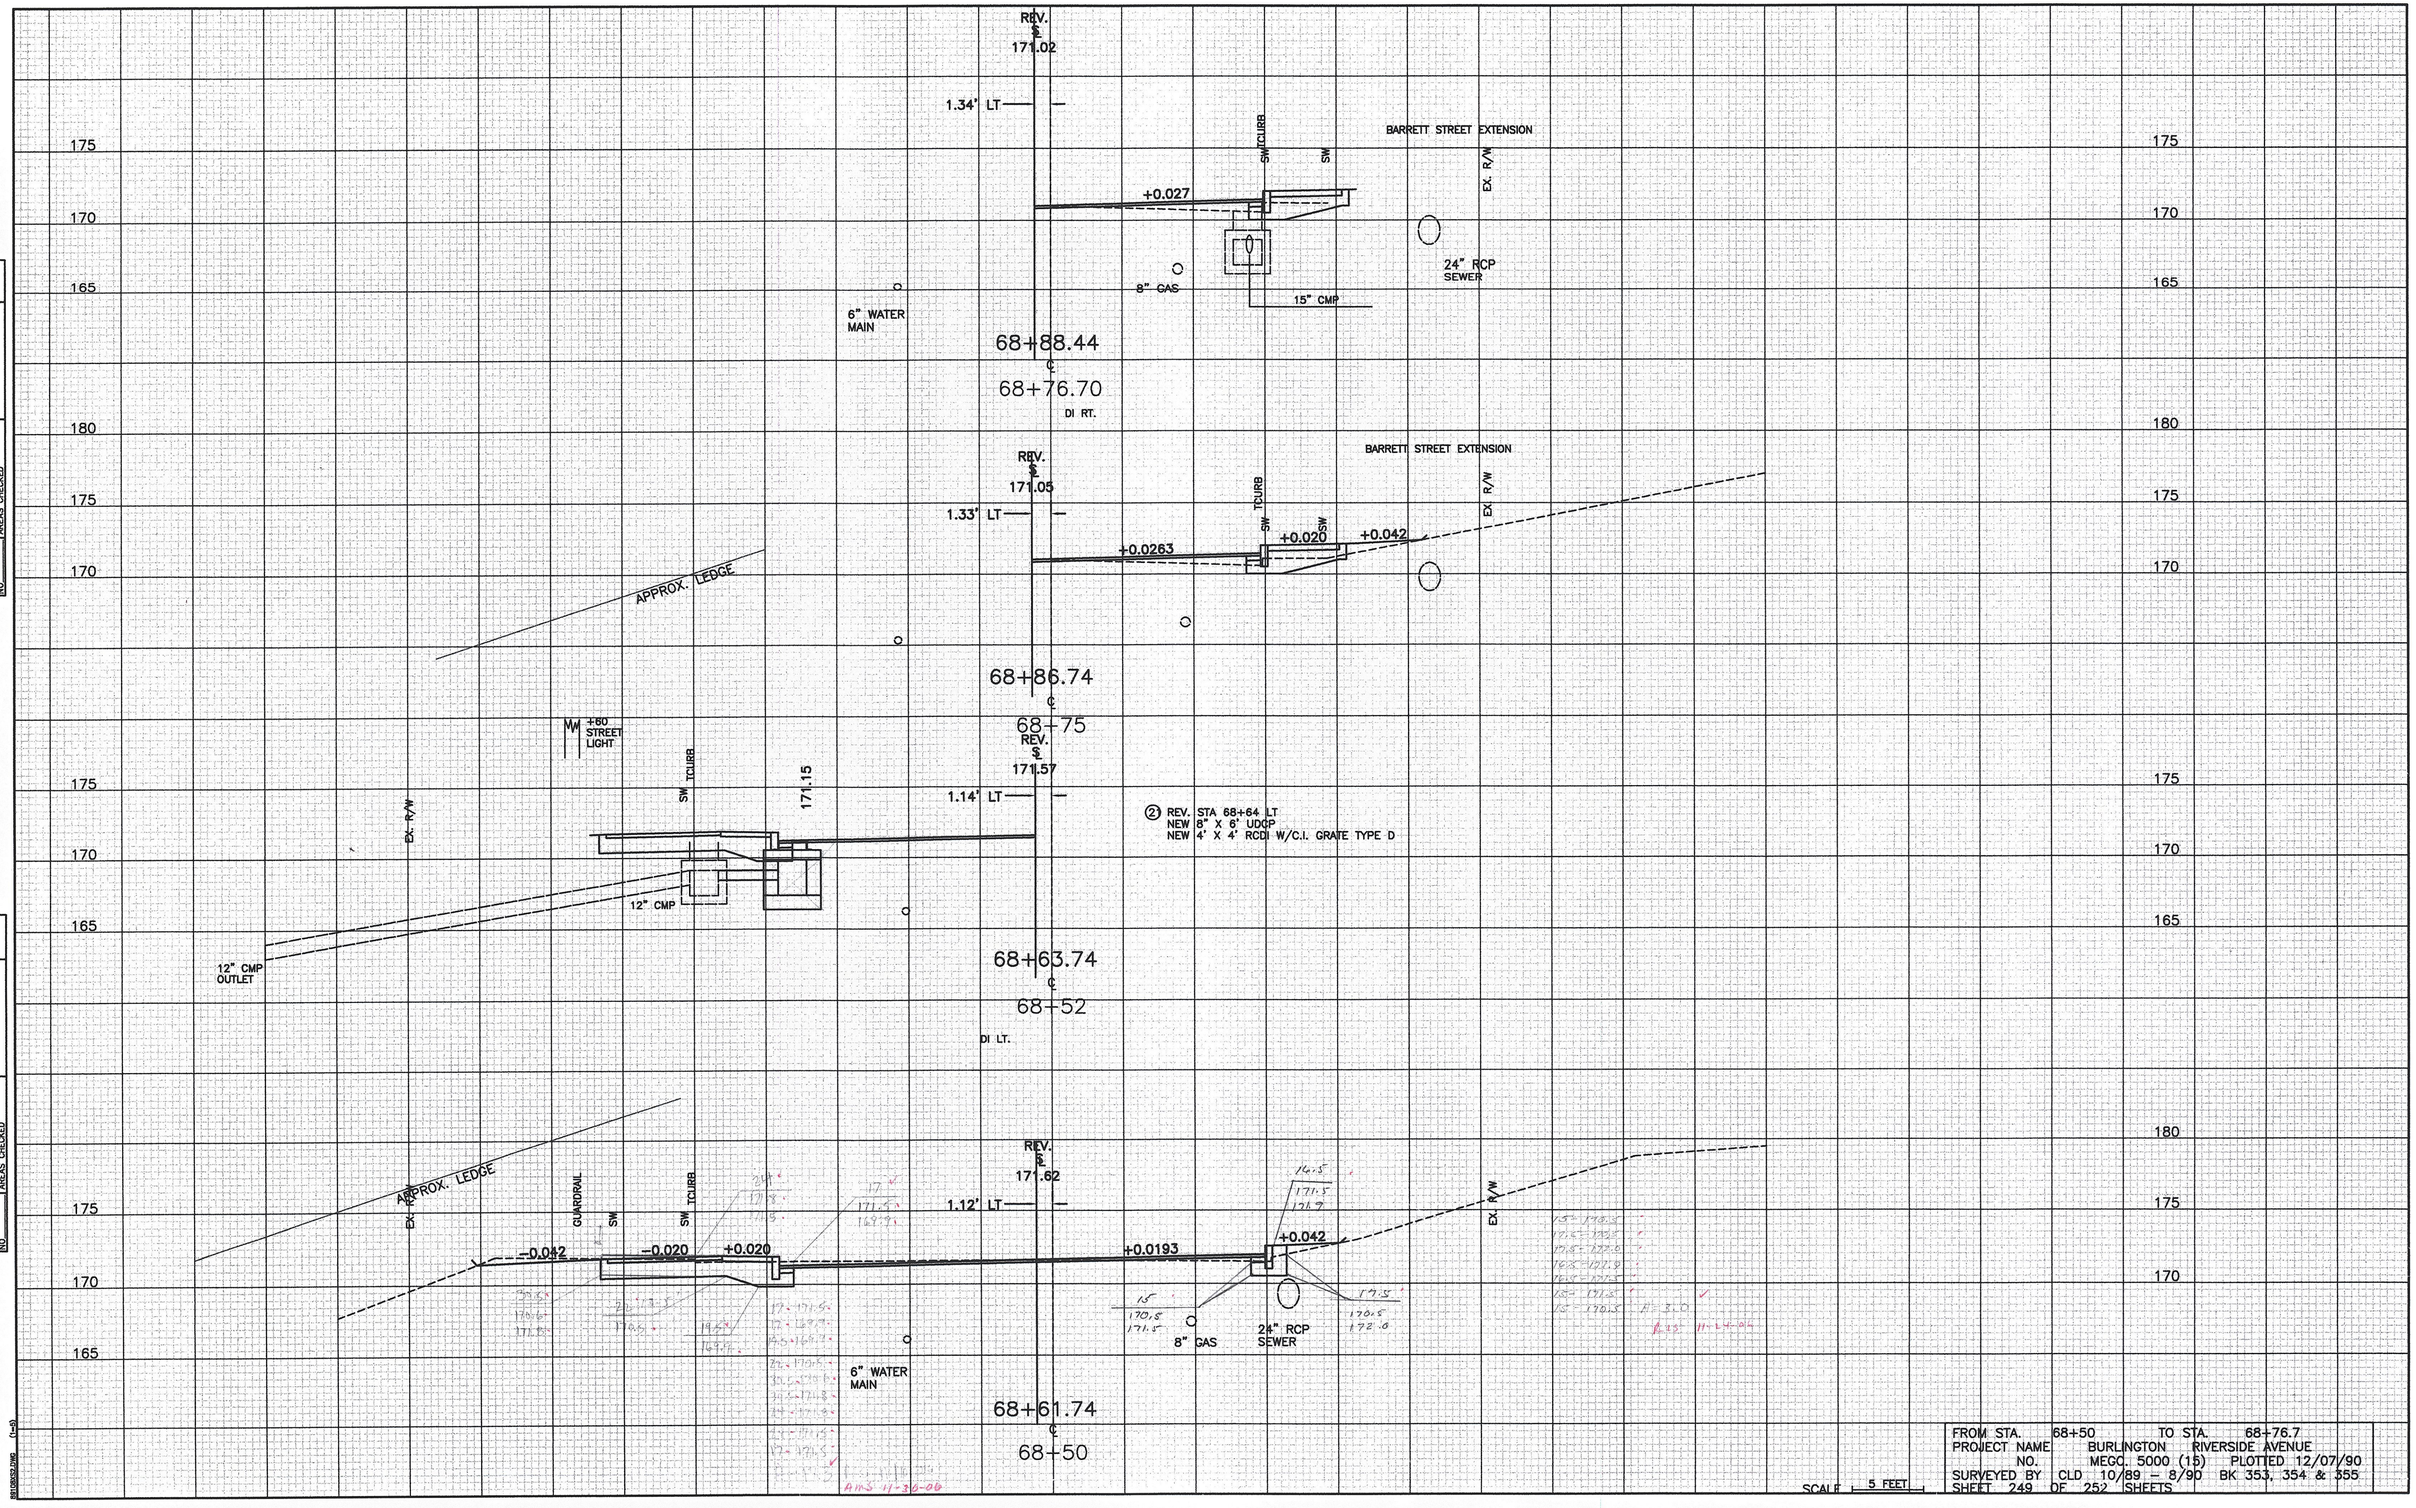

FROM STA. 68+50	TO STA. 68+76.7
PROJECT NAME	BURLINGTON RIVERSIDE AVENUE
NO.	MEGC. 5000 (15) PLOTTED 12/07/90
SURVEYED BY	CLD 10/89 – 8/90 BK 353, 354 & 355
SHEET 249	OF 252 SHEETS

FINAL SURVEY		BY	DATE
	SURVEYED		
	PLOTTED		
	TEMPLATE		
NOTEBOOK	AREAS		
NO.	AREAS CHECKED		

ORIGINAL SURVEY		BY	DATE
	SURVEYED		
	PLOTTED		
	TEMPLATE		
NOTEBOOK	AREAS		
NO.	AREAS CHECKED		

BRUBRO3.DWG (1of3)