FINAL SURVEY		BY	DATE
	SURVEYED		
	PLOTTED		
NOTEBOOK	TEMPLATE		
	TRACED		
NO.	AREAS CHECKED		

ORIGINAL SURVEY		BY	DATE
	SURVEYED		
	PLOTTED		
NOTEBOOK	TEMPLATE		
	TRACED		
NO.	AREAS CHECKED		

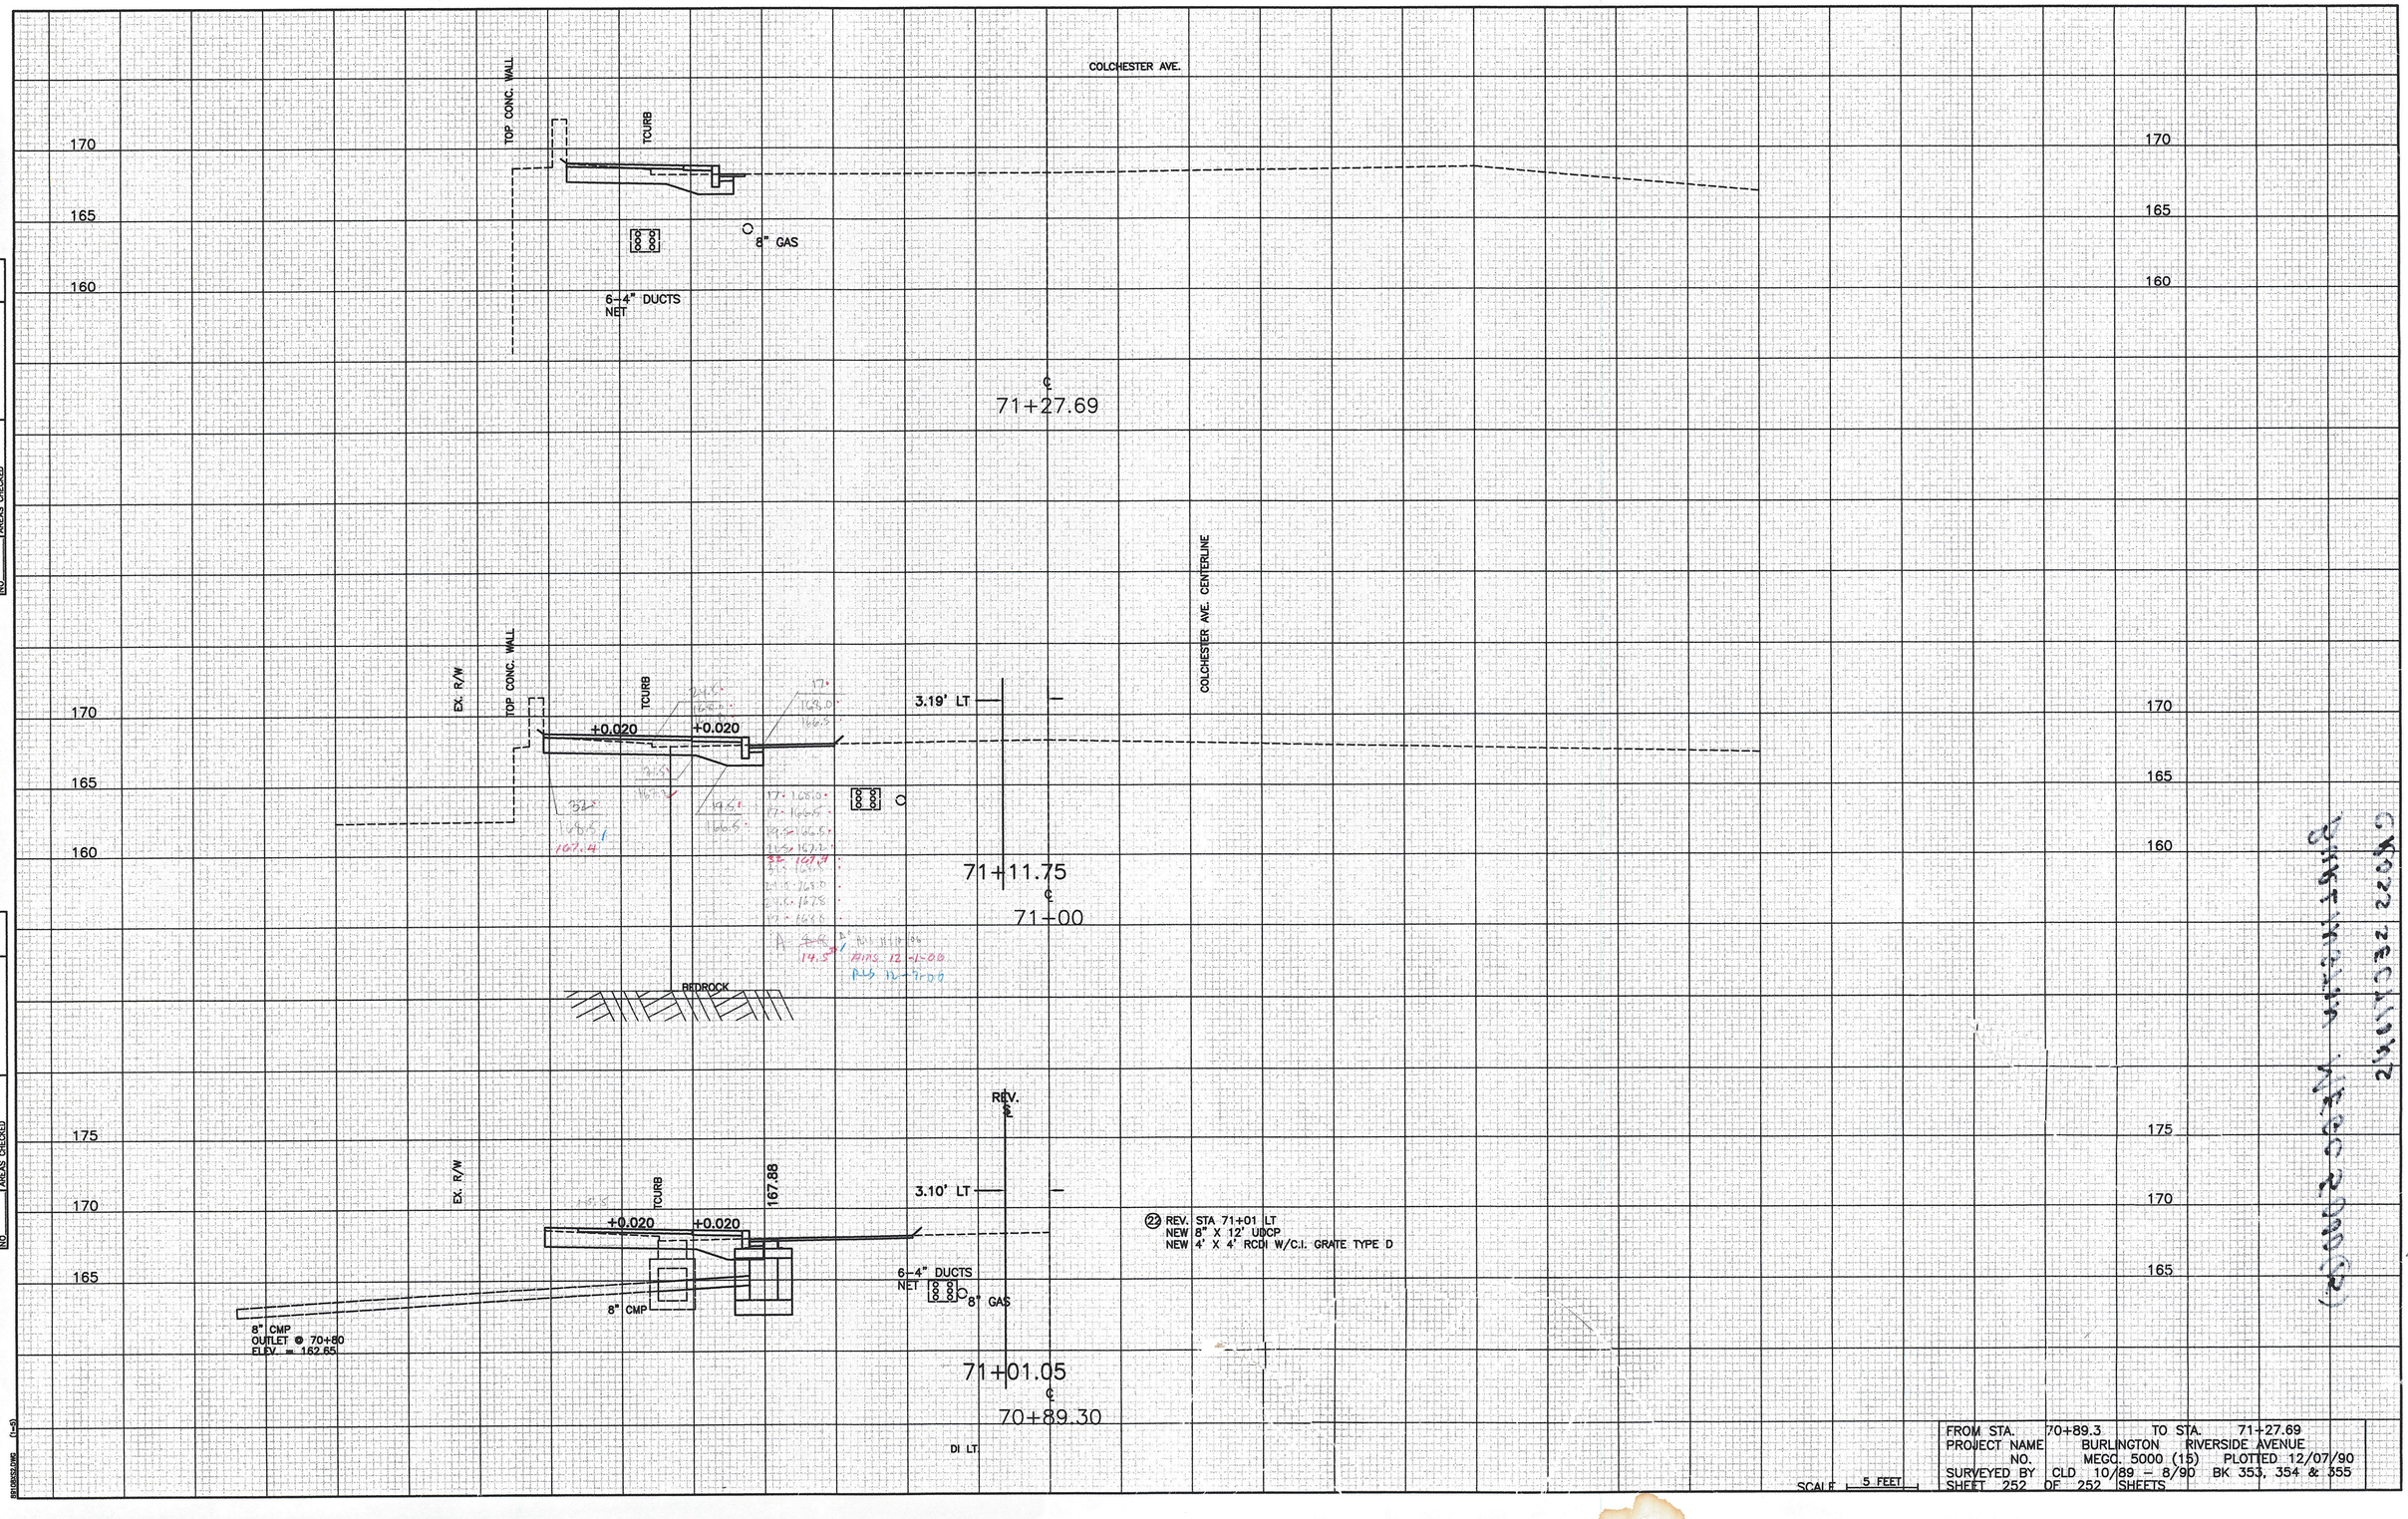

FROM STA. 70+89.3 TO STA. 71+27.69
PROJECT NAME BURLINGTON RIVERSIDE AVENUE
NO. MEGC. 5000 (15) PLOTTED 12/07/90
SURVEYED BY CLD 10/89 – 8/90 BK 353, 354 & 355
SHEET 252 OF 252 SHEETS

27"