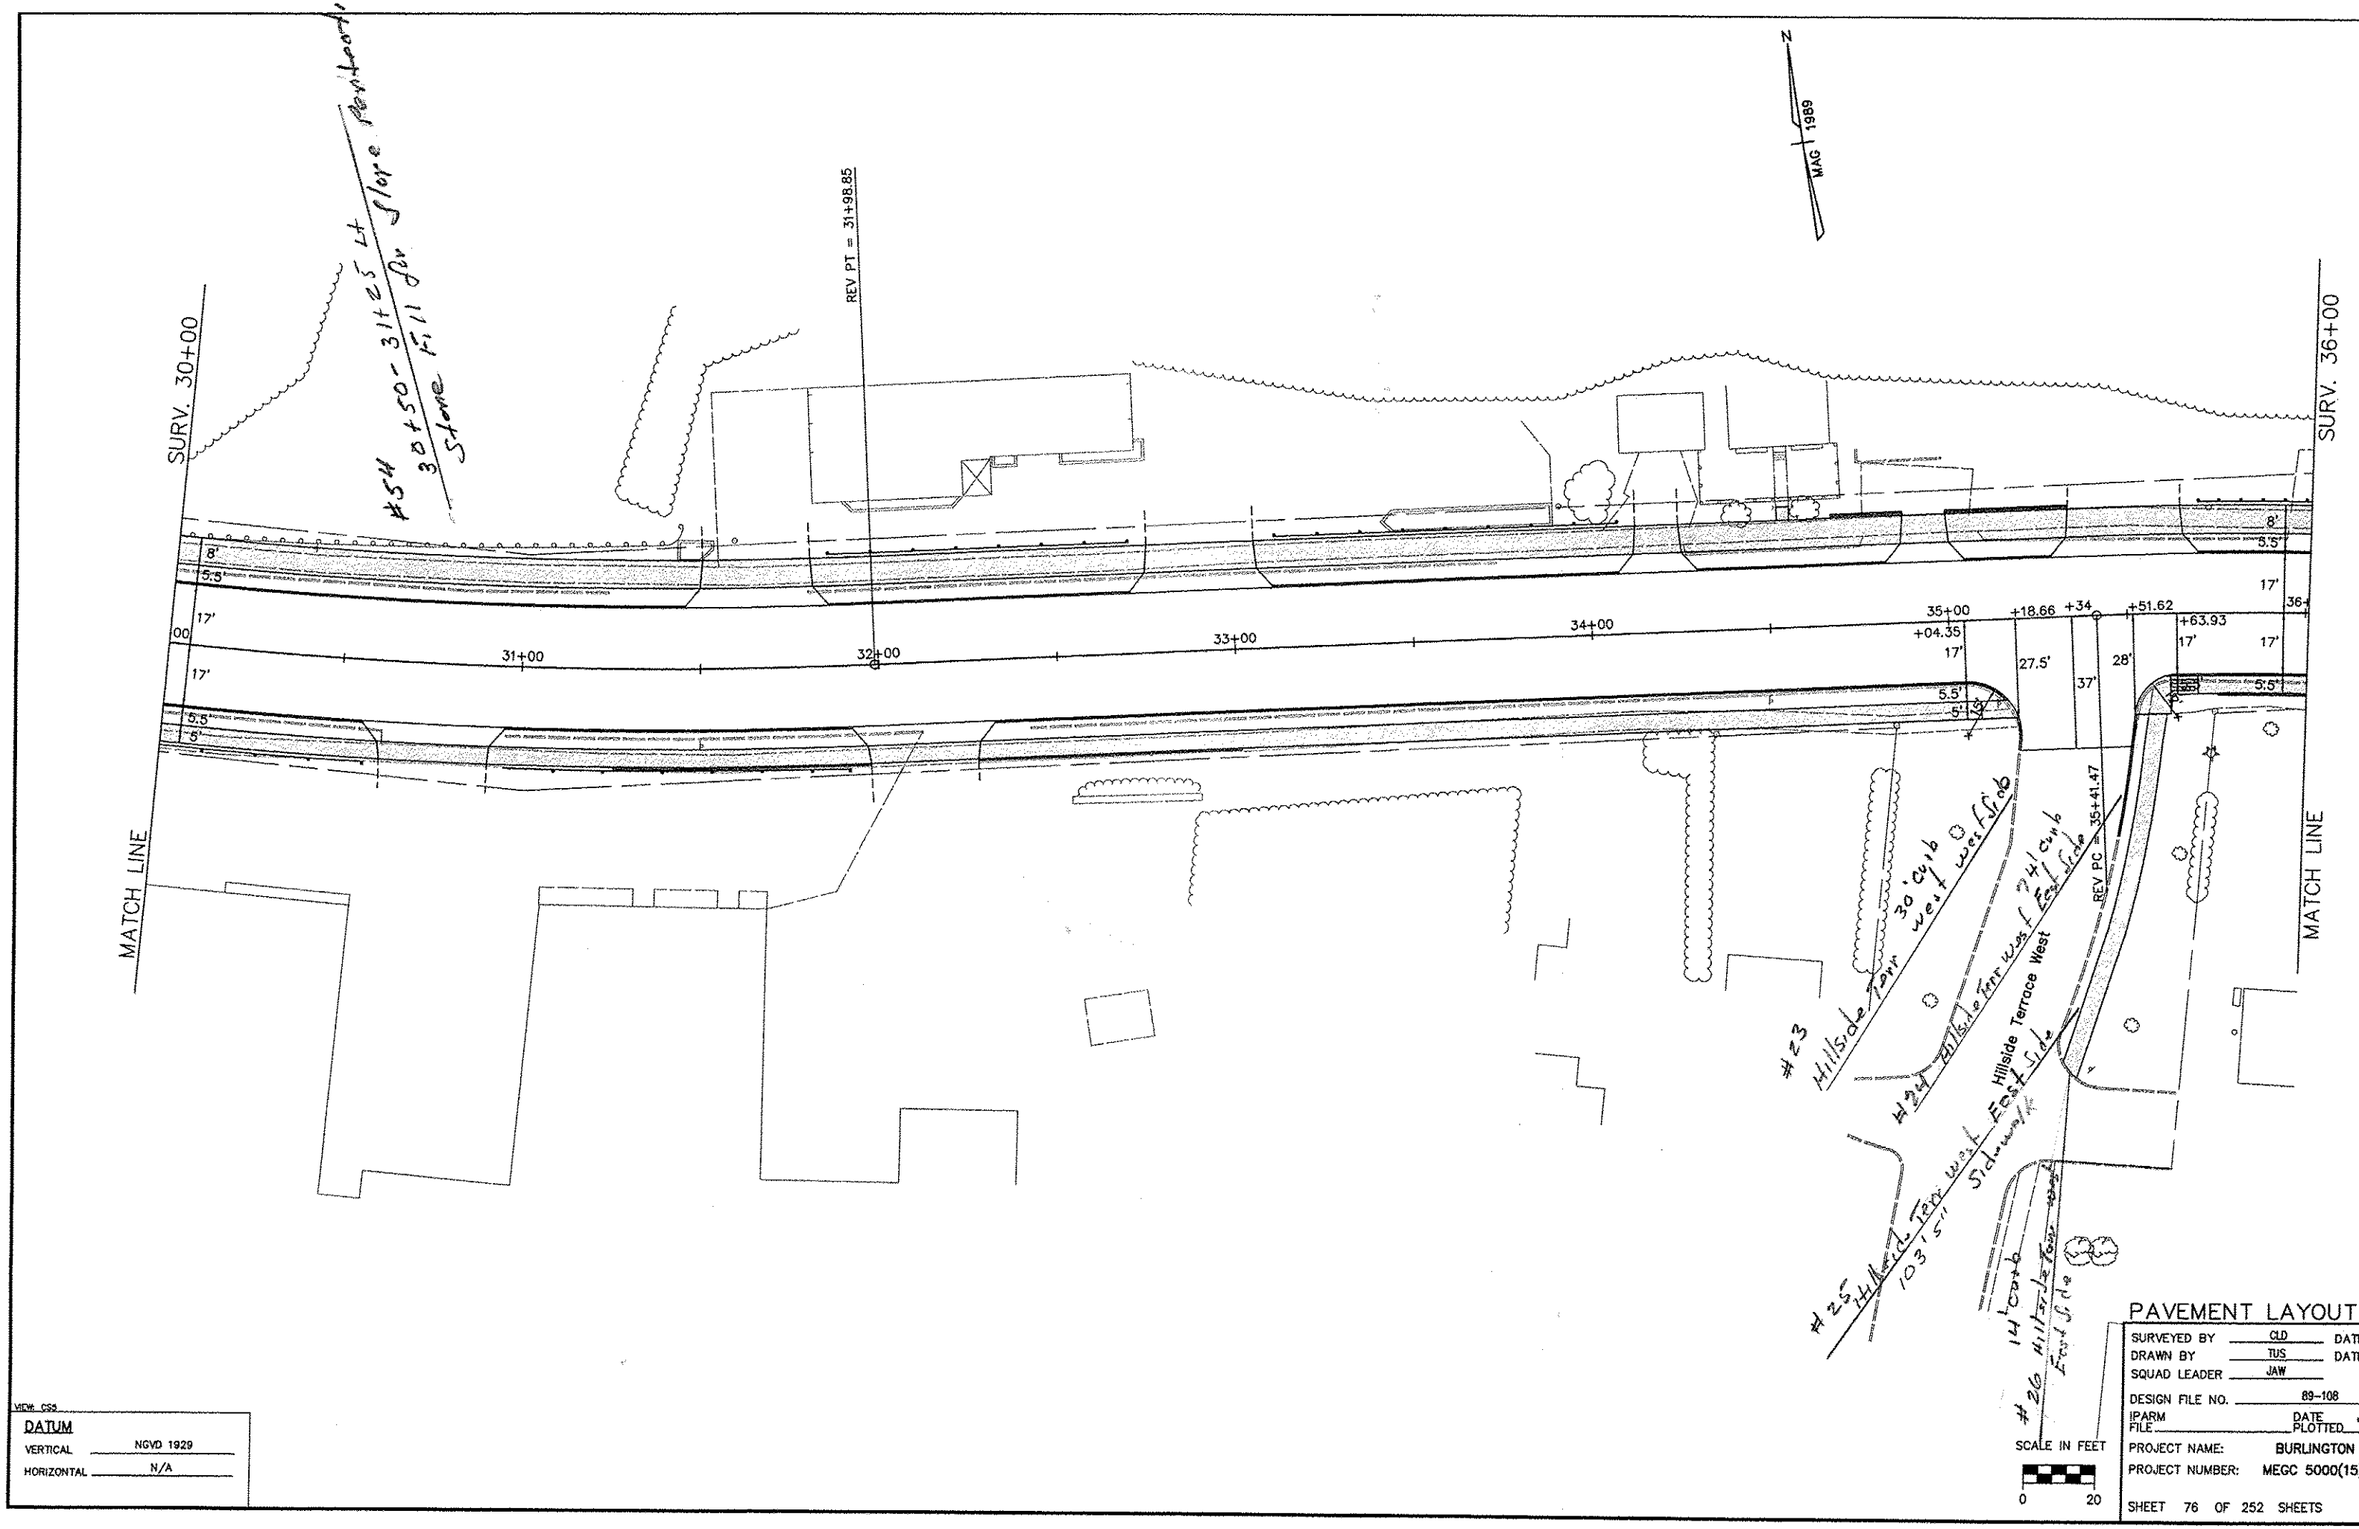

VIEW: CS5

DATUM

VERTICAL	NGVD 1929
HORIZONTAL	N/A

PAVEMENT LAYOUT

SURVEYED BY	CLD	DAT
DRAWN BY	TUS	DAT
SQUAD LEADER	JAW	
DESIGN FILE NO.	89-108	
IPARM FILE		DATE PLOTTED
PROJECT NAME:	BURLINGTON	
PROJECT NUMBER:	MEGC 5000(15	

SHEET 76 OF 252 SHEETS