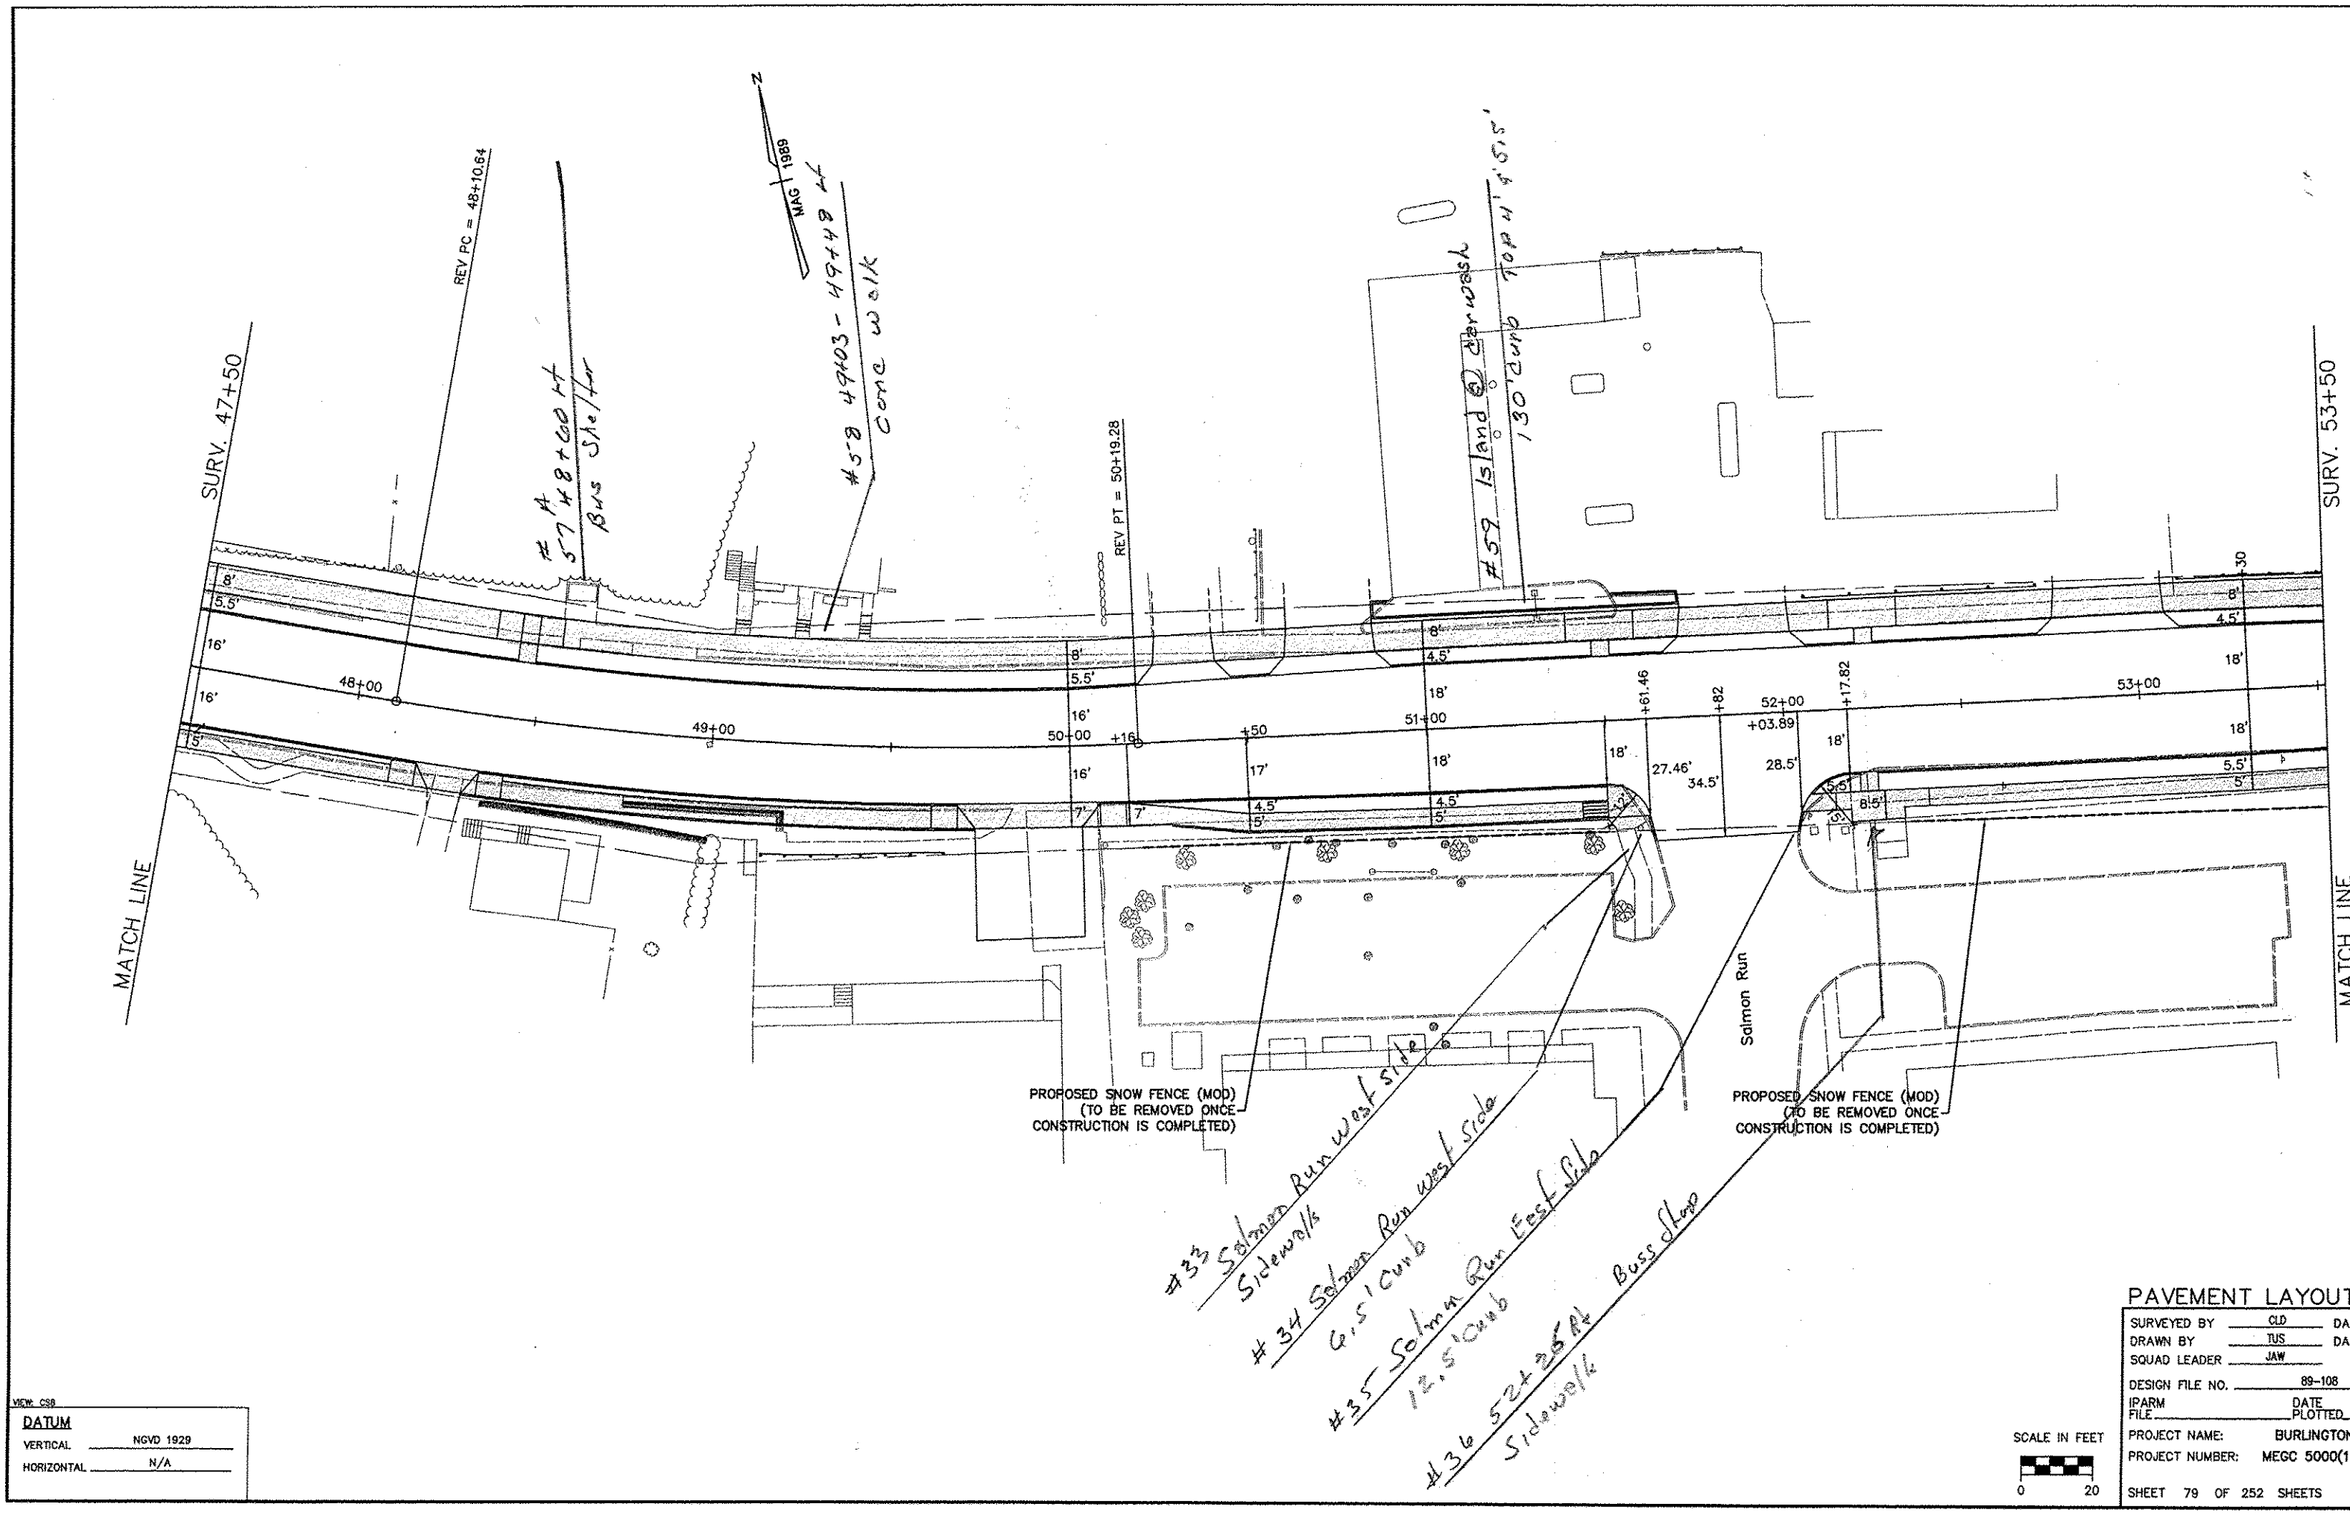

VIEW: CS8

DATUM

VERTICAL NGVD 1929

HORIZONTAL N/A

SCALE IN FEET

0 20

PAVEMENT LAYOUT

SURVEYED BY CLD DA

DRAWN BY TUS DA

SQUAD LEADER JAW

DESIGN FILE NO. 89-108

IPARM FILE DATE PLOTTED

PROJECT NAME: BURLINGTON

PROJECT NUMBER: MEGC 5000(1

SHEET 79 OF 252 SHEETS