BY GCP DATE 2/11/87 SUBJECT Pavement Marking SHEET NO. 42 OF 81

CHKD. BY _____ DATE _____ JOB NO. HMA 2001 Montpelier

Edge [redacted] n. 2' From Curb.

 

Total: 33 DRBL. LETTER IN WORD MARKING