FED.ROAD DIV.NO.	STATE	FED.AID PROJ.NO.
	VT	

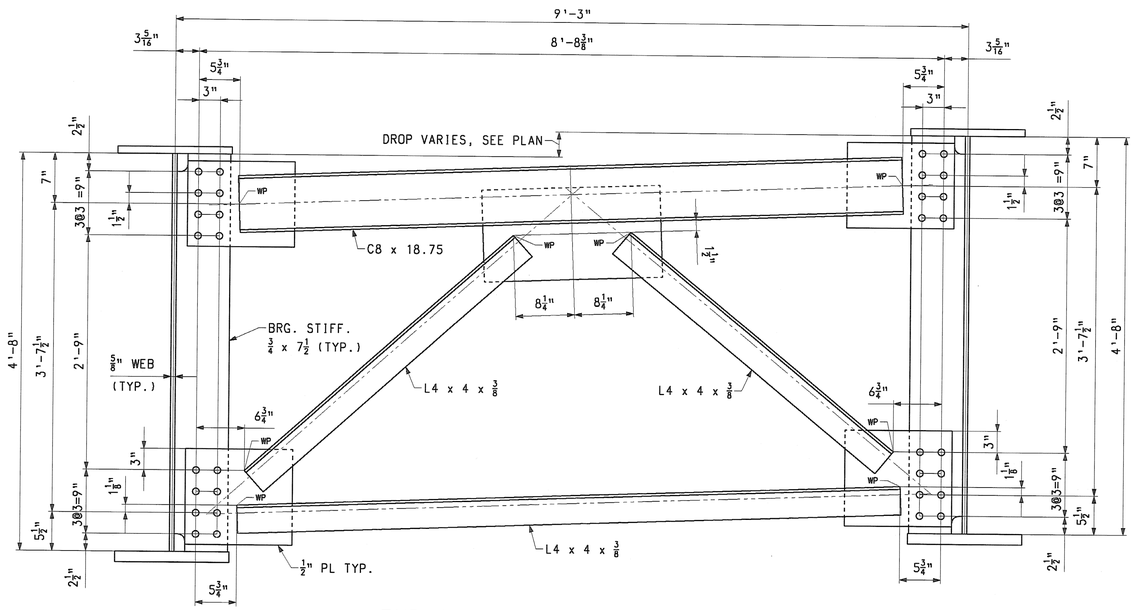

END & PIER CROSSFRAME LAYOUT

(LOOKING TOWARD BACKWALL AT ABUT.)
(LOOKING STATIONS AHEAD AT PIER)

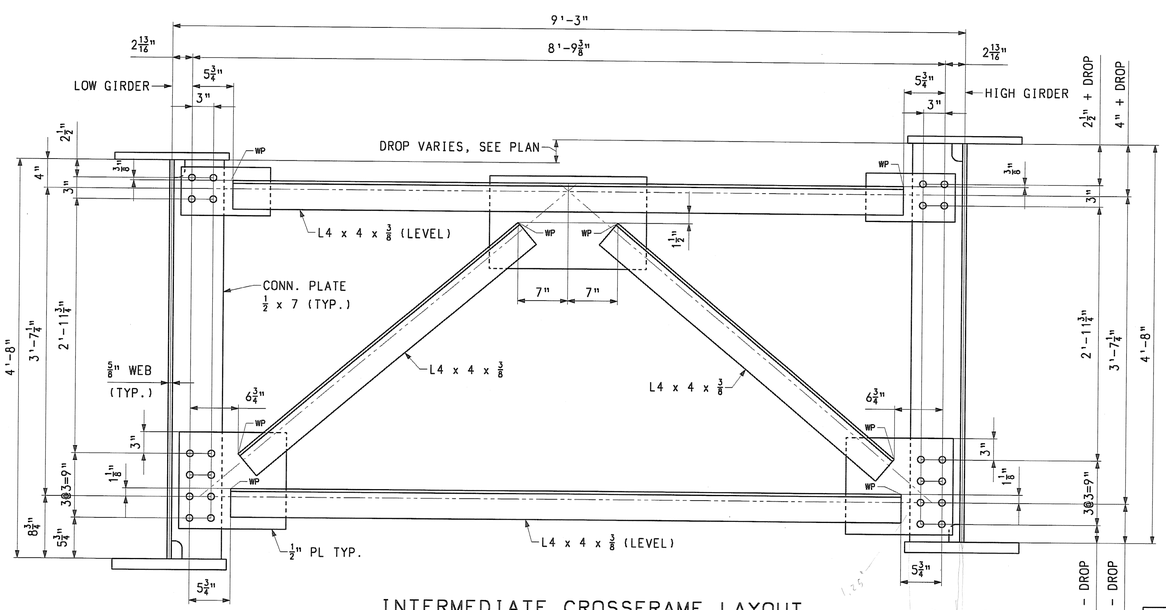

INTERMEDIATE CROSSFRAME LAYOUT

(LOOKING STATIONS AHEAD)

NOTES:

FOR NOTES, SEE DRAWING WS1.

WORK THIS DRAWING WITH WS1.

NOTE
THE PURPOSE OF THIS DRAWING IS TO COORDINATE GEOMETRIC CONTROL INFORMATION. THIS DRAWING IS SUBMITTED FOR INFORMATION ONLY AND IS NOT INTENDED FOR SHOP FABRICATION. THIS DRAWING IS FOR REFERENCE ONLY. APPROVAL IS NOT REQUIRED.

RECEIVED
CK'D BY RZ OK'D BY
JAN 30 2007
RESUBMIT APPROVED RZ
BY WY DATE 1-31-2007

NO.	REVISION	BY	DATE

HIGH STEEL STRUCTURES, INC.
1770 Hempstead Road
Lancaster, PA 17601-0008
Phone 717/299-5211
A Division of High Industries, Inc.

TYPICAL DETAILS
VT. 12 (MAIN ST.) OVER THIRD BRANCH OF THE WHITE RIVER
VT. 12 STA. 15+36.00 TO STA. 17+36.00
TOWN OF RANDOLPH, ORANGE COUNTY, VT. BRIDGE NO. 42
STATE OF VERMONT
AGENCY OF TRANSPORTATION

STATE CONTRACT OR REF. NO.: PROJECT NO. RANDOLPH BRF 0241 (29)
CONTRACTOR: WINTERSET, INC.
IN CHARGE: BRITIGAN (IH) MADE BY: RC CHK'D. BY: CS DATE: 11/6/06
CONTRACT NUMBER: VT-06215-1 DRAWING NUMBER: TD1 OF TD2

PLOTTED: DATE5678901234567 BY: USERNAME

06215 X2 1/25/07 Final Approval and Distribution TO:Winterset, Inc.