ABM INFO		SHIP	BILL OF MATERIAL					JOB NO.	DRAWING NO.	REV.
								369	5	
PAGE	LINE	MARK	QTY	MARK	MATERIAL	LENGTH FT	LENGTH INCHES	REMARKS	WT	PROCUREMENT NOTES
					DIAPHRAGMS					
2	G		12	5D1	W 30x90	9	4			

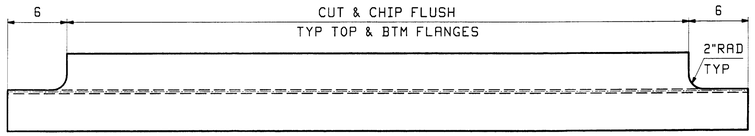

VIEW "A-A"

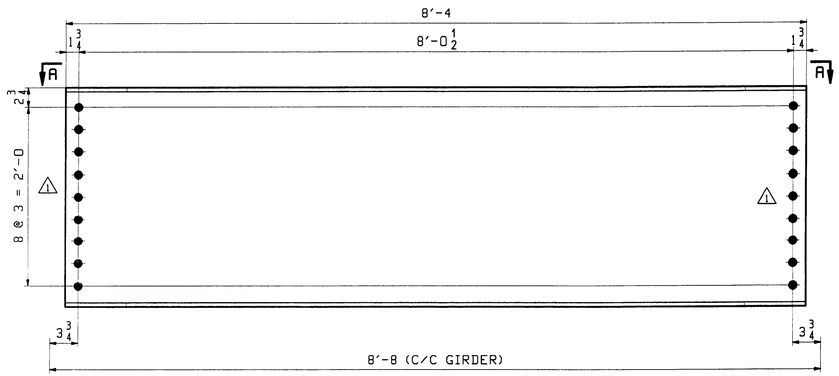

12 ~ INT. DIAPHRAGMS - 5D1

REV.	DATE	REMARKS	DWN	CHK	APVL	SHOP
1	6/18	ADDED HOLES (INT. DIAPH.)	ZAD	WL	5/28/08 6/20/08	

MATERIAL	SURFACE PREP & PAINT.	HOLES.	SHOP BOLTS
A709-50W	SEE DWG GN1	15/16"ø	NONE

DESCRIPTION: DIAPHRAGMS

CASCO BAY STEEL STRUCTURES, INC.
75 SPRING HILL ROAD SACO, MAINE 04072
PHONE (207) 282-7360 FAX. (207) 282-1179
TENSOR 2795

STRUCTURE:	ROUTE No. VT 11 MINOR ARTERIAL BRIDGE NO. 43 OVER MIDDLE BRANCH OF WILLIAMS RIVER TOWN OF CHESTER COUNTY OF WINDSOR	DRAWN: JTB	DATE: 05/01
		CHKD: JF	DATE: 05/21
LOCATION:	CHESTER, VT	JOB NO.	DWG NO.
PROJ NO.	BRF 016-1(25)	369	5
CUSTOMER:	VT AOT		REV. 1