GPW 10/1/08

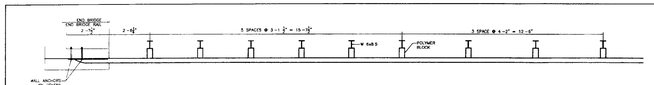

PLAN

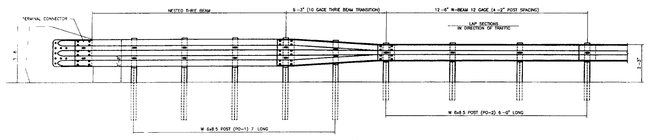

ELEVATION

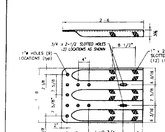
2'-8"
3/4"
5/8 x 2-1/2 SLOTTED HOLES (2 LOCATIONS AS SHOWN)
8 1/2"
1" HOLES (8 LOCATIONS (Typ))
1" x 2-1/2" OBLONG SLOTTED HOLES (12 LOCATIONS (Typ))
1"
2 1/4"
2 1/4"
1 3/4"
1 3/4"
1 3