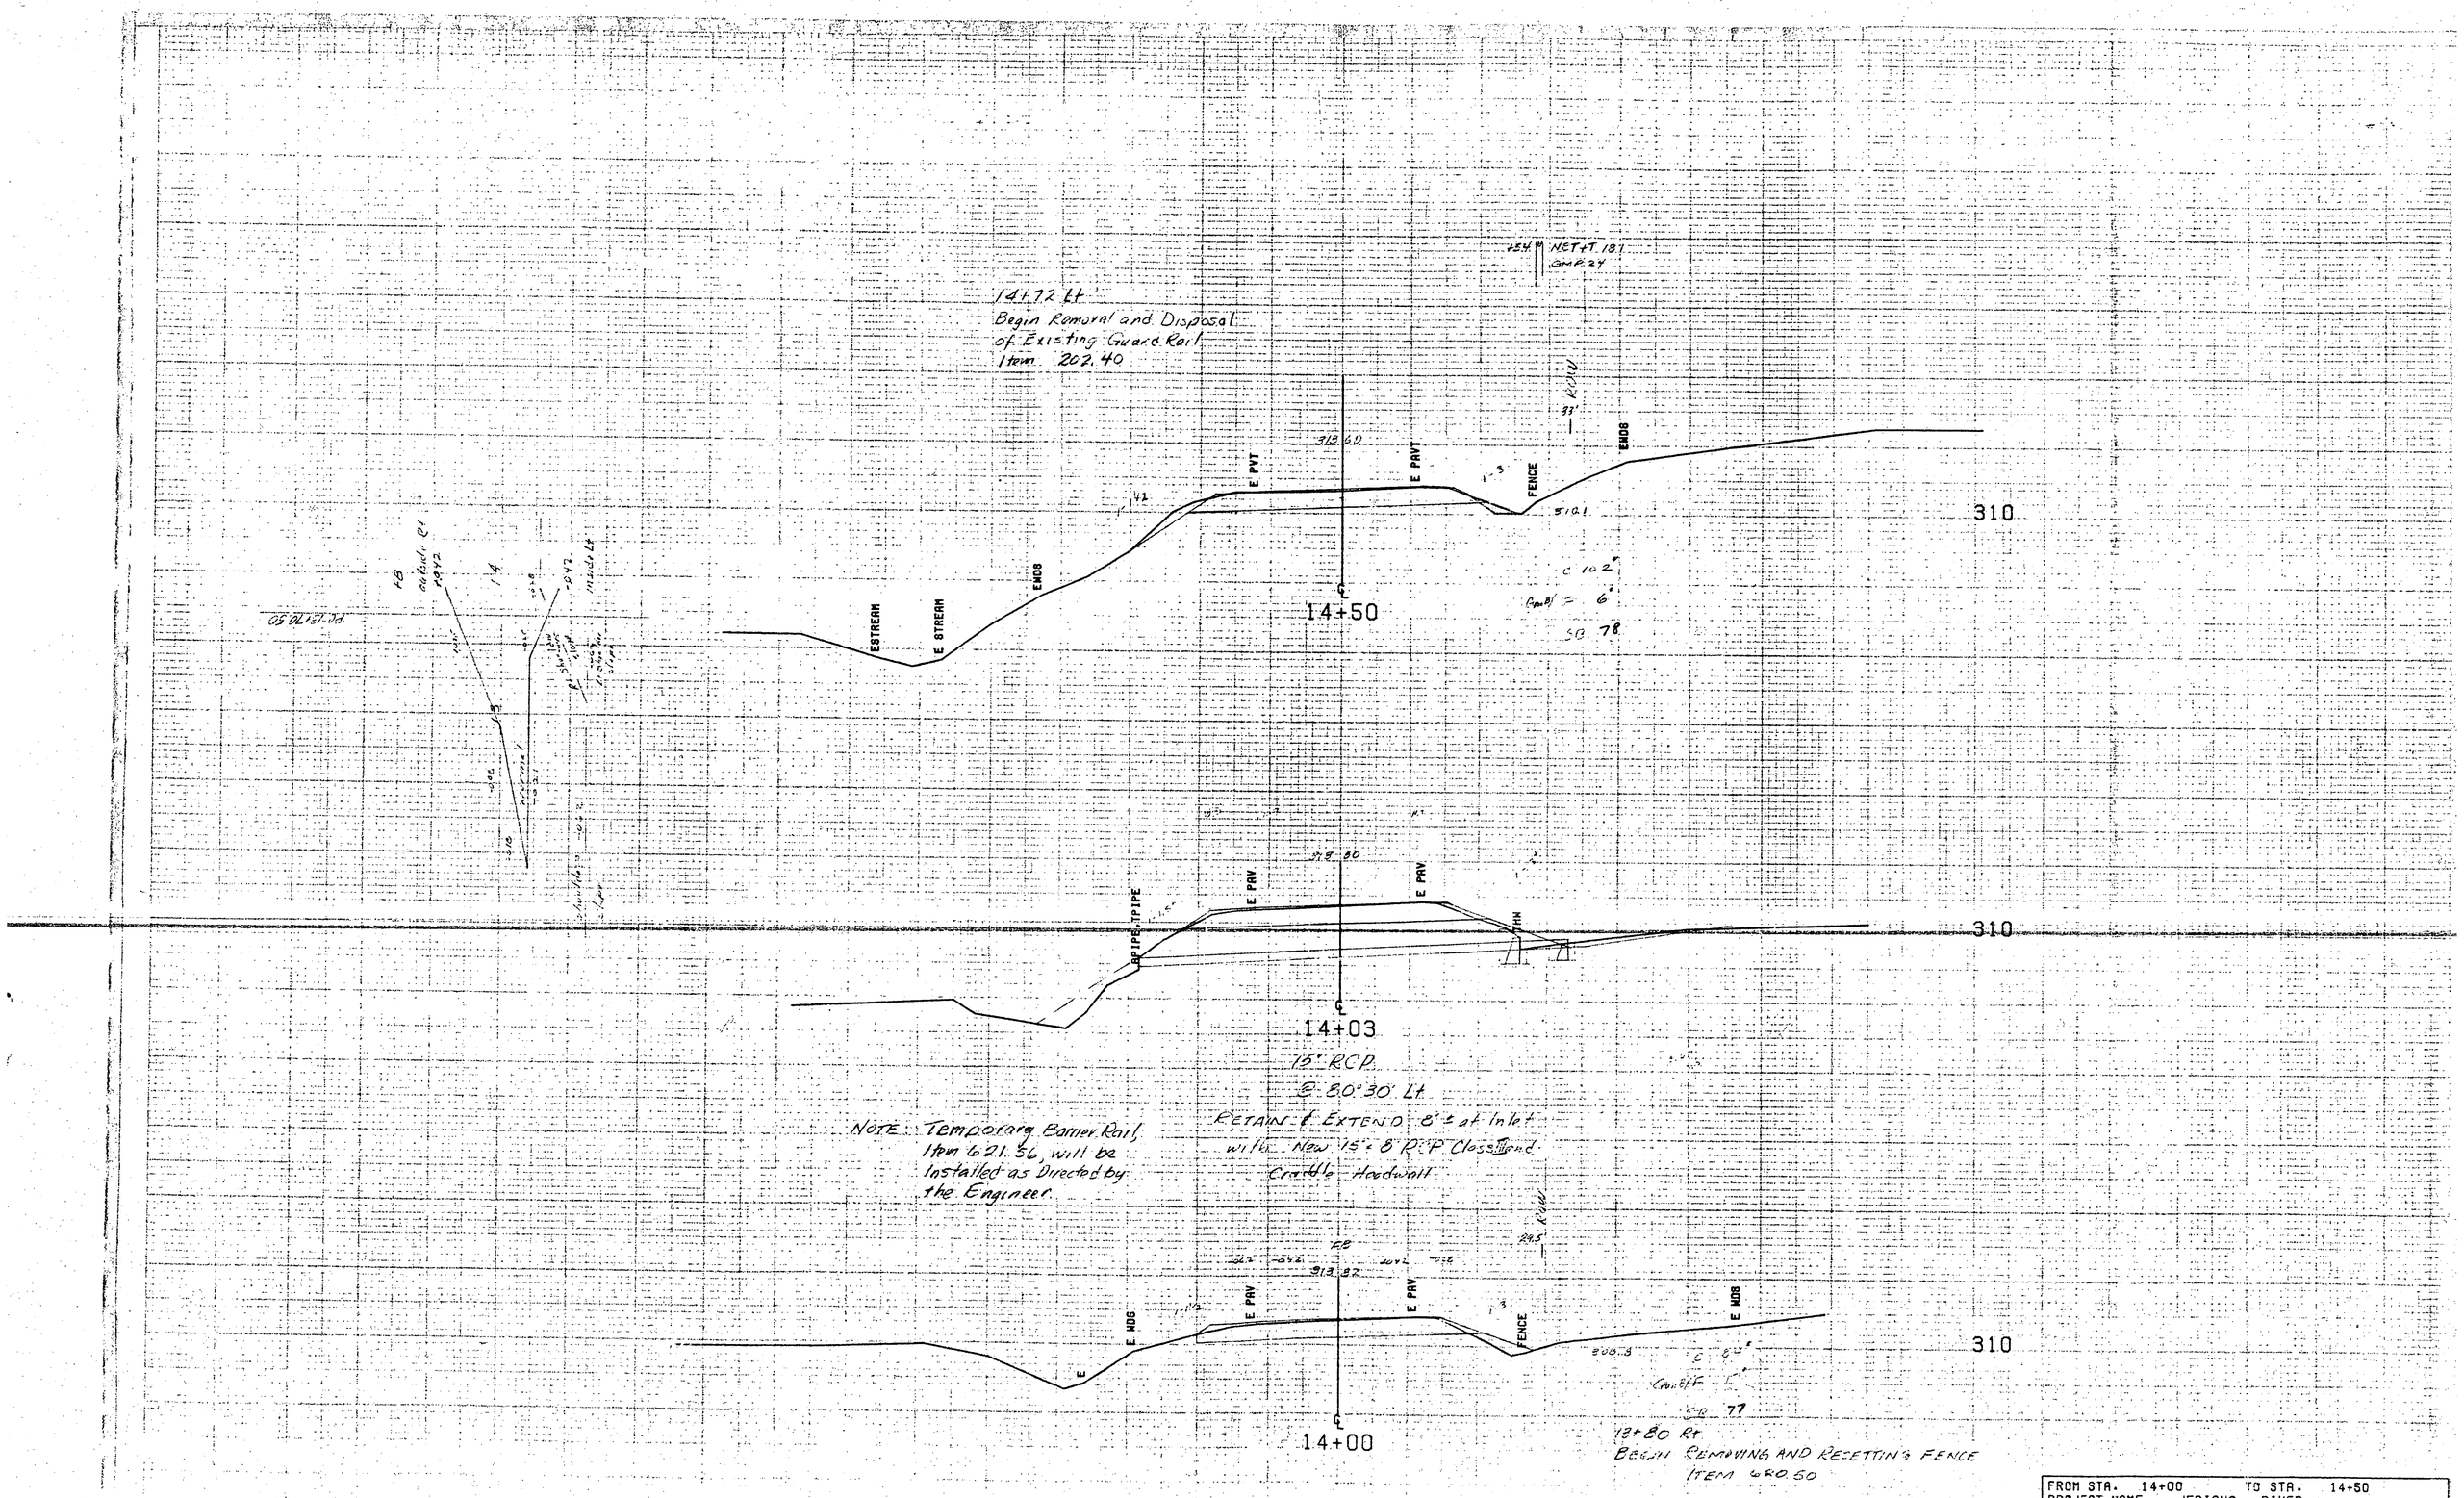

FROM STA. 14+00	TO STA. 14+50
PROJECT NAME JERICHO RIVER	
NO. RS0224(3)	PLOTTED 01/17/84
SURVEYED BY BEARD	JAN 1984
SHEET 27 OF 60 SHEETS	