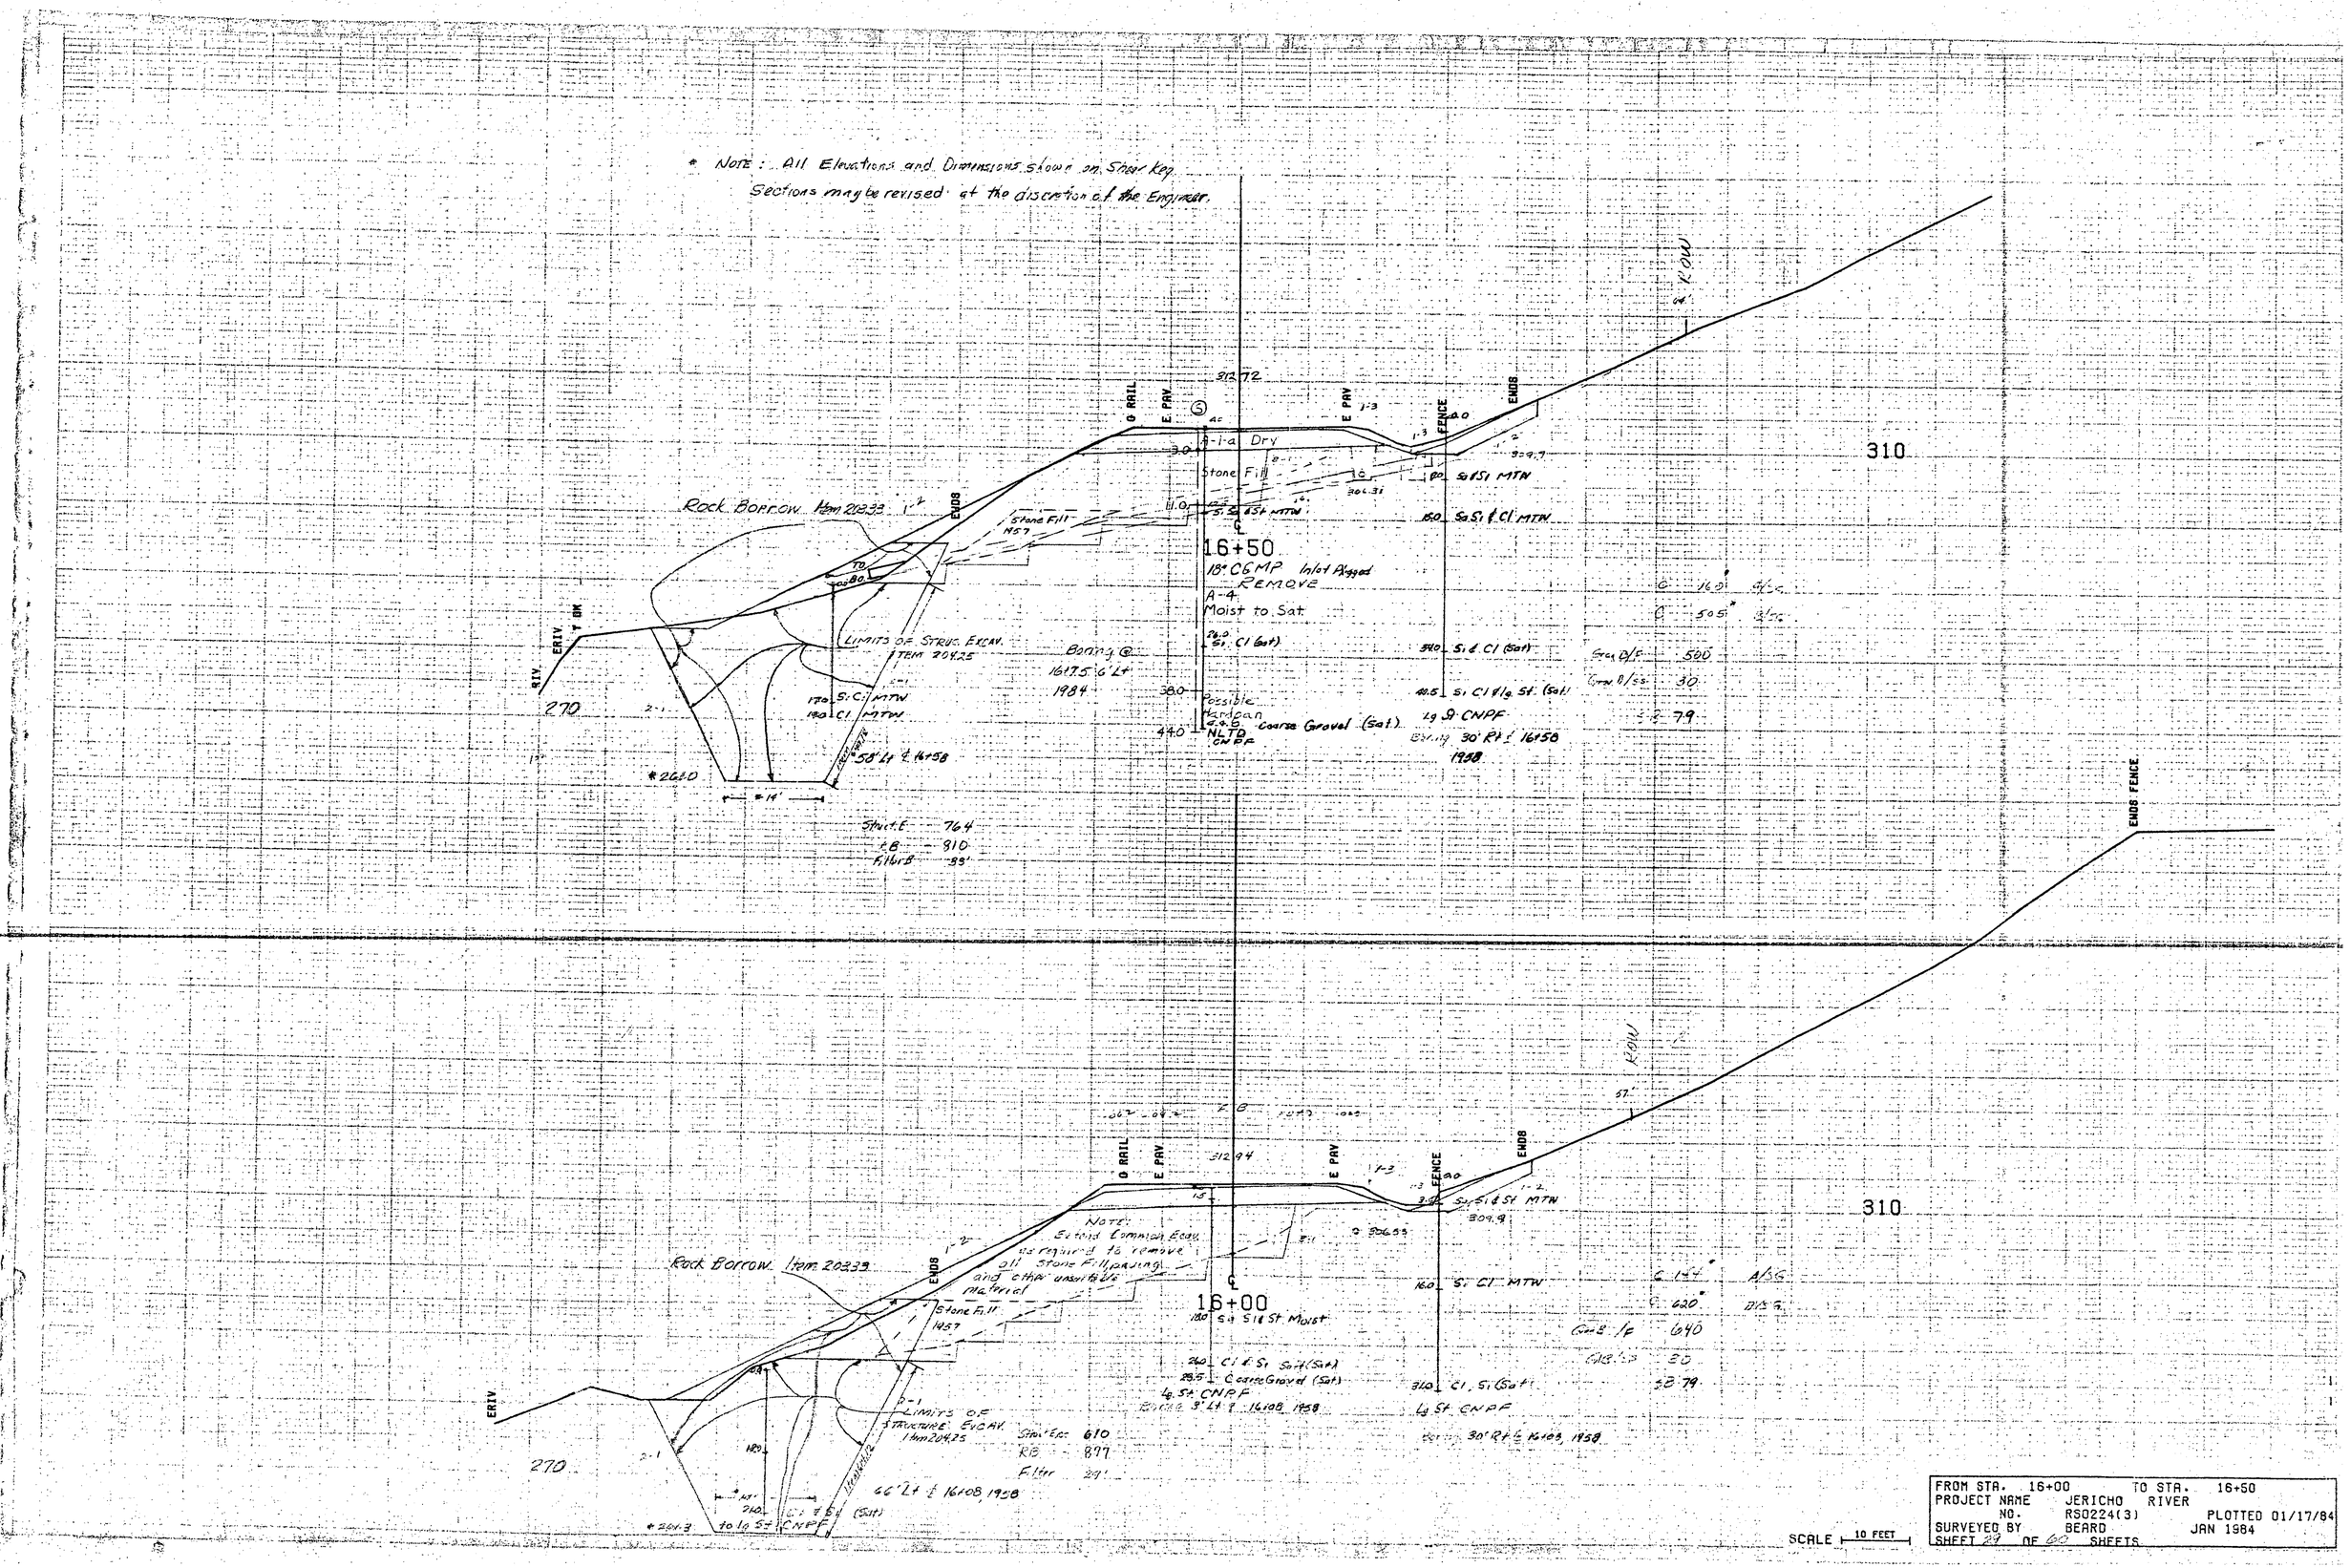

FROM STA. 16+00	TO STA. 16+50
PROJECT NAME JERICHO RIVER	
NO. RS0224(3)	PLOTTED 01/17/84
SURVEYED BY BEARD	JAN 1984
SHEET 29 OF 60 SHEETS	