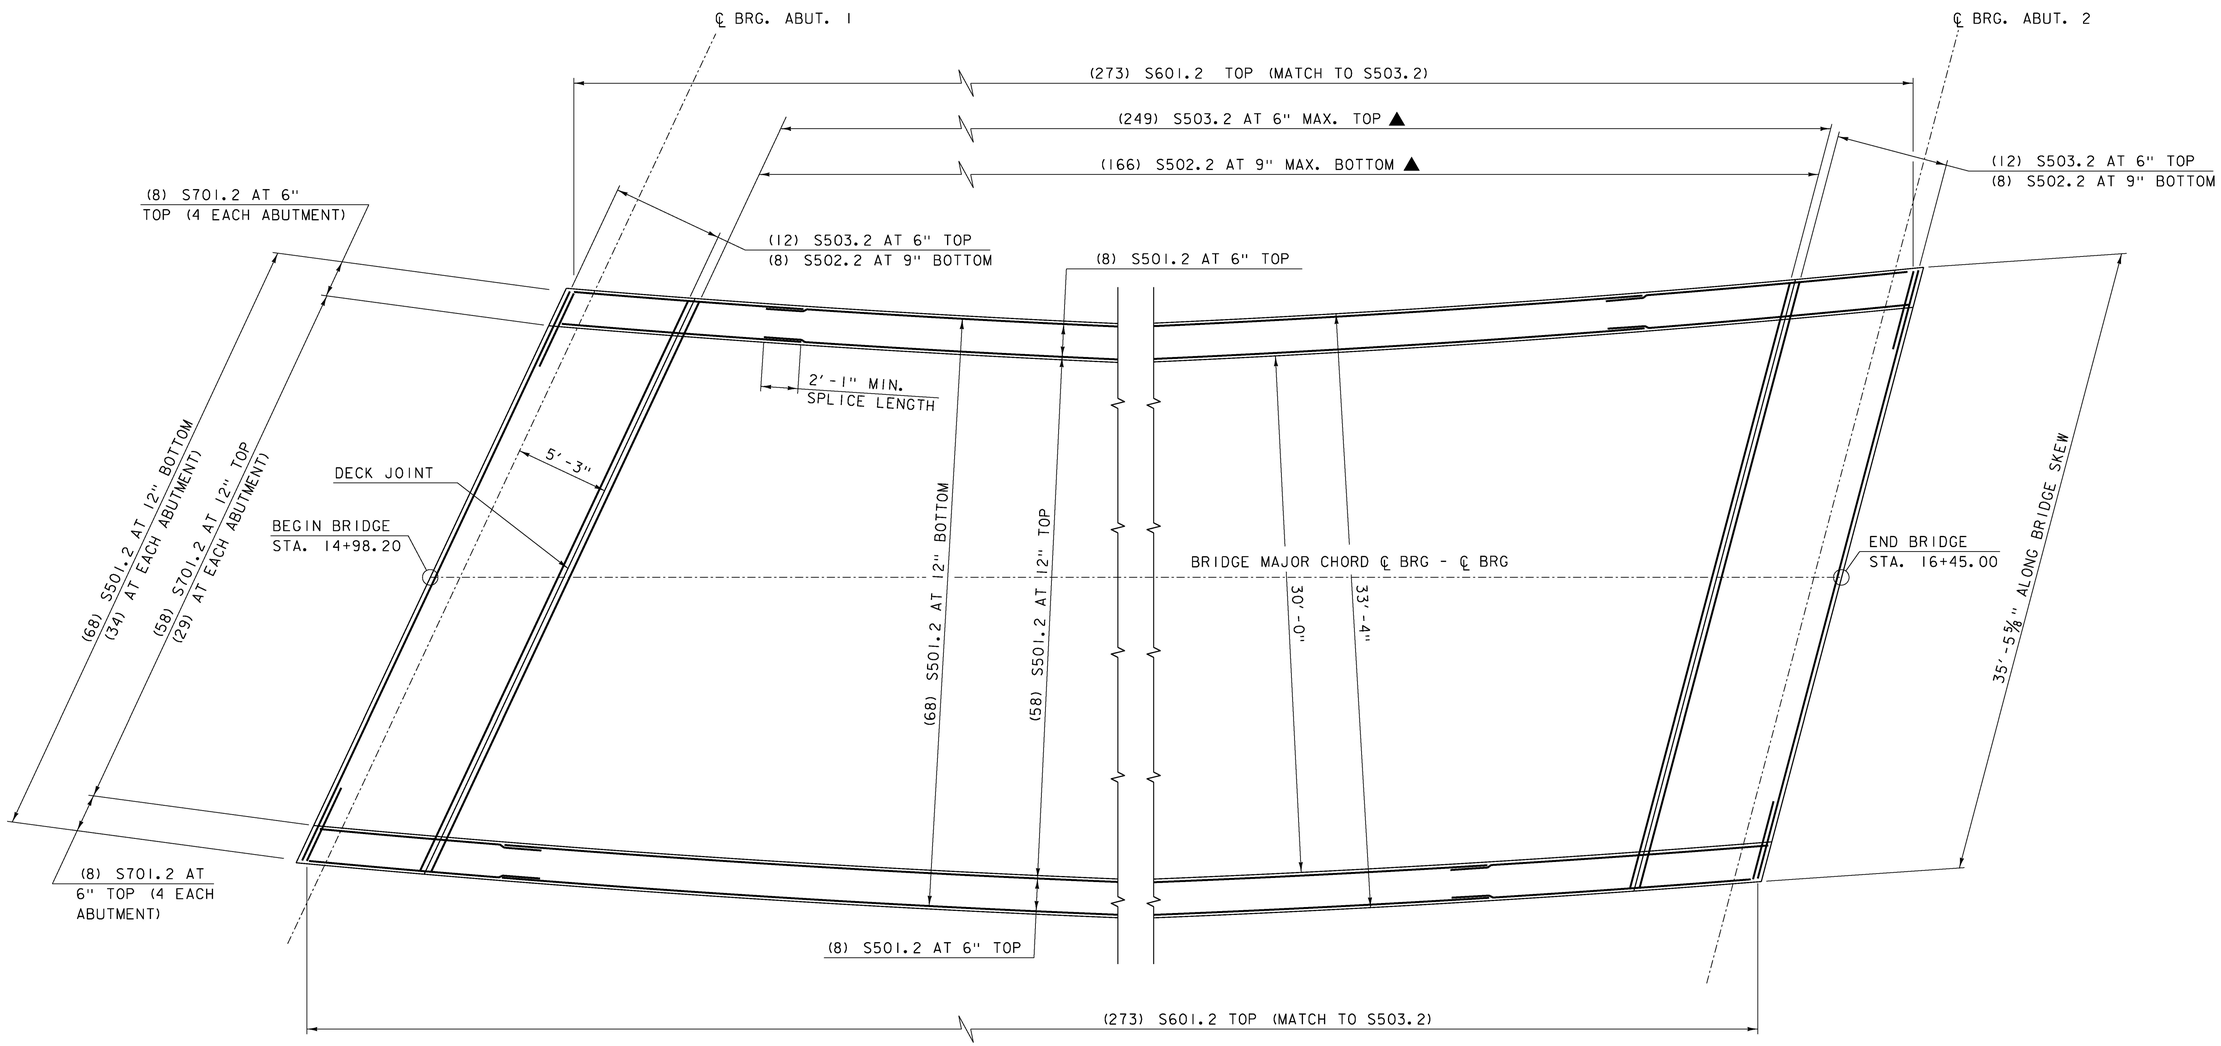

BRIDGE DECK REINFORCING PLAN

SCALE: 1/4" = 1'-0"

PROJECT NAME: STOWE	
PROJECT NUMBER: BRF 0235(15)	
FILE NAME: z88c190sup.dgn	PLOT DATE: 5/8/2015
PROJECT LEADER: J. BYATT	DRAWN BY: M. SMITH
DESIGNED BY: J. FRENCH	CHECKED BY: J. BYATT
DECK REINFORCING PLAN	SHEET 36 OF 79

CONSULTING ENGINEERS

CLD 12-020 MODEL: Deck Reinforcing Plan