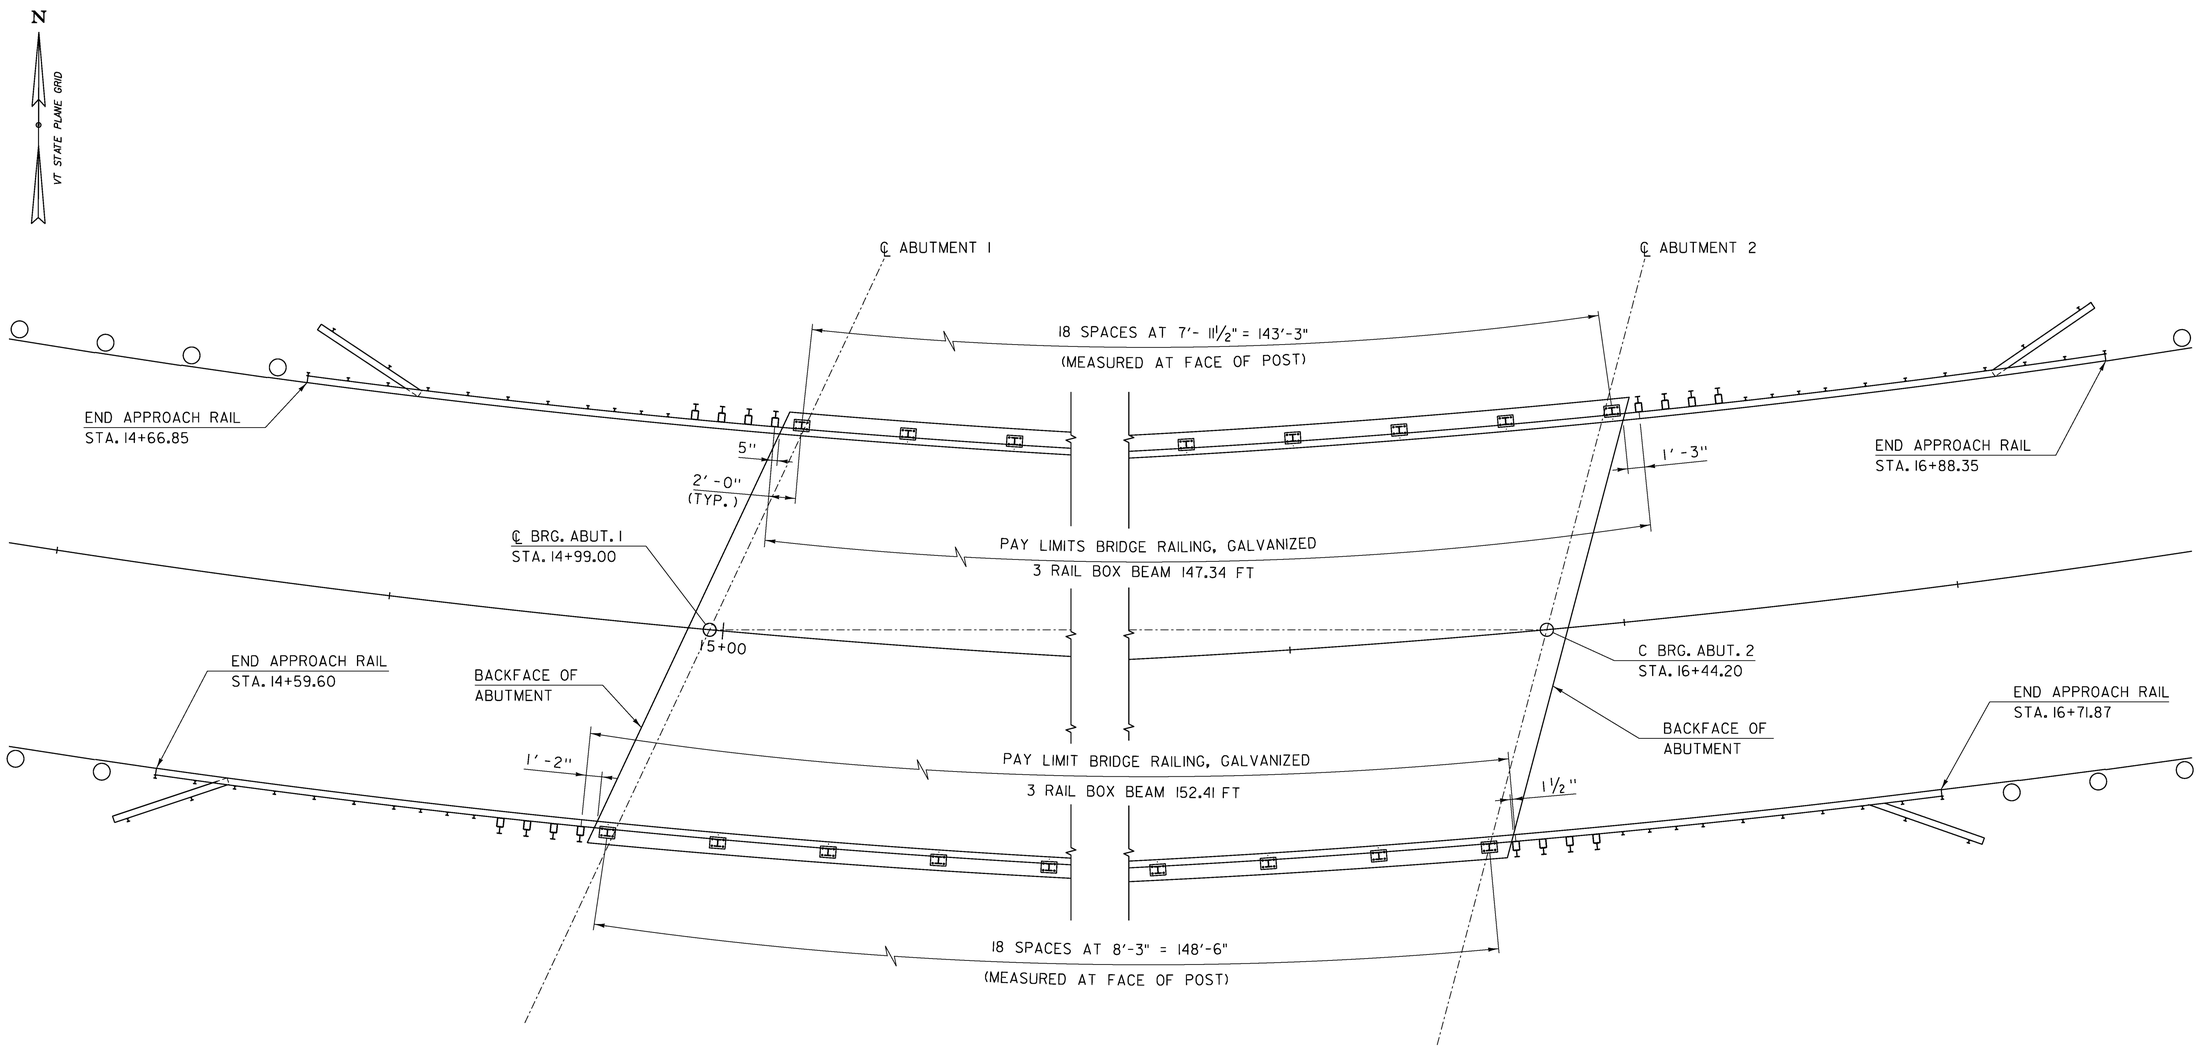

BRIDGE RAIL LAYOUT

SCALE: 3/16" = 1'-0"

CLD 12-0120 MODEL: RailLayout

PROJECT NAME: STOWE	
PROJECT NUMBER: BRF 0235(15)	
FILE NAME: z88c190rail.dgn	PLOT DATE: 5/8/2015
PROJECT LEADER: J. BYATT	DRAWN BY: M. SMITH
DESIGNED BY: J. FRENCH	CHECKED BY: J. BYATT
BRIDGE RAIL LAYOUT	SHEET 52 OF 79

CLD CONSULTING ENGINEERS