Record Plans
Contractor: CCS CONSTRUCTORS, INC.
Resident Engineer: ROBERT SUCKERT
Construction Began: OCTOBER 19, 2015
Construction Complete: SEPTEMBER 14, 2017
Record Plans By: ROBERT SUCKERT


I hereby certify that all construction required by this set of drawings has been accomplished as indicated herein.

BY: e-Signed by Robert Suckert on 2018-10-09 17:03:33 GMT _____ Resident Engineer

Date: October 09, 2018

NOTE: Any further information concerning final quantities, amounts or other details relative to this project may be found at Central Files in the electronic archives.

# STATE OF VERMONT
# AGENCY OF TRANSPORTATION

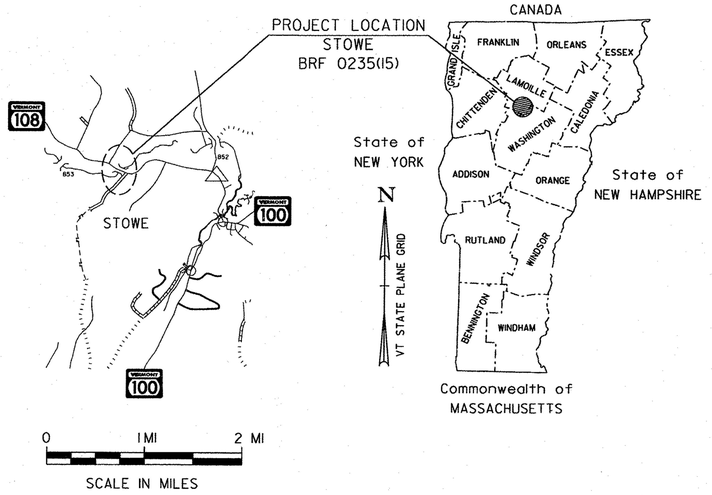



# PROPOSED IMPROVEMENT
# BRIDGE PROJECT
# TOWN OF STOWE
# COUNTY OF LAMOILLE
# VT ROUTE 108 (MAJOR COLLECTOR) BRIDGE NO. 3

PROJECT LOCATION: LOCATED IN TOWN OF STOWE ON VT ROUTE 108 APPROXIMATELY 1.5 MILES WEST OF THE JUNCTION WITH VT ROUTE 100.

PROJECT DESCRIPTION: WORK TO BE PERFORMED UNDER THIS PROJECT INCLUDES REPLACEMENT OF EXISTING STRUCTURE WITH A NEW STRUCTURE INCLUDING RELATED ROADWAY ITEMS, TEMPORARY BRIDGE, AND CHANNEL WORK.

LENGTH OF STRUCTURE: 146.80 FEET
LENGTH OF ROADWAY: 753.20 FEET
LENGTH OF PROJECT: 900.00 FEET

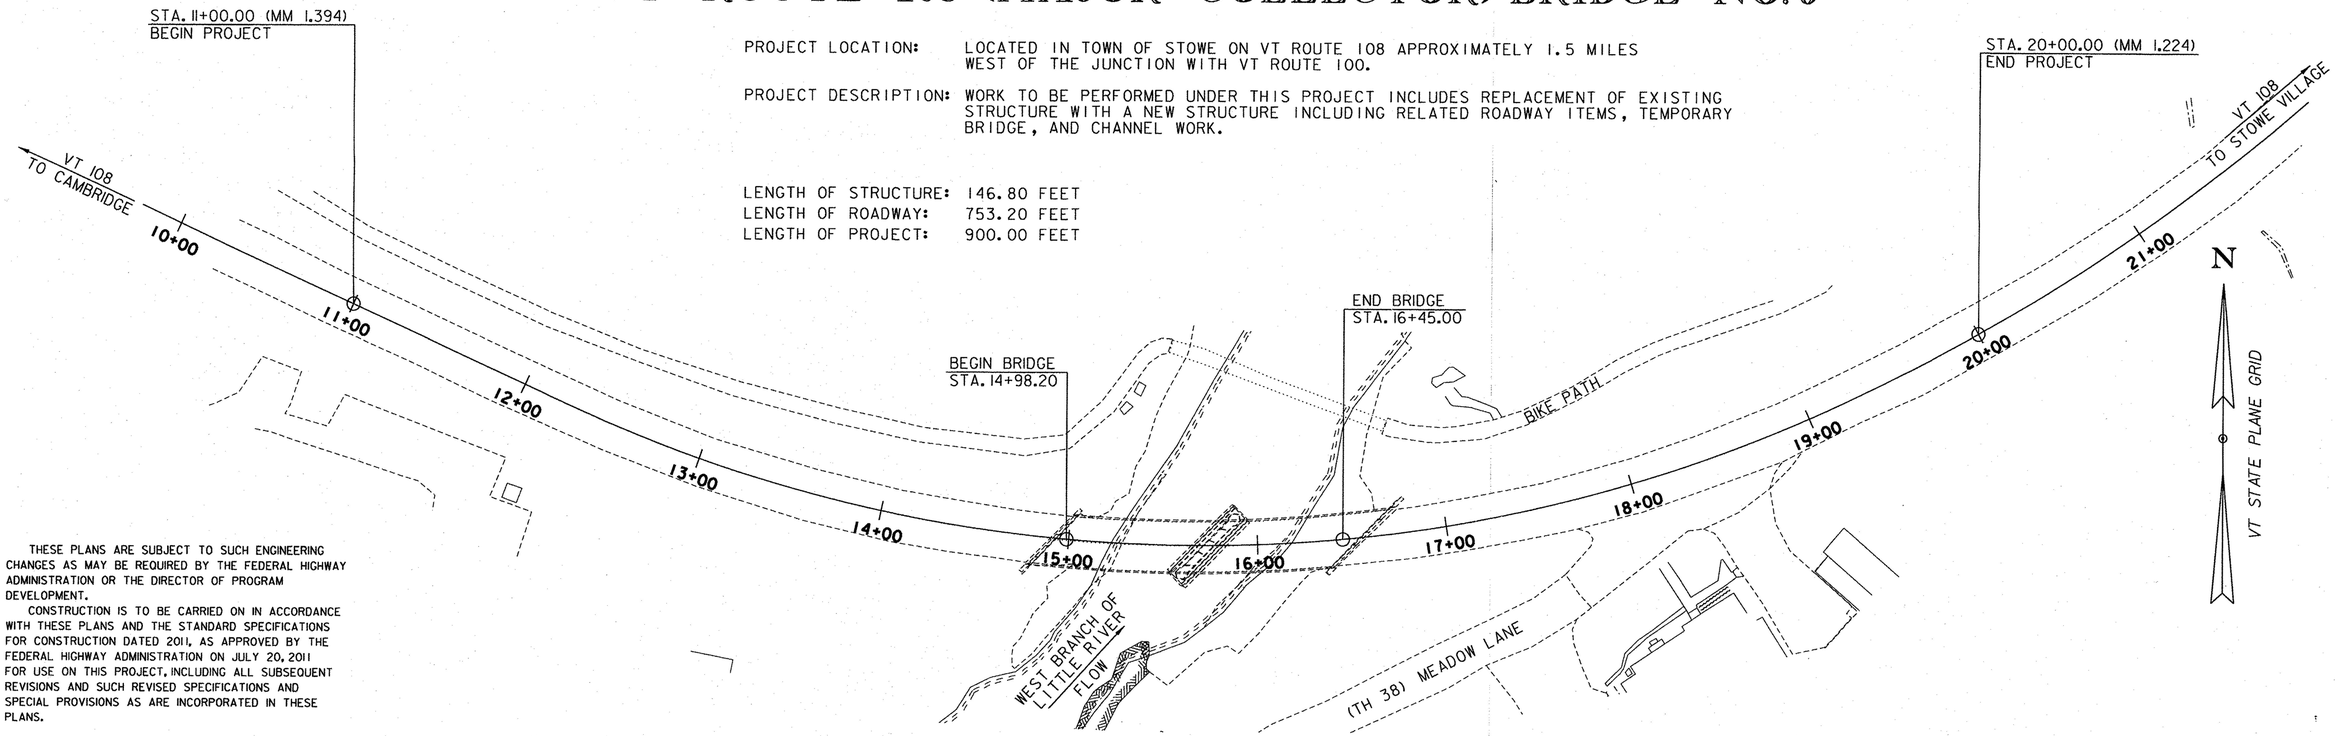


THESE PLANS ARE SUBJECT TO SUCH ENGINEERING CHANGES AS MAY BE REQUIRED BY THE FEDERAL HIGHWAY ADMINISTRATION OR THE DIRECTOR OF PROGRAM DEVELOPMENT.

CONSTRUCTION IS TO BE CARRIED ON IN ACCORDANCE WITH THESE PLANS AND THE STANDARD SPECIFICATIONS FOR CONSTRUCTION DATED 2011, AS APPROVED BY THE FEDERAL HIGHWAY ADMINISTRATION ON JULY 20, 2011 FOR USE ON THIS PROJECT, INCLUDING ALL SUBSEQUENT REVISIONS AND SUCH REVISED SPECIFICATIONS AND SPECIAL PROVISIONS AS ARE INCORPORATED IN THESE PLANS.

| |
|---|
| QUALITY ASSURANCE PROGRAM : LEVEL 2 |
| SURVEYED BY : VTRANS<br>SURVEYED DATE : 07/20/2011 |
| DATUM<br>VERTICAL NAVD 88<br>HORIZONTAL NAD83 (1996) |

MODEL: TITLE
CLD 12-0120

STATE OF VERMONT JOHN P. BYATT NO. 8478 Structural LICENSED PROFESSIONAL ENGINEER

STATE OF VERMONT CHRISTOPHER R. GERT No. 8529 REGISTERED PROFESSIONAL ENGINEER


CLD CONSULTING ENGINEERS
540 Commercial Street
Manchester, NH 03101
(603) 668-8223
www.cldengineers.com


DIRECTOR OF PROJECT DELIVERY
APPROVED Kevin S. Marshia DATE 5/11/15

PROJECT MANAGER : ROB YOUNG, P.E.

PROJECT NAME : STOWE
PROJECT NUMBER : BRF 0235(15)

SHEET 1 OF 79 SHEETS

STATE OF VERMONT
AGENCY OF TRANSPORTATION

# PRELIMINARY INFORMATION SHEET (BRIDGE)

Version 11.06.15

**LRFD**

## INDEX OF SHEETS

### PLAN SHEETS


| | |
|---|---|
| 1 | TITLE SHEET |
| 2 | PRELIMINARY INFORMATION SHEET |
| 3 - 5 | TYPICAL SHEETS 1-3 |
| 6 | MISCELLANEOUS DETAILS |
| 7 | TYPICAL EARTHWORK SECTIONS |
| 8 - 10 | QUANTITY SHEETS 1-3 |
| 11 | BRIDGE QUANTITY SHEET |
| 12 | PROJECT NOTES |
| 13 | CONVENTIONAL SYMBOLOGY LEGEND SHEET |
| 14 - 15 | TIE SHEETS 1-2 |
| 16 - 17 | LAYOUT SHEETS 1-2 |
| 18 - 19 | VT 108 PROFILE SHEETS 1-2 |
| 20 | MATERIAL TRANSITION AND BANKING DIAGRAM |
| 21 | MEADOW LANE PROFILE SHEET |
| 22 | UTILITY RELOCATION SHEET |
| 23 | TRAFFIC CONTROL SHEET |
| 24 | TRAFFIC CONTROL PROFILE SHEET |
| 25 | TRAFFIC CONTROL SIGN PLAN |
| 26 - 27 | TRAFFIC SIGN & LINE LAYOUT SHEETS 1-2 |
| 28 | TRAFFIC SIGN SUMMARY SHEET |
| 29 | LANDSCAPE LAYOUT SHEET |
| 30 | LANDSCAPE DETAILS |
| 31 | BORING INFORMATION SHEET |
| 32 - 33 | BORING LOGS 1-2 |
| 34 | PLAN AND ELEVATION |
| 35 | TYPICAL BRIDGE SECTION |
| 36 | DECK REINFORCING PLAN |
| 37 - 38 | FRAMING PLAN AND DETAILS 1-2 |
| 39 | SPLICE DETAILS |
| 40 | CAMBER AND DEFLECTION DETAILS |
| 41 | BEARING DETAILS |
| 42 | ABUTMENT 1 PLAN AND ELEVATION |
| 43 | ABUTMENT 2 PLAN AND ELEVATION |
| 44 | ABUTMENT 1 PILE CAP PLAN AND ELEVATION |
| 45 | ABUTMENT 2 PILE CAP PLAN AND ELEVATION |
| 46 - 47 | WINGWALL PLAN AND ELEVATION 1-2 |
| 48 | WINGWALL AND PILE DETAILS |
| 49 | SHEET PILE RETAINING WALL DETAILS |
| 50 | APPROACH SLAB DETAILS |
| 51 | REINFORCING STEEL SCHEDULE |
| 52 | BRIDGE RAIL LAYOUT |
| 53 - 57 | VT 108 CROSS SECTIONS |
| 58 - 59 | MEADOW LANE CROSS SECTIONS |
| 60 - 63 | TEMP DETOUR CROSS SECTIONS |
| 64 - 69 | CHANNEL CROSS SECTIONS |
| 70 | EPSC NARRATIVE |
| 71 - 76 | EPSC PLAN SHEETS |
| 77 - 78 | EPSC DETAILS |
| 79 | TOWN WATER LINE REFERENCE SHEET |


### STANDARDS LIST

| | | |
|---|---|---|
| B-5 | SLOPE GRADING, EMBANKMENTS, MUCK | 06-01-1994 |
| B-71 | STANDARD FOR RESIDENTIAL AND COMMERCIAL DRIVES | 07-08-2005 |
| E-121 | STANDARD SIGN PLACEMENT - CONVENTIONAL ROAD | 08-08-1995 |
| E-141 | REGULATORY SIGN DETAILS | 09-20-1995 |
| G-1 | STEEL BEAM GUARDRAIL DETAILS (POST, DELINEATOR, TYPICALS) | 02-10-2014 |
| G-1BM | BOXBEAM GUARD RAIL | 06-13-1997 |
| G-1D | STEEL BEAM GUARDRAIL DETAILS (END TERMINAL, ANCHOR, MEDIAN) | 02-10-2014 |
| G-16 | STEEL BEAM GUARDRAIL ATTACHMENTS TO EXISTING BRIDGE | 06-01-1994 |
| G-19 | GENERIC GRADING PLANS FOR GUARDRAIL END TERMINALS | 11-15-2002 |
| J-3 | MAIL BOX SUPPORT DETAILS | 08-07-1995 |
| S-364A | BRIDGE RAILING, GALVANIZED 3 RAIL BOX BEAM | 04-23-2012 |
| S-364B | GUARDRAIL APPROACH SECTION, GALVANIZED 3 RAIL BOX BEAM | 04-23-2012 |
| S-364C | GUARDRAIL APPROACH SECTION, GALVANIZED 3 RAIL BOX BEAM | 04-23-2012 |
| S-364D | GUARDRAIL APPROACH SECTION, GALVANIZED 3 RAIL BOX BEAM | 04-23-2012 |
| T-1 | TRAFFIC CONTROL GENERAL NOTES | 08-06-2012 |
| T-10 | CONVENTIONAL ROADS CONSTRUCTION APPROACH SIGNING | 08-06-2012 |
| T-17 | TRAFFIC CONTROL MISCELLANEOUS DETAILS | 08-06-2012 |
| T-28 | CONSTRUCTION SIGN DETAILS | 08-06-2012 |
| T-30 | CONSTRUCTION SIGN DETAILS | 08-06-2012 |
| T-35 | CONSTRUCTION ZONE LONGITUDINAL DROP-OFFS | 08-06-2012 |
| T-42 | BRIDGE NUMBER PLAQUE | 04-09-2014 |
| T-45 | SQUARE TUBE SIGN POST AND ANCHOR | 01-02-2013 |

### STRUCTURES DETAILS

| | | |
|---|---|---|
| SD-501.00 | CONCRETE DETAILS AND NOTES | 02-09-2012 |
| SD-502.00 | CONCRETE DETAILS AND NOTES | 10-10-2012 |
| SD-516.10 | BRIDGE ASPHALTIC PLUG | 08-29-2011 |
| SD-602.00 | STRUCTURAL STEEL PLATE GIRDER DETIALS AND NOTES | 05-02-2011 |

## FINAL HYDRAULIC REPORT

### HYDROLOGIC DATA

Date: May 2013

DRAINAGE AREA : 23.8 sq. mi.
CHARACTER OF TERRAIN : Hilly to mountainous
STREAM CHARACTERISTICS : Sinuous, semi-alluvial, incised, past degradation
NATURE OF STREAMBED : Gravel, cobbles, some boulders and some ledge upstream

PEAK FLOW DATA

| | | | |
|---|---|---|---|
| Q 2.33 = | 1300 cfs | Q 50 = | 3550 cfs |
| Q 10 = | 2350 cfs | Q 100 = | 4200 cfs |
| Q 25 = | 3000 cfs | Q 500 = | 5750 cfs |

DATE OF FLOOD OF RECORD : Unknown
ESTIMATED DISCHARGE: Unknown
WATER SURFACE ELEV.: Unknown
NATURAL STREAM VELOCITY : @ Q50 = 13.1 fps
ICE CONDITIONS : Moderate
DEBRIS: Moderate
DOES THE STREAM REACH MAXIMUM HIGHWATER ELEV. RAPIDLY? Yes
IS ORDINARY RISE RAPID? Yes
IS STAGE AFFECTED BY UPSTREAM OR DOWNSTREAM CONDITIONS? No
IF YES, DESCRIBE:

WATERSHED STORAGE: <1%
HEADWATERS:
UNIFORM: X
IMMEDIATELY ABOVE SITE:

### EXISTING STRUCTURE INFORMATION

STRUCTURE TYPE: Two-span rolled beam bridge with concrete deck
YEAR BUILT: Built 1938, reconstructed 1975
CLEAR SPAN(NORMAL TO STREAM): Two spans of 58' = 116' total
VERTICAL CLEARANCE ABOVE STREAMBED: 19'
WATERWAY OF FULL OPENING: 1500 sq. ft.
DISPOSITION OF STRUCTURE: Remove
TYPE OF MATERIAL UNDER SUBSTRUCTURE: See boring logs

WATER SURFACE ELEVATIONS AT:

| | | | |
|---|---|---|---|
| Q2.33 = | 731.0' | VELOCITY = | 6.8 fps |
| Q10 = | 733.2' | " | 7.9 fps |
| Q25 = | 734.1' | " | 8.8 fps |
| Q50 = | 734.9' | " | 9.5 fps |
| Q100 = | 735.6' | " | 10.6 fps |

LONG TERM STREAMBED CHANGES: There is evidence of past stream bed degradation

IS THE ROADWAY OVERTOPPED BELOW Q100: No
FREQUENCY: Above Q100
RELIEF ELEVATION: 741.7'
DISCHARGE OVER ROAD @Q100: None

### UPSTREAM STRUCTURE

TOWN: Stowe — DISTANCE: 4,000'
HIGHWAY # : TH 5 (FAS 0236) (Luce Hill Road) — STRUCTURE #: 53
CLEAR SPAN: about 55' — CLEAR HEIGHT: 20'
YEAR BUILT: Built 1952, reconstructed 1982 — FULL WATERWAY: NA
STRUCTURE TYPE: Single span steel beam bridge with concrete deck

### DOWNSTREAM STRUCTURE

TOWN: Stowe — DISTANCE: 6,400'
HIGHWAY # : TH 6 (Weeks Hill Road) — STRUCTURE #: 52
CLEAR SPAN: about 61' — CLEAR HEIGHT: 16'
YEAR BUILT: 1958 — FULL WATERWAY: NA
STRUCTURE TYPE: Single span steel beam bridge with concrete deck

### LRFR LOAD RATING FACTORS

| LOADING LEVELS | TRUCK | | | | | | |
|---|---|---|---|---|---|---|---|
| | H-20 | HL-93 | 3S2 | 6 AXLE | 3A. STR. | 4A. STR. | 5A. SEMI |
| TONNAGE | 20 | 36 | 36 | 66 | 30 | 34.5 | 38 |
| INVENTORY | 1.40 | 1.23 | | | | | |
| POSTING | | | | | | | |
| OPERATING | 1.88 | 1.60 | 3.77 | 2.51 | 2.51 | 3.17 | 3.55 |
| COMMENTS: | | | | | | | |

### PILE DRIVING AND TESTING REQUIREMENTS

| | | |
|---|---|---|
| 1 | NOMINAL PILE DRIVING CAPACITY | 400 KIP |
| 2 | PILE TEST RESISTANCE FACTOR | 0.65 |
| 3 | MAXIMUM PILE LENGTHS | SEE DESIGN VALUES |
| 4 | SEE GENERNAL NOTES FOR MINIMUM PILE LENGTH | |

### PROPOSED STRUCTURE

STRUCTURE TYPE: Single span curved girder bridge with concrete deck

CLEAR SPAN(NORMAL TO STREAM): 102'
VERTICAL CLEARANCE ABOVE STREAMBED: 16'
WATERWAY OF FULL OPENING: 1120 sq. ft.

WATER SURFACE ELEVATIONS AT:

| | | | |
|---|---|---|---|
| Q2.33 = | 729.7' | VELOCITY= | 8.5 fps |
| Q10 = | 731.5' | " | 10.7 fps |
| Q25 = | 732.5' | " | 12.5 fps |
| Q50 = | 733.2' | " | 13.1 fps |
| Q100 = | 734.1' | " | 13.8 fps |

IS THE ROADWAY OVERTOPPED BELOW Q100: No
FREQUENCY: Above Q100
RELIEF ELEVATION: 741.7'
DISCHARGE OVER ROAD @Q100: None

AVERAGE LOW ELEVATION OF SUPERSTRUCTURE: 739.4'
VERTICAL CLEARANCE: @ Q50 = 6.2'

SCOUR: Contraction scour = 1' up to Q100 and 5' at Q500.

REQUIRED CHANNEL PROTECTION: Stone Fill, Type IV

### PERMIT INFORMATION

| | | |
|---|---|---|
| AVERAGE DAILY FLOW: | 50 cfs | DEPTH OR ELEVATION: |
| ORDINARY LOW WATER: | 25 cfs | Depth = 1' |
| ORDINARY HIGH WATER: | 560 cfs | Depth = 3' |

### TEMPORARY BRIDGE REQUIREMENTS

STRUCTURE TYPE: Single span bridge
CLEAR SPAN (NORMAL TO STREAM): 80' minimum, centered on channel
VERTICAL CLEARANCE ABOVE STREAMBED: Elevation 734.0' minimum
WATERWAY AREA OF FULL OPENING: 580 sq. ft. minimum

### ADDITIONAL INFORMATION

### TRAFFIC MAINTENANCE NOTES

1. MAINTAIN TWO-WAY TRAFFIC ON A TEMPORARY BRIDGE.
2. TRAFFIC SIGNALS ARE NOT NECESSARY.
3. SIDEWALKS ARE NOT NECESSARY
4. THE APPROACHES FOR THE TEMPORARY BRIDGE SHALL BE PAVED.

### DESIGN VALUES

| | | |
|---|---|---|
| 1. DESIGN LIVE LOAD | | HL-93 |
| 2. FUTURE PAVEMENT | $d_P$: | 2.5 INCH |
| 3. DESIGN SPAN | $L$: | 145.00 FT |
| 4. MIN. MID-SPAN POS. CAMBER @ RELEASE (PRESTRESSED UNITS) | $\Delta$: | --- |
| 5. PRESTRESSING STRAND | $f_y$: | --- |
| 6. PRESTRESSED CONCRETE STRENGTH | $f'_c$: | --- |
| 7. PRESTRESSED CONCRETE RELEASE STRENGTH | $f'_{ci}$: | --- |
| 8. CONCRETE, HIGH PERFORMANCE CLASS AA | $f'_c$: | --- |
| 9. CONCRETE, HIGH PERFORMANCE CLASS A | $f'_c$: | 4.0 KSI |
| 10. CONCRETE, HIGH PERFORMANCE CLASS B | $f'_c$: | 3.5 KSI |
| 11. CONCRETE, CLASS C | $f'_c$: | --- |
| 12. REINFORCING STEEL | $f_y$: | 60 KSI |
| 13. STRUCTURAL STEEL AASHTO M270 (WEATHERING) | $f_y$: | 50 KSI |
| 14. SOIL UNIT WEIGHT | $\gamma$: | 0.140 KCF |
| 15. NOMINAL BEARING RESISTANCE OF SOIL | $q_n$: | --- |
| 16. SOIL BEARING RESISTANCE FACTOR (REFER TO AASHTO LRFD) | $\phi$: | --- |
| 17. NOMINAL BEARING RESISTANCE OF ROCK | $q_n$: | --- |
| 18. ROCK BEARING RESISTANCE FACTOR (REFER TO AASHTO LRFD) | $\phi$: | --- |
| 19. NOMINAL AXIAL PILE RESISTANCE | $q_p$: | 521 KIP |
| 20. PILE YIELD STRENGTH ASTM A572 | $f_y$: | 50 KSI |
| 21. PILE SIZE | | HP 12x63 |
| 22. EST. PILE LENGTH | $L_p$: | 64' ABUT 1 |
| | $L_p$: | 47' ABUT 2 |
| 23. PILE RESISTANCE FACTOR | $\phi$: | 0.50 |
| 24. LATERAL PILE DEFLECTION | $\Delta$: | 0.74 IN |
| 25. BASIC WIND SPEED | $V_{3s}$: | --- |
| 26. MINIMUM GROUND SNOW LOAD | $p_g$: | --- |
| 27. SEISMIC DATA PGA: --- | $S_s$: | --- |
| | $S_1$: | --- |

PROJECT NAME: STOWE
PROJECT NUMBER: BRF 0235(15)

AS BUILT "REBAR" DETAIL


| LEVEL I | LEVEL II | LEVEL III |
|---|---|---|
| TYPE: | TYPE: | TYPE: |
| GRADE: | GRADE: | GRADE: |

### TRAFFIC DATA

| YEAR | ADT | DHV | % D | % T | ADTT |
|---|---|---|---|---|---|
| 2014 | 8200 | 1100 | 52 | 5.7 | 480 |
| 2034 | 8700 | 1200 | 52 | 8.6 | 780 |

20 year ESAL for flexible pavement from 2014 to 2034 : 1920000
40 year ESAL for flexible pavement from 2014 to 2054 : 4446000
Design Speed : 30 mph

### TEMPORARY BRIDGE PROFILE ALONG TEMP CL

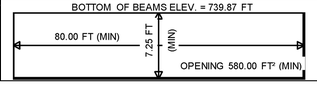



MODEL: PI
CLD 12-0120

FILE NAME: z88cl90pi.dgn
PROJECT LEADER: J. BYATT
DESIGNED BY: K. RUTTER
PRELIMINARY INFORMATION SHEET

PLOT DATE: 6/1/2015
DRAWN BY: M. SMITH
CHECKED BY: J. BYATT
SHEET 2 OF 79

## MATERIAL TOLERANCES

| | |
|---|---|
| SURFACE | |
| - PAVEMENT (TOTAL THICKNESS) | +/- 1/4" |
| - AGGREGATE SURFACE COURSE | +/- 1/2" |
| SUBBASE | +/- 1" |
| SAND BORROW | +/- 1" |

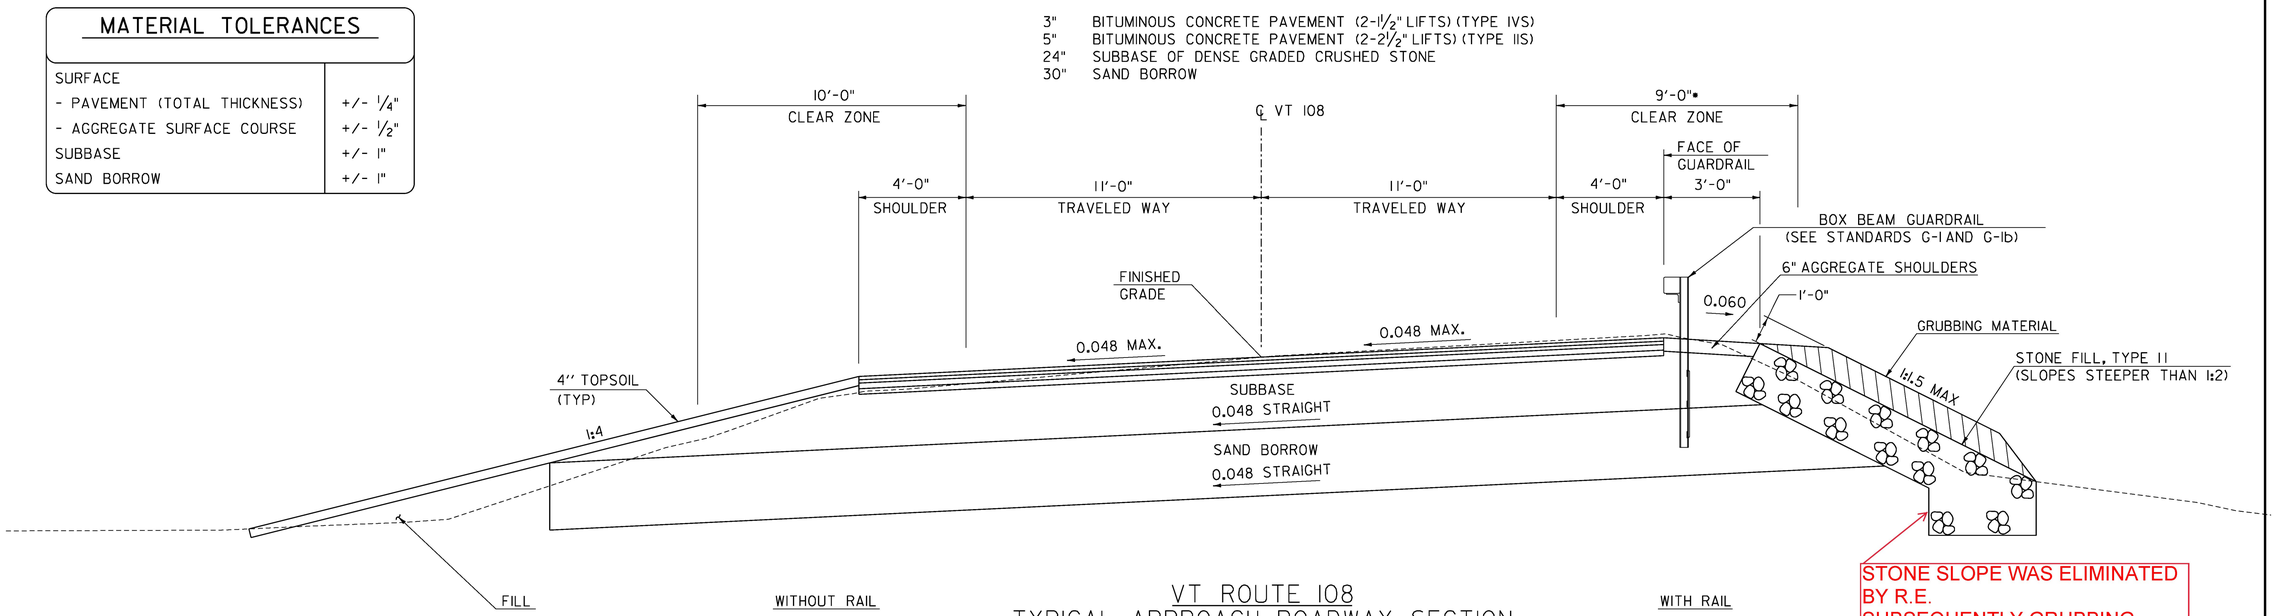



STONE SLOPE WAS ELIMINATED BY R.E.
SUBSEQUENTLY GRUBBING MATERIAL WAS ELIMINATED AS WELL.

## VT ROUTE 108
## TYPICAL APPROACH ROADWAY SECTION


SCALE: 3/8" = 1'-0"

•BASED ON 5'-0" DEFLECTION FOR BOX BEAM GUARDRAIL

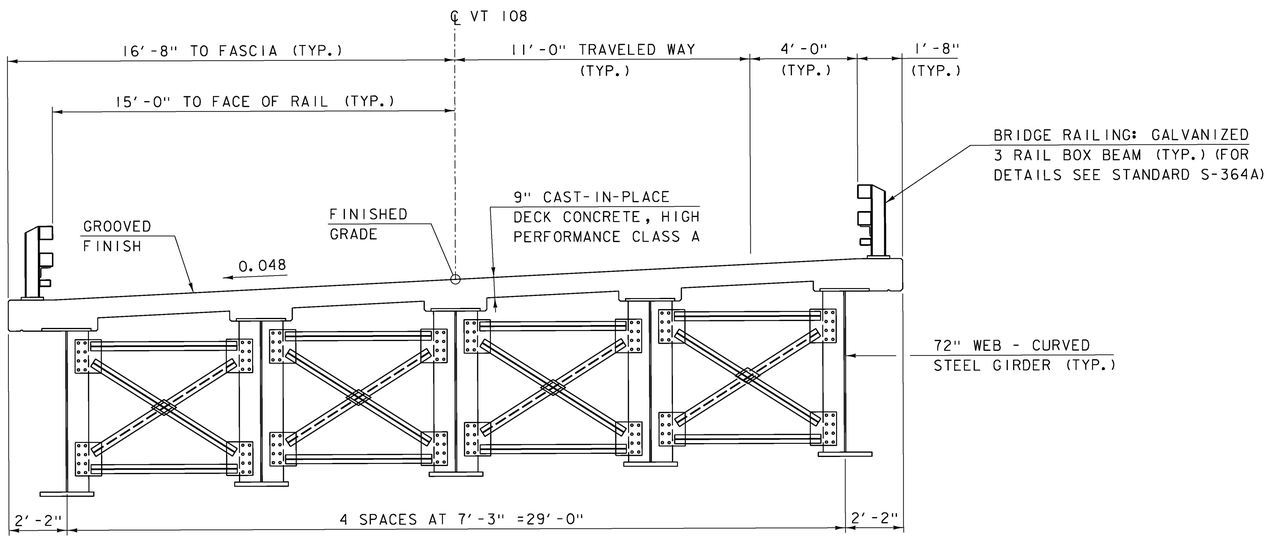


## TYPICAL BRIDGE SECTION

SCALE: 3/8" = 1'-0"

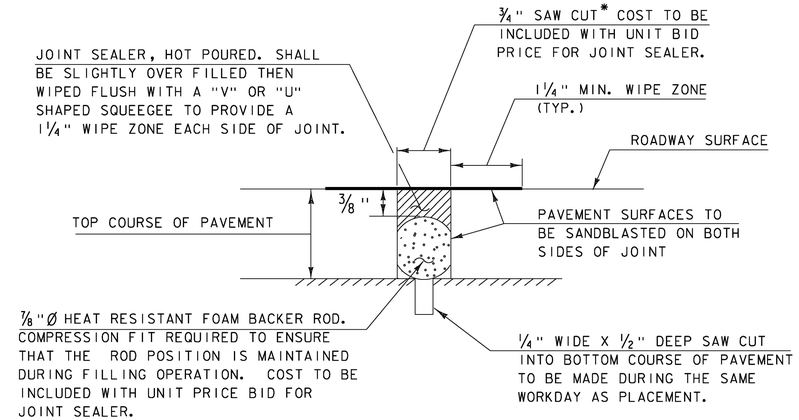


## SAWED PAVEMENT JOINT DETAIL

(NOT TO SCALE)

* JOINT IS TO BE LOCATED ACCURATELY BY STRING LINING, OR OTHER MEANS, PRIOR TO PAVING, SO THAT THE SAW CUT WILL BE MADE DIRECTLY OVER THE END OF CONCRETE DECK. JOINT SHALL BE CUT DRY IN A SINGLE PASS AND BE SEALED WITHIN 24 HOURS OR PRIOR TO EXPOSURE TO TRAFFIC. JOINT SHALL BE CLEANED PRIOR TO APPLYING THE JOINT SEALER. ALL WORK SHALL BE PAID UNDER ITEM 524.11, "JOINT SEALER, HOT POURED".


CLD 12-0120 MODEL: 01

PROJECT NAME: STOWE
PROJECT NUMBER: BRF 0235(15)

FILE NAME: z88cl90typ.dgn
PROJECT LEADER: J. BYATT
DESIGNED BY: K. RUTTER
TYPICAL SHEET 1


PLOT DATE: 5/8/2015
DRAWN BY: S. FORTIER
CHECKED BY: C. GREGORY
SHEET 3 OF 79

| TEMPORARY DETOUR CROSS SLOPE | | | |
|---|---|---|---|
| STA | LT | RT | |
| 100+00 | -8.02% | 1.28% | MATCH EXISTING |
| 100+56 | -4.73% | -2.00% | |
| 101+03 | -2.00% | -2.00% | NORMAL CROWN |
| 101+46 | -2.00% | -2.00% | NORMAL CROWN |
| 101+86 | -2.00% | 0.00% | REMOVE CROWN |
| 102+26 | -2.00% | 2.00% | REVERSE CROWN |
| 102+78 | -2.00% | 2.00% | REVERSE CROWN |
| 103+18 | 0.00% | 0.00% | BEGIN BRIDGE |
| 103+72 | 0.00% | 0.00% | END BRIDGE |
| 104+12 | -2.00% | 2.00% | REVERSE CROWN |
| 106+09 | -2.00% | 2.00% | REVERSE CROWN |
| 106+50 | 0.00% | 0.00% | CROWN REMOVED |
| 106+90 | 2.00% | -2.00% | REVERSE CROWN |
| 107+40 | 2.00% | -2.00% | REVERSE CROWN |
| 108+20 | -2.60% | 2.80% | MATCH EXISTING RT LANE |
| 108+80 | -6.20% | MATCH EXISTING | MATCH EXISTING LT AND RT LANE |

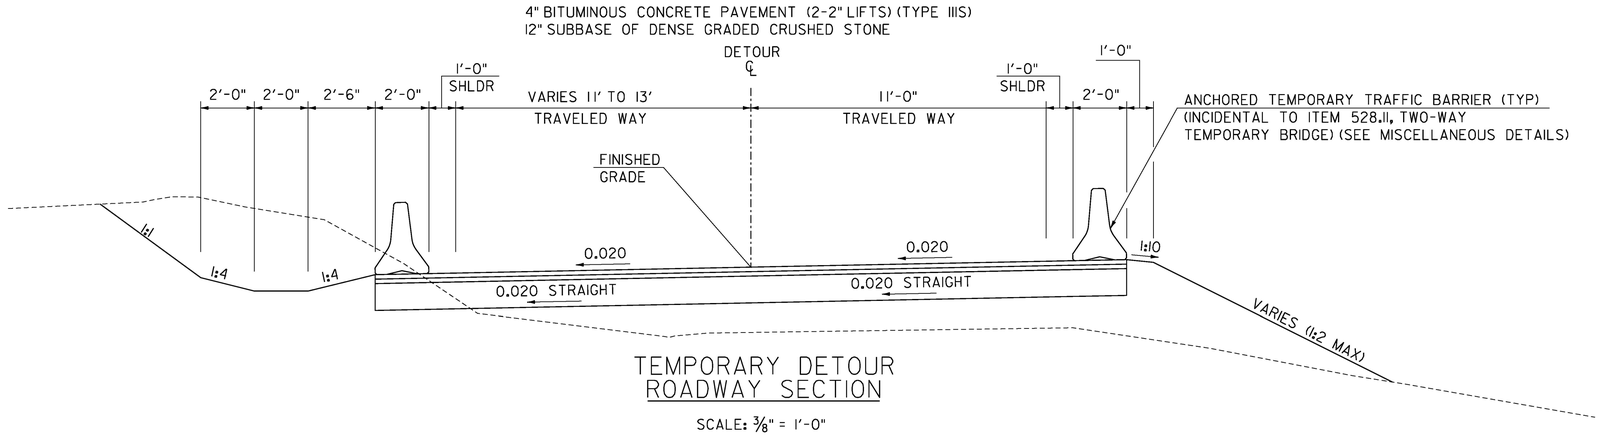


## TEMPORARY DETOUR ROADWAY SECTION

SCALE: 3/8" = 1'-0"

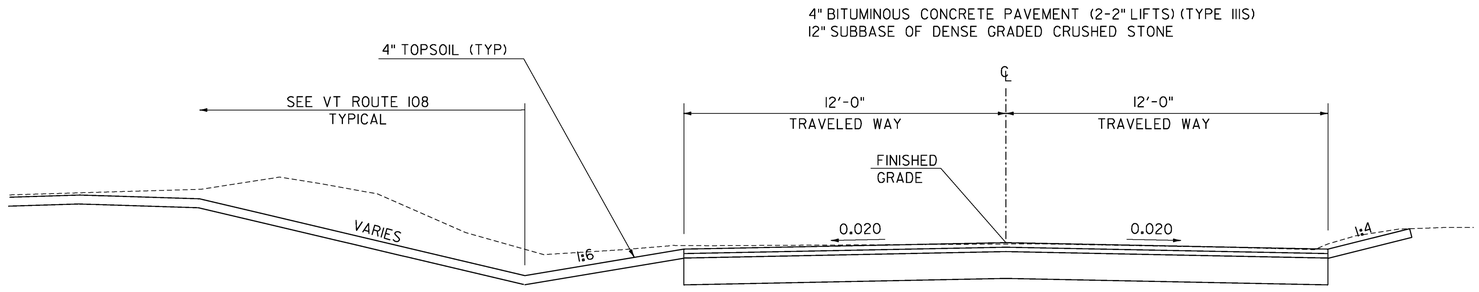



## MEADOW LANE - PAVED
## STA ~~42+33~~ TO 43+20

41+70

SCALE: 3/8" = 1'-0"

PAVING OF MEADOW LANE EXTENDED PER R.E. SUCKERT

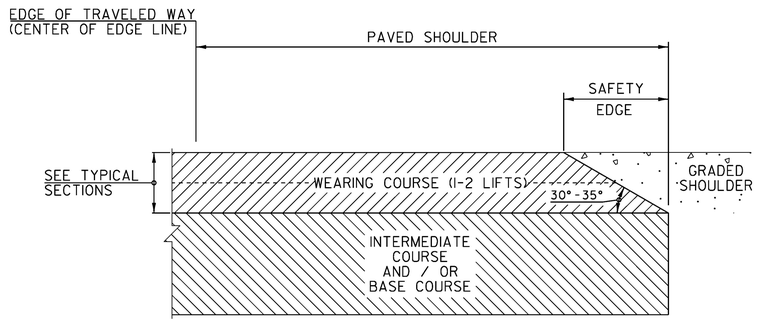



## SAFETY EDGE DETAIL

NOT TO SCALE

SAFETY EDGE NOTES

1. THE EDGE OF PAVEMENT SHALL BE FORMED IN SUCH A WAY THAT THE BITUMINOUS CONCRETE PAVEMENT IS EXTRUDED OR COMPRESSED TO FORM THE 30 TO 35 DEGREE ANGLE. DEVICES THAT SIMPLY STRIKE-OFF THE MIX WITHOUT PROVIDING ANY COMPACTIVE EFFORT WILL NOT BE ALLOWED.

2. THE PAVED SHOULDER EXTENDS FROM THE EDGE OF TRAVELED WAY TO THE EDGE OF THE WEARING COURSE, INCLUDING THE "SAFETY EDGE".

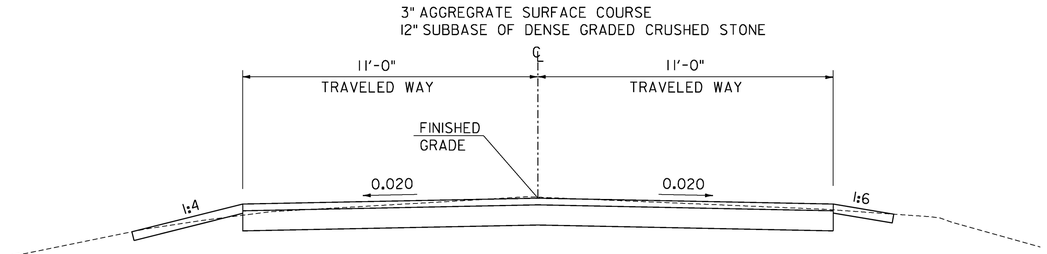


## MEADOW LANE - GRAVEL
## STA 40+45 TO ~~42+33~~


SCALE: 3/8" = 1'-0"

41+70


CLD 12-020 MODEL: 02

| | |
|---|---|
| PROJECT NAME: | STOWE |
| PROJECT NUMBER: | BRF 0235(15) |
| FILE NAME: z88cl90typ.dgn | PLOT DATE: 6/1/2015 |
| PROJECT LEADER: J. BYATT | DRAWN BY: S. FORTIER |
| DESIGNED BY: K. RUTTER | CHECKED BY: C. GREGORY |
| TYPICAL SHEET 2 | SHEET 4 OF 79 |

CLD CONSULTING ENGINEERS

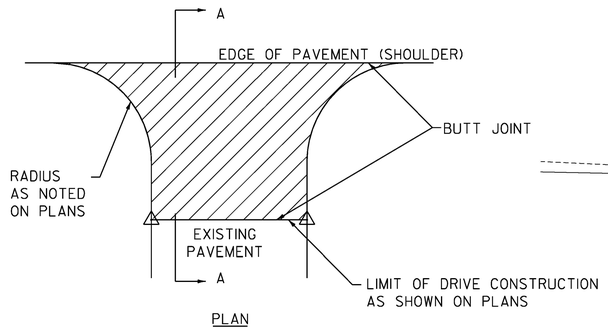



PLAN

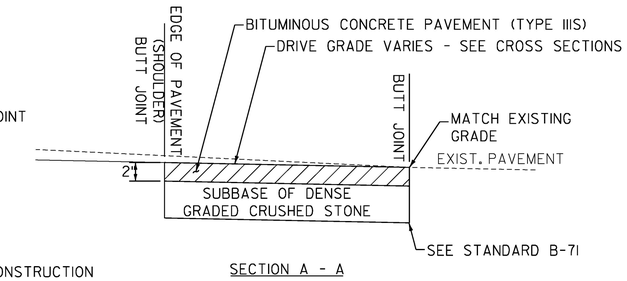



SECTION A - A

## PAVED DRIVEWAY DETAIL

(NOT TO SCALE)

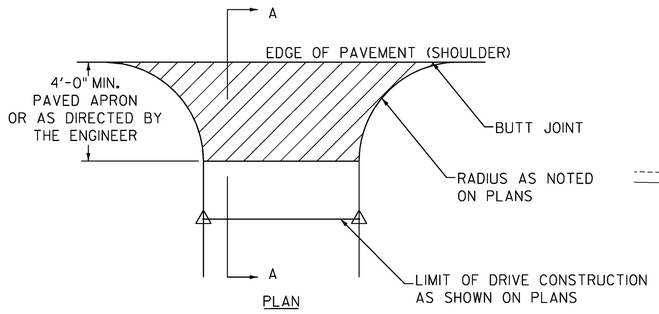


PLAN

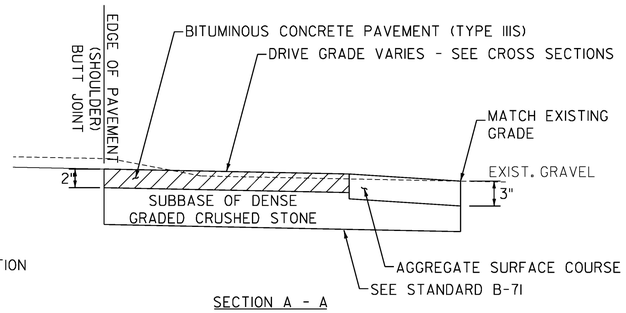


SECTION A - A

## GRAVEL DRIVEWAY DETAIL

(NOT TO SCALE)

NOTES

1. ALL UNPAVED DRIVES SHALL HAVE A 4' APRON AND BE PAVED WITH 2" BITUMINOUS CONCRETE PAVEMENT (TYPE IIIS). REFER TO STANDARD PLAN B-7I FOR ADDITIONAL INFORMATION. DRIVEWAYS LOCATED ALONG GRAVEL ROADWAYS SHALL NOT RECEIVE A PAVED APRON, THE DRIVEWAY WILL BE TIED INTO THE GRAVEL ROADWAY WITH AGGREGATE SURFACE COURSE.

2. BITUMINOUS CONCRETE PAVEMENT WORK, WHICH WILL INVOLVE SOME HAND-WORK (SUCH AS PUBLIC AND/OR PRIVATE DRIVES), SHALL BE PAID FOR UNDER ITEM 900.675 - SPECIAL PROVISION (HAND-PLACED BITUMINOUS CONCRETE MATERIAL, DRIVES). BITUMINOUS CONCRETE MATERIAL PLACED BY MECHANICAL METHODS AT THESE LOCATIONS AND ALL OTHER BITUMINOUS CONCRETE PAVEMENT MATERIAL PLACED WITHIN THE PROJECT LIMITS SHALL BE PAID UNDER ITEM 900.680 SPECIAL PROVISION (BITUMINOUS CONCRETE PAVEMENT, SMALL QUANTITY).

LEGEND

ITEM 900.675 - SPECIAL PROVISION (HAND-PLACED BITUMINOUS CONCRETE MATERIAL, DRIVES)

CONSULTING ENGINEERS

PROJECT NAME: STOWE
PROJECT NUMBER: BRF 0235(15)


FILE NAME: z88cl90typ.dgn
PROJECT LEADER: J. BYATT
DESIGNED BY: K. RUTTER
TYPICAL SHEET 3

PLOT DATE: 5/8/2015
DRAWN BY: K. RUTTER
CHECKED BY: C. GREGORY
SHEET 5 OF 79


CLD 12-0120 MODEL: 03

# ANCHORED TEMPORARY TRAFFIC BARRIER


(NOT TO SCALE)

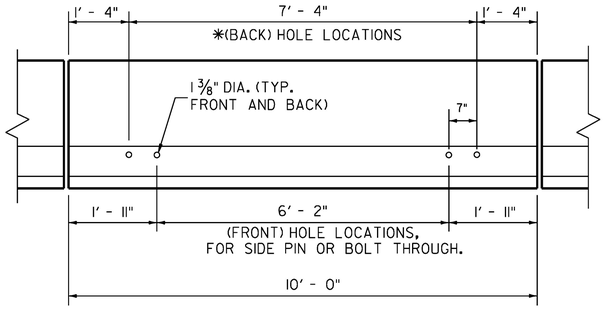


DETAIL 1

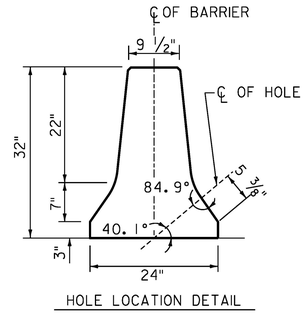



HOLE LOCATION DETAIL

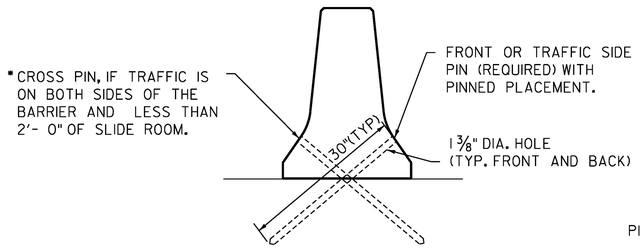



DETAIL 2

PLACEMENT ON BITUMINOUS CONCRETE PAVEMENT OR TREATED BASE MATERIAL (30" PIN REQUIRED)

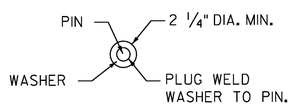


VIEW A-A

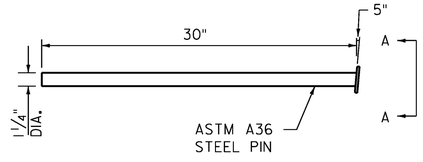


(30") PIN DETAIL
SEE DETAIL 2

## CORE DRILLING EXISTING BARRIER

CORE DRILLING EXISTING CONCRETE BARRIER IS PERMITTED. HOLES SHALL BE DRILLED WITH CORING OR MASONRY DRILLING TYPE EQUIPMENT. PERCUSSION (STAR) DRILLING SHALL NOT BE USED. A SPECIAL DRILL BIT (TO CUT THROUGH EXISTING REINFORCING) WILL LIKELY BE REQUIRED. SPALLS IN THE CONCRETE EXCEEDING 1/2" SHALL BE PATCHED.

## GENERAL NOTES

1. THE DETAILS PROVIDED ARE INTENDED TO BE A SCHEMATIC ONLY. THE EXACT LAYOUT OF THE ANCHORS SHALL BE DETERMINED BY THE CONTRACTOR AND APPROVED BY THE ENGINEER AND BE BASED FROM MEASUREMENT OF THE BARRIER ONSITE. THE ANCHORING SYSTEM SHALL BE CRASH TESTED FOR A MINIMUM TL-3 RATING.

2. THESE DETAILS PROVIDE A METHOD OF LATERALLY RESTRAINING PRECAST CONCRETE BARRIER TO LIMIT DEFLECTIONS UNDER NORMALLY EXPECTED PASSENGER VEHICLE IMPACTS. THESE DETAILS ARE INTENDED FOR USE IN WORK ZONES, PRIMARILY ON PAVEMENT WHERE TEMPORARY BARRIER MUST BE PLACED LESS THEN 2 FEET FROM THE LONGITUDINAL EDGE OF THE DECK OR DROPOFF AND PARALLEL TO THE DIRECTION OF TRAVEL. OTHER APPLICATIONS OF THESE DETAILS ARE ACCEPTABLE AS DIRECTED BY THE ENGINEER.

3. EACH PRECAST CONCRETE BARRIER SECTION SHALL HAVE A MINIMUM OF TWO OR TOTAL OF FOUR 1 3/8" ID, HOLES FORMED OR CORED THROUGH THE BARRIER.

4. THE DRILLING OF THE TRAVEL SURFACE IS ACCOMPLISHED BY PLACING THE PRE-DRILLED BARRIER SECTION ON THE TRAVEL SURFACE IN THE DESIRED POSITION. THE HOLE IS DRILLED WITH THE BIT PASSING THROUGH THE HOLE IN THE BARRIER. THE BIT IS TO BE INSERTED INTO THE HOLE IN THE BARRIER SO THAT THE TRAVEL SURFACE IS DRILLED TO A POINT WHICH IS SLIGHTLY MORE THAN THE PIN LENGTH.

5. NOTE THAT STEEL WASHERS HAVE BEEN WELDED TO THE TOP OF THE STEEL PINS TO AID IN THE REMOVAL OF THE PINS, WHEN THE BARRIER IS REMOVED.

6. PAYMENT FOR FORMING OR CORING OF HOLES IN THE BARRIER, DRILLING OF HOLES IN BRIDGE DECK OR PAVEMENT, FABRICATION AND MATERIALS FOR THE 1 1/4" PINS, INSTALLATION OF PINS, AND ANY REPAIR TO THE BARRIER SHALL BE CONSIDERED INCIDENTAL TO ITEM 528.11, TWO-WAY TEMPORARY BRIDGE.


7. THE BARRIER AND TRAVEL SURFACE WILL BE REPAIRED AS DIRECTED BY THE ENGINEER.

8. PROVIDE GALVANIZED BOLTS, NUTS, AND PLATE WASHERS. ALL STEEL PINS SHALL BE GALVANIZED. ALL NUTS, BOLTS, PLATE WASHERS, AND PINS SHALL BE INCIDENTAL TO ITEM 528.11, TWO-WAY TEMPORARY BRIDGE.

NOT TO SCALE

CLD 12-0120 MODEL: 04


| | |
|---|---|
| PROJECT NAME: STOWE | |
| PROJECT NUMBER: BRF 0235(15) | |
| FILE NAME: z88c190typ.dgn | PLOT DATE: 6/1/2015 |
| PROJECT LEADER: J. BYATT | DRAWN BY: M. SMITH |
| DESIGNED BY: K. RUTTER | CHECKED BY: N. FOX |
| MISCELLANEOUS DETAILS | SHEET 6 OF 79 |

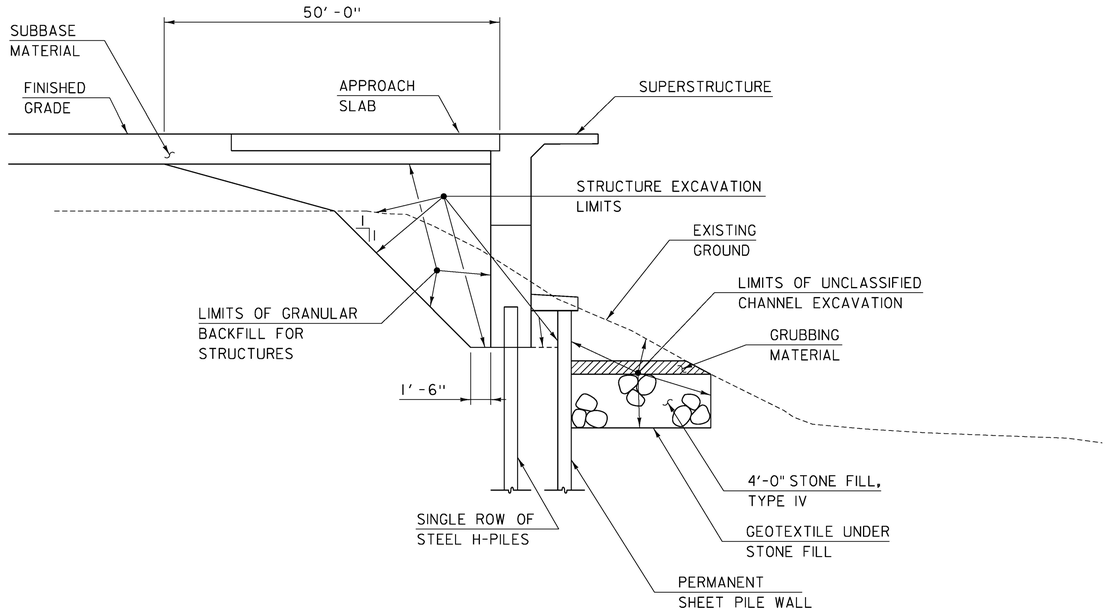


## TYPICAL ABUT. 1 EARTHWORK SECTION

SCALE: 3/16" = 1'-0"


1. ACTUAL EXCAVATION LIMITS SHALL BE DETERMINED BY THE CONTRACTOR. HOWEVER, PAYMENT UNDER CONTRACT ITEM 204.25 WILL ONLY BE MADE TO THE LIMITS SHOWN.

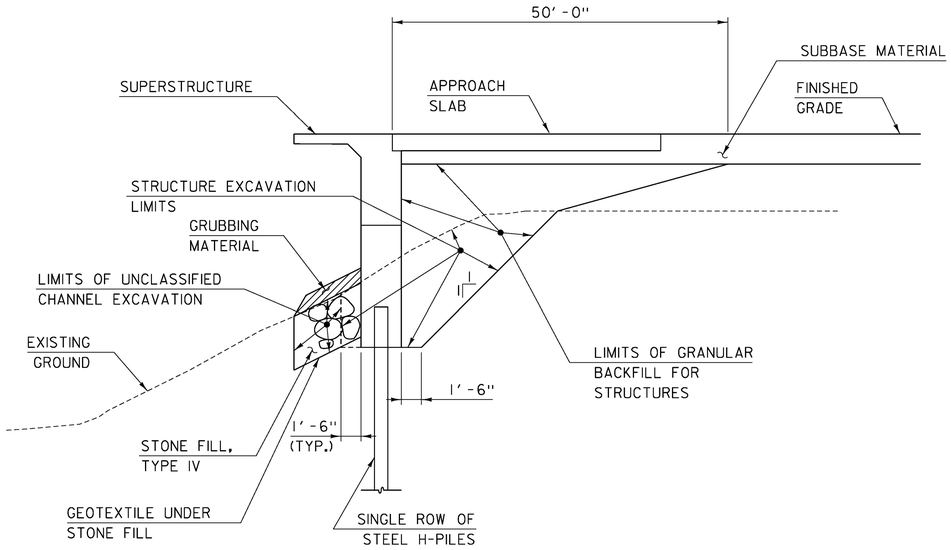


## TYPICAL ABUT. 2 EARTHWORK SECTION

SCALE: 3/16" = 1'-0"

1. ACTUAL EXCAVATION LIMITS SHALL BE DETERMINED BY THE CONTRACTOR. HOWEVER, PAYMENT UNDER CONTRACT ITEM 204.25 WILL ONLY BE MADE TO THE LIMITS SHOWN.

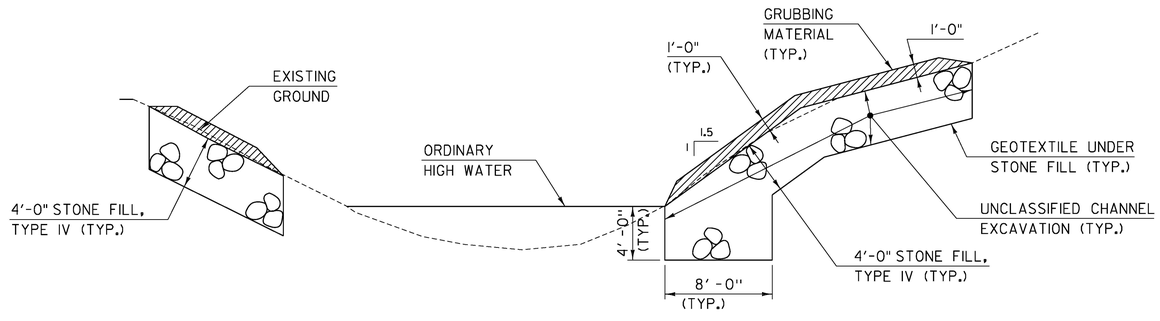


## TYPICAL CHANNEL SECTION

SCALE: 3/16" = 1'-0"

- WHENEVER CHANNEL SLOPE INTERSECTS ROADWAY SUBBASE, GRUBBING MATERIAL SHALL BEGIN AT THE BOTTOM OF SUBBASE.

CLD 12-020 MODEL: TYPICAL EARTH WORKS

| | |
|---|---|
| PROJECT NAME: | STOWE |
| PROJECT NUMBER: | BRF 0235(15) |
| FILE NAME: z88cl90sub.dgn | PLOT DATE: 5/8/2015 |
| PROJECT LEADER: J. BYATT | DRAWN BY: M. SMITH |
| DESIGNED BY: J. FRENCH | CHECKED BY: J. BYATT |
| TYPICAL EARTHWORK SECTIONS | SHEET 7 OF 79 |

CONSULTING ENGINEERS

STATE OF VERMONT
AGENCY OF TRANSPORTATION

# QUANTITY SHEET 1

## SUMMARY OF ESTIMATED QUANTITIES

| ROADWAY | TRAINING | LANDSCAPING | EROSION CONTROL | BRIDGE | FULL C.E. ITEMS |
|---|---|---|---|---|---|
| 1 | | | | | |
| 6200 | | | | | |
| | | | | 535 | |
| 2850 | | | | | |
| 50 | | | | | |
| 1 | | | | | |
| | | | | 430 | |
| | | | | 340 | |
| 3150 | | | | | |
| 2600 | | | | | |
| 50 | | | | | |
| 155 | | | | | |
| 26 | | | | | |
| 1 | | | | | |
| | | | | 281 | |
| | | | | 72 | |
| | | | | 1 | |
| | | | | 606 | |
| | | | | 2227 | |
| | | | | 2 | |
| | | | | 301540 | |
| 380 | | | | 11612 | |
| | | | | 46091 | |
| | | | | 1 | |
| | | | | 550 | |
| | | | | 44 | |
| | | | | 63 | |
| | | | | 62 | |
| | | | | 299.75 | |
| | | | | 1 | |
| | | | | 1 | |
| 3 | | | | | |
| 10 | | | | | |
| | | | | | |
| 52 | | | | | |
| 52 | | | | | |
| 52 | | | | | |
| 52 | | | | | |

## TOTALS

| GRAND TOTAL | FINAL |
|---|---|
| 1 | |
| 6200 | |
| 535 | |
| 2850 | |
| 50 | |
| 1 | |
| 430 | |
| 340 | |
| 3150 | |
| 2600 | |
| 50 | |
| 155 | |
| 26 | |
| 1 | |
| 281 | |
| 72 | |
| 1 | |
| 606 | |
| 2227 | |
| 2 | |
| 301540 | |
| 11992 | |
| 46091 | |
| 1 | |
| 550 | |
| 44 | |
| 63 | |
| 62 | |
| 299.75 | |
| 1 | |
| 1 | |
| 3 | |
| 10 | |
| | |
| 52 | |
| 52 | |
| 52 | |
| 52 | |

## DESCRIPTIONS

| UNIT | ITEMS | ITEM NUMBER | ROUND |
|---|---|---|---|
| LS | CLEARING AND GRUBBING, INCLUDING INDIVIDUAL TREES AND STUMPS | 201.10 | - |
| CY | COMMON EXCAVATION | 203.15 | 39 |
| CY | UNCLASSIFIED CHANNEL EXCAVATION | 203.27 | - |
| CY | SAND BORROW | 203.31 | 44 |
| CY | TRENCH EXCAVATION OF EARTH | 204.20 | 5.1 |
| CY | TRENCH EXCAVATION OF EARTH, EXPLORATORY (N.A.B.I.) | 204.22 | - |
| CY | STRUCTURE EXCAVATION | 204.25 | - |
| CY | GRANULAR BACKFILL FOR STRUCTURES | 204.30 | - |
| SY | COLD PLANING, BITUMINOUS PAVEMENT | 210.10 | 20 |
| CY | SUBBASE OF DENSE GRADED CRUSHED STONE | 301.35 | 41 |
| CY | AGGREGATE SURFACE COURSE | 401.10 | 4.3 |
| TON | AGGREGATE SHOULDERS | 402.12 | 3 |
| CWT | EMULSIFIED ASPHALT | 404.65 | 1.3 |
| LU | PRICE ADJUSTMENT, ASPHALT CEMENT (N.A.B.I.) | 406.50 | - |
| CY | CONCRETE, HIGH PERFORMANCE CLASS A | 501.33 | - |
| CY | CONCRETE, HIGH PERFORMANCE CLASS B | 501.34 | - |
| LS | FURNISHING EQUIPMENT FOR DRIVING PILING | 504.10 | - |
| LF | STEEL PILING, HP 12 X 63 | 505.155 | - |
| SF | PERMANENT STEEL SHEET PILING (Z MIN.= 48.9 IN^3) | 505.35 | |
| EACH | DYNAMIC PILE LOADING TEST | 505.45 | - |
| LB | STRUCTURAL STEEL, CURVED PLATE GIRDER | 506.56 | - |
| LB | REINFORCING STEEL, LEVEL I | 507.11 | - |
| LB | REINFORCING STEEL, LEVEL II | 507.12 | - |
| LS | SHEAR CONNECTORS (1180 - 7" x 7/8") | 508.15 | |
| SY | LONGITUDINAL DECK GROOVING | 509.10 | |
| GAL | WATER REPELLENT, SILANE | 514.10 | - |
| LF | BRIDGE EXPANSION JOINT, ASPHALTIC PLUG | 516.10 | - |
| LF | JOINT SEALER, HOT POURED | 524.11 | |
| LF | BRIDGE RAILING, GALVANIZED 3 RAIL BOX BEAM | 525.335 | - |
| LS | TWO-WAY TEMPORARY BRIDGE (3840 SF - EST.) | 528.11 | |
| EACH | REMOVAL OF STRUCTURE (5747 SF - EST.) | 529.15 | |
| CY | CONCRETE, CLASS B | 541.25 | 0.95 |
| CY | CONTROLLED DENSITY (FLOWABLE) FILL | 541.45 | 0.3 |
| | BEGIN OPTION AA | | |
| LF | 18" CAAP .060 (2-2/3 X 1/2) | 601.0215 | - |
| LF | 18" PCCSP .064 (2-2/3 X 1/2) | 601.0415 | - |
| LF | 18" RCP CLASS III | 601.0815 | - |
| LF | 18" CPEP(SL) | 601.2615 | - |
| | END OPTION AA | | |

## DETAILED SUMMARY OF QUANTITIES

| QUANTITIES | UNIT | ITEMS |
|---|---|---|
| | | **EARTHWORK SUMMARY** |
| 6200 | CY | COMMON EXCAVATION |
| 535 | CY | UNCLASSIFIED CHANNEL EXCAVATION |
| 430 | CY | STRUCTURE EXCAVATION |
| 7165 | | SUBTOTAL |
| 5 | | ROUNDING |
| 7170 | | TOTAL FILL AVAILABLE |
| 86 | | TOTAL FILL REQUIRED (1.15 FACTOR) |
| 7084 | | TOTAL WASTE |

CLD 12-0120 MODEL: OS#1

CONSULTING ENGINEERS

PROJECT NAME: STOWE
PROJECT NUMBER: BRF 0235(15)

FILE NAME: z88c190qty.dgn
PROJECT LEADER: J. BYATT
DESIGNED BY: K. RUTTER
QUANTITY SHEET 1

PLOT DATE: 6/1/2015
DRAWN BY: K. RUTTER
CHECKED BY: C. GREGORY
SHEET 8 OF 79

STATE OF VERMONT
AGENCY OF TRANSPORTATION

# QUANTITY SHEET 2

| SUMMARY OF ESTIMATED QUANTITIES | | | | | | | | | TOTALS | | DESCRIPTIONS | | | | DETAILED SUMMARY OF QUANTITIES | | |
|---|---|---|---|---|---|---|---|---|---|---|---|---|---|---|---|---|---|
| | ROADWAY | TRAINING | LANDSCAPING | EROSION CONTROL | BRIDGE | FULL C.E. ITEMS | GRAND TOTAL | FINAL | UNIT | ITEMS | ITEM NUMBER | ROUND | QUANTITIES | UNIT | ITEMS |
| | | | | | | | | | | BEGIN OPTION BB | | | | | |
| | 1 | | | | | | 1 | | EACH | 18" CAAPES .060 (2-2/3 X 1/2) | 601.6215 | - | | | |
| | 1 | | | | | | 1 | | EACH | 18" RCPES CLASS III | 601.6815 | - | | | |
| | 1 | | | | | | 1 | | EACH | 18" CPEPES | 601.7015 | - | | | |
| | | | | | | | | | | END OPTION BB | | | | | |
| | 1 | | | | | | 1 | | HR | POWER BROOM RENTAL, TYPE I | 608.30 | 0.5 | | | |
| | 200 | | | | | | 200 | | MGAL | DUST CONTROL WITH WATER | 609.10 | 16 | | | |
| | | | | 150 | | | 150 | | CY | STONE FILL, TYPE II | 613.11 | 7 | | | |
| | | | | | 640 | | 640 | | CY | STONE FILL, TYPE IV | 613.13 | - | | | |
| | 2 | | | | | | 2 | | EACH | YIELDING MARKER POSTS | 619.17 | - | | | |
| | 762 | | | | | | 762 | | LF | BOX BEAM GUARDRAIL | 621.30 | - | | | |
| | 4 | | | | | | 4 | | EACH | MANUFACTURED TERMINAL SECTION, TANGENT | 621.51 | - | | | |
| | | | | | 4 | | 4 | | EACH | GUARDRAIL APPROACH SECTION, GALVANIZED 3 RAIL BOX BEAM | 621.725 | - | | | |
| | 850 | | | | | | 850 | | LF | REMOVAL AND DISPOSAL OF GUARDRAIL | 621.80 | - | | | |
| | 300 | | | | | | 300 | | HR | UNIFORMED TRAFFIC OFFICERS | 630.10 | EST. | | | |
| | 600 | | | | | | 600 | | HR | FLAGGERS | 630.15 | EST. | | | |
| | | | | | | 1 | 1 | | LS | FIELD OFFICE, ENGINEERS | 631.10 | - | | | |
| | | | | | | 1 | 1 | | LS | TESTING EQUIPMENT, CONCRETE | 631.16 | - | | | |
| | | | | | | 1 | 1 | | LS | TESTING EQUIPMENT, BITUMINOUS | 631.17 | - | | | |
| | | | | | | 3000 | 3000 | | DL | FIELD OFFICE TELEPHONE (N.A.B.I.) | 631.26 | EST. | | | |
| | | 520 | | | | | 520 | | HR | EMPLOYEE TRAINEESHIP | 634.10 | | | | |
| | 1 | | | | | | 1 | | LS | MOBILIZATION/DEMOBILIZATION | 635.11 | - | | | |
| | 1 | | | | | | 1 | | LS | TRAFFIC CONTROL | 641.10 | - | | | |
| | 2 | | | | | | 2 | | EACH | PORTABLE CHANGEABLE MESSAGE SIGN | 641.15 | - | | | |
| | | | | | | | | | | BEGIN OPTION CC | | | | | |
| | 2250 | | | | | | 2250 | | LF | DURABLE 4 INCH WHITE LINE, THERMOPLASTIC | 646.402 | 1 | | | |
| | 2250 | | | | | | 2250 | | LF | DURABLE 4 INCH WHITE LINE, POLYUREA | 646.404 | 1 | | | |
| | | | | | | | | | | END OPTION CC | | | | | |
| | | | | | | | | | | BEGIN OPTION DD | | | | | |
| | 2200 | | | | | | 2200 | | LF | DURABLE 4 INCH YELLOW LINE, TYPE C TAPE | 646.4113 | - | | | |
| | 2200 | | | | | | 2200 | | LF | DURABLE 4 INCH YELLOW LINE, POLYUREA | 646.414 | - | | | |
| | | | | | | | | | | END OPTION DD | | | | | |
| | | | | | | | | | | BEGIN OPTION EE | | | | | |
| | 15 | | | | | | 15 | | LF | DURABLE 24 INCH STOP BAR, THERMOPLASTIC | 646.482 | 4 | | | |
| | 15 | | | | | | 15 | | LF | DURABLE 24 INCH STOP BAR, POLYUREA | 646.484 | 4 | | | |
| | | | | | | | | | | END OPTION EE | | | | | |
| | | | | | | | | | | BEGIN OPTION FF | | | | | |
| | 4 | | | | | | 4 | | EACH | DURABLE LETTER OR SYMBOL, THERMOPLASTIC | 646.492 | - | | | |
| | 4 | | | | | | 4 | | EACH | DURABLE LETTER OR SYMBOL, POLYUREA | 646.494 | - | | | |
| | | | | | | | | | | END OPTION FF | | | | | |

CLD 12-0120 MODEL: QS#2

CONSULTING ENGINEERS

PROJECT NAME: STOWE
PROJECT NUMBER: BRF 0235(15)

FILE NAME: z88cl90qty.dgn
PROJECT LEADER: J. BYATT
DESIGNED BY: K. RUTTER
QUANTITY SHEET 2

PLOT DATE: 5/8/2015
DRAWN BY: K. RUTTER
CHECKED BY: C. GREGORY
SHEET 9 OF 79

STATE OF VERMONT
AGENCY OF TRANSPORTATION

# QUANTITY SHEET 3

| SUMMARY OF ESTIMATED QUANTITIES | | | | | | | | TOTALS | | DESCRIPTIONS | | | | DETAILED SUMMARY OF QUANTITIES | | |
|---|---|---|---|---|---|---|---|---|---|---|---|---|---|---|---|---|
| ROADWAY | TRAINING | LANDSCAPING | EROSION CONTROL | BRIDGE | FULL C.E. ITEMS | GRAND TOTAL | FINAL | UNIT | ITEMS | ITEM NUMBER | ROUND | QUANTITIES | UNIT | ITEMS |
| 2250 | | | | | | 2250 | | LF | TEMPORARY 4 INCH WHITE LINE, PAINT | 646.602 | 1 | | | |
| 2200 | | | | | | 2200 | | LF | TEMPORARY 4 INCH YELLOW LINE, PAINT | 646.612 | - | | | |
| 15 | | | | | | 15 | | LF | TEMPORARY 24 INCH STOP BAR, PAINT | 646.682 | 4 | | | |
| 4 | | | | | | 4 | | EACH | TEMPORARY LETTER OR SYMBOL, PAINT | 646.692 | - | | | |
| | | | 230 | 705 | | 935 | | SY | GEOTEXTILE UNDER STONE FILL | 649.31 | 5.6 | | | |
| | | | 560 | | | 560 | | SY | GEOTEXTILE FOR SILT FENCE | 649.51 | 3 | | | |
| | | | 300 | | | 300 | | SY | GEOTEXTILE FOR SILT FENCE, WOVEN WIRE REINFORCED | 649.515 | 1 | | | |
| | | | 180 | | | 180 | | SY | GEOTEXTILE FOR FILTER CURTAIN | 649.61 | 6 | | | |
| | | | 110 | | | 110 | | LB | SEED | 651.15 | 1 | | | |
| | | | 380 | | | 380 | | LB | FERTILIZER | 651.18 | 3 | | | |
| | | | 1.5 | | | 1.5 | | TON | AGRICULTURAL LIMESTONE | 651.20 | 0.1 | | | |
| | | | 1.5 | | | 1.5 | | TON | HAY MULCH | 651.25 | 0.1 | | | |
| 370 | | | | | | 370 | | CY | TOPSOIL | 651.35 | 8 | | | |
| | | | 155 | 133 | | 288 | | SY | GRUBBING MATERIAL | 651.40 | 3 | | | |
| | | | 1 | | | 1 | | LS | EPSC PLAN | 652.10 | - | | | |
| | | | 180 | | | 180 | | HR | MONITORING EPSC PLAN | 652.20 | 1 | | | |
| | | | 4500 | | | 4500 | | LU | MAINTENANCE OF EPSC PLAN (N.A.B.I.) | 652.30 | 25 | | | |
| | | | 800 | | | 800 | | SY | TEMPORARY EROSION MATTING | 653.20 | 7 | | | |
| | | | 450 | | | 450 | | LF | BARRIER FENCE | 653.50 | 15 | | | |
| | | | 1625 | | | 1625 | | LF | PROJECT DEMARCATION FENCE | 653.55 | 9 | | | |
| | | 3 | | | | 3 | | EACH | EVERGREEN TREES (PICEA OMORIKA) (B&B) (7' - 8' HEIGHT) | 656.20 | - | | | |
| | | 18 | | | | 18 | | EACH | EVERGREEN TREES (PICES GLAUCA) (B&B) (7' - 8' HEIGHT) | 656.20 | - | | | |
| | | 20 | | | | 20 | | EACH | DECIDUOUS SHRUBS (CORNUS SERICEA ARCTIC FIRE) (CONT.) (2 GALLON) | 656.35 | - | | | |
| | | 20 | | | | 20 | | MGAL | LANDSCAPE WATERING | 656.65 | 4 | | | |
| | | 225 | | | | 225 | | CY | LANDSCAPE BACKFILL, TRUCK MEASUREMENT | 656.80 | 6 | | | |
| | | 1 | | | | 1 | | LS | TREE PROTECTION | 656.85 | - | | | |
| 1 | | | | | | 1 | | SF | TRAFFIC SIGNS, TYPE A | 675.20 | 0.16 | | | |
| 50 | | | | | | 50 | | LF | SQUARE TUBE SIGN POST AND ANCHOR | 675.341 | - | | | **SPECIAL PROVISION (BITUMINOUS CONCRETE PAVEMENT, SMALL QUANTITY)** |
| 2 | | | | | | 2 | | EACH | REMOVING SIGNS | 675.50 | - | | | |
| 1 | | | | | | 1 | | EACH | ERECTING SALVAGED SIGNS | 675.60 | - | 792 | TON | TYPE IIS (VT108) |
| 1 | | | | | | 1 | | LU | PRICE ADJUSTMENT, FUEL (N.A.B.I.) | 690.50 | - | 67 | TON | TYPE IIIS (MEADOW LANE) |
| 13 | | | | | | 13 | | EACH | SPECIAL PROVISION (CPM SCHEDULE) | 900.620 | - | 542 | TON | TYPE IVS (VT108) |
| 1 | | | | | | 1 | | LU | SPECIAL PROVISION (MAT DENSITY PAY ADJUSTMENT, SMALL QUANTITY) (N.A.B.I.) | 900.650 | - | 1401 | TON | SUBTOTAL |
| 1 | | | | | | 1 | | LU | SPECIAL PROVISION (MIXTURE PAY ADJUSTMENT) (N.A.B.I.) | 900.650 | - | 49 | TON | ROUNDING |
| | | | | 371 | | 371 | | SF | SPECIAL PROVISION (RETAINING WALL) | 900.670 | - | 1450 | TON | TOTAL |
| 25 | | | | | | 25 | | SY | SPECIAL PROVISION (HAND-PLACED BITUMINOUS CONCRETE MATERIAL, DRIVES) | 900.675 | 3 | | | |
| 1450 | | | | | | 1450 | | TON | SPECIAL PROVISION (BITUMINOUS CONCRETE PAVEMENT, SMALL QUANTITY) | 900.680 | 49 | | | |

CLD 12-0120 MODEL: QS#3

CONSULTING ENGINEERS

PROJECT NAME: STOWE
PROJECT NUMBER: BRF 0235(15)

FILE NAME: z88cl90qty.dgn
PROJECT LEADER: J. BYATT
DESIGNED BY: K. RUTTER
QUANTITY SHEET 3

PLOT DATE: 5/8/2015
DRAWN BY: K. RUTTER
CHECKED BY: C. GREGORY
SHEET 10 OF 79

STATE OF VERMONT
AGENCY OF TRANSPORTATION

# BRIDGE QUANTITY SHEET 1

## SUMMARY OF BRIDGE QUANTITIES

| TEMPORARY BRIDGE | PIER | APPROACH SLAB 1 | APPROACH SLAB 2 | ABUTMENT NO. 1 | ABUTMENT NO. 2 | SUPER-STRUCTURE | BRIDGE TOTAL | UNIT | ITEMS | ITEM NUMBER |
|---|---|---|---|---|---|---|---|---|---|---|
| | | | | 270 | 265 | | 535 | CY | UNCLASSIFIED CHANNEL EXCAVATION | 203.27 |
| | | | | 215 | 215 | | 430 | CY | STRUCTURE EXCAVATION | 204.25 |
| | | | | 175 | 165 | | 340 | CY | GRANULAR BACKFILL FOR STRUCTURES | 204.30 |
| | | 26 | 28 | 42 | 42 | 143 | 281 | CY | CONCRETE, HIGH PERFORMANCE CLASS A | 501.33 |
| | | | | 42 | 30 | | 72 | CY | CONCRETE, HIGH PERFORMANCE CLASS B | 501.34 |
| | | | | 0.5 | 0.5 | | 1 | LS | FURNISHING EQUIPMENT FOR DRIVING PILING | 504.10 |
| | | | | 384 | 222 | | 606 | LF | STEEL PILING, HP 12 X 63 | 505.155 |
| | | | | 2227 | | | 2227 | SF | PERMANENT STEEL SHEET PILING (Z MIN.= 48.9 IN^3) | 505.35 |
| | | | | 1 | 1 | | 2 | EACH | DYNAMIC PILE LOADING TEST | 505.45 |
| | | | | | | 301540 | 301540 | LB | STRUCTURAL STEEL, CURVED PLATE GIRDER | 506.56 |
| | | 3070 | 3292 | 2860 | 2390 | | 11612 | LB | REINFORCING STEEL, LEVEL I | 507.11 |
| | | | | 7616 | 7512 | 30963 | 46091 | LB | REINFORCING STEEL, LEVEL II | 507.12 |
| | | | | | | 1 | 1 | LS | SHEAR CONNECTORS (1180 - 7" x 7/8") | 508.15 |
| | | | | | | 550 | 550 | SY | LONGITUDINAL DECK GROOVING | 509.10 |
| | | | | 4 | 4 | 36 | 44 | GAL | WATER REPELLENT, SILANE | 514.10 |
| | | 31 | 32 | | | | 63 | LF | BRIDGE EXPANSION JOINT, ASPHALTIC PLUG | 516.10 |
| | | | | 30.5 | 31.5 | | 62 | LF | JOINT SEALER, HOT POURED | 524.11 |
| | | | | | | 299.75 | 299.75 | LF | BRIDGE RAILING, GALVANIZED 3 RAIL BOX BEAM | 525.335 |
| 1 | | | | | | | 1 | LS | TWO-WAY TEMPORARY BRIDGE (3840 SF - EST.) | 528.11 |
| | | | | | | 1 | 1 | EACH | REMOVAL OF STRUCTURE (5747 SF - EST.) | 529.15 |
| | 105 | | | 270 | 265 | | 640 | CY | STONE FILL, TYPE IV | 613.13 |
| | | | | | | 4 | 4 | EACH | GUARDRAIL APPROACH SECTION, GALVANIZED 3 RAIL BOX BEAM | 621.725 |
| | 135 | | | 305 | 265 | | 705 | SY | GEOTEXTILE UNDER STONE FILL | 649.31 |
| | | | | 67 | 66 | | 133 | SY | GRUBBING MATERIAL | 651.40 |
| | | | | 202 | 169 | | 371 | SF | SPECIAL PROVISION (RETAINING WALL) | 900.670 |

## DETAILED SUMMARY OF QUANTITIES

| QUANTITIES | UNIT | ITEMS |
|---|---|---|

CLD 12-0120 MODEL: OS BRIDGE

CONSULTING ENGINEERS

PROJECT NAME: STOWE
PROJECT NUMBER: BRF 0235(15)

FILE NAME: z88c190qty.dgn
PROJECT LEADER: J. BYATT
DESIGNED BY: J. FRENCH
BRIDGE QUANTITY SHEET I

PLOT DATE: 5/8/2015
DRAWN BY: J. FRENCH
CHECKED BY: J. BYATT
SHEET II OF 79

## GENERAL

1. ALL MATERIAL AND CONSTRUCTION SHALL CONFORM TO THE STATE OF VERMONT AGENCY OF TRANSPORTATION STANDARD SPECIFICATIONS FOR CONSTRUCTION DATED 2011, AND ITS LATEST REVISIONS, AND THE AASHTO LRFD BRIDGE DESIGN SPECIFICATIONS, DATED 2012, AND ITS LATEST REVISIONS.

2. THE BRIDGE WAS DESIGNED FOR THE HL-93 LIVE LOAD WITH 2½" FUTURE PAVEMENT.

3. ALL DIMENSIONS SHOWN IN THE PLANS ARE HORIZONTAL AND VERTICAL AND ARE GIVEN AT 68 DEGREES FAHRENHEIT, UNLESS NOTED OTHERWISE.

4. THE CONTRACTOR SHALL BE MADE AWARE THAT EXISTING UTILITIES ARE WITHIN THE CONSTRUCTION LIMITS OF BRIDGE 3. THE LOCATION OF ANY UTILITY INFORMATION SHOWN ON THE PLANS IS APPROXIMATE. NO CLAIMS ARE MADE AS TO THE ACCURACY OR COMPLETENESS OF THE UTILITIES SHOWN. THE CONTRACTOR IS SOLELY RESPONSIBLE FOR LOCATING AND PROTECTING FROM DAMAGE ALL UTILITIES ON SITE DURING ALL STAGES OF CONSTRUCTION. SEE UTILITY PLANS AND SPECIAL PROVISIONS FOR ADDITIONAL INFORMATION AND REQUIREMENTS.

5. THE REMOVAL OF THE EXISTING WATER LINE ON THE BRIDGE SHALL BE INCIDENTAL TO ITEM 529.15 - REMOVAL OF STRUCTURE.

6. ALL PG BINDER USED IN BITUMINOUS CONCRETE PAVEMENT SHALL BE IN ACCORDANCE WITH THE SPECIAL PROVISIONS.

7. EMULSIFIED ASPHALT SHALL BE APPLIED ON ALL COLD PLANED SURFACES AT THE RATE OF 0.040 GAL/SY AND BETWEEN ALL COURSES OF PAVEMENT AT THE RATE OF 0.025 GAL/SY OR AS DIRECTED BY THE ENGINEER.

8. ANY REQUIRED SAWCUT OF EXISTING PAVEMENT SHALL BE INCIDENTAL TO THE WEARING COURSE PAY ITEM.

9. THE CONTRACTOR SHALL BE RESPONSIBLE FOR REPAIRING ANY DAMAGE TO PRIVATE OR PUBLIC PROPERTY CAUSED BY THE CONTRACTOR AT THE CONTRACTOR'S EXPENSE AND TO THE SATISFACTION OF THE ENGINEER.

10. UPON COMPLETION OF THE BRIDGE CONSTRUCTION THE CONTRACTOR SHALL REMOVE THE DETOUR, RESTORE THE DETOUR SITE TO THE ORIGINAL GRADE AND STABILIZE AS SHOWN ON THE EPSC FINAL CONDITIONS PLAN.

11. SLOPE ROUNDING: ALL CUT SLOPES TO BE ROUNDED IN ACCORDANCE WITH STANDARD SHEET B-5.

12. NO WINTER WORK WILL BE ALLOWED. ALL PROVISIONS OF SUBSECTION 108.09 SHALL APPLY.

13. SHEET 79 IS INCLUDED FOR REFERENCE ONLY. ALL WORK SHOWN ON SHEET 79 WILL BE COMPLETED PRIOR TO CONSTRUCTION AND BY OTHERS.

## EARTHWORK AND RELATED ITEMS

14. TEMPORARY CONSTRUCTION FILLS WITHIN THE WATERCOURSE FOR ANY PURPOSE SHALL CONSIST OF CLEAN STONE FILL ONLY. NO OTHER FILLING IN THE STREAM SHALL OCCUR WITHOUT THE APPROVAL OF THE STREAM ALTERATION ENGINEER.

15. THE "STONE FILL, TYPE IV" UNDER THE BRIDGE AS SHOWN IN THE PLANS SHALL BE PLACED BEFORE THE NEW STEEL GIRDERS ARE SET.

16. ITEM 529.15 "REMOVAL OF STRUCTURE" SHALL BE USED FOR THE REMOVAL OF THE EXISTING STRUCTURE INCLUDING THE SUPERSTRUCTURE, PIER, AND ABUTMENTS OUTSIDE THE LIMITS OF STRUCTURE EXCAVATION OR UNCLASSIFIED CHANNEL EXCAVATION. THE PIER SHALL BE REMOVED TO ELEVATION 722.0.

## H-PILES

17. TO PREVENT DAMAGE TO THE PILES, PILE SHOES ARE REQUIRED AND SHALL CONFORM TO SUB-SECTION 505.04(f).

18. PILES SHALL BE DRIVEN WITHIN 3 INCHES OF THE LOCATION SHOWN ON THE PLANS. THE PILE ORIENTATION SHALL NOT VARY MORE THAN 5 DEGREES. THE CONTRACTOR SHALL DEMONSTRATE HOW THE TOLERANCE WILL BE MET TO THE SATISFACTION OF THE RESIDENT ENGINEER.

19. TO ENSURE THAT THE NOMINAL CAPACITY HAS BEEN ATTAINED AND TO PREVENT THE OVERSTRESSING OF THE PILES DURING DRIVING OPERATIONS, DYNAMIC TESTING SHALL BE PERFORMED IN ACCORDANCE WITH SUBSECTION 505.04. A MINIMUM OF ONE DYNAMIC PILE TEST SHALL BE CONDUCTED ON THE FIRST PILE DRIVEN FOR EACH SUBSTRUCTURE UNIT, FOR A TOTAL OF 2 TESTS. MORE TESTS MAY BE REQUIRED BY THE ENGINEER. ADDITIONAL TEST REQUIRED BY THE ENGINEER WILL BE PAID FOR AT THE UNIT PRICE BID FOR CONTRACT ITEM 505.45.

20. THE PILES SHALL BE DRIVEN TO A NOMINAL PILE DRIVING RESISTANCE (RNDR) OF 400 KIPS, AS DETERMINED BY THE RESULTS OF DYNAMIC TESTING, AND AS INTERPRETED BY THE RESIDENT ENGINEER. HOWEVER, THE PILES SHALL BE DRIVEN TO A MINIMUM DEPTH OF 30 FEET BELOW THE BOTTOM OF THE PILE CAP.

21. FOR ESTIMATING PURPOSES, THE PILE TIP ELEVATIONS WERE ASSUMED TO BE AS SHOWN ON THE BORING LOGS. THE ACTUAL IN PLACE LENGTH MAY VARY.

## STEEL

22. THE EXISTING STRUCTURAL STEEL IS PAINTED WITH MATERIAL THAT MAY CONTAIN LEAD. THE CONTRACTOR SHALL FOLLOW ALL APPLICABLE REGULATIONS WHEN HANDLING AND WORKING WITH THIS STEEL. THE REMOVED STRUCTURAL STEEL IS THE PROPERTY OF THE CONTRACTOR. THE CONTRACTOR SHALL INDEMNIFY AND HOLD THE STATE, ITS OFFICERS, AND EMPLOYEES HARMLESS CONCERNING THE CONTRACTOR'S USE OR DISPOSITION OF THE REMOVED EXISTING STRUCTURAL STEEL.

## CONCRETE

23. CONCRETE USED FOR DECK, APPROACH SLABS, END DIAPHRAGMS, AND SHEET PILE RETAINING WALL CAP SHALL BE HIGH PERFORMANCE CONCRETE CLASS A AND WILL BE PAID UNDER CONTRACT ITEM 501.33. CONCRETE USED FOR PILE CAP SHALL BE HIGH PERFORMANCE CONCRETE CLASS B. AND WILL BE PAID UNDER CONTRACT ITEM 501.34

24. WATER REPELLENT, SILANE, SHALL BE APPLIED TO ALL EXPOSED CONCRETE SURFACES, EXCEPT THE UNDERSIDE OF THE DECK BETWEEN DRIP NOTCHES.

25. ALL REINFORCING STEEL IN THE DECK AND END DIAPHRAGMS SHALL BE LEVEL II - STAINLESS CLAD OR DUAL COATED REINFORCING STEEL. REINFORCEMENT IN THE PILE CAP, APPROACH SLABS, AND SHEET PILE WALL CAP SHALL BE LEVEL I. LEVEL I EPOXY COATED REINFORCEMENT IS DESIGNATED BY AN "E" IN THE BAR MARK PREFIX.

26. ALL REINFORCING STEEL SHALL BE DETAILED AND FABRICATED USING PROCEDURES AND TOLERANCES IN ACCORDANCE WITH APPLICABLE PUBLICATIONS OF THE "CONCRETE REINFORCING INSTITUTE".

27. MINIMUM CLEAR COVER FOR REINFORCING STEEL SHALL BE AS FOLLOWS:

| | |
|---|---|
| ALONG BACKFACES OF WALLS AGAINST EARTH: | 2.0 INCH |
| ALONG TOP SURFACE OF DECK SLAB: | 3.0 INCH |
| ALONG BOTTOM SURFACE OF DECK SLAB: | 1.5 INCH |
| ELSEWHERE UNLESS OTHERWISE INDICATED: | 3.0 INCH |

CLD 12-0120 MODEL: GeneralNotes

CONSULTING ENGINEERS

PROJECT NAME: STOWE
PROJECT NUMBER: BRF 0235(15)

FILE NAME: z88cl90gennotes.dgn
PROJECT LEADER: J. BYATT
DESIGNED BY: J. FRENCH
PROJECT NOTES

PLOT DATE: 6/1/2015
DRAWN BY: M. SMITH
CHECKED BY: J. BYATT
SHEET 12 OF 79

## GENERAL INFORMATION

### SYMBOLOGY LEGEND NOTE

THE SYMBOLOGY ON THIS SHEET IS INTENDED TO COVER STANDARD CONVENTIONAL SYMBOLOGY. THE SYMBOLOGY IS USED FOR EXISTING & PROPOSED FEATURES WITH HEAVIER LINEWEIGHT, IN COMBINATION WITH PROJECT ANNOTATION, AS NOTED ON PROJECT PLAN SHEETS. THIS LEGEND SHEET COVERS THE BASICS. SYMBOLOGY ON PLANS MAY VARY, PLAN ANNOTATIONS AND NOTES SHOULD BE USED TO CLARIFY AS NEEDED.

### SIGNS

| | |
|---|---|
| N | NEW SIGN |
| RET | RETAIN SIGN |
| S | SALVAGE SIGN |
| R | REMOVE SIGN |
| R&S | REMOVE AND SALVAGE |

### PAVEMENT MARKINGS

| | |
|---|---|
| YL | YELLOW LINE |
| WL | WHITE LINE |

## R.O.W. ABBREVIATIONS (CODES) & SYMBOLS

| POINT | CODE | DESCRIPTION |
|---|---|---|
| | CH | CHANNEL EASEMENT |
| | CONST | CONSTRUCTION EASEMENT |
| | CUL | CULVERT EASEMENT |
| | D&C | DISCONNECT & CONNECT |
| | DIT | DITCH EASEMENT |
| | DR | DRAINAGE EASEMENT |
| | DRIVE | DRIVEWAY EASEMENT |
| | EC | EROSION CONTROL |
| | HWY | HIGHWAY EASEMENT |
| | I&M | INSTALL & MAINTAIN EASEMENT |
| | LAND | LANDSCAPE EASEMENT |
| | R&RES | REMOVE & RESET |
| | R&REP | REMOVE & REPLACE |
| | SR | SLOPE RIGHT |
| | UE | UTILITY EASEMENT |
| | (P) | PERMANENT EASEMENT |
| | (T) | TEMPORARY EASEMENT |
| ■ | BNDNS | BOUND SET |
| ⧈ | BNDNS | BOUND TO BE SET |
| ● | IPNS | IRON PIN SET |
| ◎ | IPNS | IRON PIN TO BE SET |
| ⊠ | CALC | EXISTING ROW POINT |
| ○ | PROW | PROPOSED ROW POINT |
| [LENGTH] | | LENGTH CARRIED ON NEXT SHEET |

## COMMON TOPOGRAPHIC POINT SYMBOLS

| POINT | CODE | DESCRIPTION |
|---|---|---|
| | APL | BOUND APPARENT LOCATION |
| | BM | BENCHMARK |
| | BND | BOUND |
| | CB | CATCH BASIN |
| | COMB | COMBINATION POLE |
| | DITHR | DROP INLET THROATED DNC |
| | EL | ELECTRIC POWER POLE |
| | FPOLE | FLAGPOLE |
| | GASFIL | GAS FILLER |
| | GP | GUIDE POST |
| | GSO | GAS SHUT OFF |
| | GUY | GUY POLE |
| | GUYW | GUY WIRE |
| | GV | GATE VALUE |
| | H | TREE HARDWOOD |
| | HCTRL | CONTROL HORIZONTAL |
| | HVCTRL | CONTROL HORIZ. & VERTICAL |
| | HYD | HYDRANT |
| | IP | IRON PIN |
| | IPIPE | IRON PIPE |
| | LI | LIGHT - STREET OR YARD |
| | MB | MAILBOX |
| | MH | MANHOLE (MH) |
| | MM | MILE MARKER |
| | PM | PARKING METER |
| | PMK | PROJECT MARKER |
| | POST | POST STONE/WOOD |
| | RRSIG | RAILROAD SIGNAL |
| | RRSL | RAILROAD SWITCH LEVER |
| | S | TREE SOFTWOOD |
| | SAT | SATELLITE DISH |
| | SHRUB | SHRUB |
| | SIGN | SIGN |
| | STUMP | STUMP |
| | TEL | TELEPHONE POLE |
| | TIE | TIE |
| | TSIGN | SIGN W/DOUBLE POST |
| | VCTRL | CONTROL VERTICAL |
| | WELL | WELL |
| | WSO | WATER SHUT OFF |

THESE ARE COMMON VAOT SURVEY POINT SYMBOLS FOR EXISTING FEATURES, ALSO USED FOR PROPOSED FEATURES WITH HEAVIER LINEWEIGHT, IN COMBINATION WITH PROPOSED ANNOTATION.

## PROPOSED GEOMETRY CODES

| CODE | DESCRIPTION |
|---|---|
| PC | POINT OF CURVATURE |
| PI | POINT OF INTERSECTION |
| CC | CENTER OF CURVE |
| PT | POINT OF TANGENCY |
| PCC | POINT OF COMPOUND CURVE |
| PRC | POINT OF REVERSE CURVE |
| POB | POINT OF BEGINNING |
| POE | POINT OF ENDING |
| STA | STATION PREFIX |
| AH | AHEAD STATION SUFFIX |
| BK | BACK STATION SUFFIX |
| D | CURVE DEGREE OF (100FT) |
| R | CURVE RADIUS OF |
| T | CURVE TANGENT LENGTH |
| L | CURVE LENGTH OF |
| E | CURVE EXTERNAL DISTANCE |

## UTILITY SYMBOLOGY

### UNDERGROUND UTILITIES

- UTILITY (GENERIC-UNKNOWN)
- UT — TELEPHONE
- UE — ELECTRIC
- UC — CABLE (TV)
- UEC — ELECTRIC+CABLE
- UET — ELECTRIC+TELEPHONE
- UCT — CABLE+TELEPHONE
- UECT — ELECTRIC+CABLE+TELEP.
- G — GAS LINE
- W — WATER LINE
- S — SANITARY SEWER (SEPTIC)

### ABOVE GROUND UTILITIES (AERIAL)

- UTILITY (GENERIC-UNKNOWN)
- T — TELEPHONE
- E — ELECTRIC
- C — CABLE (TV)
- EC — ELECTRIC+CABLE
- ET — ELECTRIC+TELEPHONE
- AER E&T — ELECTRIC+TELEPHONE
- CT — CABLE+TELEPHONE
- ECT — ELECTRIC+CABLE+TELEP.
- UTILITY POLE GUY WIRE

## PROJECT CONSTRUCTION SYMBOLOGY

### PROJECT DESIGN & LAYOUT SYMBOLOGY

- CZ — CLEAR ZONE
- PLAN LAYOUT MATCHLINE

### PROJECT CONSTRUCTION FEATURES

- TOP OF CUT SLOPE
- TOE OF FILL SLOPE
- STONE FILL
- BOTTOM OF DITCH ℄
- CULVERT PROPOSED
- STRUCTURE SUBSURFACE
- PDF — PDF — PROJECT DEMARCATION FENCE
- BF — BF — BARRIER FENCE
- TREE PROTECTION ZONE (TPZ)
- STRIPING LINE REMOVAL
- SHEET PILES

## CONVENTIONAL BOUNDARY SYMBOLOGY

### BOUNDARY LINES

- TOWN LINE — TOWN BOUNDARY LINE
- COUNTY LINE — COUNTY BOUNDARY LINE
- STATE LINE — STATE BOUNDARY LINE
- PROPOSED STATE R.O.W. (LIMITED ACCESS)
- PROPOSED STATE R.O.W.
- STATE ROW (LIMITED ACCESS)
- STATE ROW
- TOWN ROW
- PERMANENT EASEMENT LINE (P)
- TEMPORARY EASEMENT LINE (T)
- SURVEY LINE
- P/L — P/L — PROPERTY LINE (P/L)
- SR SR SR — SLOPE RIGHTS
- 6F — 6F — 6F PROPERTY BOUNDARY
- 4F — 4F — 4F PROPERTY BOUNDARY
- HAZ — HAZ — HAZARDOUS WASTE

## EPSC LAYOUT PLAN SYMBOLOGY

### EPSC MEASURES

- FILTER CURTAIN
- SILT FENCE
- SILT FENCE WOVEN WIRE
- CHECK DAM
- DISTURBED AREAS REQUIRING RE-VEGETATION
- EROSION MATTING

### ENVIRONMENTAL RESOURCES

- WETLAND BOUNDARY
- RIPARIAN BUFFER ZONE
- WETLAND BUFFER ZONE
- SOIL TYPE BOUNDARY
- T&E — THREATENED & ENDANGERED SPECIES
- HAZ — HAZ — HAZARDOUS WASTE AREA
- AG — AGRICULTURAL LAND
- HABITAT — FISH & WILDLIFE HABITAT
- FLOOD PLAIN — FLOOD PLAIN
- OHW — ORDINARY HIGH WATER (OHW)
- STORM WATER
- USDA FOREST SERVICE LANDS
- WILDLIFE HABITAT SUIT/CONN

### ARCHEOLOGICAL & HISTORIC

- ARCH — ARCHEOLOGICAL BOUNDARY
- HISTORIC DIST — HISTORIC DISTRICT BOUNDARY
- HISTORIC — HISTORIC AREA
- (H) HISTORIC STRUCTURE

## CONVENTIONAL TOPOGRAPHIC SYMBOLOGY

### EXISTING FEATURES

- ROAD EDGE PAVEMENT
- ROAD EDGE GRAVEL
- DRIVEWAY EDGE
- DITCH
- FOUNDATION
- FENCE (EXISTING)
- FENCE WOOD POST
- FENCE STEEL POST
- GARDEN
- ROAD GUARDRAIL
- RAILROAD TRACKS
- CULVERT (EXISTING)
- STONE WALL
- WALL
- WOOD LINE
- BRUSH LINE
- HEDGE
- BODY OF WATER EDGE
- LEDGE EXPOSED

CLD 12-0120 MODEL: LEGEND

CONSULTING ENGINEERS

| | |
|---|---|
| PROJECT NAME: | STOWE |
| PROJECT NUMBER: | BRF 0235(15) |
| FILE NAME: z88cl90legend.dgn | PLOT DATE: 5/8/2015 |
| PROJECT LEADER: J. BYATT | DRAWN BY: K. RUTTER |
| DESIGNED BY: K. RUTTER | CHECKED BY: C. GREGORY |
| CONVENTIONAL SYMBOLOGY LEGEND SHEET | SHEET 13 OF 79 |

## GPS CONTROL POINTS

### HVCTRL #1

COTTAGE

NORTH = 720366.318
EAST = 1583870.117
ELEV. = 766.304

DESCRIBED BY VERMONT AGENCY OF TRANSPORTATION 1996 (DJM)
GENERAL LOCATION - THE STATION IS LOCATED IN THE TOWN OF STOWE, 1.6 MI (2.6 KM) NORTHWEST OF STOWE VILLAGE, 8.2 MI (13.2 KM) SOUTHWEST OF MORRISVILLE, AND 9.9 MI (15.9 KM) NORTH NORTHEAST OF WATERBURY. TO REACH FROM THE JUNCTION OF VERMONT ROUTE 100 AND VERMONT ROUTE 108 IN STOWE VILLAGE, PROCEED NORTHERLY ALONG ROUTE 108 FOR 2.0 MI (3.2 KM) TO COTTAGE CLUB ROAD (TH 29) ON THE RIGHT. PROCEED NORTHEASTERLY ALONG COTTAGE CLUB ROAD FOR 0.1 MI (0.2 KM) TO THE MARK ON THE RIGHT. THE MARK IS A STATE OF VERMONT SURVEY DISK SET IN THE TOP OF A CONCRETE MONUMENT 30 CM IN DIAMETER, FLUSH WITH THE GROUND SURFACE. IT IS LOCATED 128 FT (39.0 M) NORTHEAST OF UTILITY POLE 1, 88.5 FT (27.0 M) SOUTHWEST OF UTILITY POLE 3, 36 FT (11.0 M) SOUTHEAST OF A CHAINLINK FENCE, 18.5 FT (5.6 M) SOUTHEAST OF THE CENTERLINE OF COTTAGE CLUB ROAD (TH 29) , AND 3 FT (0.9 M) NORTHWEST OF A FIBERGLASS WITNESS POST. OWNERSHIP IS THE TOWN OF STOWE.

### HVCTRL #2

VILLAGE GREEN


NORTH = 720026.656
EAST = 1585800.072
ELEV. = 750.852

DESCRIBED BY VERMONT AGENCY OF TRANSPORTATION 1996 (DJM)
GENERAL LOCATION - THE STATION IS LOCATED IN THE TOWN OF STOWE, 1.2 MI (1.9 KM) NORTHWEST OF STOWE VILLAGE, 8.1 MI (13.0 KM) SOUTHWEST OF MORRISVILLE, AND 9.8 MI (15.8 KM) NORTH NORTHEAST OF WATERBURY. TO REACH FROM THE JUNCTION OF VERMONT ROUTE 100 AND VERMONT ROUTE 108 IN STOWE VILLAGE, PROCEED NORTHERLY ALONG ROUTE 108 FOR 1.7 MI (2.7 KM) TO CAPE COD ROAD (TH 31) ON THE RIGHT. TURN RIGHT AND GO NORTHEAST ALONG CAPE COD ROAD FOR 0.15 MI (0.24 KM) TO THE MARK ON THE RIGHT. THE MARK IS A STATE OF VERMONT SURVEY DISK SET IN THE TOP OF A CONCRETE MONUMENT 30 CM IN DIAMETER FLUSH WITH THE GROUND SURFACE. IT IS LOCATED 176.5 FT (53.8 M) SOUTHWEST OF THE CENTERLINE OF A PAVED DRIVE TO VILLAGE GREEN CONDOMINIUMS, 66.5 FT (20.3 M) NORTHEAST OF UTILITY POLE 3, 31.5 FT (9.6 M) NORTH OF A HIGHWAY SIGN (SPEED LIMIT 35) , 14.5 FT (4.4 M) SOUTHEAST OF THE CENTERLINE OF CAPE COD ROAD (TH 31) , AND 1 FT (0.3 M) WEST OF A FIBERGLASS WITNESS POST. OWNERSHIP IS THE STATE OF VERMONT.

## TRAVERSE TIES


### HVCTRL #3

NORTH = 718966.310
EAST = 1586568.514
ELEV. = 745.795

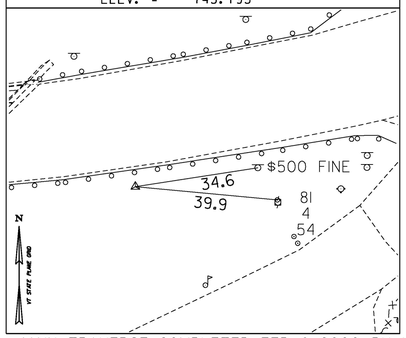



### HVCTRL #4

NORTH = 719244.738
EAST = 1587011.060
ELEV. = 734.881

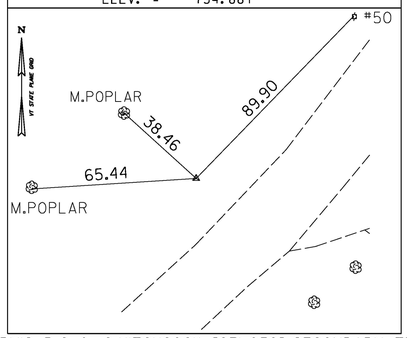



### HVCTRL #5

NORTH = 719726.269
EAST = 1587327.249
ELEV. = 735.122

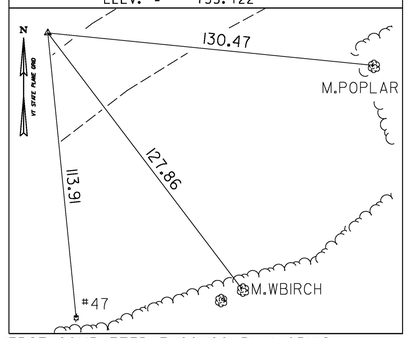



### HVCTRL #10

NORTH = 719070.220
EAST = 1586004.621
ELEV. = 743.799

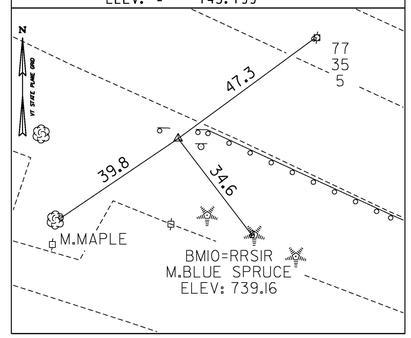


### HVCTRL #11

NORTH = 719380.602
EAST = 1585477.025
ELEV. = 753.092

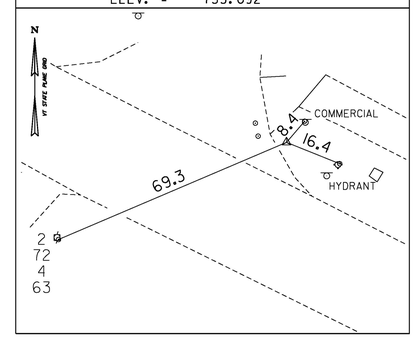



* MAIN TRAVERSE COMPLETED FEB. 8 2000 BY L.ORVIS P.C. & G.HITCHCOCK [93b059] SECONDARY TRAVERSE COMPLETED 7/20/2011 BY L.ORVIS

## ALIGNMENT TIES


### POB STA 10+00.00

NORTH = 719142.105
EAST = 1585899.792

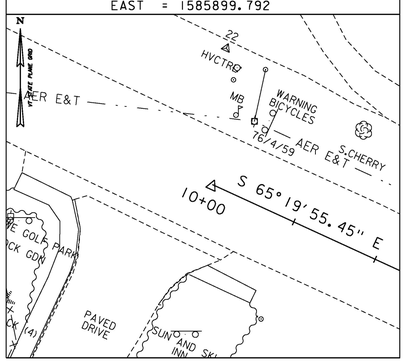



### PC STA 12+24.49

NORTH = 719048.411
EAST = 1586103.799

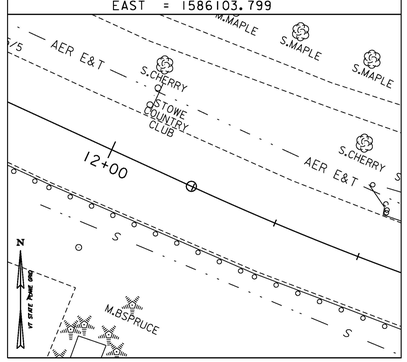



### PCC STA 19+03.41

NORTH = 719044.316
EAST = 1586762.719

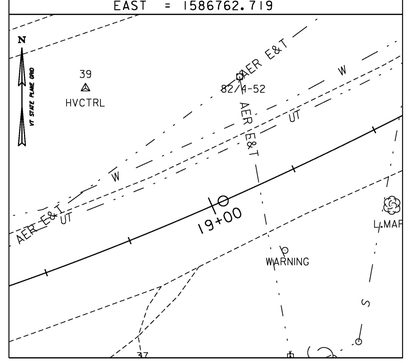


### PT STA 22+12.98

NORTH = 719210.509
EAST = 1587022.297

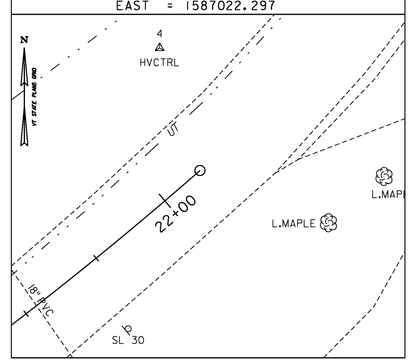


DATUM

VERTICAL NAVD 88
HORIZONTAL NAD 83(96)
ADJUSTMENT COMPASS

CLD 12-0120 MODEL: TIE01

PROJECT NAME: STOWE
PROJECT NUMBER: BRF 0235(15)


FILE NAME: z88cl90t1.dgn
PROJECT LEADER: J. BYATT
DESIGNED BY: K. RUTTER
TIE SHEET 1

PLOT DATE: 5/8/2015
DRAWN BY: K. RUTTER
CHECKED BY: C. GREGORY
SHEET 14 OF 79


CONSULTING ENGINEERS

## ALIGNMENT TIES


### POB STA 40+00.00
NORTH = 718838.694
EAST = 1586428.223

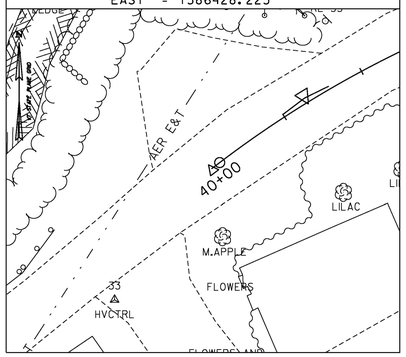



### PC STA 40+02.85
NORTH = 718840.421
EAST = 1586430.493

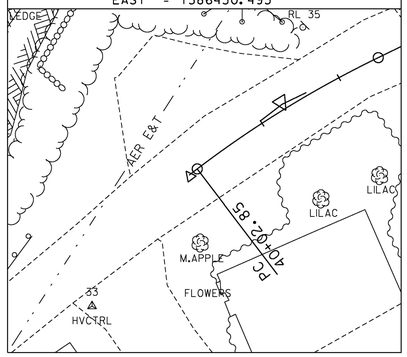



### PT STA 40+62.34
NORTH = 718871.520
EAST = 1586481.088

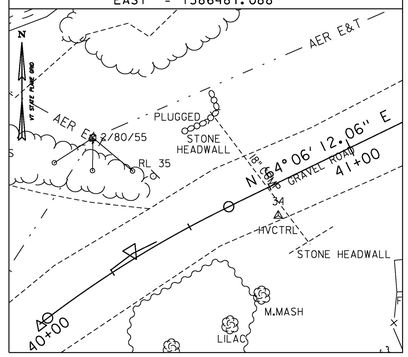


### PC STA 41+90.51
NORTH = 718927.500
EAST = 1586596.393

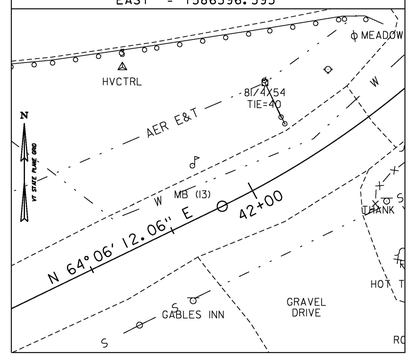



### PT STA 42+50.07
NORTH = 718959.619
EAST = 1586646.381

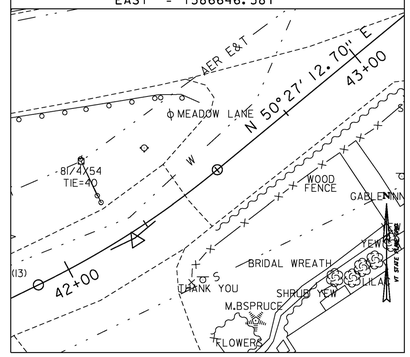



## ALIGNMENT TIES


### POB STA 100+00.00
NORTH = 719058.633
EAST = 1586081.541

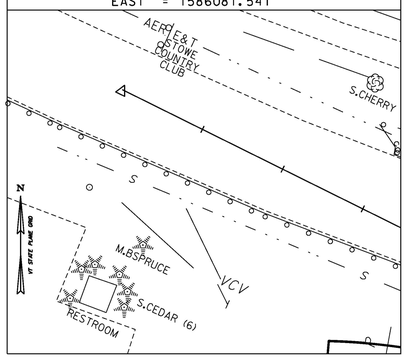



### PC STA 102+18.00
NORTH = 718961.750
EAST = 1586276.827

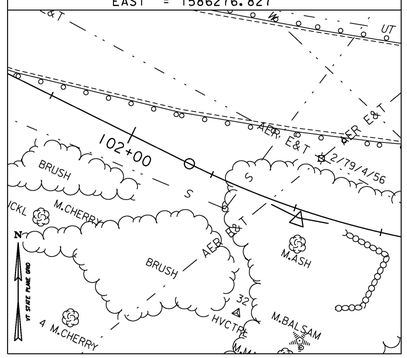



### PT STA 102+85.62
NORTH = 718940.385
EAST = 1586340.757

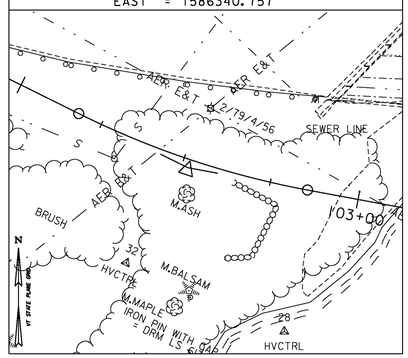



### PC STA 104+04.17
NORTH = 718918.632
EAST = 1586457.298

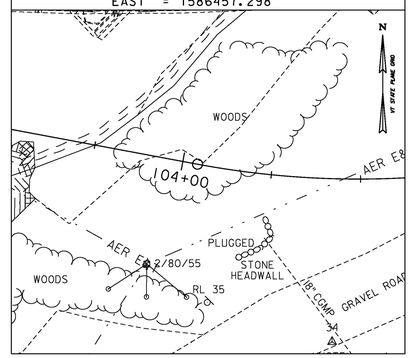



### PT STA 106+16.60
NORTH = 718969.358
EAST = 1586656.787

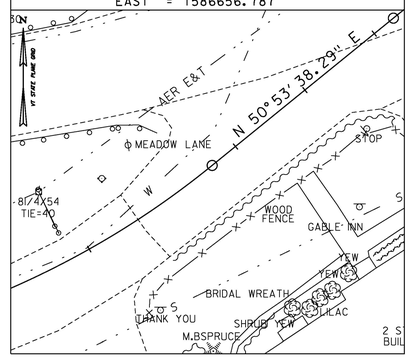


### PC STA 106+81.87
NORTH = 719010.530
EAST = 1586707.438

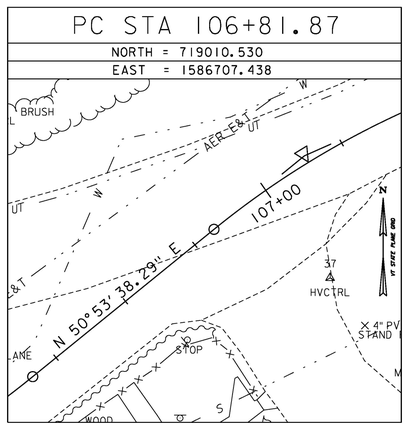


### PRC STA 107+46.66
NORTH = 719044.311
EAST = 1586762.499

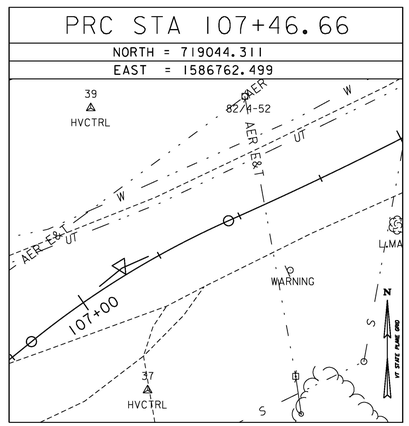


DATUM

| | |
|---|---|
| VERTICAL | NAVD 88 |
| HORIZONTAL | NAD 83(96) |
| ADJUSTMENT | COMPASS |

PROJECT NAME: STOWE
PROJECT NUMBER: BRF 0235(15)

FILE NAME: z88c1901t1.dgn
PROJECT LEADER: J. BYATT
DESIGNED BY: K. RUTTER
TIE SHEET 2

PLOT DATE: 5/8/2015
DRAWN BY: K. RUTTER
CHECKED BY: C. GREGORY
SHEET 15 OF 79

N

VT STATE PLANE GRID

BOX BEAM GUARDRAIL
STA 11+14.0 TO 14+59.6 RT
STA 12+81.3 TO 14+66.9 LT

MANUFACTURED TERMINAL SECTION, TANGENT
STA 11+00.1 TO 11+14.0 RT
STA 12+67.1 TO 12+81.3 LT

RELOCATE UTILITY POLE, BY OTHERS
STA 13+07 LT
STA 14+48 RT

~~STONE FILL, TYPE II~~
~~STA 12+00 TO 13+00 RT~~
ELIMINATED PER R.E.
SUCKERT

GUARDRAIL APPROACH SECTION,
GALVANIZED 3 RAIL BOX BEAM
STA 14+59.6 TO 14+90.9 RT
STA 14+66.9 TO 15+02.5 LT

REMOVAL AND DISPOSAL OF GUARDRAIL
STA 11+19 TO 14+75 RT
STA 12+71 TO 14+75 LT

VT ROUTE 108
CURVE (1)
DELTA = 48°37'25" LT
D = 7°09'43"
R = 800.00'
T = 361.41'
L = 678.91'
E = 77.85'
BANKING = 0.048%

BEGIN PROJECT
STA 11+00.00

BEGIN APPROACH
STA 10+00.00

POB STA 10+00.00

VT 108 STA 12+00.00 =
DETOUR STA 100+00.00

PC 12+24.49

PERMANENT CONSTRUCTION
LIMITS

PROPOSED 12" WATER
BY OTHERS

MATCH LINE 14+75

VT 108
TO CAMBRIDGE

S 65°19'55.45" E

11+00

12+00

13+00

14+00

BM#10
RRSIR M.BSPRUCE
ELEV:

EXISTING STATE
RIGHT-OF-WAY

TEMPORARY DETOUR
ALIGNMENT
(SEE SHEET 22)

ABANDONED
WATER

WEST BRANCH OF
LITTLE RIVER
FLOW

BIKE PATH

BRICK

RESTROOM

WOODS

BRUSH

STOWE GOLF PARK
ROCK GDN

SUN AND SKI
INN

ROCK
GARDEN

PAVED
DRIVE

STOWE
COUNTRY
CLUB

LAST SWC IS SWC2 ST

SCALE 1" = 20'-0"
20 0 20

CLD 12-0120 MODEL: 01

CONSULTING ENGINEERS

| | |
|---|---|
| PROJECT NAME: STOWE | |
| PROJECT NUMBER: BRF 0235(15) | |
| FILE NAME: z88c190bdr.dgn | PLOT DATE: 5/8/2015 |
| PROJECT LEADER: J. BYATT | DRAWN BY: S. FORTIER |
| DESIGNED BY: K. RUTTER | CHECKED BY: C. GREGORY |
| LAYOUT SHEET 1 | SHEET 16 OF 79 |

N

VT STATE PLANE GRID

BOX BEAM GUARDRAIL
STA 16+71.9 TO 17+01.3 RT
STA 16+88.4 TO 18+90.1 LT

MANUFACTURED TERMINAL SECTION, TANGENT
STA 17+01.3 TO 17+15.0 RT
STA 18+90.1 TO 19+04.4 LT

GUARDRAIL APPROACH SECTION, GALVANIZED 3 RAIL BOX BEAM
STA 16+40.5 TO 16+71.9 RT
STA 16+52.7 TO 16+88.4 LT

BRIDGE RAILING, GALVANIZED 3 RAIL BOX BEAM
STA 14+90.9 TO 16+40.5 RT
STA 15+02.5 TO 16+52.7 LT

REMOVAL AND DISPOSAL OF GUARDRAIL
STA 14+75 TO 14+79 RT
STA 14+75 TO 15+01 LT
STA 16+41 TO 17+69 RT
STA 16+75 TO 17+62 LT

CONSTRUCT DRIVES WITH 5' PAVED APRON
STA 41+70 TO 42+32 RT (18" GRAVEL)
STA 18+19 TO 18+85 RT (18" GRAVEL)

STONE FILL, TYPE II
STA 40+46.3 LT (MEADOW LANE)

VT ROUTE 108
CURVE (2)
DELTA = 17°18'17" LT
D = 5°35'23"
R = 1025.00'
T = 155.97'
L = 309.57'
E = 11.80'
BANKING = 0.042

VT108 STA 15+50.00 =
CHANNEL STA 52+00.00
Δ = 50°00'00"
(TANGENT TO CURVE)

BEGIN BRIDGE
STA 14+98.20

CHANNEL
STA 53+50.00

WEST BRANCH OF LITTLE RIVER

PROPOSED 12" WATER
BY OTHERS

EXISTING TOWN
RIGHT-OF-WAY

PERMANENT CONSTRUCTION
LIMITS

END BRIDGE
STA 16+45.00

ABANDONED
WATER

REMOVE
18" CGMP

LIMIT OF WORK
STA 40+45.00

CHANNEL
STA 50+75.00

CHANNEL LINE
N 41°21' 18.84" E

MATCH LINE 14+75

MEADOW LANE
(TH 38)

EXISTING TOWN
RIGHT-OF-WAY

EXISTING STATE
RIGHT-OF-WAY

TEMPORARY DETOUR
ALIGNMENT (SEE SHEET 22)

N 64°06'12.06" E

N 50°27'12.70" E

VT 108 STA 20+36.73 =
DETOUR STA 108+80.00

EXISTING STATE
RIGHT-OF-WAY

END APPROACH
STA 21+00.00

VT 108
TO STOWE VILLAGE

END PROJECT
STA 20+00.00

P1 VT 108 20+59.28
P1 DETOUR 109+02.64

STA 18+73.32 VT 108 =
STA 43+64.73 MEADOW LANE

MEADOW LANE
CURVE (2)
DELTA = 13°38'59" LT
D = 22°55'06"
R = 250.00'
T = 29.92'
L = 59.56'
E = 1.78'

EXISTING BRIDGE DATA

168'-0" TWO SPAN STEEL GIRDER
26'-8" CURB TO CURB
20' +/- VERTICAL CLEARANCE TO STREAM BED
BUILT IN 1938

MEADOW LANE
CURVE (1)
DELTA = 11°21'40" RT
D = 19°05'55"
R = 300.00'
T = 29.84'
L = 59.49'
E = 1.48'


18" x 60' CPEP(SL) WAS INSTALLED WITH NO HEADWALL AT INLET OR END SECTION AND STONE PAD AT OUTLET. APPROVED BY TOWN OF STOWE.

SCALE 1" = 20'-0"
20 0 20

CONSULTING ENGINEERS

| | |
|---|---|
| PROJECT NAME: STOWE | |
| PROJECT NUMBER: BRF 0235(15) | |
| FILE NAME: z88cl90bdr.dgn | PLOT DATE: 5/8/2015 |
| PROJECT LEADER: J. BYATT | DRAWN BY: K. RUTTER |
| DESIGNED BY: K. RUTTER | CHECKED BY: C. GREGORY |
| LAYOUT SHEET 2 | SHEET 17 OF 79 |

CLD 12-0120 MODEL: 02

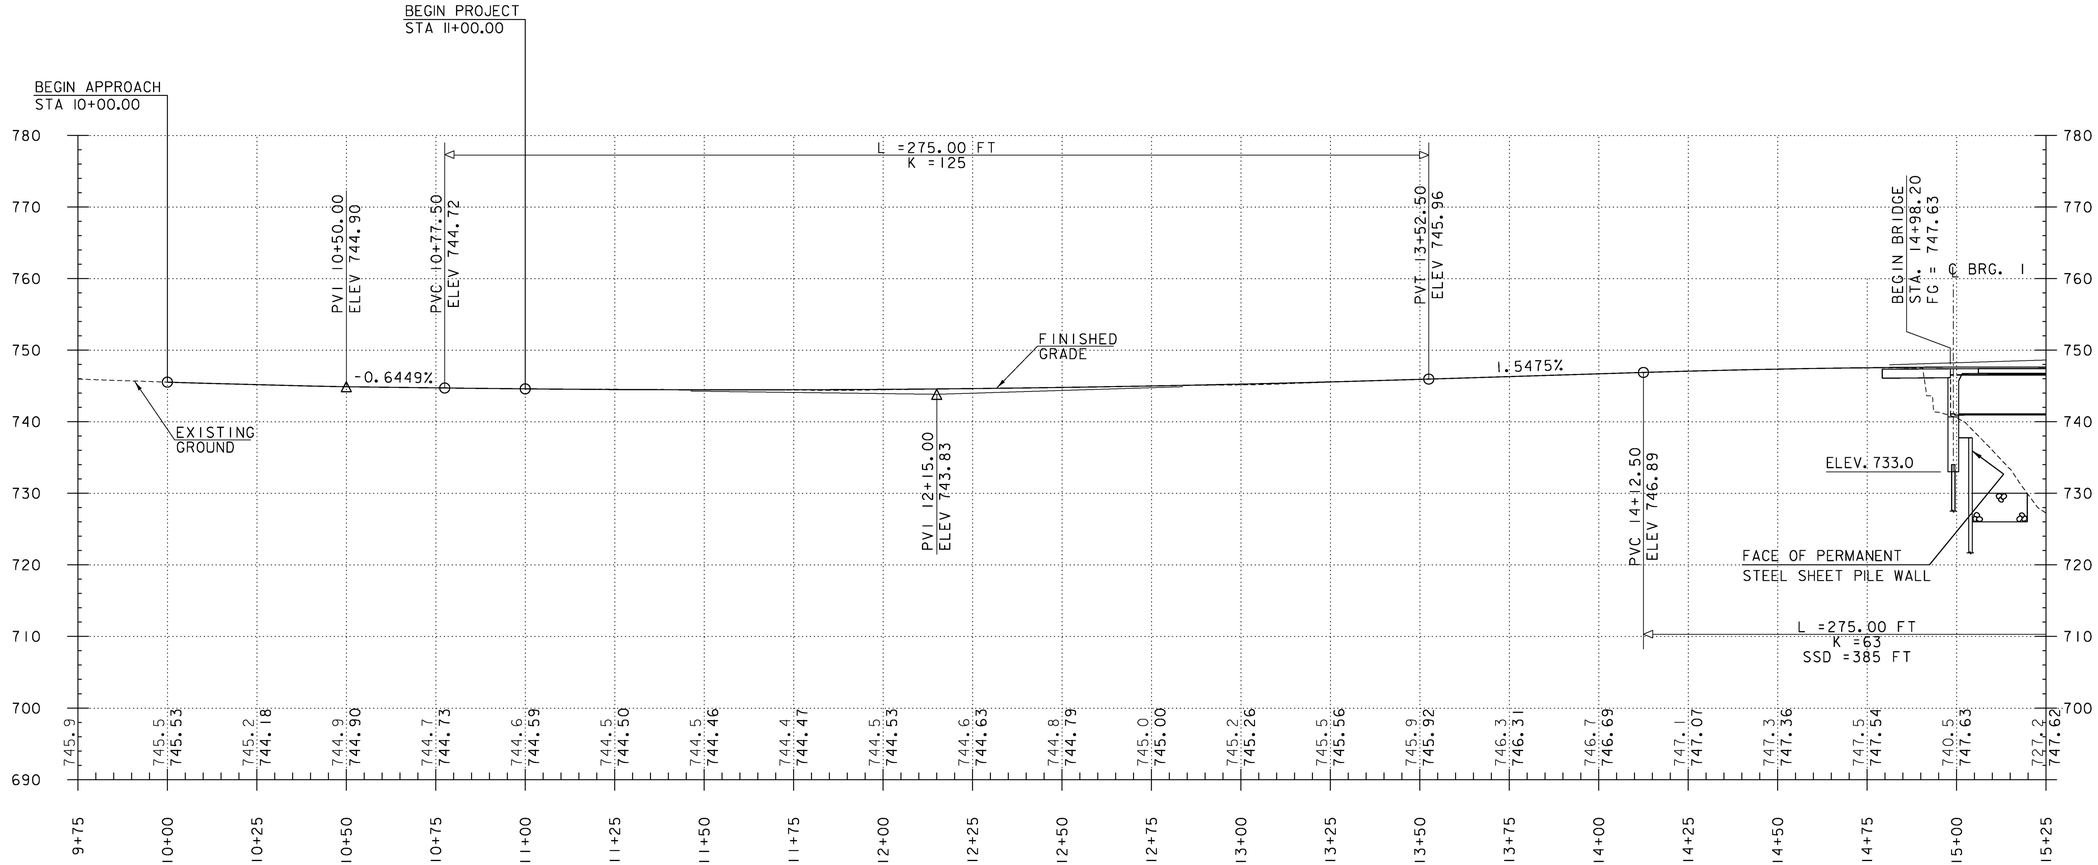


## PROFILE VT 108

HOR. SCALE 1" = 20'-0"
VER. SCALE 1" = 10'-0"


NOTES:
GRADES SHOWN TO THE NEAREST TENTH ARE EXISTING GROUND ALONG THE PROPOSED CENTER LINE.

GRADES SHOWN TO THE NEAREST HUNDREDTH ARE FINISHED GRADE ALONG THE PROPOSED CENTER LINE.

CLD 12-020 MODEL: VT108 PRO 01

CLD CONSULTING ENGINEERS

| | |
|---|---|
| PROJECT NAME: STOWE | |
| PROJECT NUMBER: BRF 0235(15) | |
| FILE NAME: z88cl90pro.dgn | PLOT DATE: 5/8/2015 |
| PROJECT LEADER: J. BYATT | DRAWN BY: S. FORTIER |
| DESIGNED BY: K. RUTTER | CHECKED BY: C. GREGORY |
| VT 108 PROFILE SHEET 1 | SHEET 18 OF 79 |

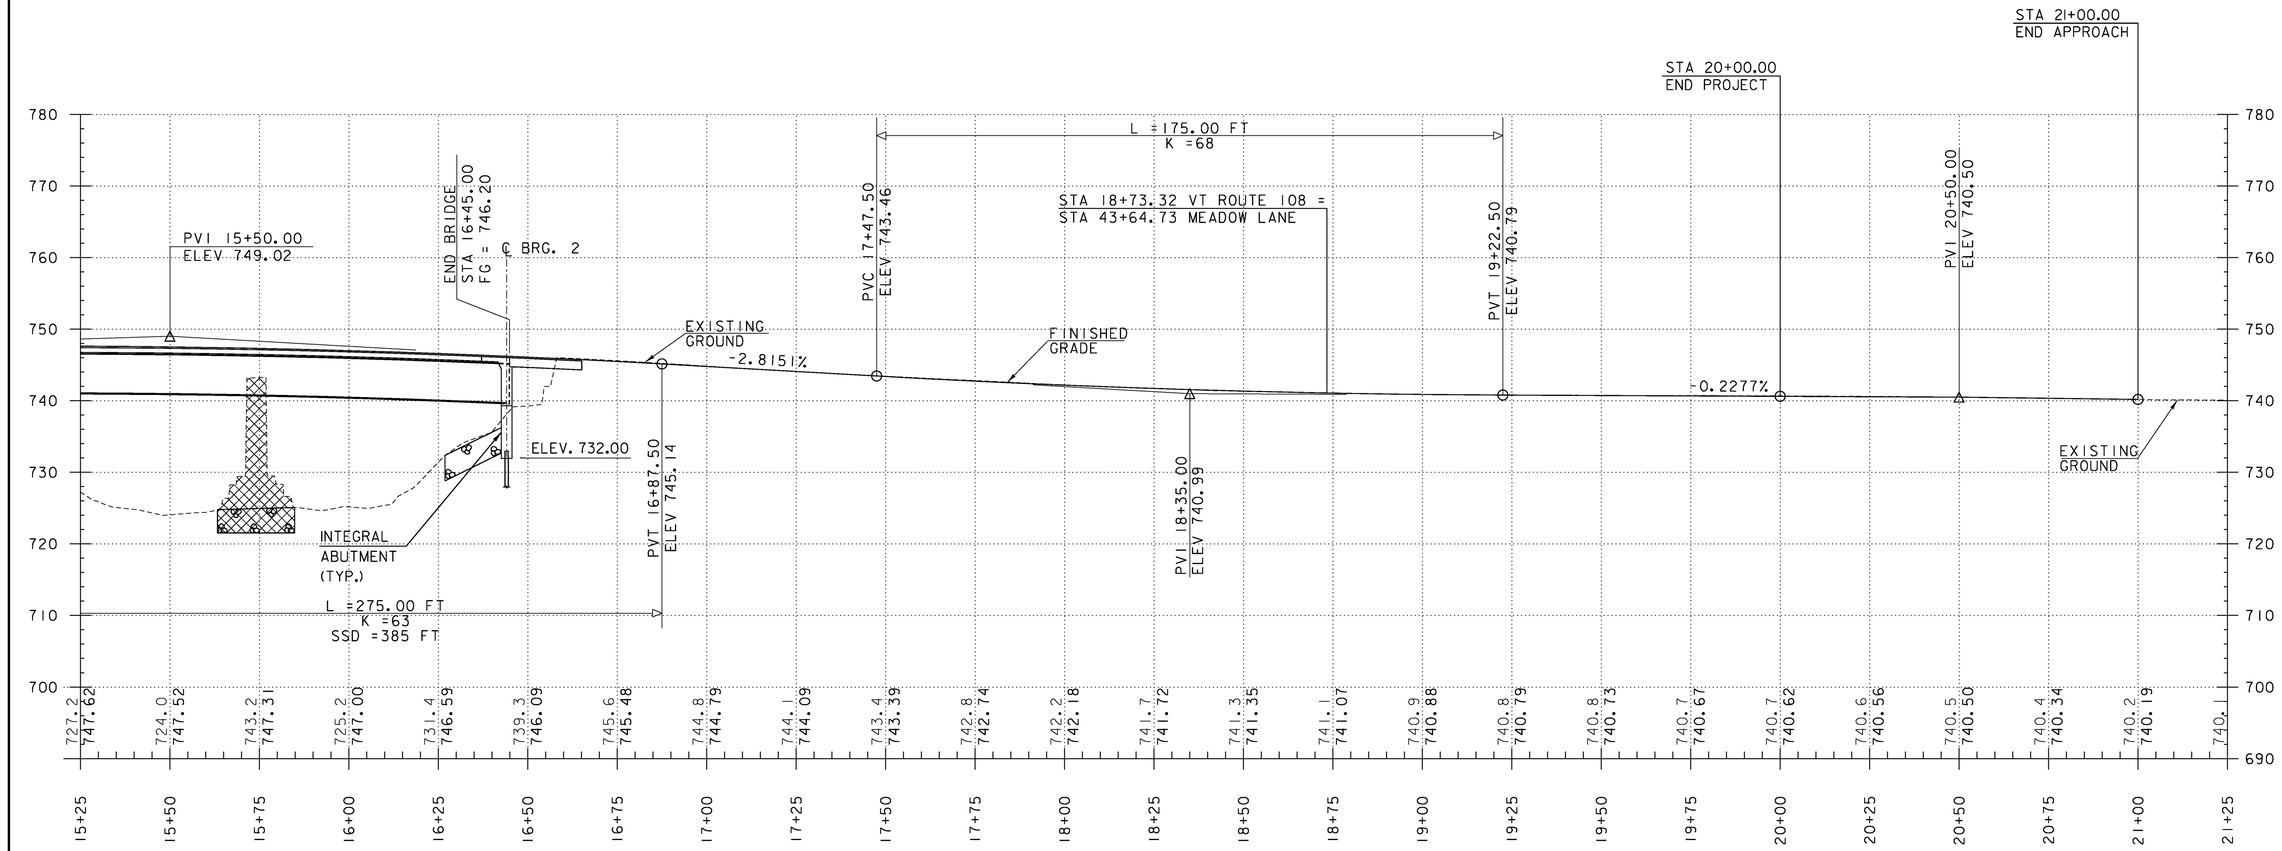


## PROFILE VT 108


HOR. SCALE 1" = 20'-0"
VER. SCALE 1" = 10'-0"

NOTES:
GRADES SHOWN TO THE NEAREST TENTH ARE EXISTING GROUND ALONG THE PROPOSED CENTER LINE.

GRADES SHOWN TO THE NEAREST HUNDREDTH ARE FINISHED GRADE ALONG THE PROPOSED CENTER LINE.


CLD 12-020 MODEL: VT108 PRO 02

| | |
|---|---|
| PROJECT NAME: | STOWE |
| PROJECT NUMBER: | BRF 0235(15) |
| FILE NAME: z88cl90pro.dgn | PLOT DATE: 5/8/2015 |
| PROJECT LEADER: J. BYATT | DRAWN BY: S. FORTIER |
| DESIGNED BY: K. RUTTER | CHECKED BY: C. GREGORY |
| VT 108 PROFILE SHEET 2 | SHEET 19 OF 79 |

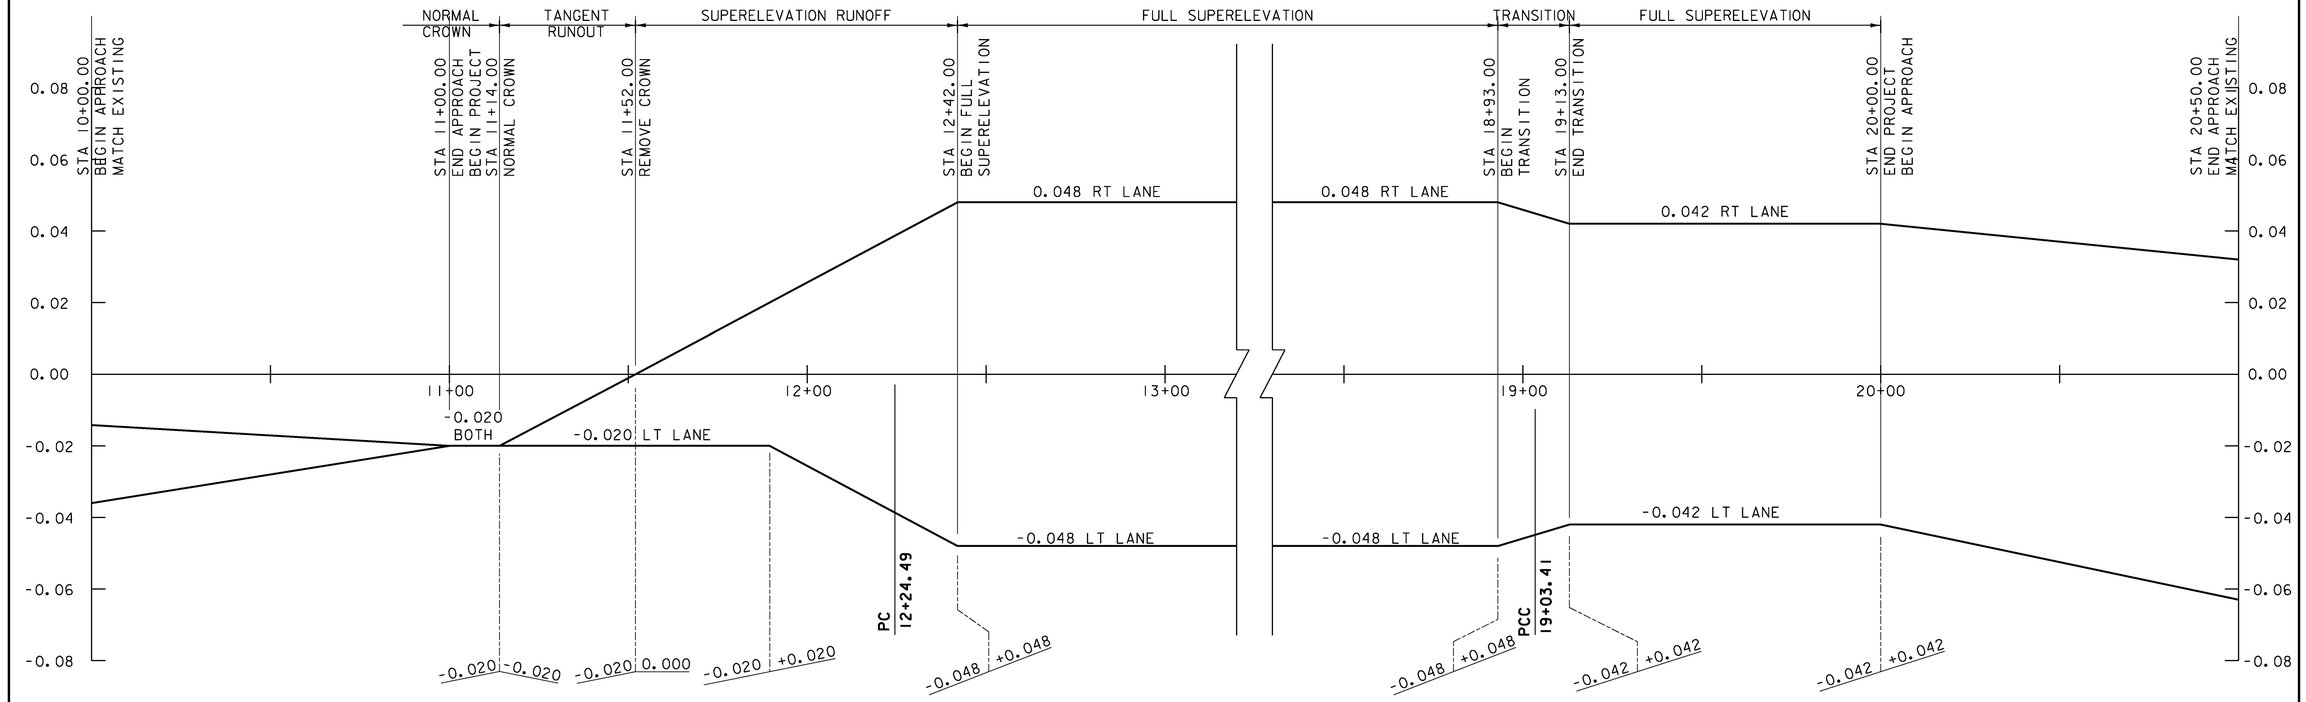


## VT 108 BANKING DIAGRAM

HOR. SCALE 1" = 20'-0"
VER. SCALE 1" = .02'

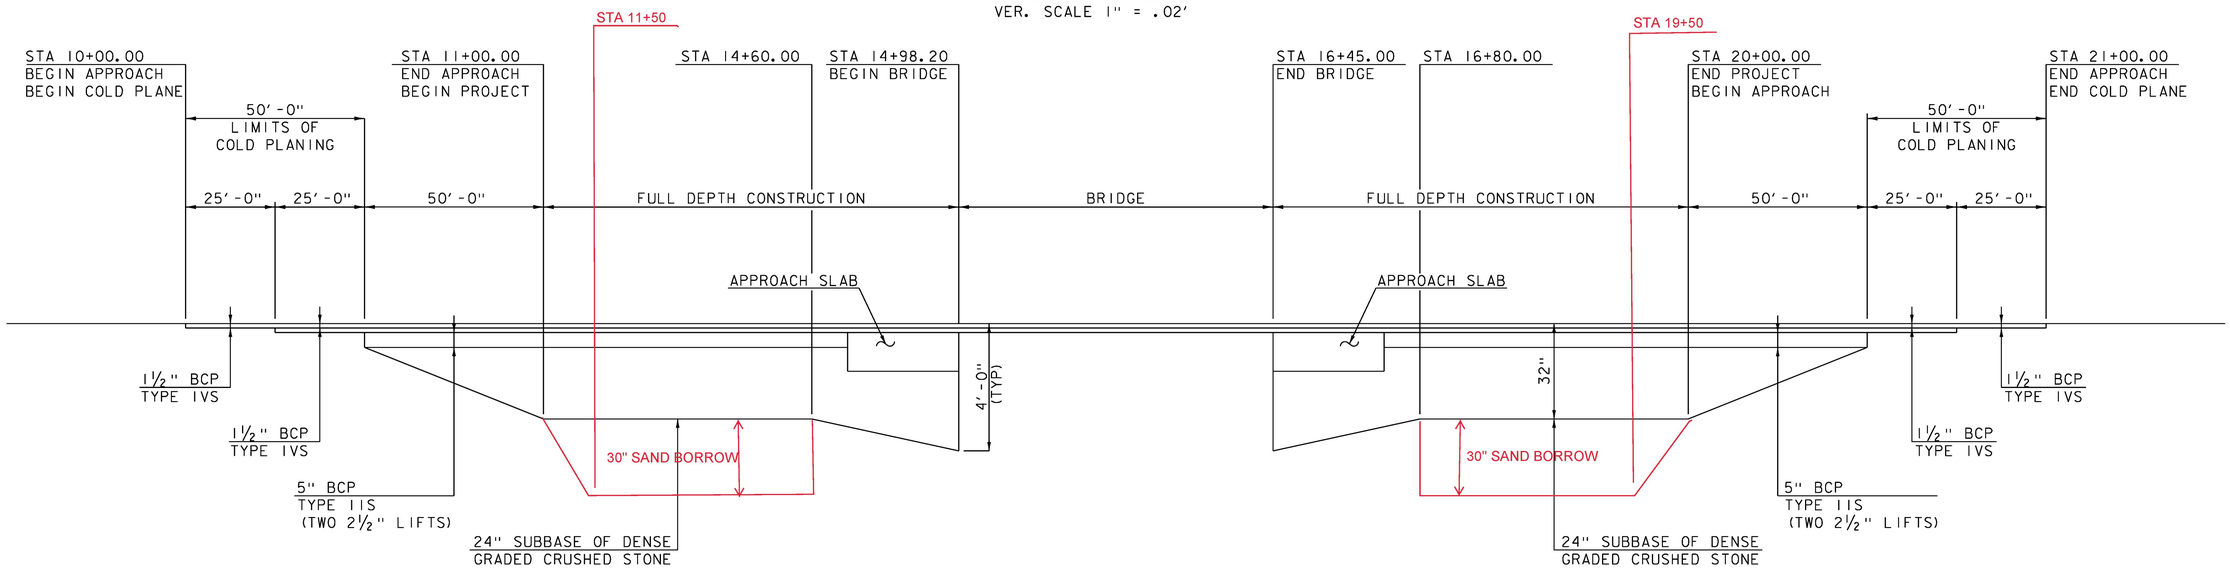


## VT 108 MATERIAL TRANSITION DIAGRAM


NOT TO SCALE

REVISED MATERIAL TRANSITION DETAIL TO INCORPORATE SAND BORROW TAPER.

CONSULTING ENGINEERS

| | |
|---|---|
| PROJECT NAME: | STOWE |
| PROJECT NUMBER: | BRF 0235(15) |
| FILE NAME: z88cl90bank.dgn | PLOT DATE: 5/8/2015 |
| PROJECT LEADER: J. BYATT | DRAWN BY: K. RUTTER |
| DESIGNED BY: K. RUTTER | CHECKED BY: C. GREGORY |
| MATERIAL TRANSITION & BANKING DIAGRAM | SHEET 20 OF 79 |

CLD 12-0120 MODEL: 01

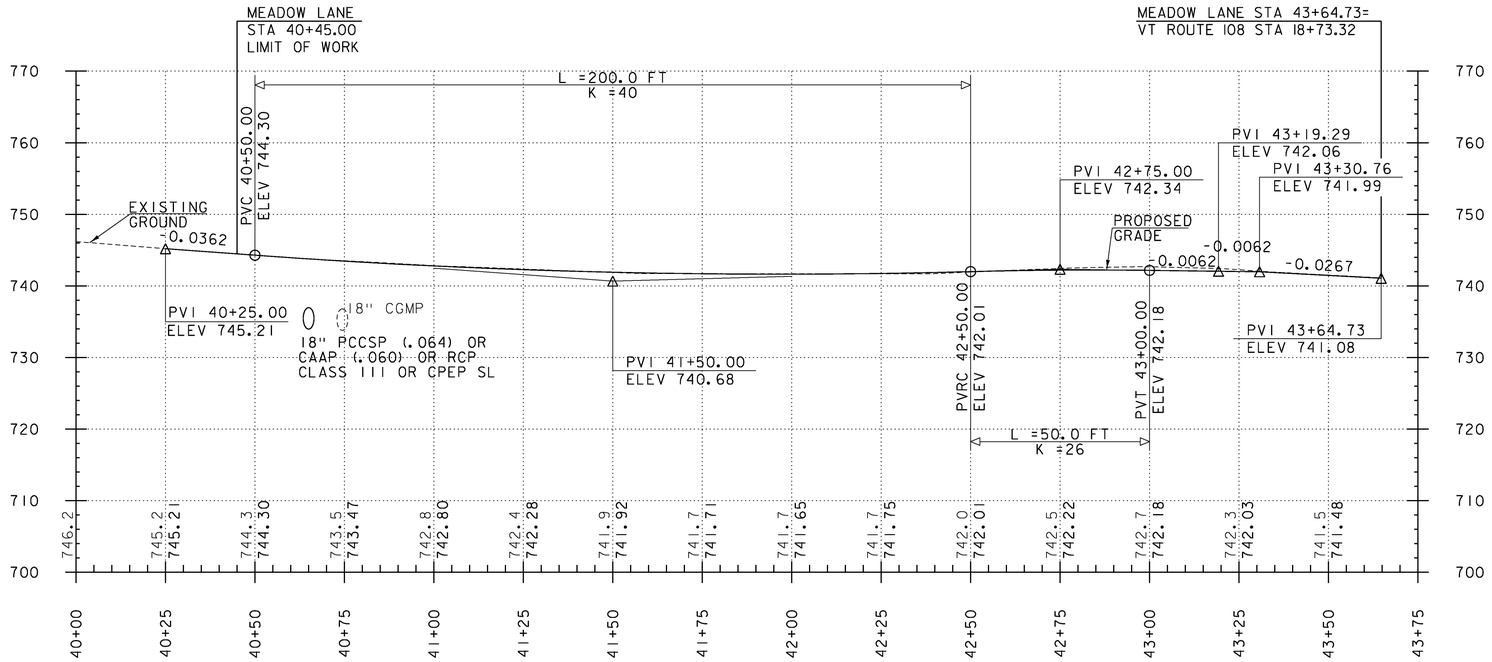


## PROFILE MEADOW LANE


HOR. SCALE 1" = 20'-0"
VER. SCALE 1" = 10'-0"

NOTES:
GRADES SHOWN TO THE NEAREST TENTH ARE EXISTING GROUND ALONG THE PROPOSED CENTER LINE.

GRADES SHOWN TO THE NEAREST HUNDREDTH ARE FINISHED GRADE ALONG THE PROPOSED CENTER LINE.

CLD 12-0120 MODEL: MEADOW LANE PRO

| | |
|---|---|
| PROJECT NAME: STOWE | |
| PROJECT NUMBER: BRF 0235(15) | |
| FILE NAME: z88cl90proMeadow.dgn | PLOT DATE: 5/8/2015 |
| PROJECT LEADER: J. BYATT | DRAWN BY: S. FORTIER |
| DESIGNED BY: K. RUTTER | CHECKED BY: C. GREGORY |
| MEADOW LANE PROFILE SHEET | SHEET 21 OF 79 |

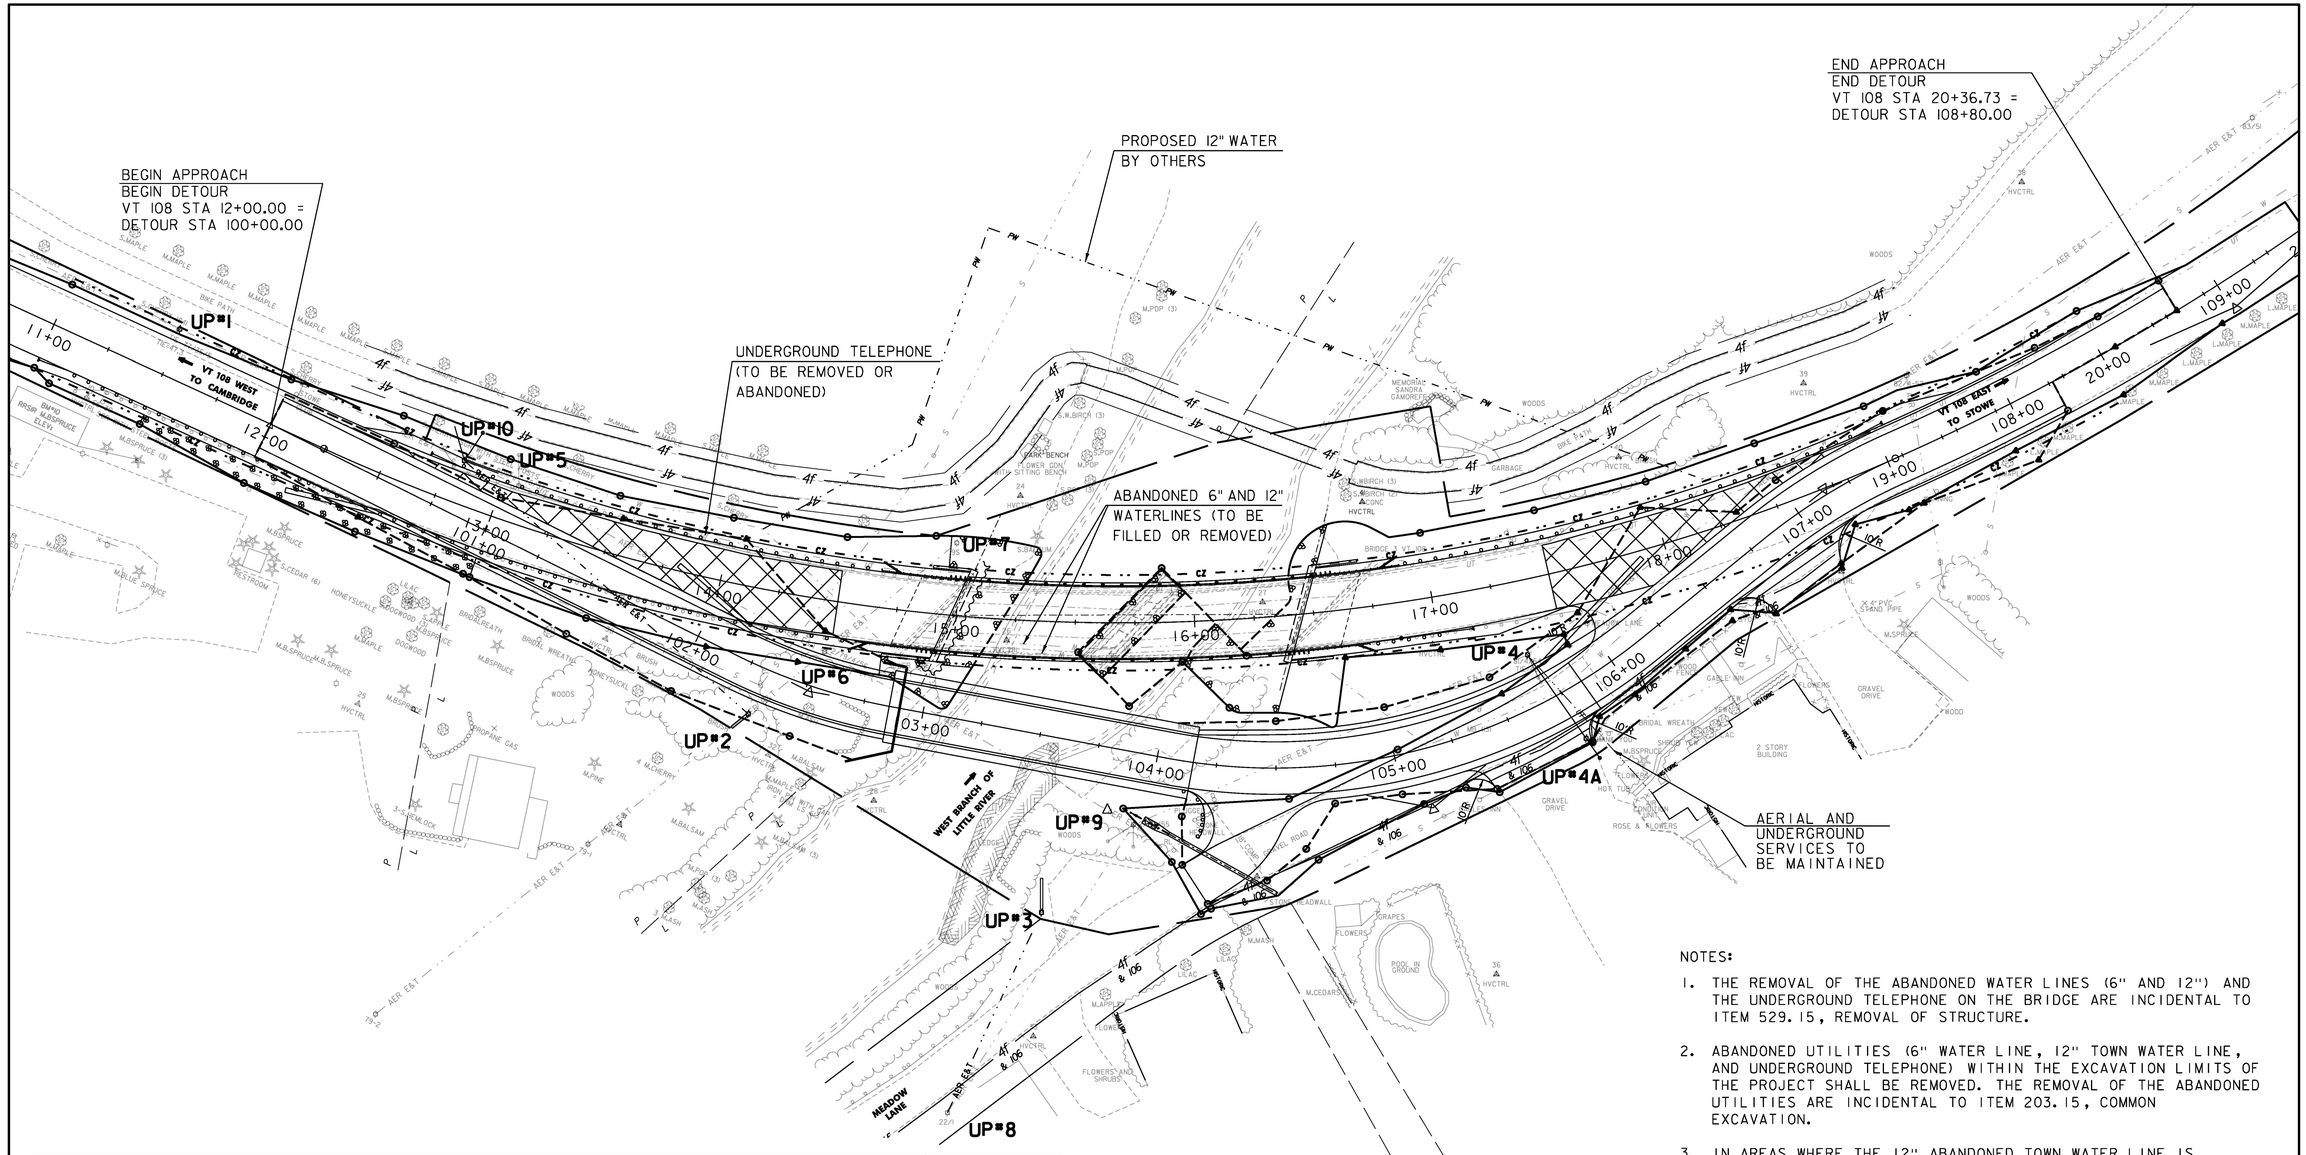


| MARK | STATION | OFFSET | NORTHING | EASTING | PHASE (PRE-CONSTRUCTION/FINAL) | REMARKS | POLE NUMBER |
|---|---|---|---|---|---|---|---|
| UP#1 | 11+49 | 20' LT | 719098.43 | 1586043.40 | PRE-CONSTRUCTION | REPLACE WITH TALLER UTILITY POLE. CONNECT LINES TO UP#10. | 77/35/5 |
| UP#2 | 14+22 | 53' RT | 718937.17 | 1586281.65 | PRE-CONSTRUCTION | INSTALL NEW UTILITY POLE WITH PUSH BRACE. CONNECT LINES TO UP#10. | NEW |
| UP#3 | 15+40 | 122' RT | 718853.95 | 1586404.61 | PRE-CONSTRUCTION | INSTALL NEW UTILITY POLE WITH PUSH BRACE. CONNECT LINES TO UP#2, UP#4 AND UP#8. | NEW |
| UP#4 | 17+34 | 31' RT | EXISTING | EXISTING | PRE-CONSTRUCTION | CLEAN GUY WIRES TO FIT. CONNECT LINES TO UP#3. | 81/4/54 |
| UP#4A | 17+50 | 70.6'RT | 718926.90 | 1586632.88 | PRE-CONSTRUCTION | INSTALL TEMPORARY UTILITY POLE AND 10' GUY. CONNECT TO UP #4. | TEMP. |
| | | | | | FINAL | REMOVE TEMPORARY POLE AND GUY. | |
| UP#5 | 13+07 | 16' LT | EXISTING | EXISTING | PRE-CONSTRUCTION | REMOVE EXISTING UTILITY POLE AND LINES | 78/57 |
| UP#6 | 14+47 | 22' RT | EXISTING | EXISTING | PRE-CONSTRUCTION | REMOVE EXISTING UTILITY POLE AND LINES | 2/79/4/56 |
| UP#7 | 14+97 | 30' LT | EXISTING | EXISTING | PRE-CONSTRUCTION | REMOVE EXISTING UTILITY POLE AND LINES | 9S |
| UP#8 | 15+11 | 208' RT | EXISTING | EXISTING | PRE-CONSTRUCTION | CONNECT LINES TO UP#3. | 22/1 |
| UP#9 | 15+74 | 85' RT | EXISTING | EXISTING | PRE-CONSTRUCTION | REMOVE EXISTING UTILITY POLE AND LINES | 2/80/55 |
| UP#10 | 12+82 | 18' RT | 719043.33 | 1586162.75 | FINAL | INSTALL NEW UTILITY POLE, 2 DEAD ENDS AND 14' GUY. CONNECT LINES TO UP#1 AND UP#2. | NEW |

NOTES:

1. THE REMOVAL OF THE ABANDONED WATER LINES (6" AND 12") AND THE UNDERGROUND TELEPHONE ON THE BRIDGE ARE INCIDENTAL TO ITEM 529.15, REMOVAL OF STRUCTURE.
2. ABANDONED UTILITIES (6" WATER LINE, 12" TOWN WATER LINE, AND UNDERGROUND TELEPHONE) WITHIN THE EXCAVATION LIMITS OF THE PROJECT SHALL BE REMOVED. THE REMOVAL OF THE ABANDONED UTILITIES ARE INCIDENTAL TO ITEM 203.15, COMMON EXCAVATION.
3. IN AREAS WHERE THE 12" ABANDONED TOWN WATER LINE IS OUTSIDE OF THE EXACATION LIMITS, THE PIPE SHALL BE FILLED WITH CONTROLLED DENSITY (FLOWABLE) FILL, ITEM 541.45.
4. IN AREAS WHERE THE 6" ABANDONED WATER LINE IS OUTSIDE OF THE EXCAVATION LIMITS THE LINE SHALL BE ABANDONED IN PLACE.
5. IN AREAS WHERE THE UNDERGROUND TELEPHONE IS OUTSIDE OF THE EXCAVATION LIMITS, THE LINE SHALL BE ABANDONED IN PLACE.
6. SEE SHEET 79 FOR THE RELOCATED 12" TOWN WATER MAIN.

SCALE 1" = 30'-0"
30 0 30


CONSULTING ENGINEERS

PROJECT NAME: STOWE
PROJECT NUMBER: BRF 0235(15)

FILE NAME: z88cl90bdrutl.dgn
PROJECT LEADER: J. BYATT
DESIGNED BY: K. RUTTER
UTILITY RELOCATION SHEET

PLOT DATE: 5/8/2015
DRAWN BY: K. RUTTER
CHECKED BY: C. GREGORY
SHEET 22 OF 79

CLD 12-0120 MODEL: 01

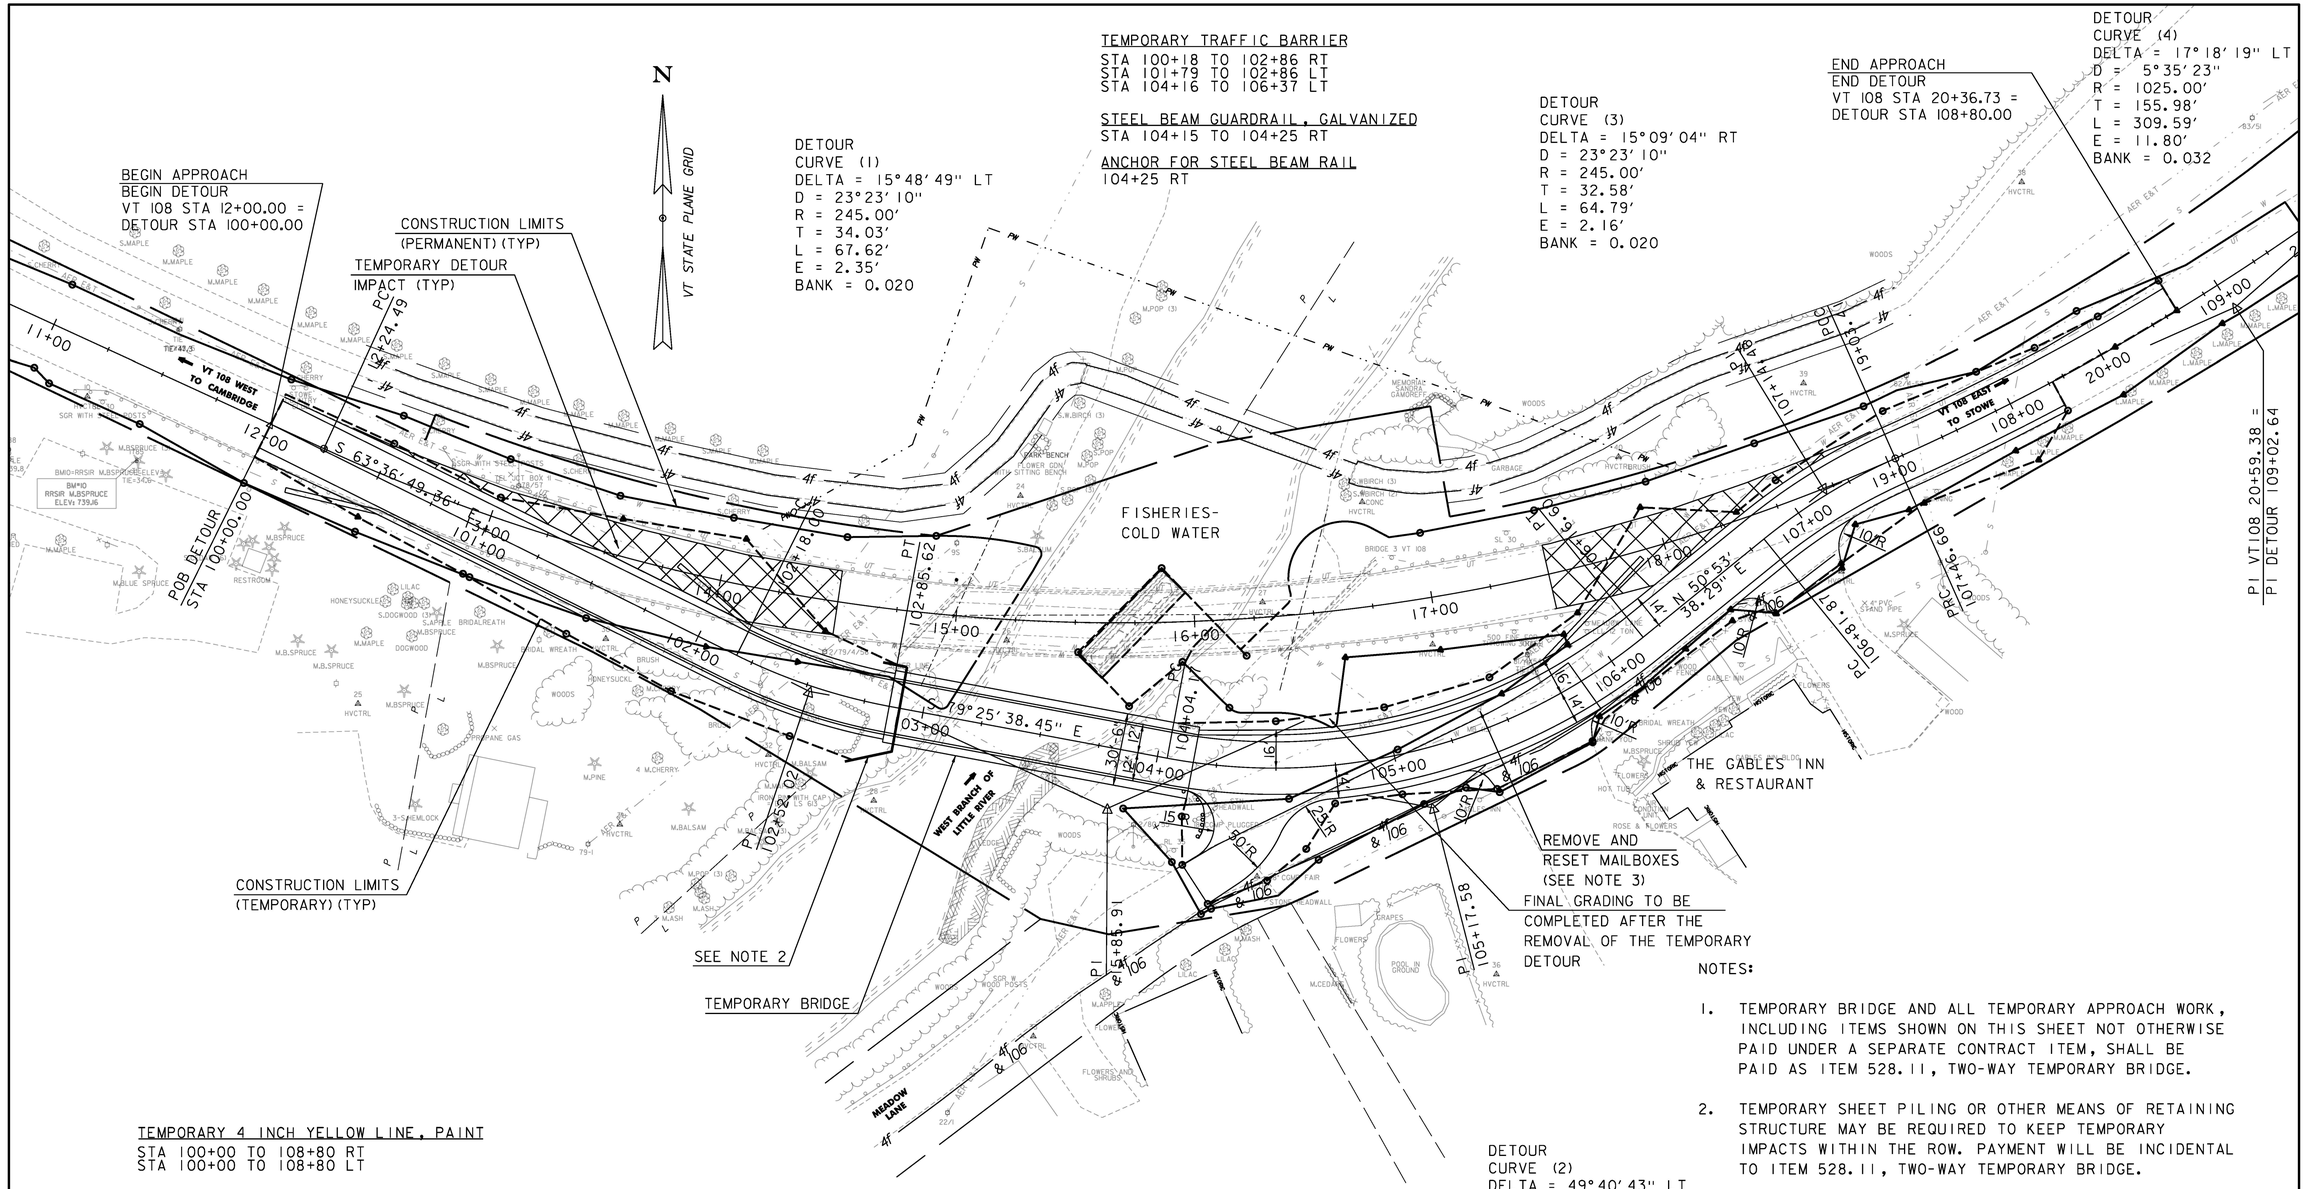


TEMPORARY 4 INCH YELLOW LINE, PAINT
STA 100+00 TO 108+80 RT
STA 100+00 TO 108+80 LT

TEMPORARY 4 INCH WHITE LINE, PAINT
STA 100+00 TO 108+20 RT
STA 100+00 TO 108+80 LT

CONSTRUCT DRIVES WITH AGGREGATE SURFACE COURSE
STA 105+25 TO 105+87 RT (18" GRAVEL)
STA 106+56 TO 107+22 RT (18" GRAVEL)

NOTES:

1. TEMPORARY BRIDGE AND ALL TEMPORARY APPROACH WORK, INCLUDING ITEMS SHOWN ON THIS SHEET NOT OTHERWISE PAID UNDER A SEPARATE CONTRACT ITEM, SHALL BE PAID AS ITEM 528.11, TWO-WAY TEMPORARY BRIDGE.

2. TEMPORARY SHEET PILING OR OTHER MEANS OF RETAINING STRUCTURE MAY BE REQUIRED TO KEEP TEMPORARY IMPACTS WITHIN THE ROW. PAYMENT WILL BE INCIDENTAL TO ITEM 528.11, TWO-WAY TEMPORARY BRIDGE.


3. TEMPORARILY RELOCATE THE MAILBOXES LOCATED AT APPROXIMATELY STA. 105+40, LEFT TO MEADOW LANE AT APPROXIMATELY STA. 40+20, LEFT OR AS DIRECTED BY THE ENGINEER, WHILE THE TEMPORARY DETOUR IS IN PLACE. ONCE THE DETOUR IS REMOVED THE MAILBOXES SHALL BE RESET IN THEIR ORIGINAL LOCATION. THIS WORK SHALL BE INCIDENTAL TO ITEM 528.11, TWO-WAY TEMPORARY BRIDGE.

SCALE 1" = 30'-0"
30 0 30

CONSULTING ENGINEERS

| | |
|---|---|
| PROJECT NAME: | STOWE |
| PROJECT NUMBER: | BRF 0235(15) |
| FILE NAME: z88c190bdrtcp.dgn | PLOT DATE: 6/1/2015 |
| PROJECT LEADER: J. BYATT | DRAWN BY: K. RUTTER |
| DESIGNED BY: K. RUTTER | CHECKED BY: C. GREGORY |
| TRAFFIC CONTROL SHEET | SHEET 23 OF 79 |

CLD 12-0120 MODEL: 01

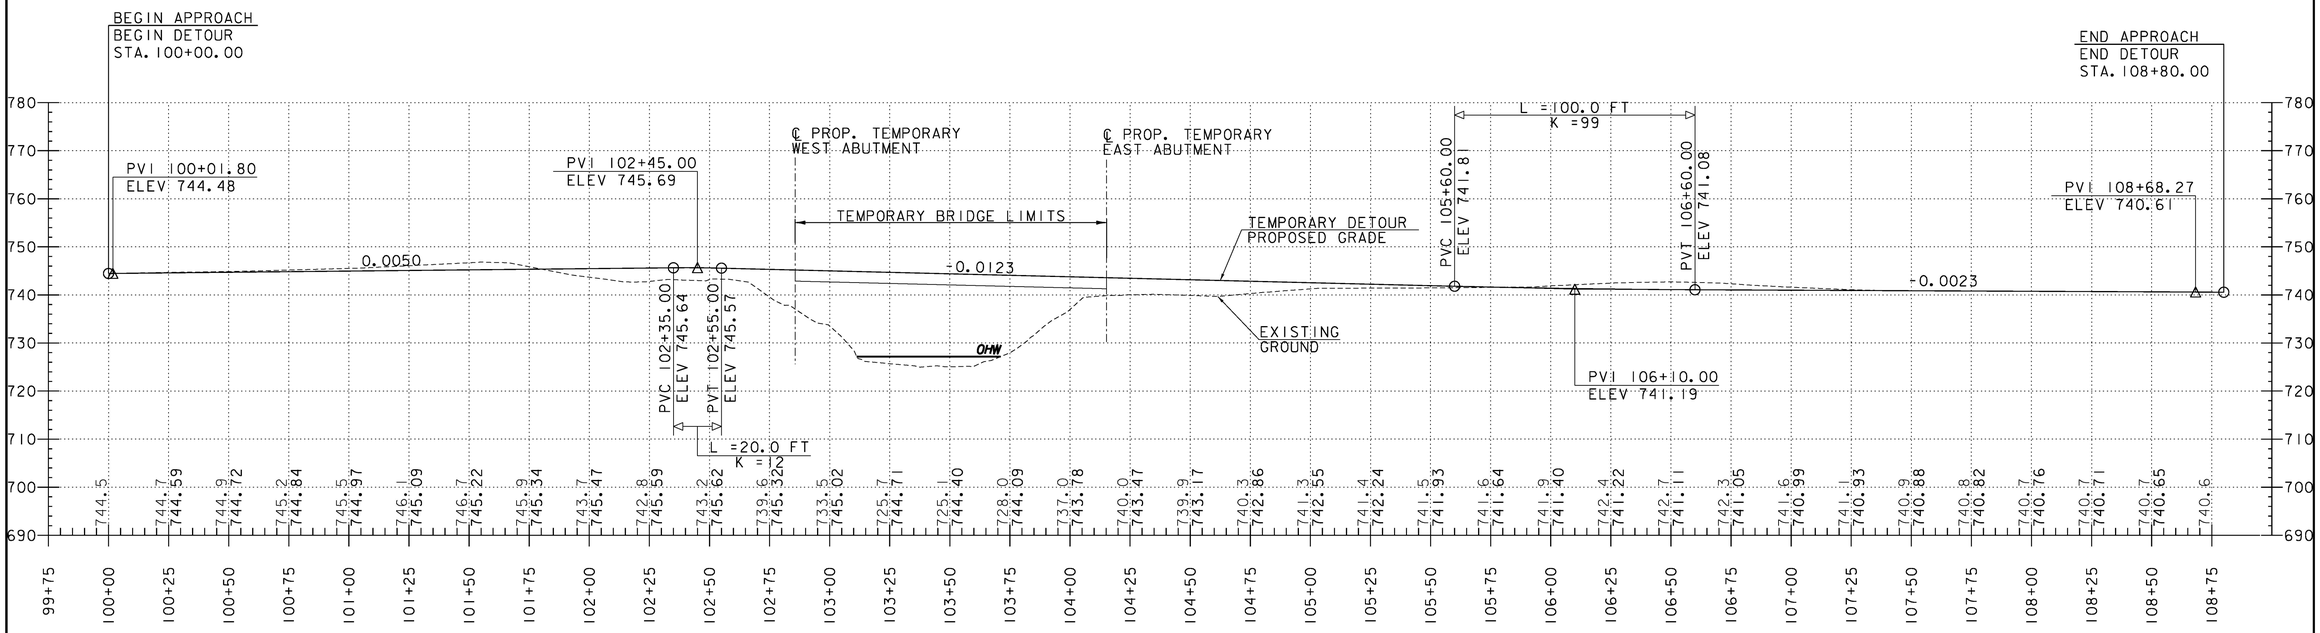


# PROFILE VT108 TEMPORARY DETOUR


HOR. SCALE 1" = 30'-0"
VER. SCALE 1" = 15'-0"

NOTES:
GRADES SHOWN TO THE NEAREST TENTH ARE EXISTING GROUND ALONG THE PROPOSED CENTER LINE.

GRADES SHOWN TO THE NEAREST HUNDREDTH ARE FINISHED GRADE ALONG THE PROPOSED CENTER LINE.

CLD 12-020 MODEL: TEMP BRIDGE PRO

| | |
|---|---|
| PROJECT NAME: STOWE | |
| PROJECT NUMBER: BRF 0235(15) | |
| FILE NAME: z88cl90proDetour.dgn | PLOT DATE: 5/8/2015 |
| PROJECT LEADER: J. BYATT | DRAWN BY: K. RUTTER |
| DESIGNED BY: K. RUTTER | CHECKED BY: C. GREGORY |
| TRAFFIC CONTROL PROFILE SHEET | SHEET 24 OF 79 |

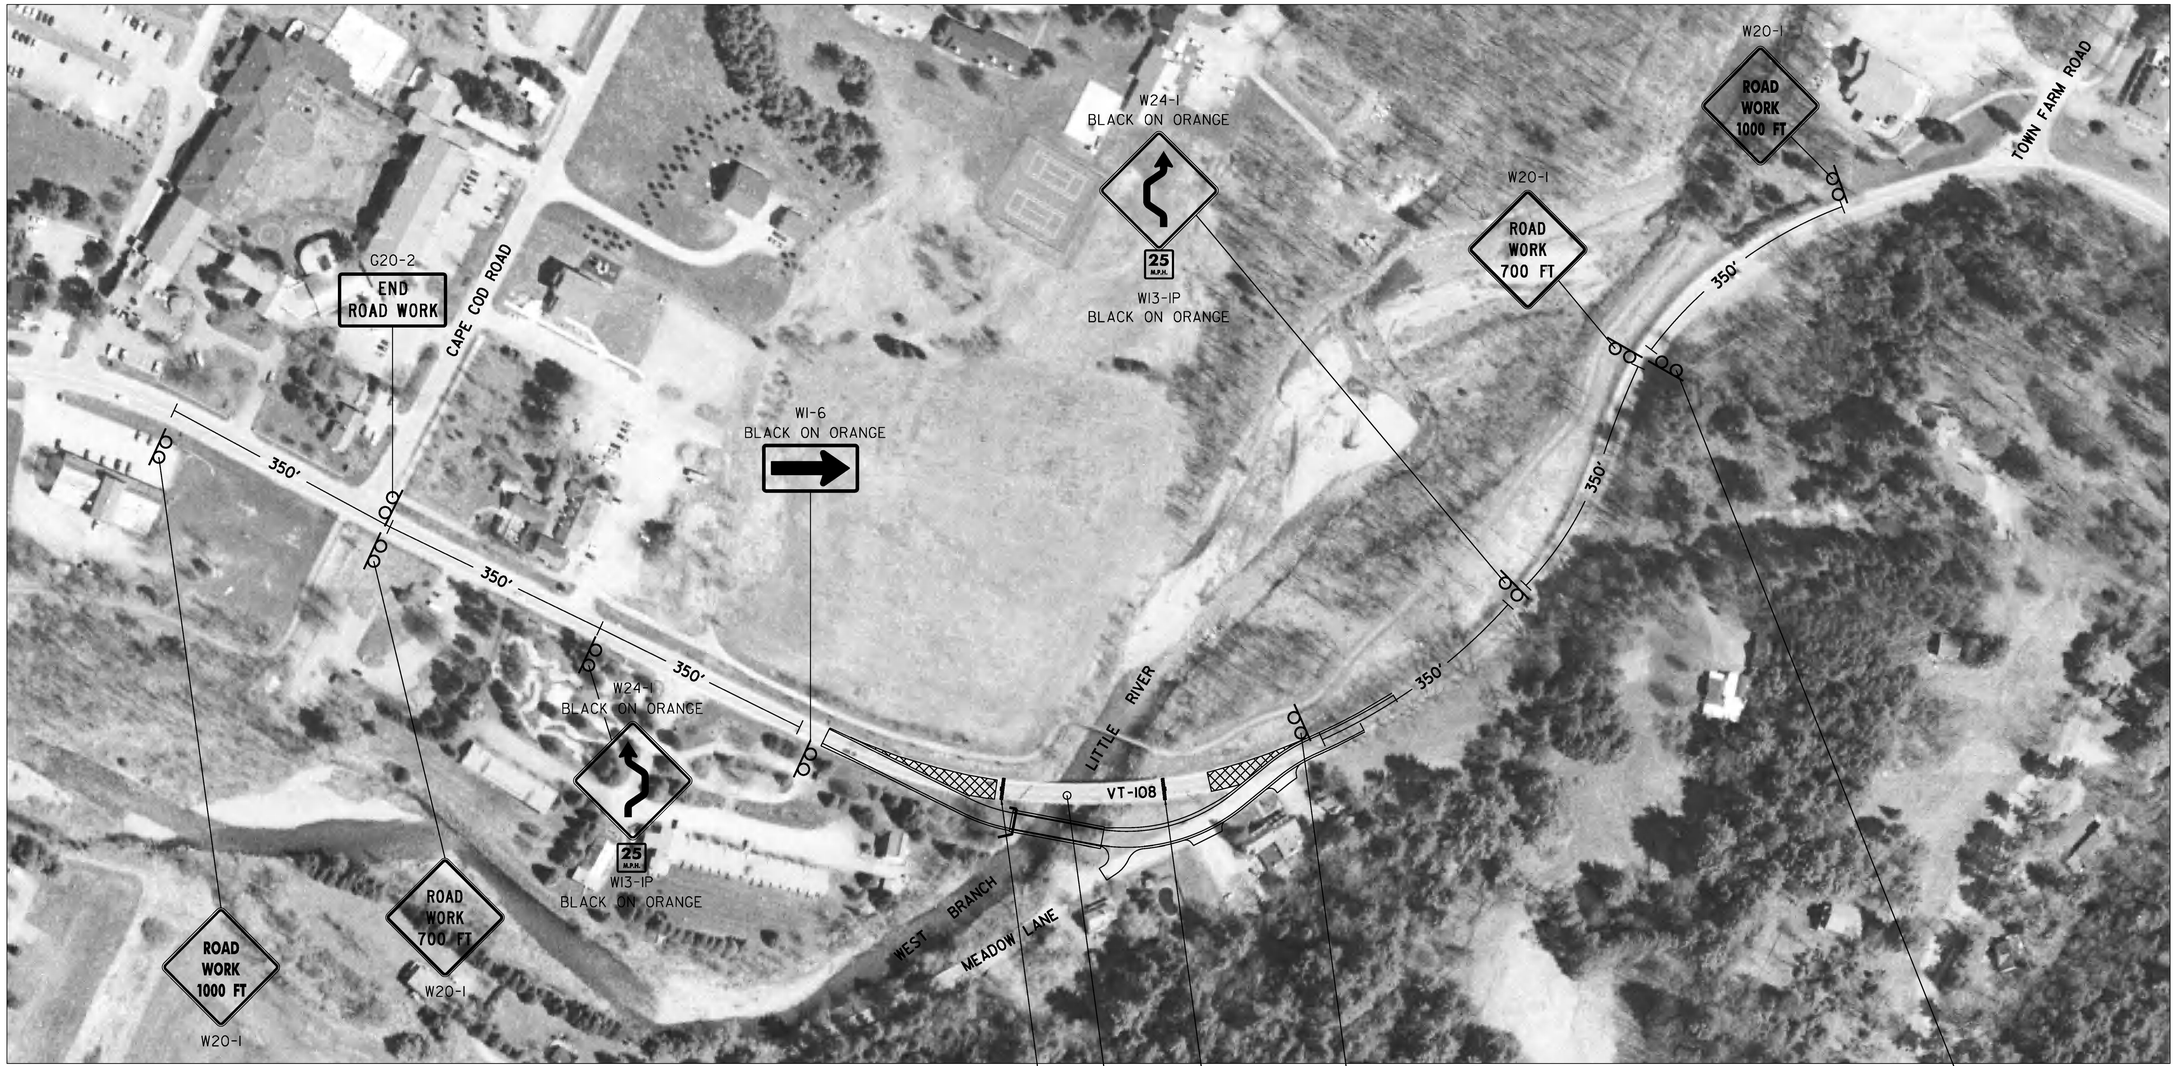


NOTES:

1. ALL TEMPORARY TRAFFIC SIGNS SHALL BE PAID FOR UNDER ITEM 641.10, TRAFFIC CONTROL, UNLESS OTHERWISE SPECIFIED.
2. NO CONSTRUCTION SIGN SHALL BE INSTALLED AS TO INTERFERE OR OBSTRUCT THE VIEW OF EXISTING TRAFFIC CONTROL DEVICES, STOPPING SIGHT DISTANCE, AND CORNER SIGHT DISTANCE FROM DRIVES AND INTERSECTING ROADS.
3. ALL PERMANENT SIGNS THAT CONFLICT WITH TEMPORARY TRAFFIC CONTROL SHALL BE COMPLETELY COVERED DURING CONSTRUCTION.
4. THE CONTRACTOR SHALL PROVIDE TWO (2) PORTABLE CHANGEABLE MESSAGE SIGNS FOR THE DURATION OF THE PROJECT, WHICH SHALL BE PAID UNDER ITEM 641.15, PORTABLE CHANGEABLE MESSAGE SIGN. THE LOCATION AND MESSAGE CONTENT SHALL BE DETERMINED IN THE FIELD BY THE ENGINEER.
5. MAINTAIN ACCESS TO DRIVES.

100 0 100

SCALE: 1" = 100'-0"

RII-2 B/W SIGN MOUNTED ON TYPE III BARRICADE (MODIFIED)

CONSULTING ENGINEERS

| | |
|---|---|
| PROJECT NAME: | STOWE |
| PROJECT NUMBER: | BRF 0235(15) |
| FILE NAME: z88cl90tcpsign.dgn | PLOT DATE: 5/8/2015 |
| PROJECT LEADER: J. BYATT | DRAWN BY: M. SMITH |
| DESIGNED BY: K. RUTTER | CHECKED BY: C. GREGORY |
| TRAFFIC CONTROL SIGN PLAN | SHEET 25 OF 79 |

CLD 12-020 MODEL: TCP SIGN PLAN

TEMPORARY 4 INCH WHITE LINE, PAINT
DURABLE 4 INCH WHITE LINE (OPTION BID ITEM)
STA 10+00 TO 14+75 SOLID LT & RT

TEMPORARY 4 INCH YELLOW LINE, PAINT
DURABLE 4 INCH YELLOW LINE (OPTION BID ITEM)
STA 10+00 TO 14+75 SOLID LT & RT

REMOVING SIGNS
AS SHOWN - 1

ERECTING SALVAGED SIGNS
AS SHOWN - 1

N
VT STATE PLANE GRID

NOT INSTALLED??

BEGIN PROJECT
STA 11+00.00

BEGIN APPROACH
STA 10+00.00

10+07 LT
RECREATION TRAIL
RET
RET RET
RET RET

12+04 LT
TIC
S
N N

12+04 LT
TIC
R&S
R R

PROPOSED 12" WATER
BY OTHERS

VT 108 STA 12+00.00 =
DETOUR STA 100+00.00

MATCH LINE 14+75

SLOW
22
HVCTRL
WARNING BICYCLES
76/4/59
BIKE PATH
AER E&T
CZ
4"WL
11+00
12+00
13+00
14+00
14+70 RT
BRIDGE 3 VT-108 N
N
SGR WITH STEEL POSTS
W BEAM W-BEAM
STOWE COUNTRY CLUB
TIE 77/35/5
TIE 47/3
82/79/4/56
PW
30
HVCTRL
32
HVCTRL
IRON PIN WITH CAP
= DRM LS 613
STOWE GOLF PARK
PAVED DRIVE
SUN AND SKI INN
BM#10
RRSIR M.BSPRUCE
ELEV:
LAST SWC IS SWC2 ST
BRICK
PROPANE GAS
25
HVCTRL
79-1
P L
11+32 RT
SPEED LIMIT 30
RET
RET
WEST BRANCH OF LITTLE RIVER FLOW

SCALE 1" = 20'-0"
20 0 20

CONSULTING ENGINEERS

| | |
|---|---|
| PROJECT NAME: STOWE | |
| PROJECT NUMBER: BRF 0235(15) | |
| FILE NAME: z88cl90bdrts.dgn | PLOT DATE: 5/8/2015 |
| PROJECT LEADER: J. BYATT | DRAWN BY: S. GOODWIN |
| DESIGNED BY: K. RUTTER | CHECKED BY: C. GREGORY |
| TRAFFIC SIGN & LINE LAYOUT SHEET 1 | SHEET 26 OF 79 |

CLD 12-020 MODEL: 01

TEMPORARY 4 INCH WHITE LINE, PAINT
DURABLE 4 INCH WHITE LINE (OPTION BID ITEM)
STA 14+75 TO 21+00 SOLID LT
STA 14+75 TO 17+56 SOLID RT
STA 17+50 TO 17+56 SOLID RT (TH 38)
STA 17+58 TO 19+01 SOLID RT (TH 38)
STA 19+01 TO 21+00 SOLID RT

TEMPORARY 4 INCH YELLOW LINE, PAINT
DURABLE 4 INCH YELLOW LINE (OPTION BID ITEM)
STA 14+75 TO 17+93 SOLID LT & RT
STA 17+54 TO 18+13 DOUBLE SOLID RT (TH 38)
STA 18+33 TO 21+00 SOLID LT & RT

~~TEMPORARY 24 INCH STOP BAR, PAINT~~
~~DURABLE 24 INCH STOP BAR (OPTION BID ITEM)~~
~~STA 18+14 TO 18+17 RT~~

~~TEMPORARY LETTER OR SYMBOL, PAINT~~
~~DURABLE LETTER OR SYMBOL (OPTION BID ITEM)~~
~~STA 18+08 RT - "STOP"~~

REMOVING SIGNS
AS SHOWN - 1

ITEMS NOT USED.

N
VT STATE PLANE GRID

16+86 LT
BRIDGE 3 VT108 R
R

16+86 LT
BRIDGE 3 VT-108 N
N

PROPOSED 12" WATER
BY OTHERS

17+36 LT
SPEED LIMIT 30 RET
RET

WEST BRANCH OF LITTLE RIVER
FLOW

END APPROACH
STA 21+00.00

VT 108 STA 20+36.73 =
DETOUR STA 108+80.00

END PROJECT
STA 20+00.00

MATCH LINE 14+75

LIMIT OF WORK
STA 40+45.00

MEADOW LANE
(TH 38)

BIKE PATH

GRAVEL ROAD

GRAVEL DRIVE

GABLES INN

WOOD FENCE

SHRUB

STONE HEADWALL

4" PVC STAND PIPE

19+13 RT
RET
RET

18+24 RT
STOP RET B-B 0108 0808 0143 RET
RET

A
17+16 RT
LEGAL LOAD LIMIT 24,000 POUNDS RET
RET

B
17+61 RT
Meadow Ln RET
RET

THESE SIGNS WERE RELOCATED FOR THE TEMPORARY DETOUR AND THEN PUT IN THEIR FINAL POSITION.

SCALE 1" = 20'-0"
20 0 20

CONSULTING ENGINEERS

| | |
|---|---|
| PROJECT NAME: STOWE | |
| PROJECT NUMBER: BRF 0235(15) | |
| FILE NAME: z88cl90bdrts.dgn | PLOT DATE: 5/8/2015 |
| PROJECT LEADER: J. BYATT | DRAWN BY: S. GOODWIN |
| DESIGNED BY: K. RUTTER | CHECKED BY: C. GREGORY |
| TRAFFIC SIGN & LINE LAYOUT SHEET 2 | SHEET 27 OF 79 |

CLD 12-0120 MODEL: 02

**STATE OF VERMONT**
**AGENCY OF TRANSPORTATION**

# TRAFFIC SIGN SUMMARY SHEET

SHSM = FHWA 2004 STANDARD HIGHWAY SIGNS AND MARKINGS BOOK AND THE 2012 SUPPLEMENT TO THE 2004 EDITION

| MILEMARKER, STATION, OR SIGN NUMBER | SIGN LEGEND | SIGN DIMENSIONS | | | NEW & SALVAGED SIGNS | | | | EXIST POST | | NEW SIGN POSTS | | | | | | | | | | | | | | | | | REMARKS | SIGN DETAIL | | |
|---|---|---|---|---|---|---|---|---|---|---|---|---|---|---|---|---|---|---|---|---|---|---|---|---|---|---|---|---|---|---|---|
| | | EA | WIDTH (in) | HEIGHT (in) | "A" | "B" | SALV SIGN | SALV TIS | RETAIN | SALVAGE | NO. OF POSTS | SQUARE STEEL (in) | | | | TUBULAR ALUMINUM Ø (in) | | | TUBULAR STEEL Ø (in) | | | | | W-SHAPE STEEL | | | | SIGN REQUIRED | | SHSM | DETAIL ON SHEET NUMBER | STD. SHEET NUMBER |
| | | | | | | | | | | | | 1.75 | 2.0 | 2.5 | ANCHOR | SLEEVE | 3.0 | 4.0 | 4.0 MOD | FOUND-ATION | 3.0 | 3.5 | 4.0 | 5.0 | FTG. SIZE 24" | FTG. SIZE 30" | WEIGHT | POST SIZE | | | | | |
| | | | | | | | | | | | | lb/ft | | | | | lb/ft | | | | lb/ft | | | | | | | | | | | |
| | | | | | | | | | | | | 1.88 | 2.42 | 3.35 | | | 1.3 | 1.7 | 1.7 | | 7.6 | 9.0 | 10.8 | 14.6 | | | | | | | | |
| STOWE VT 108 | | | | | | | | | | | | | | | | | | | | | | | | | | | | | | | | |
| 12+04 LT | TIC | | | | | | | 1 | | | 2 | | X | | X | | | | | | | | | | | | | | | | | |
| 14+70 RT | BRIDGE 3 VT108 | 1 | 6 | 10 | 0.42 | | | | | | 1 | X | | | X | | | | | | | | | | | | | VD-701 | | | T-42 |
| 16+86 LT | BRIDGE 3 VT108 | 1 | 6 | 10 | 0.42 | | | | | | 1 | X | | | X | | | | | | | | | | | | | VD-701 | | | T-42 |
| | SUBTOTALS | | | | 0.84 | | | 1 | | | | 20 | 30 | | | | | | | | | | | | | | | | | | | |
| | ROUNDING | | | | 0.16 | | | | | | | 0 | 0 | | | | | | | | | | | | | | | | | | | |
| | | | | | | | | | | | | FT 20 | FT 30 | FT | | EA | LB | LB | LB | | LB | LB | LB | LB | | | | | | | | |
| | PROJECT TOTALS | SF 1 | | | SF | | EA. | EA. 1 | | | | FT 50 | | | | | LB | | | EA. | LB | | | | EA. | EA. | LB | | | | | |

FINAL POST LENGTHS ARE TO BE DETERMINED IN THE FIELD. POST SIZES ARE COMPUTED BASED ON INFORMATION FURNISHED ON THE STANDARD SHEETS AND VTRANS "SIGN POST DESIGN GUIDELINE."

CLD 12-0120

CONSULTING ENGINEERS


PROJECT NAME: STOWE
PROJECT NUMBER: BRF 0235(15)

FILE NAME: z88c190tsdet.dgn
PROJECT LEADER: J. BYATT
DESIGNED BY: K. RUTTER
TRAFFIC SIGN SUMMARY SHEET

PLOT DATE: 5/8/2015
DRAWN BY: S. GOODWIN
CHECKED BY: C. GREGORY
SHEET 28 OF 79

## ITEM 656.80 - LANDSCAPE BACKFILL TRUCK MEASUREMENT

| BED | LENGTH | WIDTH | DEPTH |
|---|---|---|---|
| A | 40' | 8' | 3' |
| B | 20' | 10' | 3' |
| C | 30' | 25' | 3' |
| D | 40' | 10' | 3' |
| E | 50' | 9' | 2' |

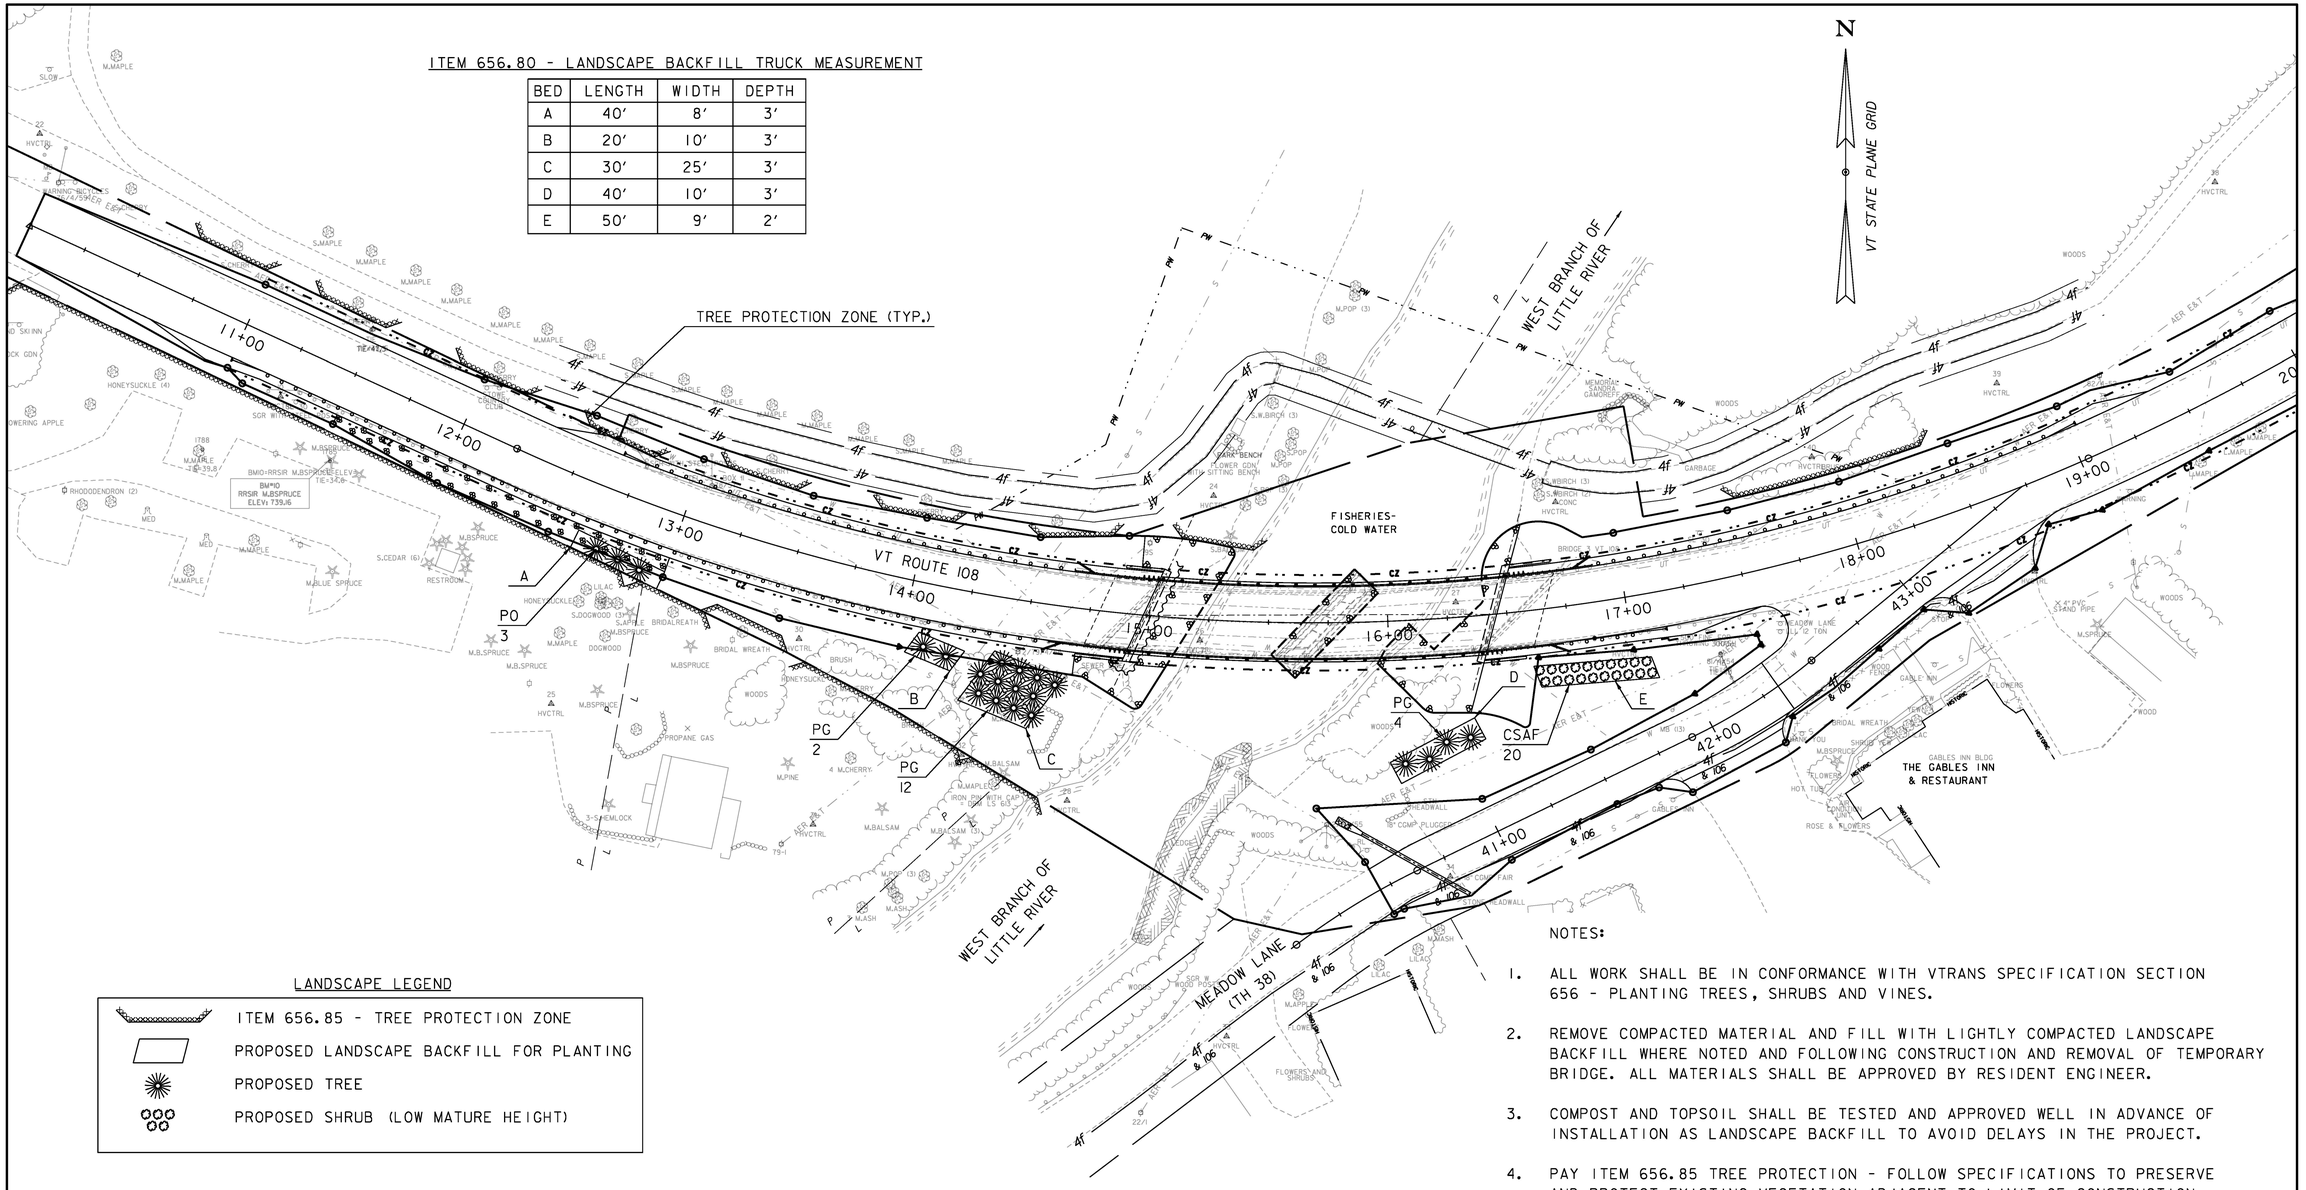


### LANDSCAPE LEGEND

- ITEM 656.85 - TREE PROTECTION ZONE
- PROPOSED LANDSCAPE BACKFILL FOR PLANTING
- PROPOSED TREE
- PROPOSED SHRUB (LOW MATURE HEIGHT)

### PLANT LIST

| QUANTITY | KEY | BOTANICAL NAME | COMMON NAME | SIZE | CONTAINER | SPACING, REMARKS, ITEMS |
|---|---|---|---|---|---|---|
| | | **EVERGREEN TREES** | | | | **ITEM NO. 656.20** |
| 18 | PG | PICES GLAUCA | WHITE SPRUCE | 3' HEIGHT | B&B | 8' ON CENTER AS SHOWN ON PLAN |
| 3 | PO | PICEA OMORIKA | SIBERIAN SPRUCE | 3' HEIGHT | B&B | 10' ON CENTER AS SHOWN ON PLAN |
| | | **DECIDUOUS TREES** | | | | **ITEM NO. 656.35** |
| 20 | CSAF | CORNUS SERICEA ARCTIC FIRE | ARCTIC FIRE RED DOGWOOD | 2 GALLON | CONTAINER | 5' ON CENTER |

NOTES:

1. ALL WORK SHALL BE IN CONFORMANCE WITH VTRANS SPECIFICATION SECTION 656 - PLANTING TREES, SHRUBS AND VINES.
2. REMOVE COMPACTED MATERIAL AND FILL WITH LIGHTLY COMPACTED LANDSCAPE BACKFILL WHERE NOTED AND FOLLOWING CONSTRUCTION AND REMOVAL OF TEMPORARY BRIDGE. ALL MATERIALS SHALL BE APPROVED BY RESIDENT ENGINEER.
3. COMPOST AND TOPSOIL SHALL BE TESTED AND APPROVED WELL IN ADVANCE OF INSTALLATION AS LANDSCAPE BACKFILL TO AVOID DELAYS IN THE PROJECT.
4. PAY ITEM 656.85 TREE PROTECTION - FOLLOW SPECIFICATIONS TO PRESERVE AND PROTECT EXISTING VEGETATION ADJACENT TO LIMIT OF CONSTRUCTION.
5. ALL PLANTS SHALL BE INSTALLED PER VTRANS SPECIFICATION SUBSECTION 656.08, AND WATERED AT TIME OF INSTALLATION AND DURING WARRANTY PERIOD AS PER SUBSECTION 656.08(F). FOLLOW VTRANS SPECIFICATION FOR QUANTITIES AND WATERING LOG.
6. THE TREE PROTECTION ZONE FROM STA. 10+00 TO STA. 12+90, RIGHT HAS BEEN PROVIDED AT THE REQUEST OF THE ADJACENT PROPERTY OWNER FOR SAFETY PURPOSES.

SCALE 1" = 30'-0"
30 0 30


CONSULTING ENGINEERS

PROJECT NAME: STOWE
PROJECT NUMBER: BRF 0235(15)

FILE NAME: z88cl90bdrlds.dgn
PROJECT LEADER: J. BYATT
DESIGNED BY: K. RUTTER
LANDSCAPE LAYOUT SHEET


PLOT DATE: 5/8/2015
DRAWN BY: M. SMITH
CHECKED BY: C. GREGORY
SHEET 29 OF 79

CLD 12-0120 MODEL: 01

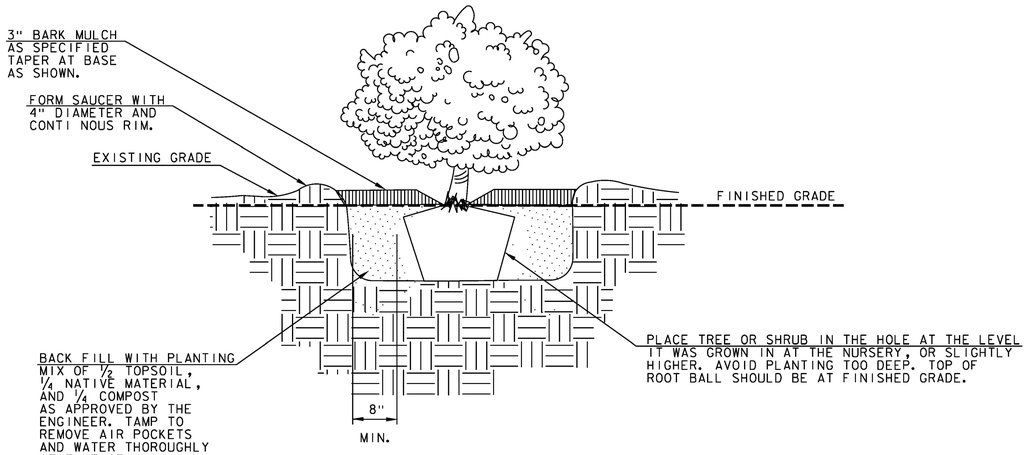


SHRUB PLANTING DETAIL


NOT TO SCALE

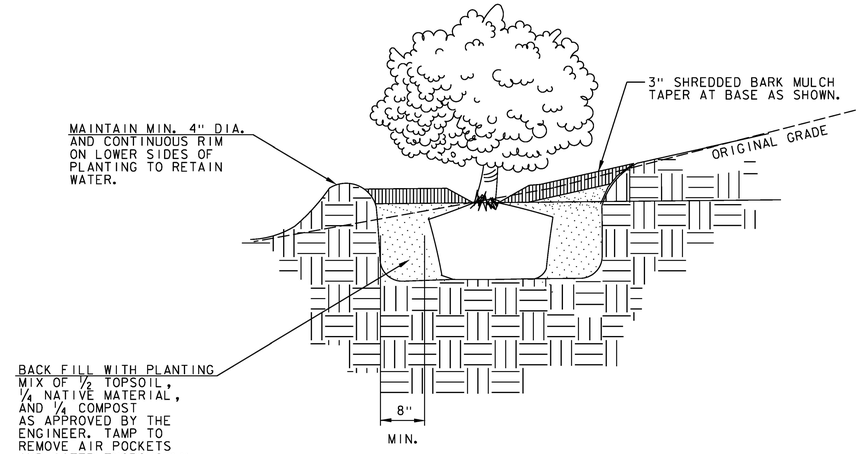


SHRUB PLANTING ON SLOPES DETAIL

GENERAL LANDSCAPE NOTES:

1. SHRUBS TO RECEIVE A MINIMUM OF 5 GALLONS AT EACH WATERING, TWICE WEEKLY DURING ESTABLISHMENT PERIOD.

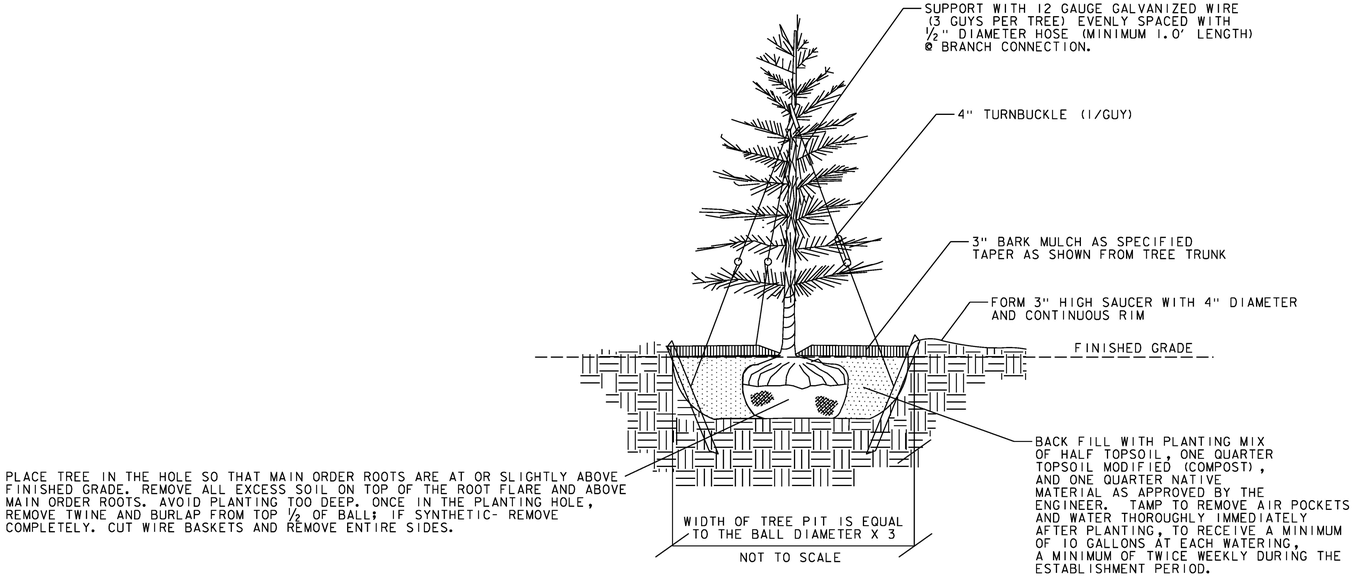


NOT TO SCALE

EVERGREEN TREE PLANTING DETAIL

NOTES:

1. ANTI-DESICCANT SPRAY IS TO BE APPLIED TO ALL EVERGREENS PER MANUFACTURER'S SPECIFICATIONS.
2. COMPLETELY REMOVE ALL GUY WIRES AND TURNBUCKLE ONE YEAR AFTER PLANTING.

GENERAL LANDSCAPE NOTES:

1. PER ITEM 651.18, FERTILIZER, MYCORRHIZAL FUNGI SHALL BE APPLIED PER MANUFACTURER'S RECOMMENDATIONS. REFER TO SUBSECTION 651.05 IN THE SPECIFICATIONS FOR THE APPLICATION OF COMPOST.
2. ORGANIC MATERIAL: TOPSOIL, COMPOST AND NATIVE EXISTING SOIL SHALL BE TESTED AT AN APPROVED LAB PRIOR TO DELIVERY ON SITE AND INSTALLATION. ORGANIC MATTER SHALL BE MINIMUM OF 5%.
3. TOPSOIL BACK FILL MIX: BACK FILL WITH PLANTING MIX OF ONE-HALF SCREENED TOPSOIL, ONE-QUARTER TOPSOIL MODIFIED (COMPOST),AND ONE QUARTER NATIVE MATERIAL AS APPROVED BY THE ENGINEER. TAMP TO REMOVE AIR POCKETS AND WATER THOROUGHLY IMMEDIATELY AFTER PLANTING, TO RECEIVE A MINIMUM OF 10 GALLONS AT EACH WATERING, TWICE WEEKLY DURING THE ESTABLISHMENT PERIOD. UNSUITABLE NATIVE MATERIAL SHALL BE REPLACED WITH IMPORTED APPROVED TOPSOIL AS DIRECTED BY THE ENGINEER.

CLD 12-0120 MODEL: 01

NOT TO SCALE

| | |
|---|---|
| PROJECT NAME: STOWE | |
| PROJECT NUMBER: BRF 0235(15) | |
| FILE NAME: z88cl90ldsdet.dgn | PLOT DATE: 6/1/2015 |
| PROJECT LEADER: J. BYATT | DRAWN BY: M. SMITH |
| DESIGNED BY: K. RUTTER | CHECKED BY: C. GREGORY |
| LANDSCAPE DETAILS | SHEET 30 OF 79 |

## SOIL CLASSIFICATION

| AASHTO | |
|---|---|
| A1 | Gravel and Sand |
| A3 | Fine Sand |
| A2 | Silty or Clayey Gravel and Sand |
| A4 | Silty Soil - Low Compressibility |
| A5 | Silty Soil - Highly Compressible |
| A6 | Clayey Soil - Low Compressibility |
| A7 | Clayey Soil - Highly Compressible |

## ROCK QUALITY DESIGNATION

| R.Q.D. (%) | ROCK DESCRIPTION |
|---|---|
| <25 | Very Poor |
| 25 to 50 | Poor |
| 51 to 75 | Fair |
| 76 to 90 | Good |
| >90 | Excellent |

## SHEAR STRENGTH

| UNDRAINED SHEAR STRENGTH IN P.S.F. | CONSISTENCY |
|---|---|
| <250 | Very Soft |
| 250-500 | Soft |
| 500-1000 | Med. Stiff |
| 1000-2000 | Stiff |
| 2000-4000 | Very Stiff |
| >4000 | Hard |


## CORRELATION GUIDE OF "N" TO DENSITY/CONSISTENCY

| DENSITY (GRANULAR SOILS) | | CONSISTENCY (COHESIVE SOILS) | |
|---|---|---|---|
| N | DESCRIPTIVE TERM | N | DESCRIPTIVE TERM |
| <5 | Very Loose | <2 | Very Soft |
| 5-10 | Loose | 2-4 | Soft |
| 11-24 | Med. Dense | 5-8 | Med. Stiff |
| 25-50 | Dense | 9-15 | Stiff |
| >50 | Very Dense | 16-30 | Very Stiff |
| | | 31-60 | Hard |
| | | >60 | Very Hard |

## COMMONLY USED SYMBOLS

| | |
|---|---|
| ▼ | Water Elevation |
| ⊗ | Standard Penetration Boring |
| ⊕ | Auger Boring |
| ⊙ | Rod Sounding |
| S | Sample |
| N | Standard Penetration Test Blow Count Per Foot For: 2" O.D. Sampler 1 3/8" I.D. Sampler Hammer Weight Of 140 Lbs. Hammer Fall Of 30" |
| VS | Field Vane Shear Test |
| US | Undisturbed Soil Sample |
| B | Blast |
| DC | Diamond Core |
| MD | Mud Drill |
| WA | Wash Ahead |
| HSA | Hollow Stem Auger |
| AX | Core Size 1 1/8" |
| BX | Core Size 1 5/8" |
| NX | Core Size 2 1/8" |
| M | Double Tube Core Barrel Used |
| LL | Liquid Limit |
| PL | Plastic Limit |
| PI | Plasticity Index |
| NP | Non Plastic |
| w | Moisture Content (Dry Wgt. Basis) |
| D | Dry |
| M | Moist |
| MTW | Moist To Wet |
| W | Wet |
| Sat | Saturated |
| Bo | Boulder |
| Gr | Gravel |
| Sa | Sand |
| Si | Silt |
| Cl | Clay |
| HP | Hardpan |
| Le | Ledge |
| NLTD | No Ledge To Depth |
| CNPF | Can Not Penetrate Further |
| TLOB | To Ledge Or Boulder |
| NR | No Recovery |
| Rec. | Recovery |
| %Rec. | Percent Recovery |
| RQD | Rock Quality Designation |
| CBR | California Bearing Ratio |
| < | Less Than |
| > | Greater Than |
| R | Refusal (N > 100) |

| COLOR | | | |
|---|---|---|---|
| blk | Black | pnk | Pink |
| bl | Blue | pu | Purple |
| brn | Brown | rd | Red |
| dk | Dark | tn | Tan |
| gry | Gray | wh | White |
| gn | Green | yel | Yellow |
| lt | Light | mltc | Multicolored |
| or | Orange | | |

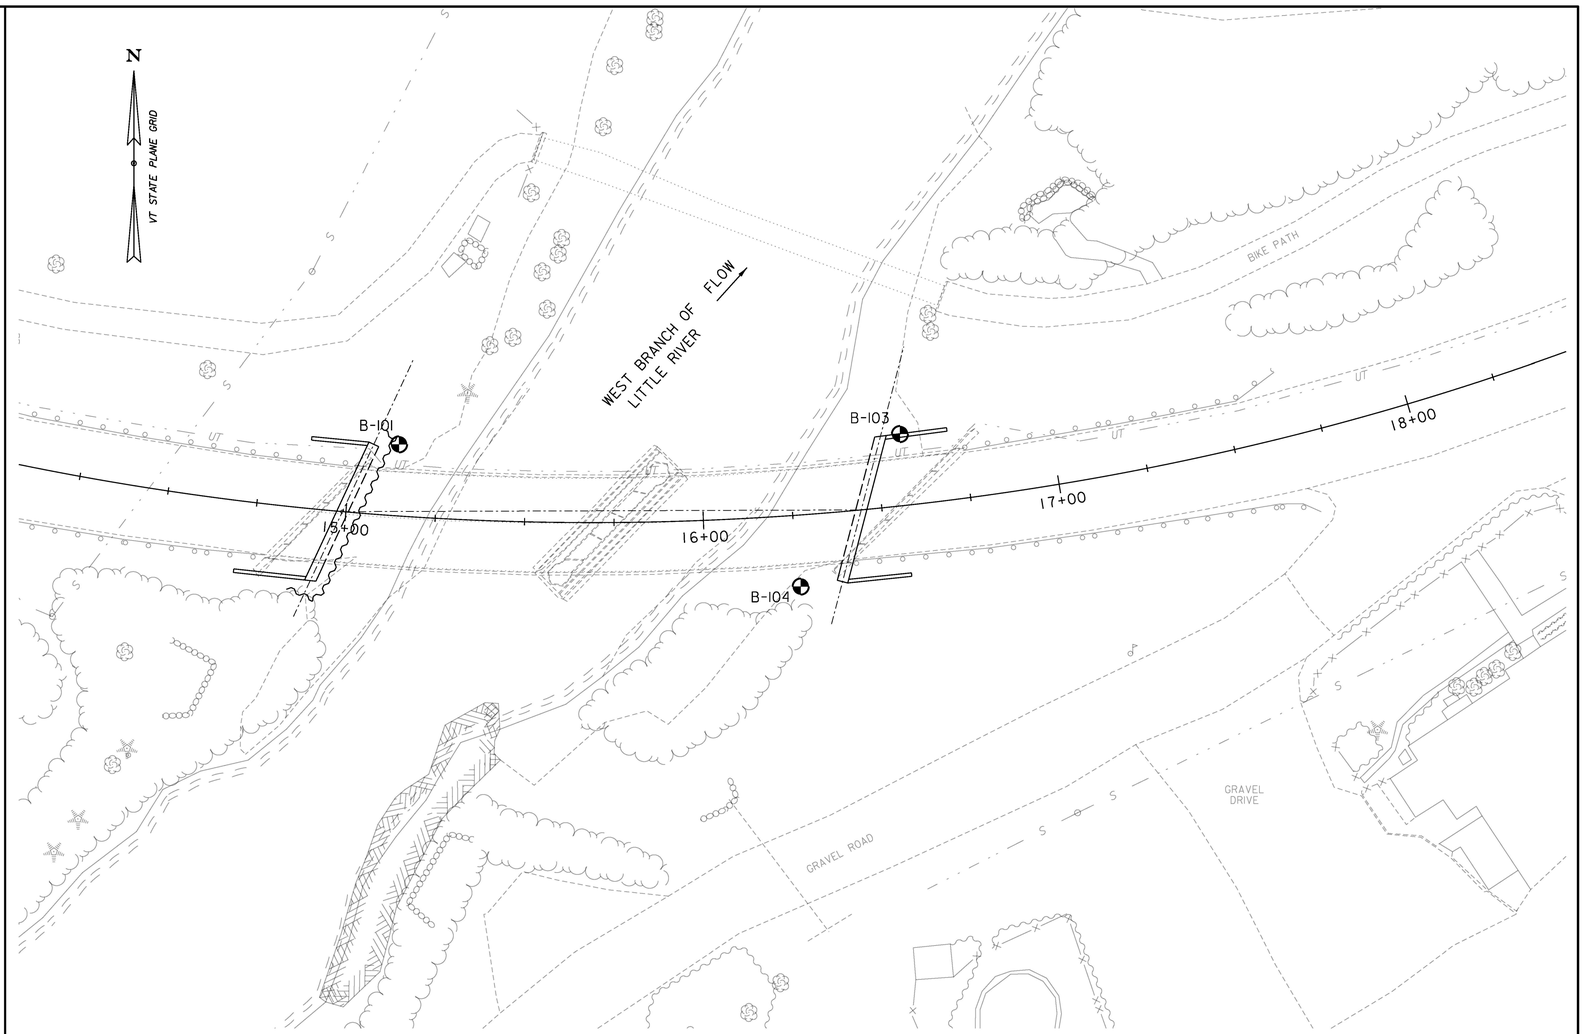


## BORING PLAN

SCALE 1" = 20'-0"

20 0 10

SCALE IN FEET

## BORING CHART

| HOLE NO. | SURV. STATION | OFFSET | GROUND ELEV. | ELEV. TLOB |
|---|---|---|---|---|
| B-101 | 15+13.5 | -20 | 740.0 | 670.5 |
| B-103 | 16+57.3 | -20 | 738.4 | 686.4 |
| B-104 | 16+26.0 | +20 | 745.4 | 706.9 |
| | | | | |
| | | | | |
| | | | | |
| | | | | |

## DEFINITIONS (AASHTO)

**BEDROCK (LEDGE)** - Rock in its native location of indefinite thickness.

**BOULDER** - A rock fragment with an average dimension > 12 inches.

**COBBLE** - Rock fragments with an average dimension between 3 and 12 inches.

**GRAVEL** - Rounded particles of rock < 3" and > 0.0787" (#10 sieve).

**SAND** - Particles of rock < 0.0787" (#10 sieve) and > 0.0029" (#200 sieve).

**SILT** - Soil < 0.0029" (#200 sieve), non or slightly plastic and exhibits no strength when air-dried.

**CLAY** - Fine grained soil, exhibits plasticity when moist and considerable strength when air-dried.

**VARVED** - Alternate layers of silt and clay.

**HARDPAN** - Extremely dense soil, cemented layer, not softened when wet.

**MUCK** - Soft organic soil (containing > 10% organic material.

**MOISTURE CONTENT** - Weight of water divided by dry weight of soil.

**FLOWING SAND** - Granular soil so saturated (loose) that it flows into drill casing during extraction of wash rod.

**STRIKE** - Angle from magnetic north to line of intersection of bed with a horizontal plane.

**DIP** - Inclination of bed with a horizontal plane.

## GENERAL NOTES

1. The subsurface explorations shown herein were made between 8/21/13 and 8/27/13 by the Agency.
2. Soil and rock classifications, properties and descriptions are based on engineering interpretation from available subsurface information by the Agency and may not necessarily reflect actual variations in subsurface conditions that may be encountered between individual boring or sample locations.
3. Observed water levels and/or conditions indicated are as recorded at the time of exploration and may vary according to the prevailing rainfall, methods of exploration and other factors.
4. Engineering judgement was exercised in preparing the subsurface information presented herein. Analysis and interpretation of subsurface data was performed and interpreted for Agency design and estimating purposes. Presentation of the information in the Contract is intended to provide the Contractor access to the same data available to the Agency. The subsurface information is presented in good faith and is not intended as a substitute for personal investigation, independent interpretation, independent analysis or judgement by the Contractor.
5. Pictorial structure details shown on the boring plan layout or soils profile are for illustrative purposes only and may not accurately portray final contract details.
6. Terminology used on boring logs to describe the hardness, degree of weathering, and spacing of fractures, joints and other discontinuities in the bedrock is defined in the AASHTO Manual on Subsurface Investigations, 1988.

CONSULTING ENGINEERS

PROJECT NAME: STOWE

PROJECT NUMBER: BRF 0235(15)

FILE NAME: z88cl90bor.dgn
PROJECT LEADER: J. BYATT
DESIGNED BY: J. FRENCH
BORING INFORMATION SHEET

PLOT DATE: 5/8/2015
DRAWN BY: M. SMITH
CHECKED BY: J. BYATT
SHEET 31 OF 79

CLD 12-020 MODEL: BORO

STATE OF VERMONT
AGENCY OF TRANSPORTATION
MATERIALS & RESEARCH SECTION
SUBSURFACE INFORMATION

# BORING LOG

**STOWE**
**BHF 0235(15)**
**VT-108 BR-3**

Boring No.: **B-101**
Page No.: 1 of 2
Pin No.: 88C190
Checked By: MLM

Boring Crew: DAIGNEAULT, JUDKINS
Date Started: 8/23/13 Date Finished: 8/26/13
VTSPG NAD83: N 719003.02 ft E 1586383.77 ft
Station: 15+13.5 Offset: -20.00
Ground Elevation: 740.0 ft

| | Casing | Sampler |
|---|---|---|
| Type: | WB | SS |
| I.D.: | 4 in | 1.5 in |
| Hammer Wt: | N.A. | 140 lb. |
| Hammer Fall: | N.A. | 30 in. |
| Hammer/Rod Type: | Auto/AW-J | |
| Rig: | CME 55 TRACK | $C_E$ = 1.46 |

Groundwater Observations

| Date | Depth (ft) | Notes |
|---|---|---|
| 08/26/13 | 12.4 | While drilling. |

| Depth (ft) | Strata (1) | CLASSIFICATION OF MATERIALS (Description) | Run (Dip deg.) | Core Rec. % (RQD %) | Drill Rate minutes/ft | Blows/6" (N Value) | Moisture Content % | Gravel % | Sand % | Fines % |
|---|---|---|---|---|---|---|---|---|---|---|
| | | Visual Description:, SiGrSa, Dk/brn, Moist, Rec. = 0.3 ft, Insufficient sample for testing. | | | | 1-1-3-5 (4) | 13.2 | | | |
| | | Visual Description:, SaGr, Dk/brn, Moist, Rec. = 0.2 ft, Insufficient sample for testing. | | | | 6-8-6-2 (14) | 9.2 | | | |
| 5 | | A-1-b, SaGr, brn, Moist, Rec. = 0.7 ft | | | | 6-9-10-10 (19) | 8.3 | 52.8 | 28.1 | 19.1 |
| | | A-1-b, SaGr, brn, Moist, Rec. = 0.7 ft | | | | 6-7-10-13 (17) | 9.8 | 46.1 | 40.9 | 13.0 |
| | | A-1-b, SiSaGr, brn, Moist, Rec. = 0.7 ft | | | | 10-16-14-16 (30) | 9.4 | 40.2 | 36.0 | 23.8 |
| 10 | | A-1-b, SaGr, brn, Moist, Rec. = 0.5 ft, Broken Rock was within sample. | | | | 8-7-7-9 (14) | 9.7 | 49.1 | 33.3 | 17.6 |
| | | A-2-4, SiSaGr, brn, MTW, Rec. = 0.6 ft | | | | 6-10-6-5 (16) | 14.1 | 38.9 | 34.2 | 26.9 |
| 15 | | A-4, Si, gry, Wet, Rec. = 0.8 ft | | | | 3-4-3-4 (7) | 26.6 | 0.4 | 13.3 | 86.3 |
| | | A-4, Si, gry, Wet, Rec. = 0.7 ft | | | | 1-3-3-4 (6) | 27.0 | 3.6 | 8.1 | 88.3 |
| | | A-4, Si, gry, Wet, Rec. = 1.4 ft | | | | 2-2-2-3 (4) | 30.8 | | 3.4 | 96.6 |
| 20 | | | | | | | | | | |
| 25 | | A-4, Si, gry, Wet, Rec. = 1.2 ft | | | | 5-2-3-3 (5) | 27.6 | 6.9 | 4.4 | 88.7 |
| 30 | | A-4, Si, gry, Wet, Rec. = 1.0 ft | | | | 2-4-3-2 (7) | 28.6 | | 11.2 | 88.8 |
| 35 | | A-4, Si, gry, Wet, Rec. = 0.9 ft | | | | 2-3-3-4 (6) | 25.3 | 1.6 | 16.2 | 82.2 |
| 40 | | A-4, Si, gry, Wet, Rec. = 1.2 ft | | | | 1-3-3-3 (6) | 27.5 | 0.6 | 6.0 | 93.4 |

Notes:
1. Stratification lines represent approximate boundary between material types. Transition may be gradual.
2. N Values have not been corrected for hammer energy. $C_E$ is the hammer energy correction factor.
3. Water level readings have been made at times and under conditions stated. Fluctuations may occur due to other factors than those present at the time measurements were made.

BOTTOM OF ABUT. I
EL. 733.0'

ESTIMATED PILE TIP
EL. 670.5'

STATE OF VERMONT
AGENCY OF TRANSPORTATION
MATERIALS & RESEARCH SECTION
SUBSURFACE INFORMATION

BORING LOG

STOWE
BHF 0235(15)
VT-108 BR-3

Boring No.: **B-101**
Page No.: 2 of 2
Pin No.: 88C190
Checked By: MLM

Boring Crew: DAIGNEAULT, JUDKINS
Date Started: 8/23/13 Date Finished: 8/26/13
VTSPG NAD83: N 719003.02 ft E 1586383.77 ft
Station: 15+13.5 Offset: -20.00
Ground Elevation: 740.0 ft

| | Casing | Sampler |
|---|---|---|
| Type: | WB | SS |
| I.D.: | 4 in | 1.5 in |
| Hammer Wt: | N.A. | 140 lb. |
| Hammer Fall: | N.A. | 30 in. |
| Hammer/Rod Type: | Auto/AW-J | |
| Rig: | CME 55 TRACK | $C_E$ = 1.46 |

Groundwater Observations

| Date | Depth (ft) | Notes |
|---|---|---|
| 08/26/13 | 12.4 | While drilling. |

| Depth (ft) | Strata (1) | CLASSIFICATION OF MATERIALS (Description) | Run (Dip deg.) | Core Rec. % (RQD %) | Drill Rate minutes/ft | Blows/6" (N Value) | Moisture Content % | Gravel % | Sand % | Fines % |
|---|---|---|---|---|---|---|---|---|---|---|
| | | A-4, Si, gry, MTW, Rec. = 1.2 ft | | | | 6-5-6-6 (11) | 24.7 | 5.8 | 15.8 | 78.4 |
| 50 | | A-4, SaSi, gry, MTW, Rec. = 0.8 ft | | | | 3-4-5-6 (9) | 21.6 | 9.3 | 22.5 | 68.2 |
| 55 | | Field Note:, No Recovery | | | | 18-7-7-4 (14) | | | | |
| 60 | | Field Note:, No Recovery | | | | 6-4-5-4 (9) | | | | |
| 65 | | Field Note:, No Recovery | | | | 8-6-3-3 (9) | | | | |
| 70 | | 69.5 ft - 74.5 ft, Light gray to green, Chlorite-muscovite-quartz Schist, with white quartzofeldspathic layers. Moderately hard, Unweathered, Fair rock, NXMDC, RMR = 52 | 1 (20) | 96 (28) | 8 6 6 5 6 | Top of Bedrock @ 69.5 ft | | | | |
| 75 | | 74.5 ft - 79.5 ft, Light gray to green, Chlorite-muscovite-quartz Schist, with white quartzofeldspathic layers. Moderately hard, Unweathered, Fair rock, NXMDC, RMR = 57 | 2 (30) | 88 (60) | 5 6 6 7 8 | | | | | |
| 80 | | Hole stopped @ 79.5 ft | | | | | | | | |
| 85 | | Remarks:<br>1. Hole collasped at 11.2 ft. | | | | | | | | |

Notes:
1. Stratification lines represent approximate boundary between material types. Transition may be gradual.
2. N Values have not been corrected for hammer energy. $C_E$ is the hammer energy correction factor.
3. Water level readings have been made at times and under conditions stated. Fluctuations may occur due to other factors than those present at the time measurements were made.

BORING LOG 2 STOWE BHF 0235(15).GPJ VERMONT AOT.GDT 8/30/13

CLD 12-0120 $FILEABBREV$ MODEL: BOR02

CONSULTING ENGINEERS

PROJECT NAME: STOWE
PROJECT NUMBER: BRF 0235(15)

FILE NAME: z88c190bor.dgn
PROJECT LEADER: J. BYATT
DESIGNED BY: J. FRENCH
BORING LOGS (1 OF 2)

PLOT DATE: 5/8/2015
DRAWN BY: M. SMITH
CHECKED BY: J. BYATT
SHEET 32 OF 79

STATE OF VERMONT
AGENCY OF TRANSPORTATION
MATERIALS & RESEARCH SECTION
SUBSURFACE INFORMATION

# BORING LOG

**STOWE**
**BHF 0235(15)**
**VT-108 BR-3**

Boring No.: **B-103**
Page No.: 1 of 2
Pin No.: 88C190
Checked By: MLM

Boring Crew: DAIGNEAULT, JUDKINS
Date Started: 8/27/13 Date Finished: 8/27/13
VTSPG NAD83: N 719001.30 ft E 1586524.99 ft
Station: 16+57.3 Offset: -20.00
Ground Elevation: 738.4 ft

| | Casing | Sampler |
|---|---|---|
| Type: | WB | SS |
| I.D.: | 4 in | 1.5 in |
| Hammer Wt: | N.A. | 140 lb. |
| Hammer Fall: | N.A. | 30 in. |
| Hammer/Rod Type: | Auto/AWJ | |
| Rig: | CME 55 TRACK | $C_e$ = 1.46 |

Groundwater Observations

| Date | Depth (ft) | Notes |
|---|---|---|
| 08/27/13 | 11.4 | After drilling. |

| Depth (ft) | Strata (1) | CLASSIFICATION OF MATERIALS (Description) | Run (Dip deg.) | Core Rec. % (RQD %) | Drill Rate minutes/ft | Blows/6" (N Value) | Moisture Content % | Gravel % | Sand % | Fines % |
|---|---|---|---|---|---|---|---|---|---|---|
| | | A-1-b, GrSa, Dk/brn, Moist, Rec. = 0.5 ft, Broken Rock was within sample. | | | | 1-1-1-8 (2) | 6.3 | 42.5 | 45.4 | 12.1 |
| | | A-1-a, SaGr, Lt/brn, Moist, Rec. = 0.6 ft, Lab Note: Mostly Broken Rock | | | | 3-1-3-5 (4) | 4.5 | 65.1 | 24.6 | 10.3 |
| 5 | | A-1-b, SiSaGr, brn, Moist, Rec. = 0.4 ft, Broken Rock was within sample. | | | | 3-8-9-10 (17) | 9.9 | 50.9 | 26.8 | 22.3 |
| | | A-1-b, SaGr, brn, Moist, Rec. = 0.8 ft | | | | 8-13-16-12 (29) | 9.9 | 49.3 | 37.2 | 13.5 |
| | | A-1-b, SaGr, brn, Moist, Rec. = 0.7 ft, Broken Rock was within sample. | | | | 5-11-14-20 (25) | 8.7 | 45.8 | 38.5 | 15.7 |
| 10 | | A-2-4, SiSaGr, brn, Moist, Rec. = 0.5 ft | | | | 9-9-8-5 (17) | 10.2 | 43.0 | 29.8 | 27.2 |
| | | A-1-a, SaGr, brn, Moist, Rec. = 0.4 ft | | | | 3-5-9-5 (14) | 10.2 | 56.3 | 28.9 | 14.8 |
| 15 | | Visual Description:, SaGr, gry, Moist, Rec. = 0.1 ft, Stone caught in sampler. Insufficient sample for testing. | | | | 3-4-6-8 (10) | | | | |
| | | A-1-b, SaGr, gry, Moist, Rec. = 0.7 ft | | | | 7-7-9-9 (16) | 10.1 | 49.3 | 38.2 | 12.5 |
| | | A-1-b, GrSa, gry-rust, Moist, Rec. = 0.6 ft, Lab Note: Sample had an orange colored area with the remainder of sample being gray. | | | | 9-8-7-7 (15) | 13.9 | 33.7 | 48.7 | 17.6 |
| 20 | | | | | | | | | | |
| 25 | | A-4, Si, gry, MTW, Rec. = 1.0 ft | | | | 6-3-3-4 (6) | 31.5 | 3.9 | 3.3 | 92.8 |
| 30 | | A-4, Si, gry, MTW, Rec. = 0.8 ft | | | | 4-3-3-3 (6) | 30.3 | | 7.6 | 92.4 |
| 35 | | A-4, SaSi, gry, MTW, Rec. = 0.8 ft | | | | 5-4-3-2 (7) | 19.0 | 12.9 | 35.2 | 51.9 |
| 40 | | Field Note:, No Recovery | | | | 3-1-1-1 (2) | | | | |

BOTTOM OF ABUT. 2
EL. 732.0'

Notes:
1. Stratification lines represent approximate boundary between material types. Transition may be gradual.
2. N Values have not been corrected for hammer energy. $C_e$ is the hammer energy correction factor.
3. Water level readings have been made at times and under conditions stated. Fluctuations may occur due to other factors than those present at the time measurements were made.

BORING LOG 2 STOWE BHF 0235(15).GPJ VERMONT AOT.GDT 9/30/13


STATE OF VERMONT
AGENCY OF TRANSPORTATION
MATERIALS & RESEARCH SECTION
SUBSURFACE INFORMATION

BORING LOG

STOWE
BHF 0235(15)
VT-108 BR-3


Boring No.: **B-103**
Page No.: 2 of 2
Pin No.: 88C190
Checked By: MLM


Boring Crew: DAIGNEAULT, JUDKINS
Date Started: 8/27/13 Date Finished: 8/27/13
VTSPG NAD83: N 719001.30 ft E 1586524.99 ft
Station: 16+57.3 Offset: -20.00
Ground Elevation: 738.4 ft

| | Casing | Sampler |
|---|---|---|
| Type: | WB | SS |
| I.D.: | 4 in | 1.5 in |
| Hammer Wt: | N.A. | 140 lb. |
| Hammer Fall: | N.A. | 30 in. |
| Hammer/Rod Type: | Auto/AWJ | |
| Rig: | CME 55 TRACK | $C_e$ = 1.46 |

Groundwater Observations

| Date | Depth (ft) | Notes |
|---|---|---|
| 08/27/13 | 11.4 | After drilling. |


| Depth (ft) | Strata (1) | CLASSIFICATION OF MATERIALS (Description) | Run (Dip deg.) | Core Rec. % (RQD %) | Drill Rate minutes/ft | Blows/6" (N Value) | Moisture Content % | Gravel % | Sand % | Fines % |
|---|---|---|---|---|---|---|---|---|---|---|
| | | Visual Description:, Broken Rocks, gry, Moist, Rec. = 0.1 ft, Stone caught in sampler. Insufficient sample for testing. | | | | 3-1-1-5 (2) | | | | |
| 50 | | A-1-b, SaGr, gry, Moist, Rec. = 0.7 ft, Lab Note: Broken Rock & little Weathered Rock was within sample. | | | | 19-29-R@1.0" (R) | 11.3 | 46.0 | 35.2 | 18.8 |
| | | Field Note:, NXDC | 1 | 100 | 12 | Top of Bedrock @ 52.0 ft | | | | |
| 55 | | 52.0 ft - 57.0 ft, Dark gray & black, Carbonaceous, graphitic, biotite-muscovite-quartz Phyllite, with silicic laminae. Moderately hard, Unweathered, Fair rock, NXMDC, RMR = 49 | (45) | (50) | 7<br>5<br>4<br>4 | | | | | |
| 60 | | 57.0 ft - 62.0 ft, Dark gray & black, Carbonaceous, graphitic, biotite-muscovite-quartz Phyllite, with silicic laminae. Moderately hard, Unweathered, Fair rock, NXMDC, RMR = 49 | 2 | 92 | 4 | | | | | |
| | | | (45) | (54) | 3<br>4<br>4<br>4 | | | | | |
| | | Hole stopped @ 62.0 ft | | | | | | | | |
| 65 | | | | | | | | | | |
| | | Remarks:<br>1. Hole collapsed at 7.2 ft. | | | | | | | | |
| 70 | | | | | | | | | | |
| 75 | | | | | | | | | | |
| 80 | | | | | | | | | | |
| 85 | | | | | | | | | | |

ESTIMATED PILE TIP
EL. 686.4'


Notes:
1. Stratification lines represent approximate boundary between material types. Transition may be gradual.
2. N Values have not been corrected for hammer energy. $C_e$ is the hammer energy correction factor.
3. Water level readings have been made at times and under conditions stated. Fluctuations may occur due to other factors than those present at the time measurements were made.

BORING LOG 2 STOWE BHF 0235(15).GPJ VERMONT AOT.GDT 9/30/13



STATE OF VERMONT
AGENCY OF TRANSPORTATION
MATERIALS & RESEARCH SECTION
SUBSURFACE INFORMATION

BORING LOG

STOWE
BHF 0235(15)
VT-108 BR-3


Boring No.: **B-104**
Page No.: 1 of 1
Pin No.: 88C190
Checked By: MLM


Boring Crew: DAIGNEAULT, JUDKINS
Date Started: 8/21/13 Date Finished: 8/22/13
VTSPG NAD83: N 718957.36 ft E 1586495.57 ft
Station: 16+26 Offset: 20.00
Ground Elevation: 745.5 ft

| | Casing | Sampler |
|---|---|---|
| Type: | WB | SS |
| I.D.: | 4 in | 1.5 in |
| Hammer Wt: | N.A. | 140 lb. |
| Hammer Fall: | N.A. | 30 in. |
| Hammer/Rod Type: | Auto/AWJ | |
| Rig: | CME 55 TRACK | $C_e$ = 1.46 |

Groundwater Observations

| Date | Depth (ft) | Notes |
|---|---|---|
| 08/22/13 | 19.5 | While drilling. |


| Depth (ft) | Strata (1) | CLASSIFICATION OF MATERIALS (Description) | Run (Dip deg.) | Core Rec. % (RQD %) | Drill Rate minutes/ft | Blows/6" (N Value) | Moisture Content % | Gravel % | Sand % | Fines % |
|---|---|---|---|---|---|---|---|---|---|---|
| | | A-2-4, SiGrSa, brn, Moist, Rec. = 0.6 ft | | | | 1-1-4-3 (5) | 4.8 | 26.1 | 49.9 | 24.0 |
| | | A-2-4, SiGrSa, brn, Moist, Rec. = 0.8 ft | | | | 3-3-4-3 (7) | 6.3 | 25.4 | 50.2 | 24.4 |
| | | Visual Description:, Lots of Broken Rock with Sand, brn, Moist, Rec. = 0.2 ft | | | | 4-6-7-5 (13) | 5.7 | | | |
| | | A-2-4, SiSaGr, brn, Moist, Rec. = 0.4 ft | | | | 6-5-5-5 (10) | 14.2 | 36.3 | 33.2 | 30.5 |
| | | A-2-4, GrSiSa, brn, Moist, Rec. = 0.7 ft, Some Broken Rock was within sample. | | | | 6-5-22-R (27) | 14.2 | 25.6 | 43.4 | 31.0 |
| 10 | | Visual Description:, Broken Rock with Silty Sand, brn-gry, Moist, Rec. = 0.2 ft | | | | 12-7-5-5 (12) | 8.9 | | | |
| | | A-1-b, SiSaGr, brn, Moist, Rec. = 0.4 ft | | | | 2-4-6-9 (10) | 9.1 | 51.7 | 26.6 | 21.7 |
| | | Field Note:, No Recovery | | | | 9-7-7-9 (14) | | | | |
| | | Visual Description:, SaGr with Broken Rock, gry, MTW, Rec. = 0.4 ft, Insufficient sample for testing. | | | | 7-7-15-15 (22) | 8.9 | | | |
| | | A-1-b, SiSaGr, brn, MTW, Rec. = 0.3 ft | | | | 8-6-7-5 (13) | 10.5 | 43.8 | 30.7 | 25.5 |
| 20 | | A-4, Si, brn, Wet, Rec. = 0.8 ft | | | | 5-2-3-3 (5) | 30.8 | 1.9 | 8.7 | 89.4 |
| | | A-4, Si, gry, Wet, Rec. = 1.2 ft | | | | 2-2-3-3 (5) | 29.6 | | 6.2 | 93.8 |
| 30 | | A-4, SaSi, gry, Wet, Rec. = 1.0 ft | | | | 4-6-5-4 (11) | 24.1 | 2.0 | 25.2 | 72.8 |
| | | Visual Description:, Broken Rock with Silty Sand, gry, MTW, Rec. = 0.4 ft | | | | 11-7-6-8 (13) | 7.0 | | | |
| 40 | | 38.5 ft - 39.5 ft, Dark gray & black, Carbonaceous, graphitic, biotite-muscovite-quartz Phyllite, with silicic laminae. Moderately hard, Unweathered, Poor rock, NXDC, Low RQD may be due to mechanical breakage along foliation planes. RMR = 39 | 1 | 80 | 3 | Top of Bedrock @ 38.5 ft | | | | |
| | | | (45) | (0) | 4 | | | | | |
| | | | 2 | 100 | 4 | | | | | |
| | | | (45) | (0) | 5 | | | | | |
| | | 39.5 ft - 44.5 ft, Dark gray & black, Carbonaceous, graphitic, biotite-muscovite-quartz Phyllite, with silicic laminae. Moderately hard, Unweathered, Poor rock, NXMDC, Low RQD may be due to mechanical breakage along foliation planes. RMR = 39 | | | 4 | | | | | |
| | | | 3 | 100 | 5 | | | | | |
| | | | (45) | (20) | 3 | | | | | |
| | | 44.5 ft - 49.5 ft, Dark gray & black, Carbonaceous, graphitic, biotite-muscovite-quartz Phyllite, with silicic laminae. Moderately hard, Unweathered, Poor rock, NXMDC, Low RQD may be due to mechanical breakage along foliation planes. RMR = 39 | | | 4 | | | | | |
| | | | | | 4 | | | | | |
| 50 | | | | | 4 | | | | | |
| | | Hole stopped @ 49.5 ft | | | | | | | | |
| | | Remarks:<br>1. Hole collapsed at 13.8 ft. | | | | | | | | |


Notes:
1. Stratification lines represent approximate boundary between material types. Transition may be gradual.
2. N Values have not been corrected for hammer energy. $C_e$ is the hammer energy correction factor.
3. Water level readings have been made at times and under conditions stated. Fluctuations may occur due to other factors than those present at the time measurements were made.

BORING LOG 2 STOWE BHF 0235(15).GPJ VERMONT AOT.GDT 9/30/13



CLD 12-020 $FILEABBREV$ MODEL: BOR03

CONSULTING ENGINEERS

PROJECT NAME: STOWE
PROJECT NUMBER: BRF 0235(15)


FILE NAME: z88c190bor.dgn
PROJECT LEADER: J. BYATT
DESIGNED BY: J. FRENCH
BORING LOGS (2 OF 2)

PLOT DATE: 5/8/2015
DRAWN BY: M. SMITH
CHECKED BY: J. BYATT
SHEET 33 OF 79

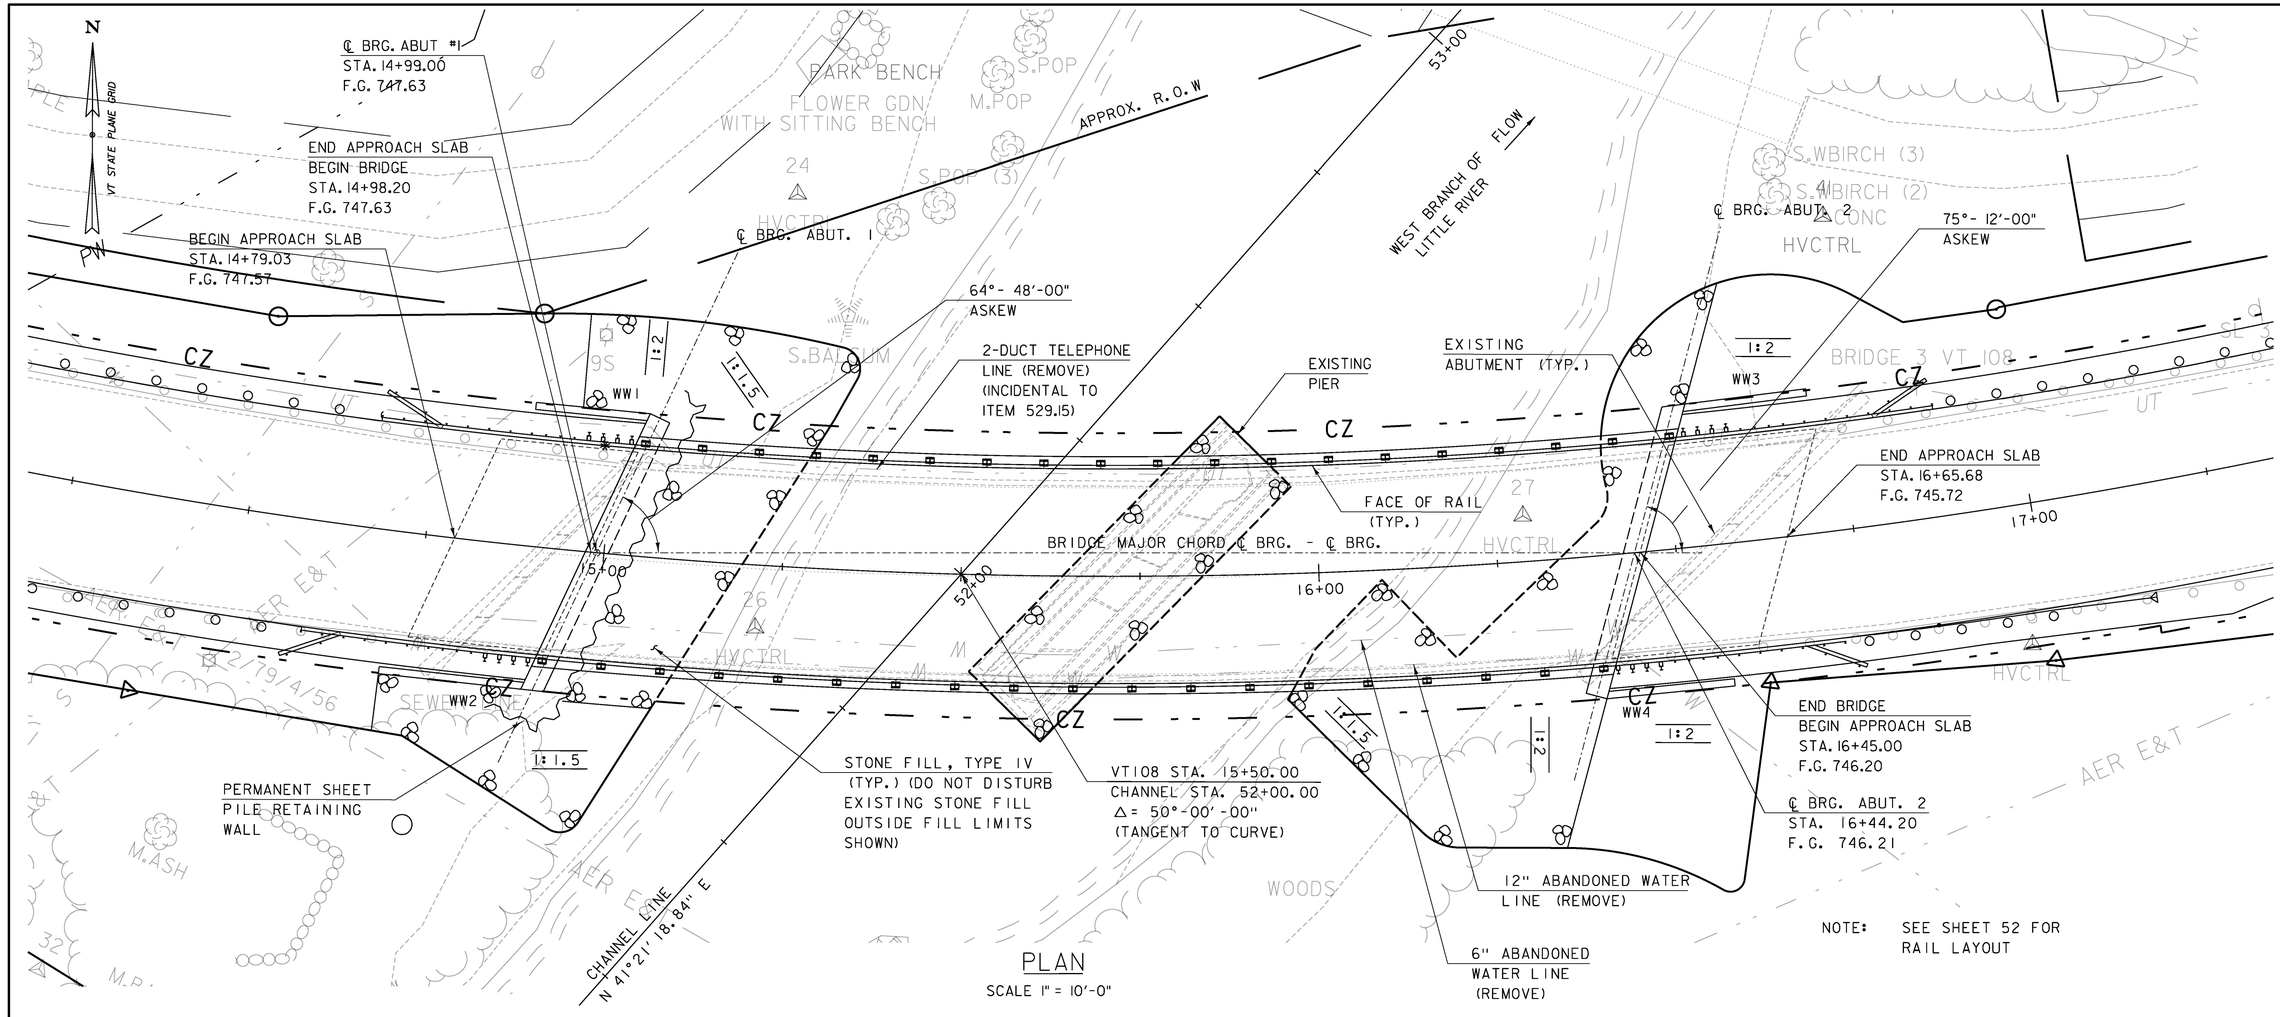


PLAN

SCALE 1" = 10'-0"

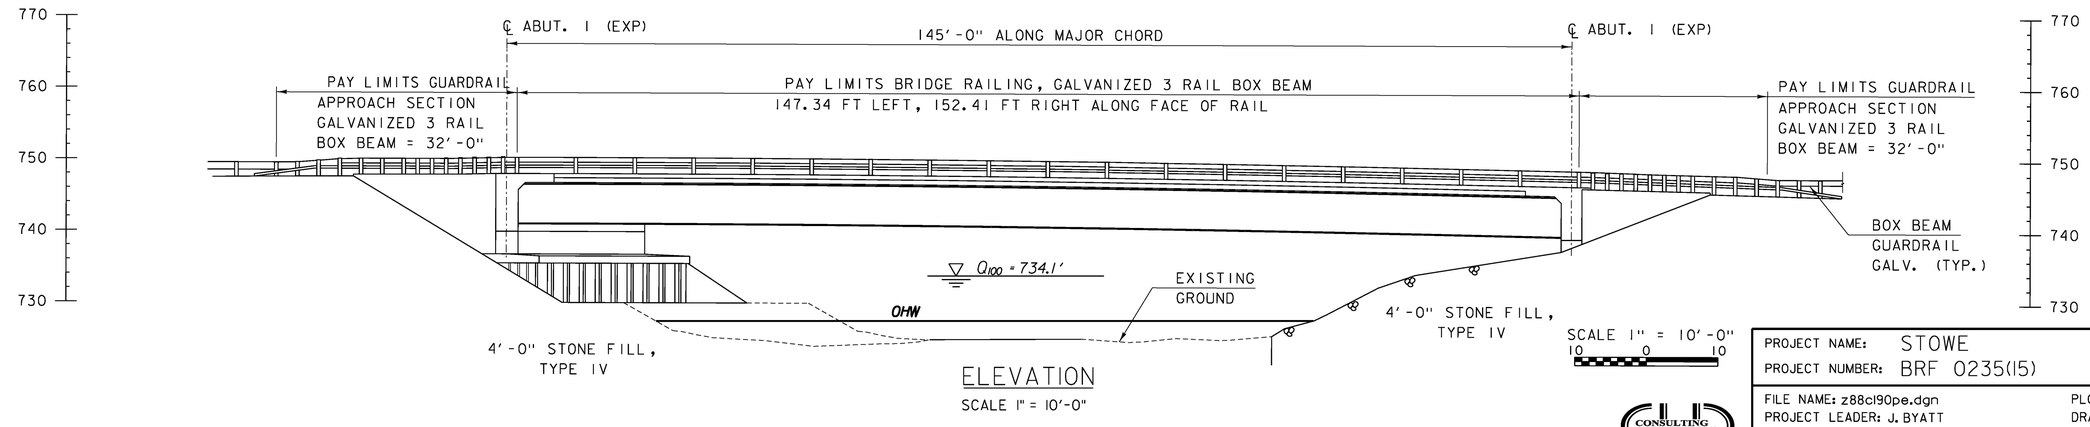


ELEVATION

SCALE 1" = 10'-0"

SCALE 1" = 10'-0"


10 0 10

CONSULTING ENGINEERS

| | |
|---|---|
| PROJECT NAME: | STOWE |
| PROJECT NUMBER: | BRF 0235(15) |

| | |
|---|---|
| FILE NAME: z88c190pe.dgn | PLOT DATE: 5/8/2015 |
| PROJECT LEADER: J. BYATT | DRAWN BY: M. SMITH |
| DESIGNED BY: J. FRENCH | CHECKED BY: J. BYATT |
| PLAN AND ELEVATION | SHEET 34 OF 79 |


CLD 12-0020 MODEL: PE01

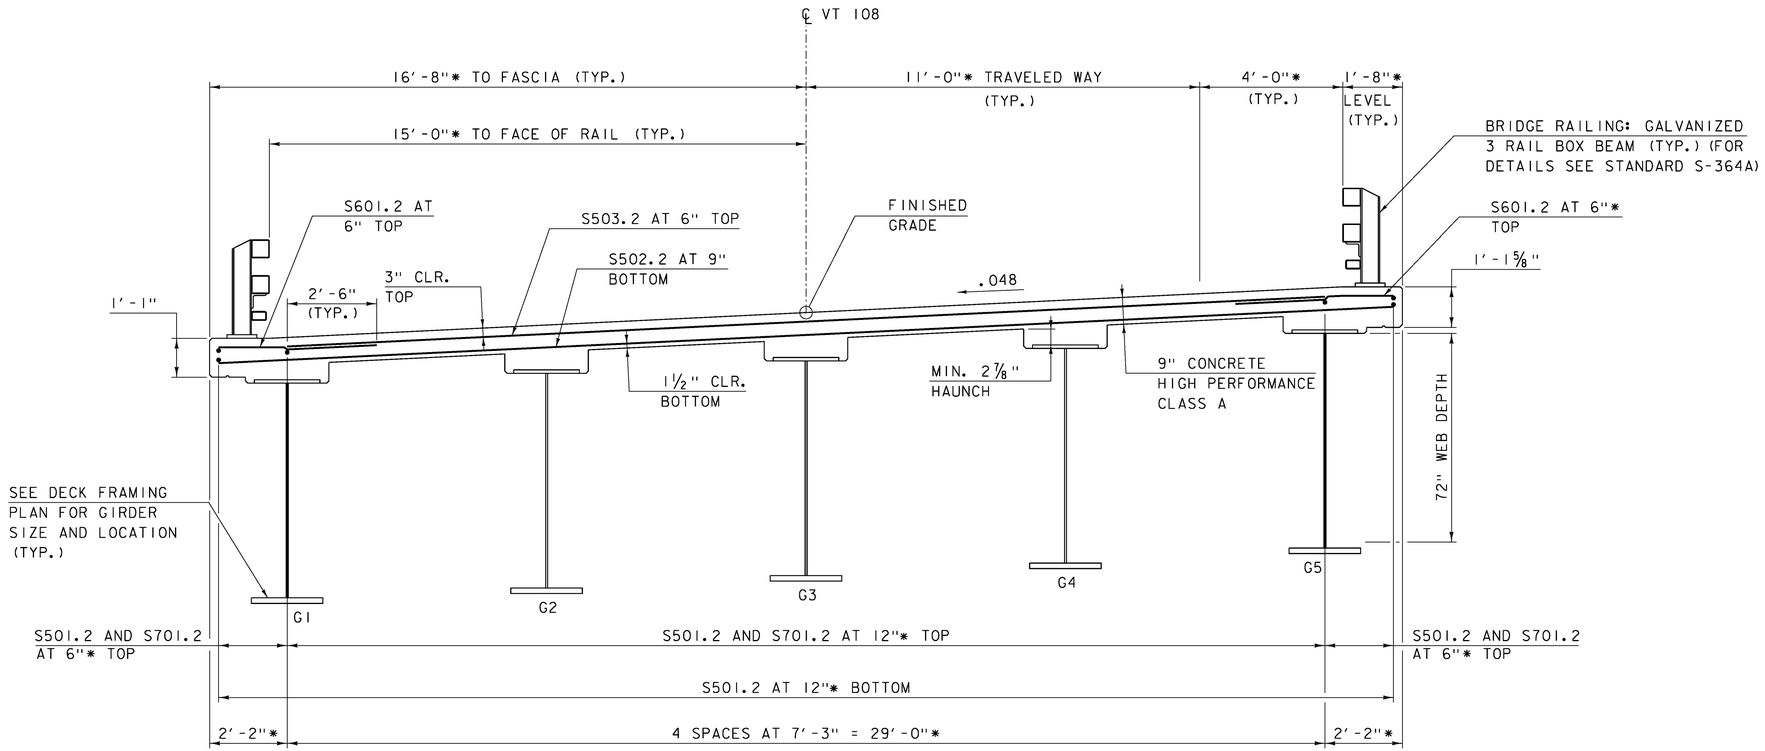


## DECK TYPICAL

SCALE: 1/2" = 1′-0"

* RADIAL DIMENSION

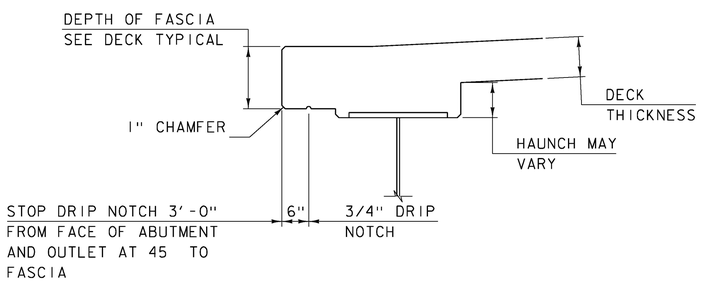



## FASCIA & DRIP NOTCH DETAIL

SCALE: 3/8" = 1′-0"

CLD 12-0120 MODEL:Deck Reinforcement

| | |
|---|---|
| PROJECT NAME: | STOWE |
| PROJECT NUMBER: | BRF 0235(15) |
| FILE NAME: z88cl90sup.dgn | PLOT DATE: 5/8/2015 |
| PROJECT LEADER: J. BYATT | DRAWN BY: M. SMITH |
| DESIGNED BY: J. FRENCH | CHECKED BY: J. BYATT |
| TYPICAL BRIDGE SECTION | SHEET 35 OF 79 |

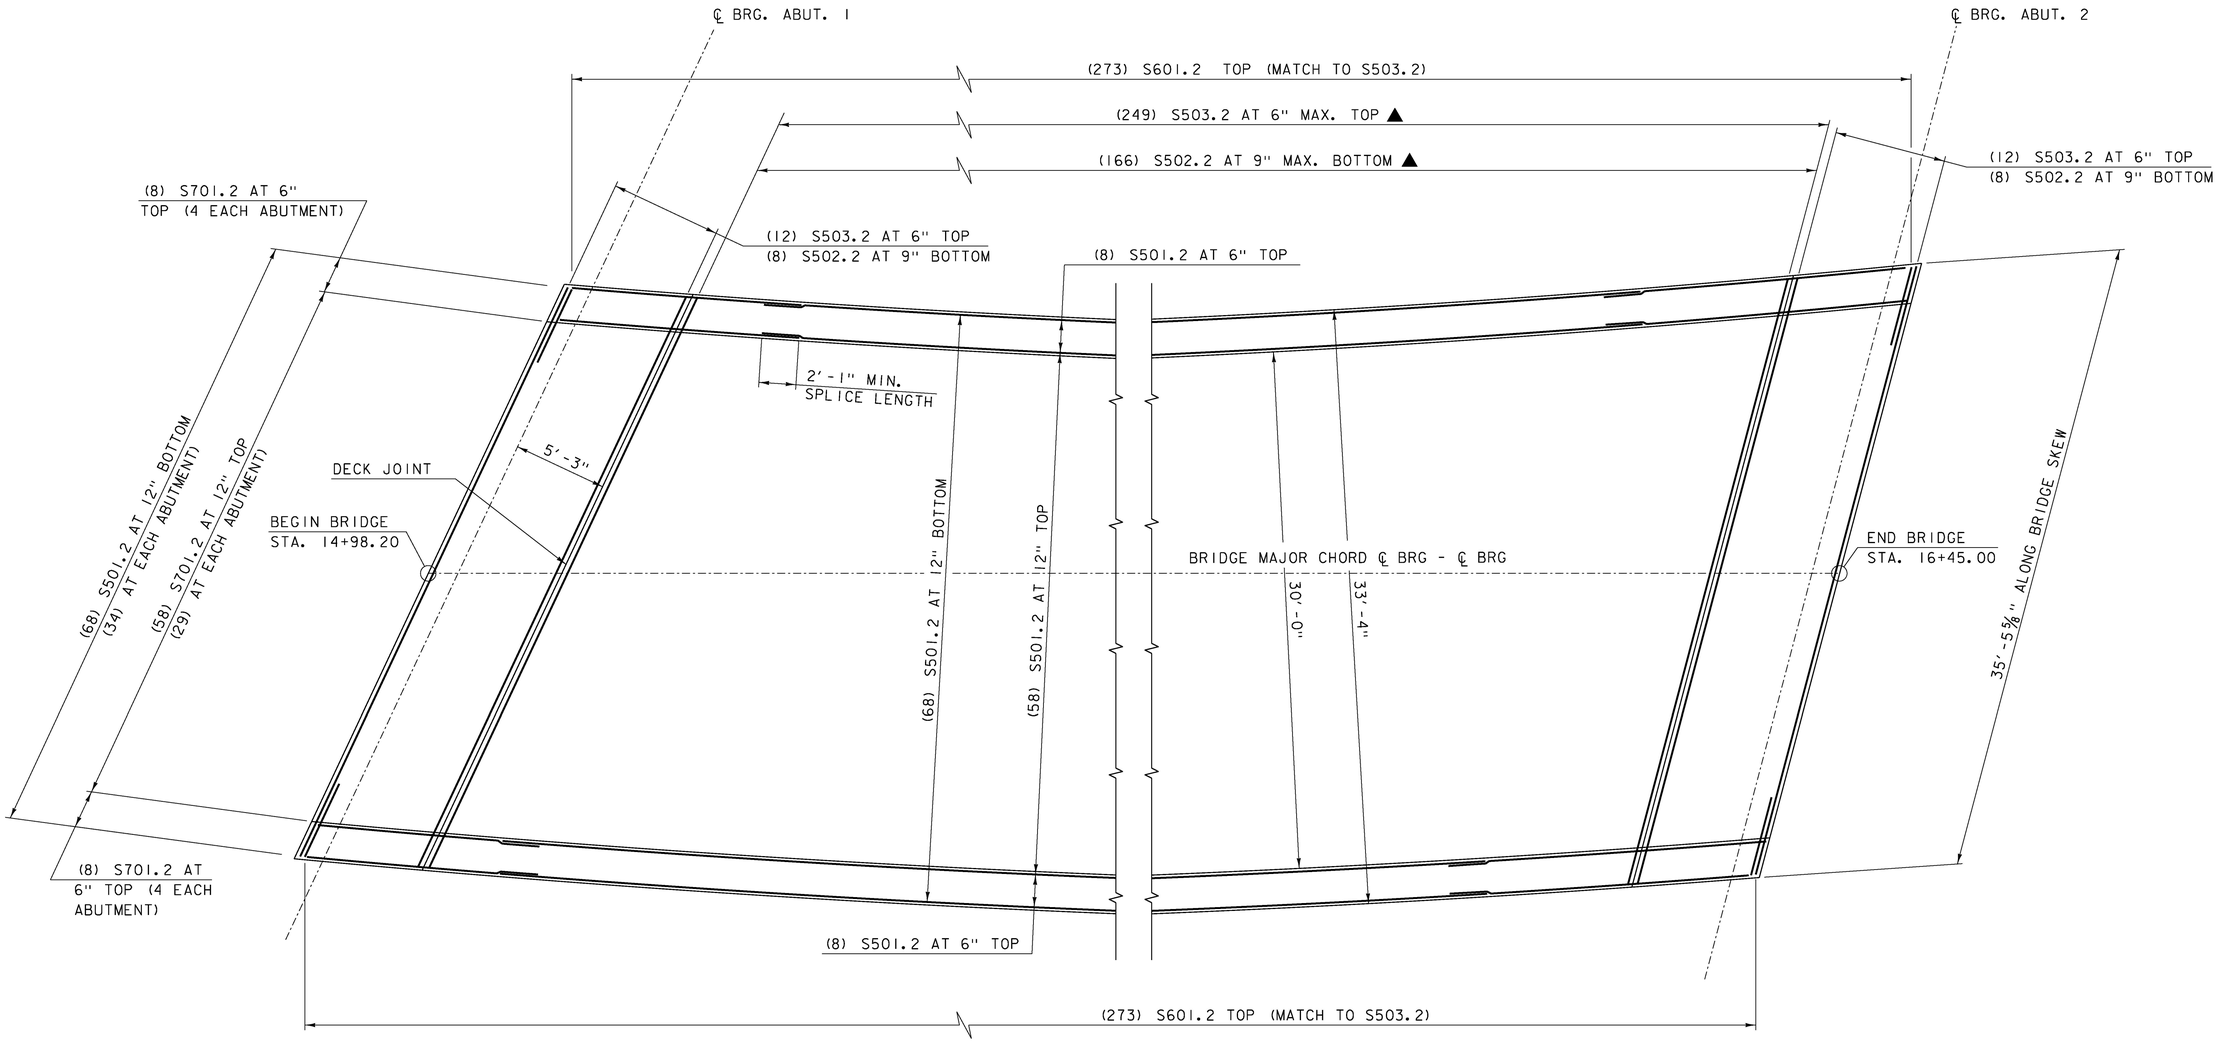



## BRIDGE DECK REINFORCING PLAN

SCALE: 1/4" = 1'-0"

| | |
|---|---|
| PROJECT NAME: | STOWE |
| PROJECT NUMBER: | BRF 0235(15) |
| FILE NAME: z88c190sup.dgn | PLOT DATE: 5/8/2015 |
| PROJECT LEADER: J. BYATT | DRAWN BY: M. SMITH |
| DESIGNED BY: J. FRENCH | CHECKED BY: J. BYATT |
| DECK REINFORCING PLAN | SHEET 36 OF 79 |

CONSULTING ENGINEERS


CLD 12-020 MODEL: Deck Reinforcing Plan

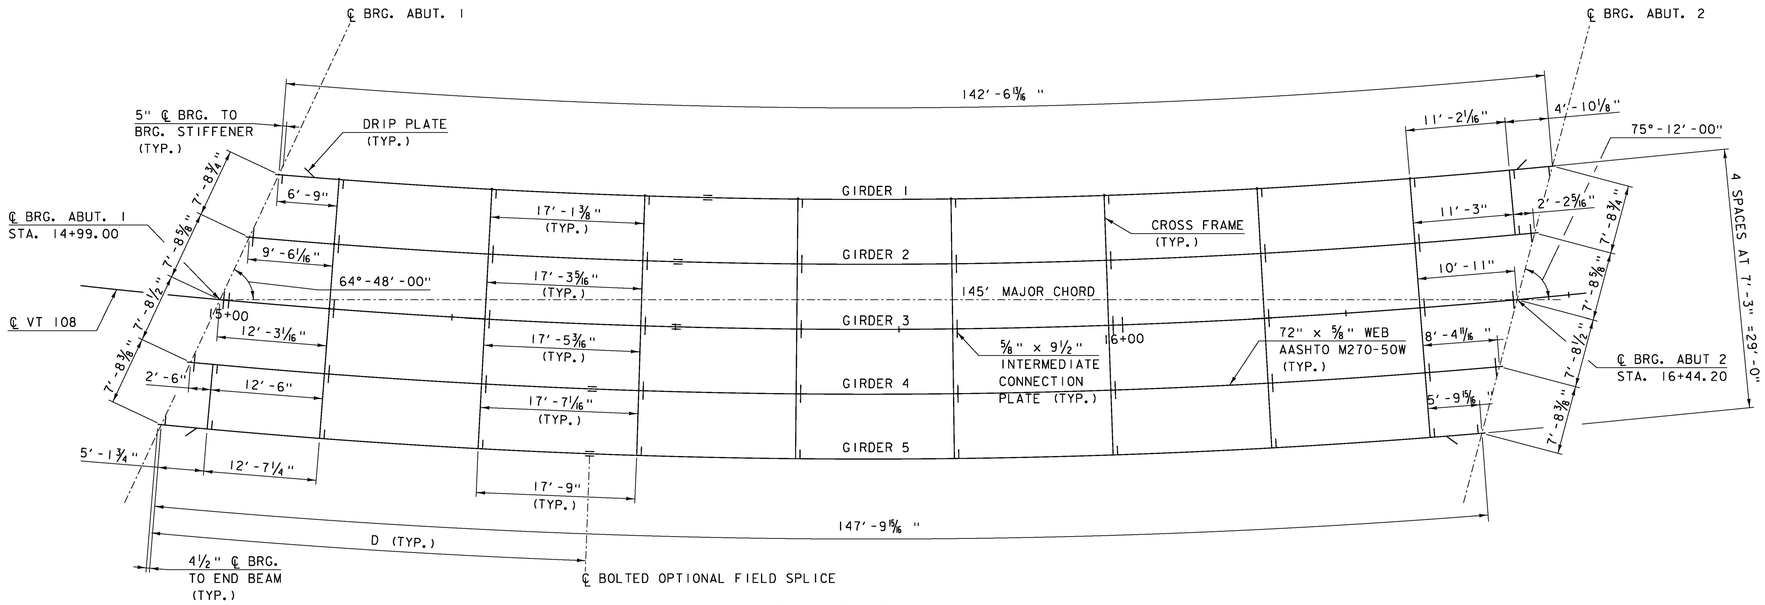


## FRAMING PLAN

SCALE: 1/8" = 1′-0"

| GIRDER | MAX SWEEP DISTANCE |
|---|---|
| G1 | 3′-2 13/16 " |
| G2 | 3′-3 1/8 " |
| G3 | 3′-3 1/2 " |
| G4 | 3′-3 7/8 " |
| G5 | 3′-4 1/4 " |

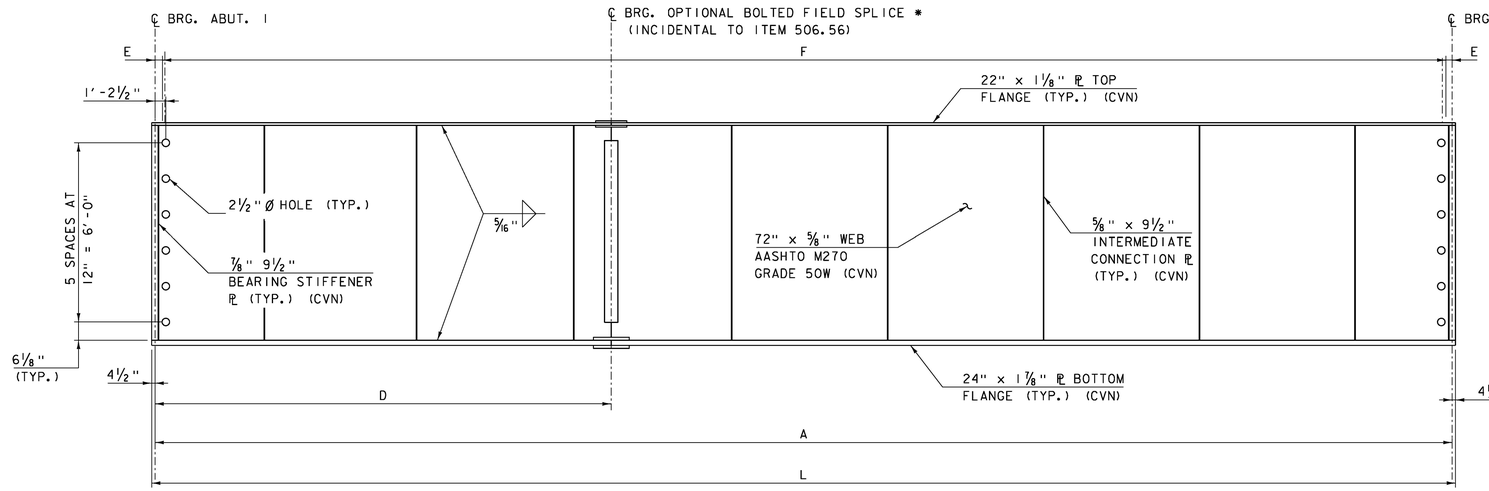



## GIRDER ELEVATION

HORIZONTAL SCALE: 1/8" = 1′-0"
VERTICAL SCALE: 1/2" = 1′-0"

| | GIRDER DIMENSIONS | | | | SHEAR CONNECTOR SPACING | | SHEAR CONNECTORS PER GIRDER |
|---|---|---|---|---|---|---|---|
| | A | L | D | RADIUS | E | F | |
| GIRDER 1 | 142.57′ | 143.32′ | 48′ | 785.50′ | 1 SP. AT 9 1/2" = 9 1/2" | 117 SP. AT 15" = 146′-3" | 240 |
| GIRDER 2 | 143.88′ | 144.63′ | 48′ | 792.75′ | 1 SP. AT 9 1/8" = 9 1/8" | 116 SP. AT 15" = 145′-0" | 238 |
| GIRDER 3 | 145.20′ | 145.95′ | 51′ | 800.00′ | 1 SP. AT 8 3/4" = 8 3/4" | 115 SP. AT 15" = 143′-9" | 236 |
| GIRDER 4 | 146.51′ | 147.26′ | 45′ | 807.25′ | 1 SP. AT 8 1/4" = 8 1/4" | 114 SP. AT 15" = 142′-6" | 234 |
| GIRDER 5 | 147.83′ | 148.58′ | 48′ | 814.50′ | 1 SP. AT 7 7/8" = 7 7/8" | 113 SP. AT 15" = 141′-3" | 232 |
| | | | | | | | 1180 TOTAL |

* IF THE BOLTED FIELD SPLICE IS OMITTED THE GIRDER SHALL BE PROVIDED IN ONE CONTINUOUS LENGTH.

(2) ROWS OF 9" x 7/8" Ø WELDED STUDS SPACED ALONG FLANGE AND OF THE LENGTH (S) AS SHOWN ON THE PROJECT PLANS.

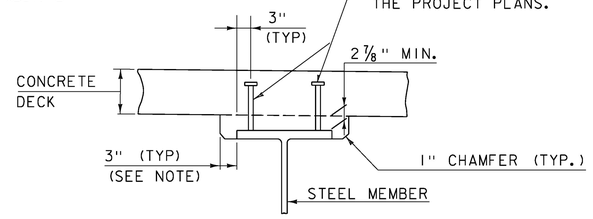


NOTES:

1. THE 3" HORIZONTAL SECTION MAY BE ELIMINATED FOR FORMING SYSTEMS DESIGNED FOR THE CONSTRUCTION OF VERTICAL HAUNCHES. ANY VOIDS RESULTING FROM FORMING SYSTEM ELEMENTS SHALL BE FILLED WITH JOINT SEALER, POLYURETHANE MEETING THE REQUIREMENTS OF SECTION 524. THE COST OF THE JOINT SEALER, POLYURETHANE SHALL BE INCIDENTAL TO THE ADJACENT CONCRETE.
2. SHEAR CONNECTORS AT THE FIELD SPLICE SHALL BE ARRANGED TO CLEAR FASTENERS AND SHALL BE WELDED TO THE SPLICE PLATE.

## HAUNCH AND SHEAR CONNECTOR DETAIL


SCALE: 3/4" = 1′-0"

CLD 12-020 MODEL: Framing Plan

PROJECT NAME: STOWE
PROJECT NUMBER: BRF 0235(15)


FILE NAME: z88cl90sup.dgn
PROJECT LEADER: J. BYATT
DESIGNED BY: J. FRENCH
FRAMING PLAN AND DETAILS (1 OF 2)

PLOT DATE: 5/13/2015
DRAWN BY: M. SMITH
CHECKED BY: J. BYATT
SHEET 37 OF 79

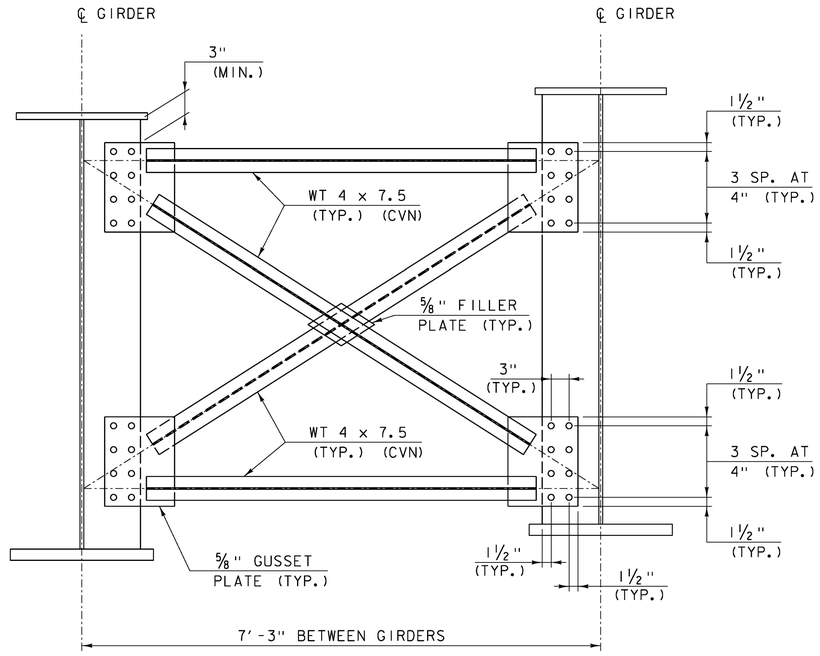



## CROSS FRAME DETAIL

SCALE: 1" = 1'-0"

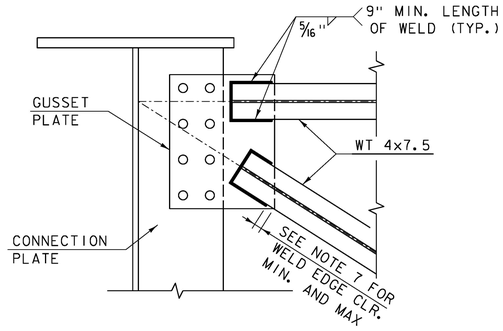


## WT TO GUSSET PLATE WELD DETAIL

SCALE: 1½" = 1'-0"

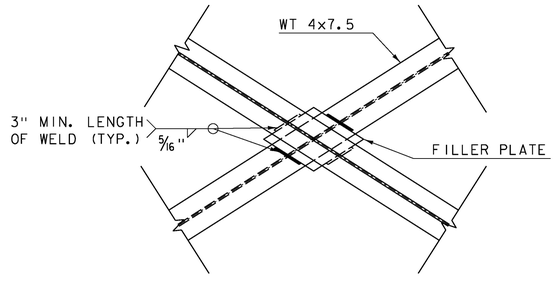


## WT TO FILLER PLATE WELD DETAIL

SCALE: 1½" = 1'-0"


## STRUCTURAL STEEL GENERAL NOTES:

1. ALL FIELD CONNECTIONS SHALL BE MADE WITH ⅞" DIAMETER HIGH-STRENGTH BOLTS IN 15/16 " DIAMETER HOLES, PER SUBSECTION 506.19, UNLESS OTHERWISE SPECIFIED.
2. ALL WELDING SHALL CONFORM TO THE PROVISIONS OF SUBSECTION 506.10.
3. ANY CONNECTIONS THAT ARE NOT DETAILED ON THE PLANS SHALL BE DETAILED BY THE FABRICATOR AND SUBMITTED TO THE STRUCTURES ENGINEER FOR APPROVAL.
4. STRUCTURAL STEEL MEMBERS DESIGNATED "CVN" IN THE PLANS SHALL BE CHARPY V-NOTCH TESTED IN ACCORDANCE WITH SUBSECTION 714.01 OF THE STANDARD SPECIFICATIONS.
5. ENDS OF GIRDERS ARE TO BE VERTICAL IN THEIR FINAL POSITION.
6. AFTER SUPERSTRUCTURE STEEL HAS BEEN ERECTED, ELEVATIONS ALONG THE TOP OF THE GIRDERS SHALL BE TAKEN AS DIRECTED BY THE RESIDENT ENGINEER FOR USE IN DETERMINING FINISHED GRADES.
7. NO WELD FOR ¼" MIN. - ½" MAX. DISTANCE FROM GUSSET PLATE EDGES.

CLD 12-020 MODEL: Superstructure Details


| | |
|---|---|
| PROJECT NAME: | STOWE |
| PROJECT NUMBER: | BRF 0235(15) |
| FILE NAME: z88cl90sup.dgn | PLOT DATE: 5/8/2015 |
| PROJECT LEADER: J. BYATT | DRAWN BY: M. SMITH |
| DESIGNED BY: J. FRENCH | CHECKED BY: J. BYATT |
| FRAMING PLAN AND DETAILS (2 OF 2) | SHEET 38 OF 79 |

CLD CONSULTING ENGINEERS

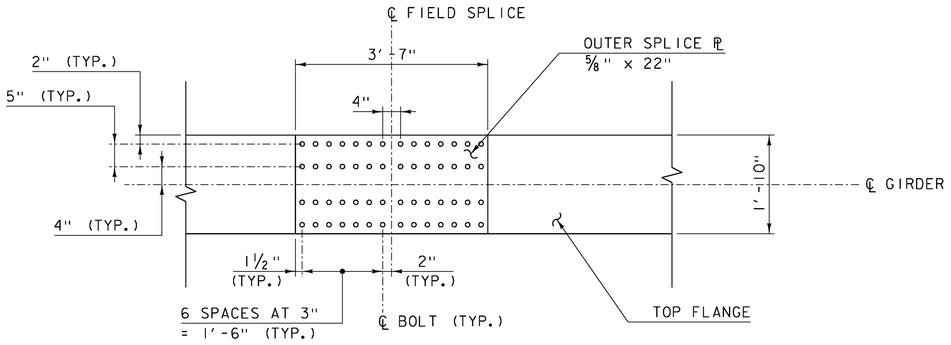


## TOP FLANGE


SCALE: 3/4" = 1'-0"

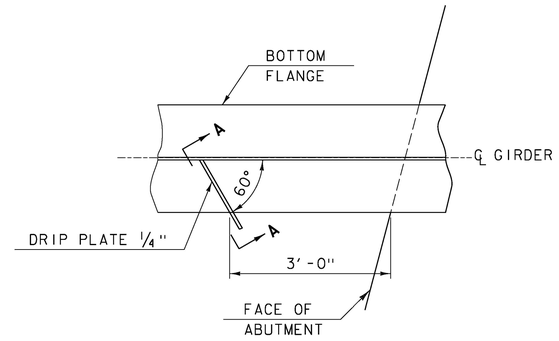


## PLAN DRIP PLATE


SCALE: 3/4" = 1'-0"

NOTE: DRIP PLATES SHALL BE PLACED ON OUTSIDE EDGE OF FASCIA GIRDERS AS INDICATED ON PROJECT PLANS.

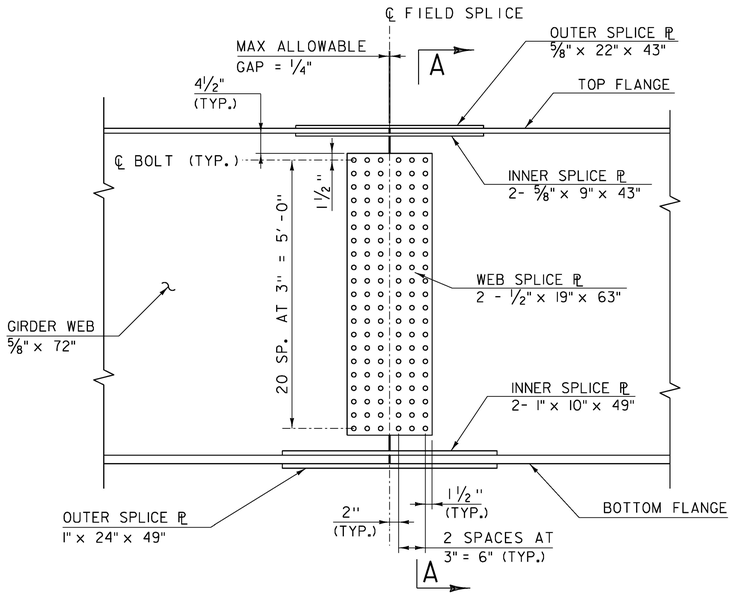



## WEB SPLICE

SCALE: 3/4" = 1'-0"

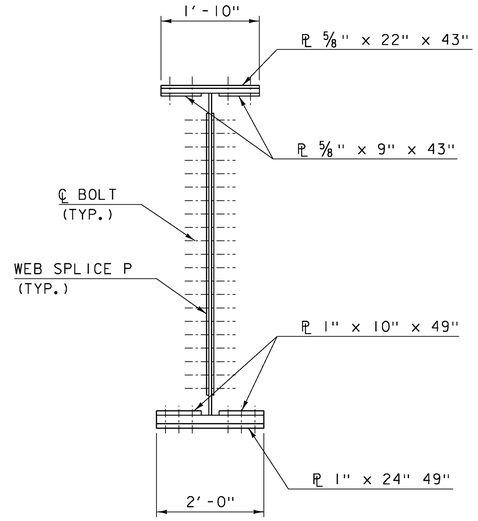



## SECTION A-A

SCALE: 3/4" = 1'-0"

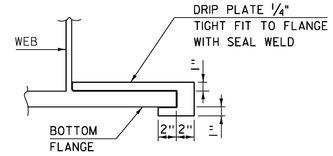


## SECTION A-A

SCALE: 1 1/2" = 1'-0"

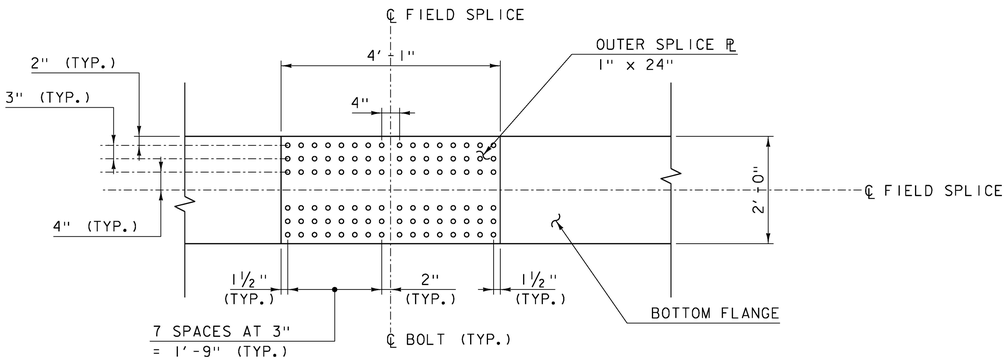



## BOTTOM FLANGE

SCALE: 3/4" = 1'-0"

NOTE: BOLTED FIELD SPLICE IS OPTIONAL AND SHALL BE INCIDENTAL TO ITEM 506.56. IF THE BOLTED FIELD SPLICE IS OMITTED THE GIRDER SHALL BE PROVIDED IN ONE CONTINUOUS LENGTH.


CLD 12-020 MODEL: Splice Details

| | |
|---|---|
| PROJECT NAME: STOWE | |
| PROJECT NUMBER: BRF 0235(15) | |
| FILE NAME: z88cl90sup.dgn | PLOT DATE: 5/13/2015 |
| PROJECT LEADER: J. BYATT | DRAWN BY: M. SMITH |
| DESIGNED BY: J. FRENCH | CHECKED BY: J. BYATT |
| SPLICE DETAILS | SHEET 39 OF 79 |

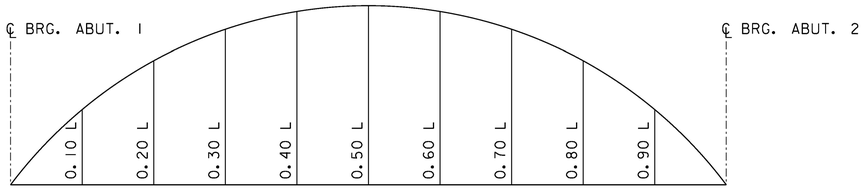


CAMBER DIAGRAM

SEE TABLES BELOW

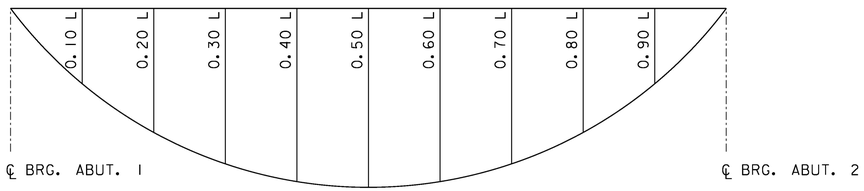


DEAD LOAD DEFLECTION DIAGRAM

SEE TABLES BELOW

| | | CAMBER TABLE AT 1/10TH POINTS (INCHES) | | | | | | | | |
|---|---|---|---|---|---|---|---|---|---|---|
| POINT ON GIRDER | | 0.10L | 0.20L | 0.30L | 0.40L | 0.50L | 0.60L | 0.70L | 0.80L | 0.90L |
| GIRDER 1 | STEEL DL | 0 | 1/2 | 3/4 | 7/8 | 1 | 7/8 | 12/16 | 4/8 | 0 |
| | CONCRETE SLAB DL | 9/16 | 1 | 1 3/8 | 1 5/8 | 1 3/4 | 1 5/8 | 1 7/16 | 1 | 9/16 |
| | SUPERIMPOSED DL | 0 | 0 | 0 | 0 | 0 | 0 | 0 | 0 | 0 |
| | VERTICAL CURVE | 1 13/16 | 3 3/16 | 4 3/16 | 4 13/16 | 5 | 4 13/16 | 4 1/4 | 3 3/16 | 1 13/16 |
| | TOTAL CAMBER | 2 5/8 | 5 | 6 3/8 | 7 3/8 | 7 11/16 | 7 3/8 | 6 3/8 | 5 | 2 5/8 |
| GIRDER 2 | STEEL DL | 0 | 3/4 | 15/16 | 1 | 1 1/4 | 1 | 15/16 | 5/8 | 0 |
| | CONCRETE SLAB DL | 3/4 | 1 3/8 | 1 7/8 | 2 3/16 | 2 1/2 | 2 3/16 | 1 7/8 | 1 5/16 | 11/16 |
| | SUPERIMPOSED DL | 0 | 0 | 0 | 0 | 0 | 0 | 0 | 0 | 0 |
| | VERTICAL CURVE | 1 13/16 | 3 3/16 | 4 3/16 | 4 13/16 | 5 | 4 13/16 | 4 3/16 | 3 3/16 | 1 13/16 |
| | TOTAL CAMBER | 2 7/8 | 5 1/2 | 7 | 8 | 8 2/4 | 8 | 7 | 5 1/2 | 2 14/16 |
| GIRDER 3 | STEEL DL | 0 | 7/8 | 1 3/16 | 1 1/4 | 1 2/4 | 1 1/4 | 1 2/16 | 7/8 | 7/16 |
| | CONCRETE SLAB DL | 7/8 | 1 3/4 | 2 1/4 | 2 1/2 | 2 13/16 | 2 1/2 | 2 2/8 | 1 3/4 | 7/8 |
| | SUPERIMPOSED DL | 0 | 0 | 0 | 0 | 0 | 0 | 0 | 0 | 0 |
| | VERTICAL CURVE | 1 13/16 | 3 3/16 | 4 3/16 | 4 13/16 | 5 | 4 13/16 | 4 3/16 | 3 3/16 | 1 13/16 |
| | TOTAL CAMBER | 3 3/16 | 5 13/16 | 7 3/4 | 8 15/16 | 9 5/16 | 8 15/16 | 7 11/16 | 5 3/4 | 3 1/8 |
| GIRDER 4 | STEEL DL | 9/16 | 1 | 1 7/16 | 1 3/4 | 1 3/4 | 1 3/4 | 1 3/8 | 1 | 9/16 |
| | CONCRETE SLAB DL | 1 1/16 | 2 | 2 3/4 | 3 | 3 3/8 | 3 | 2 3/4 | 2 | 1 1/16 |
| | SUPERIMPOSED DL | 0 | 0 | 0 | 0 | 0 | 0 | 0 | 0 | 0 |
| | VERTICAL CURVE | 1 13/16 | 3 3/16 | 4 3/16 | 4 13/16 | 5 | 4 13/16 | 4 3/16 | 3 3/16 | 1 13/16 |
| | TOTAL CAMBER | 3 7/16 | 6 5/16 | 8 7/16 | 9 3/4 | 10 1/4 | 9 3/4 | 8 7/16 | 6 1/4 | 3 7/16 |
| GIRDER 5 | STEEL DL | 11/16 | 1 1/4 | 1 3/4 | 2 | 2 1/8 | 2 | 1 3/4 | 1 1/4 | 11/16 |
| | CONCRETE SLAB DL | 1 1/4 | 2 1/4 | 3 1/4 | 3 13/16 | 4 1/16 | 3 7/8 | 3 5/16 | 2 1/2 | 1 1/4 |
| | SUPERIMPOSED DL | 0 | 0 | 0 | 0 | 0 | 0 | 0 | 0 | 0 |
| | VERTICAL CURVE | 1 13/16 | 3 3/16 | 4 3/16 | 4 13/16 | 5 | 4 13/16 | 4 3/16 | 3 3/16 | 1 13/16 |
| | TOTAL CAMBER | 3 3/4 | 6 7/8 | 9 1/4 | 10 3/4 | 11 1/4 | 10 3/4 | 9 1/4 | 6 15/16 | 3 3/4 |


CLD 12-020 MODEL: Camber Diagram

CONSULTING ENGINEERS

PROJECT NAME: STOWE
PROJECT NUMBER: BRF 0235(15)

FILE NAME: z88cl90sup.dgn
PROJECT LEADER: J. BYATT
DESIGNED BY: J. FRENCH
CAMBER AND DEFLECTION DETAILS

PLOT DATE: 5/8/2015
DRAWN BY: M. SMITH
CHECKED BY: J. BYATT
SHEET 40 OF 79

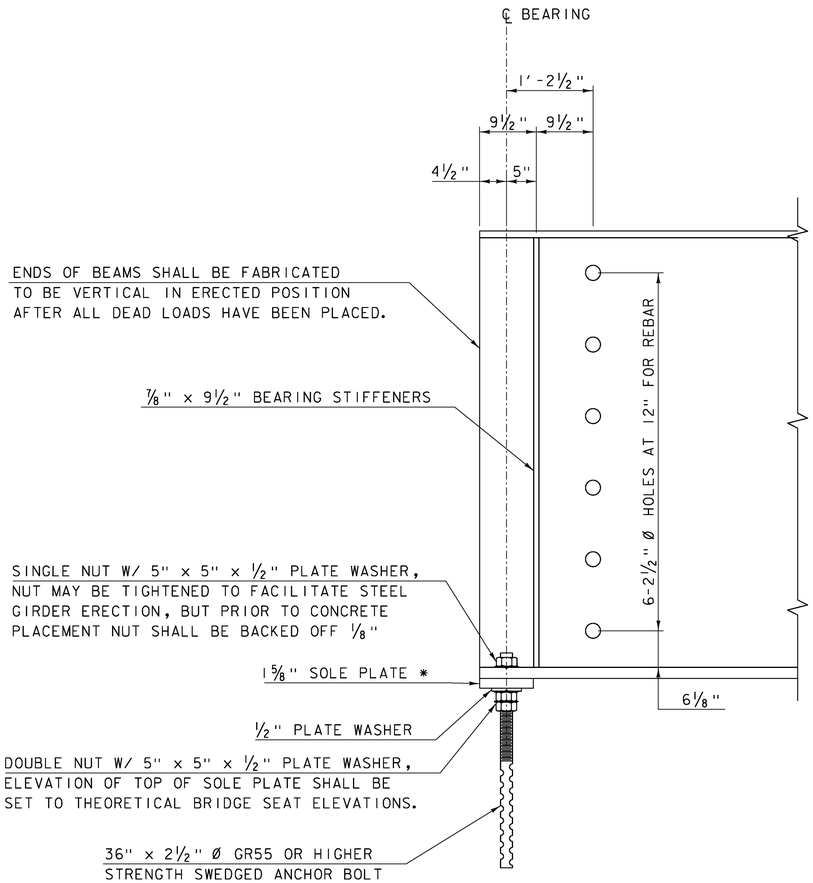


## ELEVATION VIEW END OF STEEL MEMBER AT ABUTMENT


SCALE: 1" = 1'-0"

## NOTES:

1. PAYMENT FOR THE SOLE PLATES, ANCHOR BOLTS, WASHERS AND NUTS SHALL BE INCIDENTAL TO ITEM 506.56, STRUCTURAL STEEL, CURVED PLATE GIRDER.
2. ANCHOR BOLTS SHALL BE 2½" DIAMETER, TYPE 1 BOLTS MEETING ASTM F1554, GR. 55. NUTS SHALL MEET AASHTO M291, THE CONTRACTOR SHALL ENSURE THAT THE ANCHOR BOLTS ARE INSTALLED IN PLUMB POSITION. ONE EXTRA ANCHOR BOLT SHALL BE SUPPLIED FOR TESTING PURPOSES.
3. ALL STEEL IN BEARING DEVICE ASSEMBLY SHALL BE AASHTO M270M/M270 GR 50.
4. SUBSTITUTIONS FOR BEARING DEVICE ASSEMBLY COMPONENT MATERIALS AND SIZES SHALL BE DETAILED ON THE FABRICATION DRAWINGS. ALL SUBSTITUTIONS SHALL BE APPROVED BY THE PROJECT MANAGER PRIOR TO FABRICATION AS PER SUBSECTION 506.04.


| THEORETICAL TOP OF SOLE PLATE ELEVATION | | |
|---|---|---|
| | ABUTMENT #1 | ABUTMENT #2 |
| GIRDER 1 | 739.66 | 738.12 |
| GIRDER 2 | 740.01 | 738.53 |
| GIRDER 3 | 740.35 | 738.93 |
| GIRDER 3 | 740.69 | 739.34 |
| GIRDER 4 | 741.04 | 739.74 |

* GREASE TOP OF SOLE PLATE BEFORE GIRDER PLACEMENT

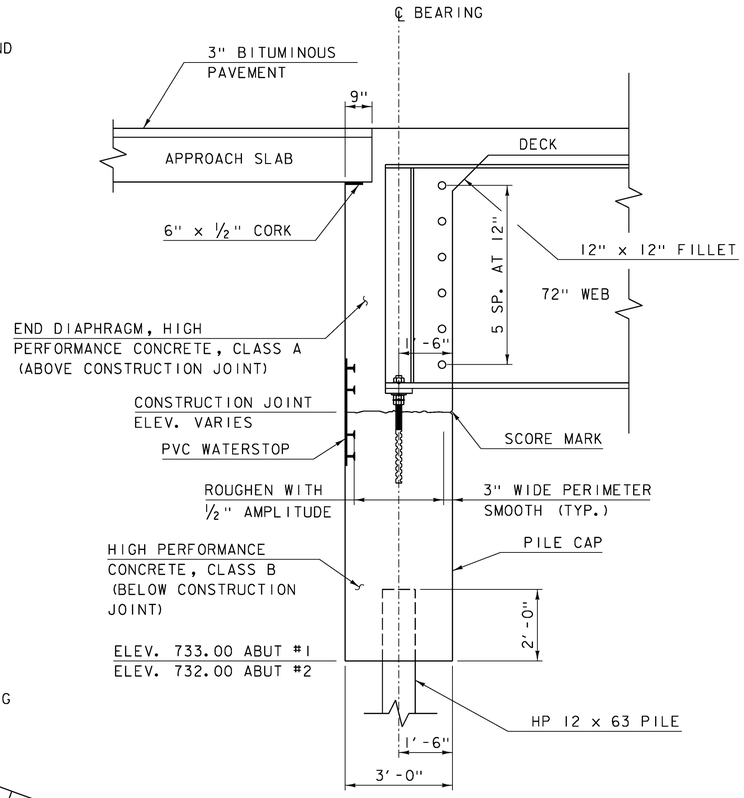



## BRIDGE END DETAIL AND ABUTMENT TYPICAL SECTION

SCALE: ½" = 1'-0"

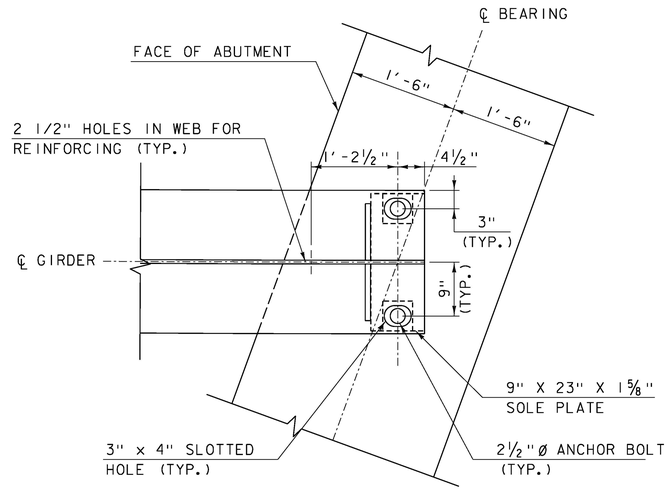



## PLAN VIEW, END OF STEEL AT ABUTMENT 2

REVERSE GIRDER FOR ABUTMENT 1
SCALE: 1" = 1'-0"

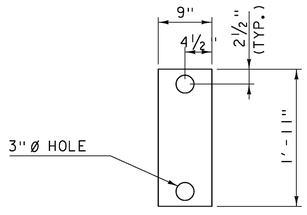


## 15/8" SOLE PLATE DETAIL

SCALE: 1" = 1'-0"

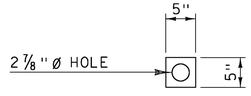



## 1/ 2" PLATE WASHER DETAIL

SCALE: 1" = 1'-0"

CLD 12-0120 MODEL: Bearing Details


| | |
|---|---|
| PROJECT NAME: | STOWE |
| PROJECT NUMBER: | BRF 0235(15) |
| FILE NAME: z88cl90sup.dgn | PLOT DATE: 5/8/2015 |
| PROJECT LEADER: J. BYATT | DRAWN BY: M. SMITH |
| DESIGNED BY: J. FRENCH | CHECKED BY: J. BYATT |
| BEARING DETAILS | SHEET 41 OF 79 |

CONSULTING ENGINEERS

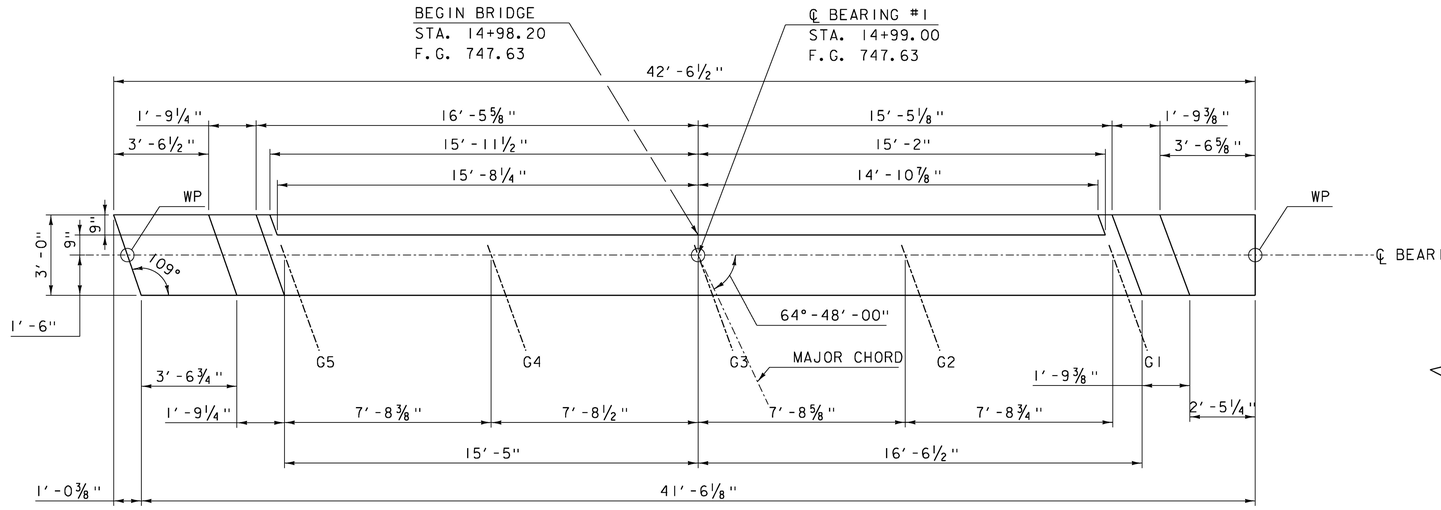


## ABUTMENT #1 PLAN


SCALE: ⅜" = 1'-0"

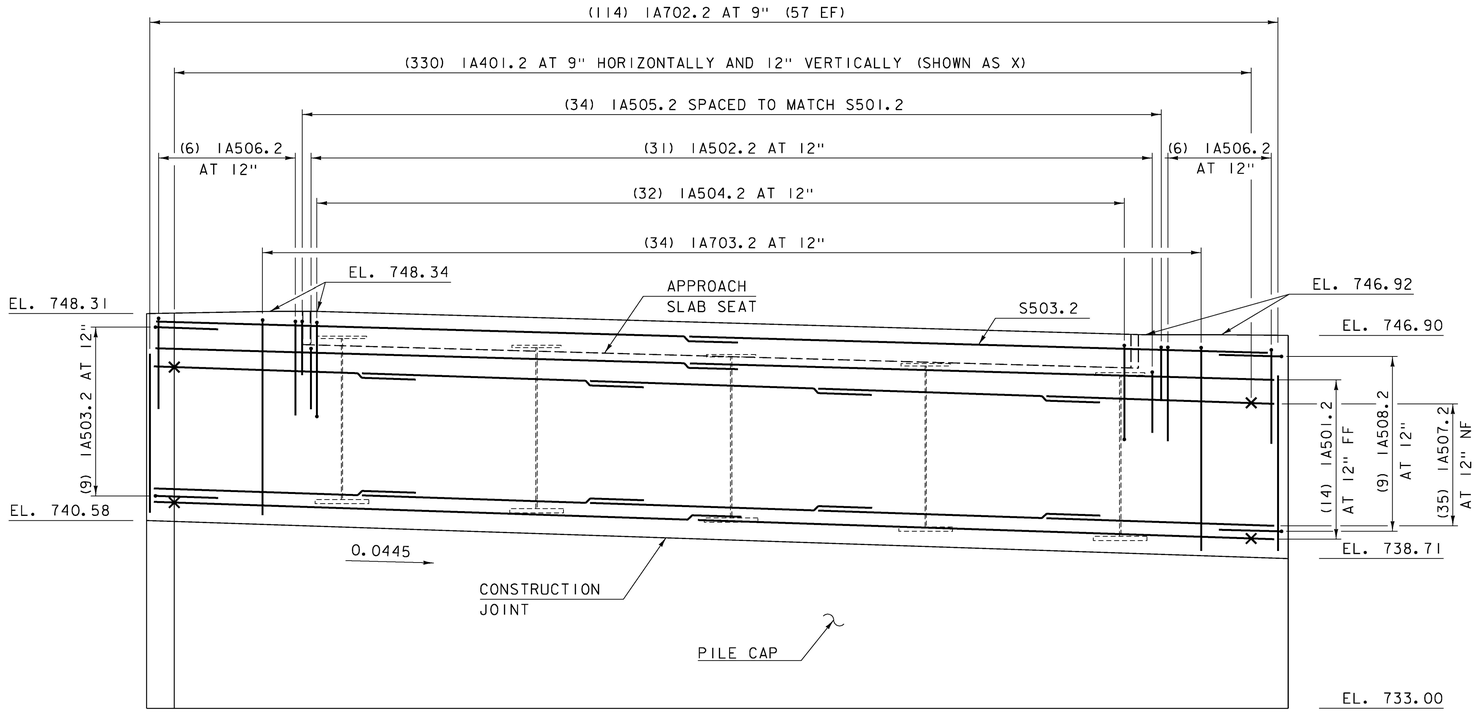


## ABUTMENT #1 ELEVATION

SCALE: ⅜" = 1'-0"

NOTE: ELEVATIONS SHOWN ARE AT ℄ OF BEARING.

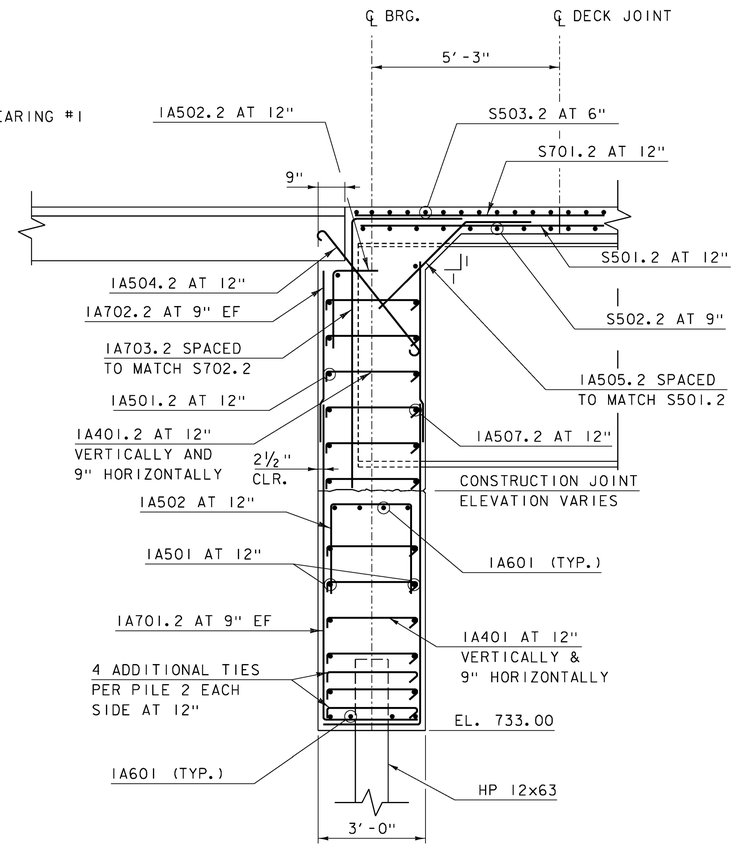


## ABUTMENT #1 TYPICAL REBAR SECTION

SCALE: ½" = 1'-0"

### NOTE:


NF = NEAR FACE
FF = FAR FACE
EF = EACH FACE
▲ = CUT TO FIT IN FIELD
X = LATERAL TIES
3" CLEAR, UNLESS OTHERWISE SPECIFIED ON THE PLANS.
2' - 2" BAR LAP UNLESS OTHERWISE SPECIFIED ON THE PLANS

CLD 12-020 MODEL: ABUTMENT 1

PROJECT NAME: STOWE
PROJECT NUMBER: BRF 0235(15)


FILE NAME: z88cl90sub.dgn
PROJECT LEADER: J. BYATT
DESIGNED BY: J. FRENCH
ABUTMENT 1 PLAN AND ELEVATION

PLOT DATE: 5/8/2015
DRAWN BY: M. SMITH
CHECKED BY: J. BYATT
SHEET 42 OF 79

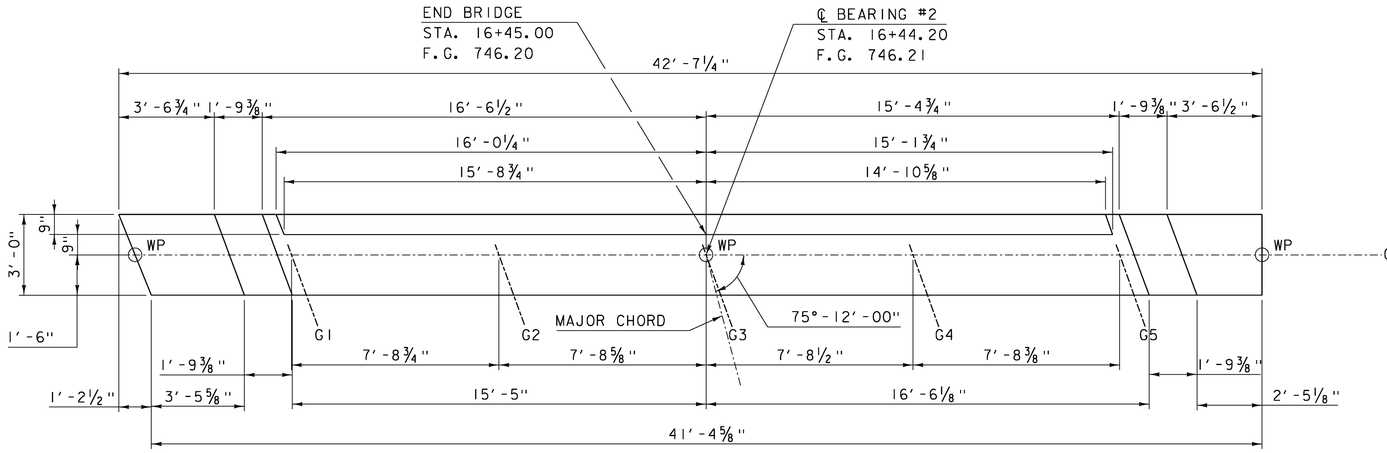


## ABUTMENT #2 PLAN


SCALE: ⅜" = 1'-0"

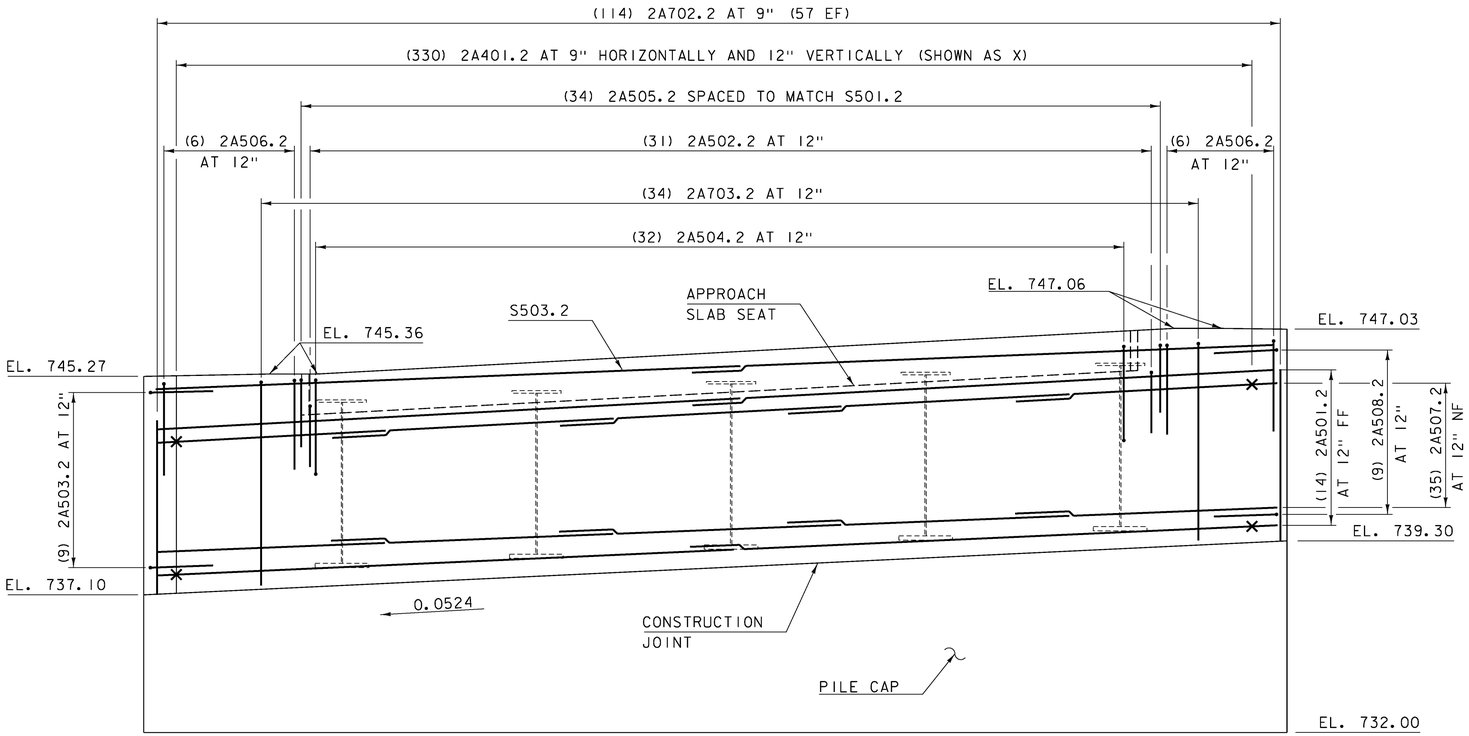


## ABUTMENT #2 ELEVATION

SCALE: ⅜" = 1'-0"

NOTE: ELEVATIONS SHOWN ARE AT ℄ OF BEARING.

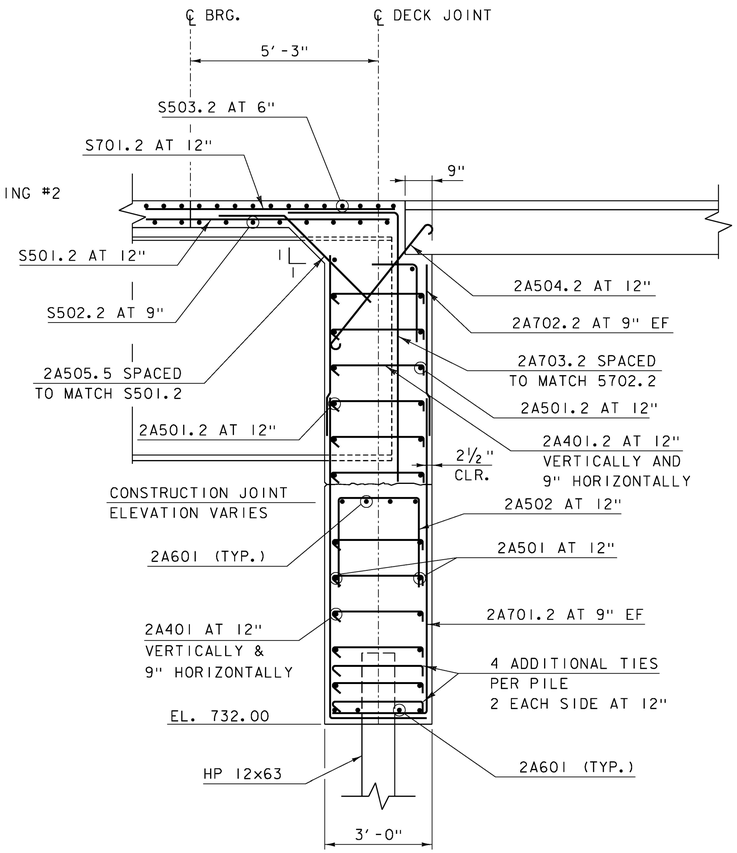


## ABUTMENT #2 TYPICAL REBAR SECTION

SCALE: ½" = 1'-0"

### NOTE:

NF = NEAR FACE
FF = FAR FACE
EF = EACH FACE
▲ = CUT TO FIT IN FIELD
X = LATERAL TIES
3" CLEAR, UNLESS OTHERWISE SPECIFIED ON THE PLANS.
2' - 2" BAR LAP UNLESS OTHERWISE SPECIFIED ON THE PLANS


CONSULTING ENGINEERS

| | |
|---|---|
| PROJECT NAME: STOWE | |
| PROJECT NUMBER: BRF 0235(15) | |
| FILE NAME: z88cl90sub.dgn | PLOT DATE: 5/8/2015 |
| PROJECT LEADER: J. BYATT | DRAWN BY: M. SMITH |
| DESIGNED BY: J. FRENCH | CHECKED BY: J. BYATT |
| ABUTMENT 2 PLAN AND ELEVATION | SHEET 43 OF 79 |

CLD 12-020 MODEL: ABUTMENT 2


NOTE:

SEE PROJECT NOTES FOR ADDITIONAL FABRICATION, CONSTRUCTION, AND SEQUENCE NOTES.

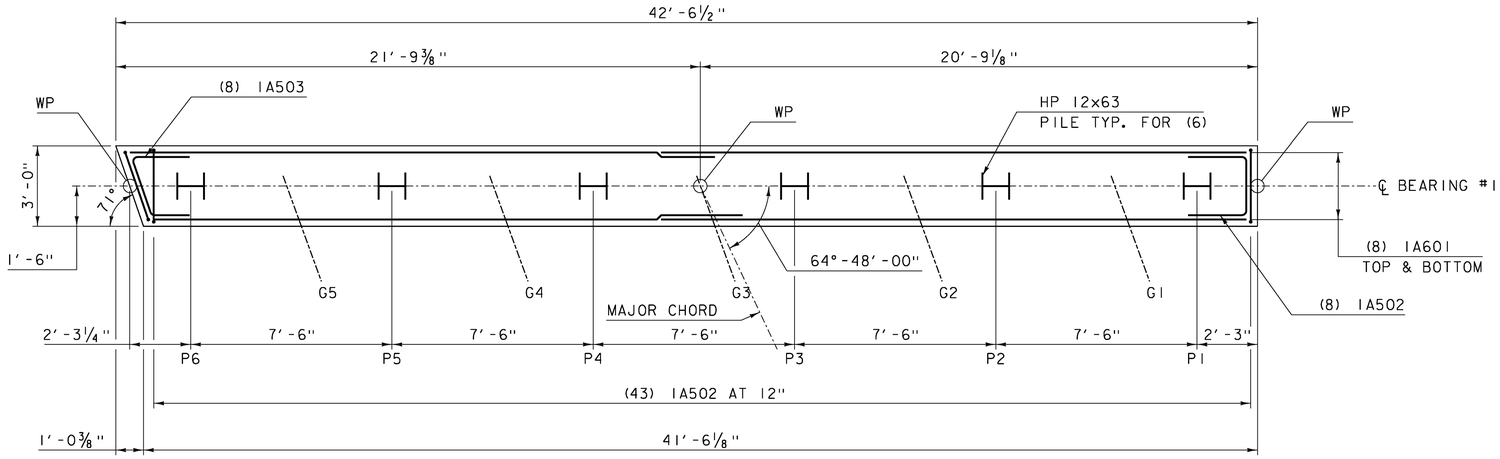


ABUTMENT #1 PILE CAP PLAN

SCALE: ⅜" = 1′-0"

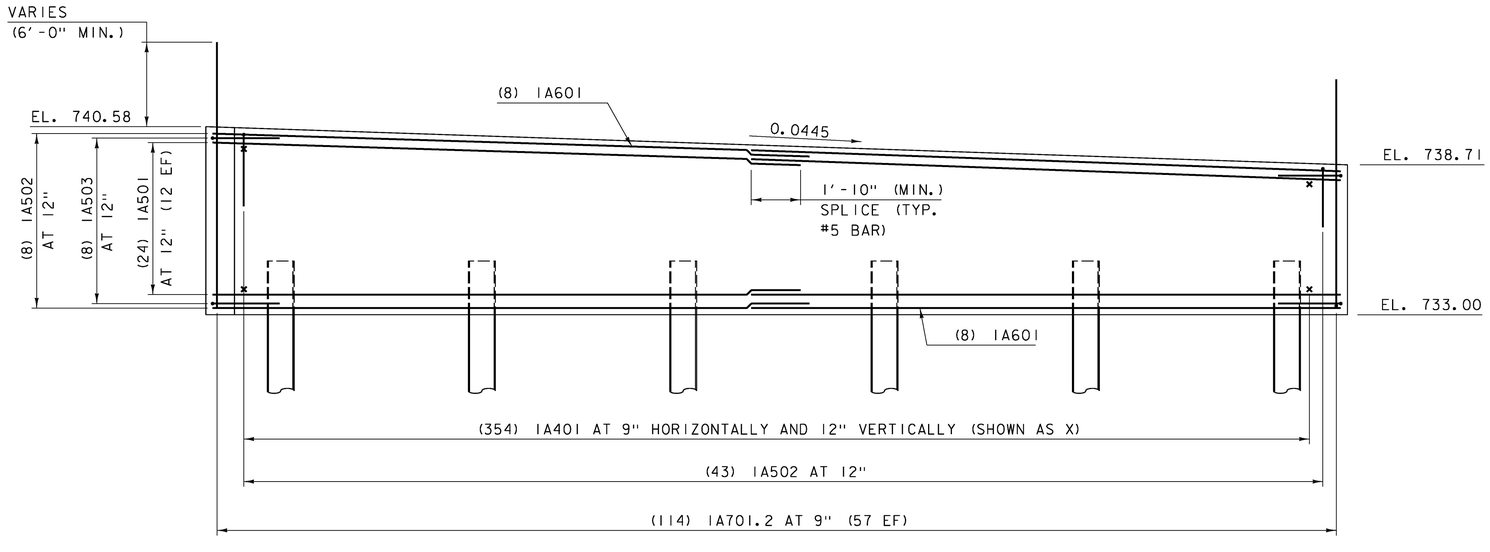


ABUTMENT #1 PILE CAP ELEVATION

SCALE: ⅜" = 1′-0"

NOTE:

NF = NEAR FACE
FF = FAR FACE
EF = EACH FACE
▲ = CUT TO FIT IN FIELD
3" CLEAR, UNLESS OTHERWISE SPECIFIED ON THE PLANS.
2′ - 2" BAR LAP UNLESS OTHERWISE SPECIFIED ON THE PLANS
X = LATERAL TIE


| | |
|---|---|
| PROJECT NAME: | STOWE |
| PROJECT NUMBER: | BRF 0235(15) |

| | |
|---|---|
| FILE NAME: z88c190sub.dgn | PLOT DATE: 5/8/2015 |
| PROJECT LEADER: J. BYATT | DRAWN BY: M. SMITH |
| DESIGNED BY: J. FRENCH | CHECKED BY: J. BYATT |
| ABUTMENT 1 PILE CAP PLAN AND ELEVATION | SHEET 44 OF 79 |

CLD 12-0120 MODEL: PILE CAP 1


NOTE:

SEE PROJECT NOTES FOR ADDITIONAL FABRICATION, CONSTRUCTION, AND SEQUENCE NOTES.

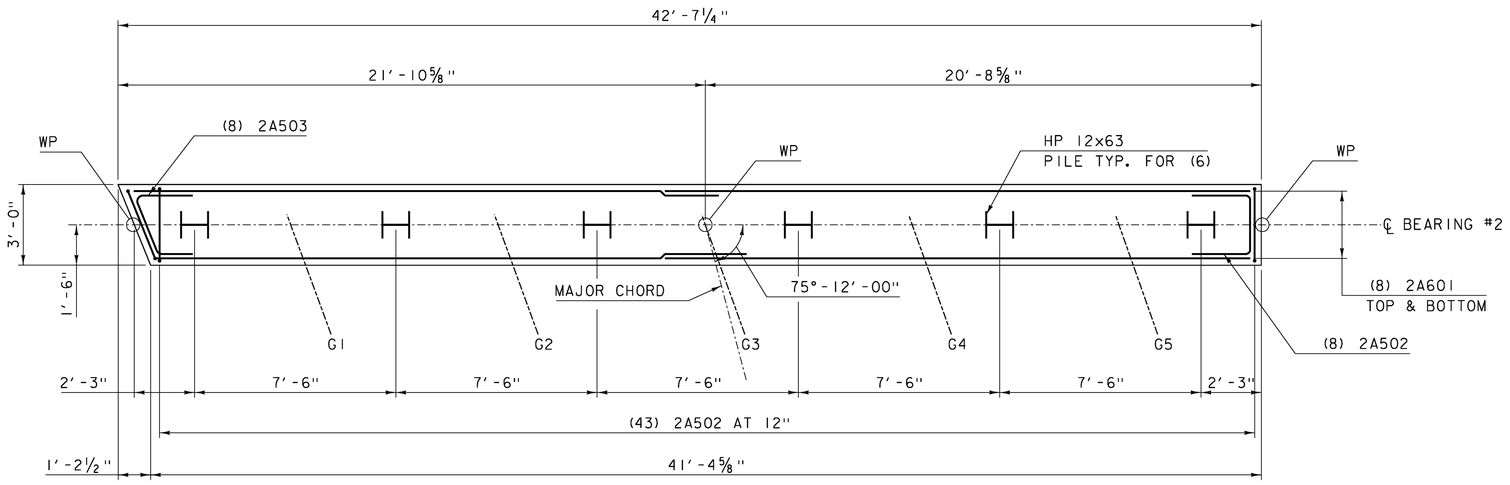


ABUTMENT #2 PILE CAP PLAN

SCALE: ⅜" = 1'-0"

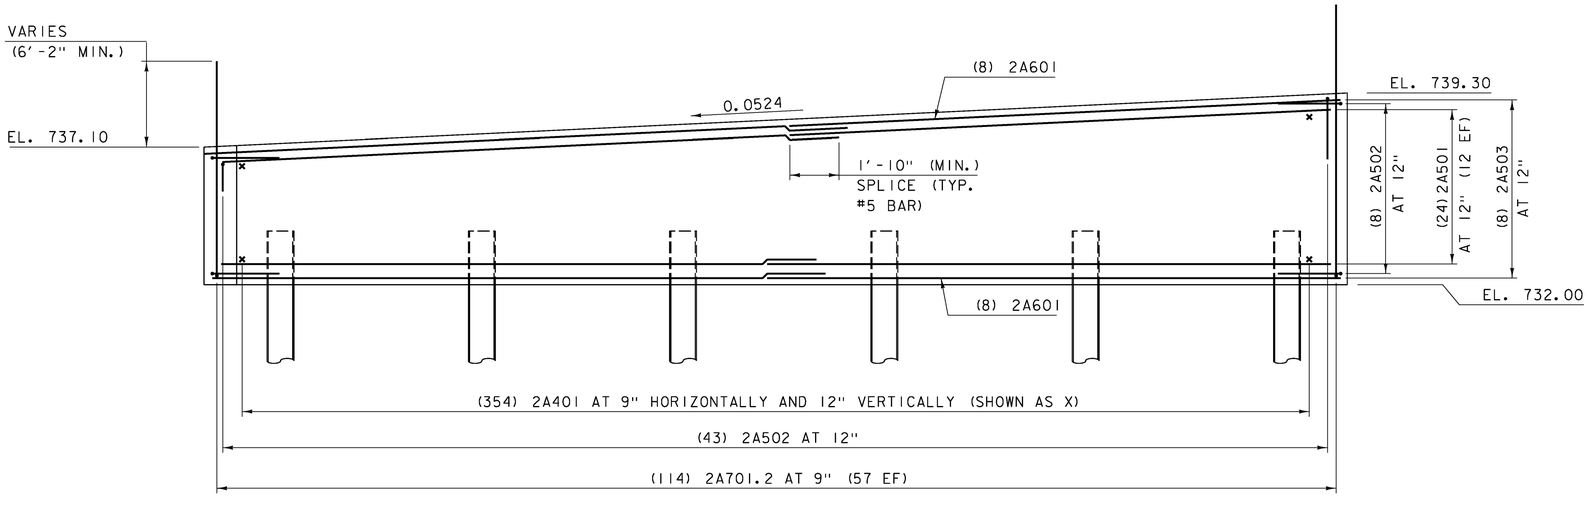


ABUTMENT #2 PILE CAP ELEVATION

SCALE: ⅜" = 1'-0"


NOTE:

NF = NEAR FACE
FF = FAR FACE
EF = EACH FACE
▲ = CUT TO FIT IN FIELD
3" CLEAR, UNLESS OTHERWISE SPECIFIED ON THE PLANS.
2' - 2" BAR LAP UNLESS OTHERWISE SPECIFIED ON THE PLANS
X = LATERAL TIE

| | |
|---|---|
| PROJECT NAME: | STOWE |
| PROJECT NUMBER: | BRF 0235(15) |


| | |
|---|---|
| FILE NAME: z88cl90sub.dgn | PLOT DATE: 5/8/2015 |
| PROJECT LEADER: J. BYATT | DRAWN BY: M. SMITH |
| DESIGNED BY: J. FRENCH | CHECKED BY: J. BYATT |
| ABUTMENT 2 PILE CAP PLAN AND ELEVATION | SHEET 45 OF 79 |

CLD 12-0120 MODEL: PILE CAP 2

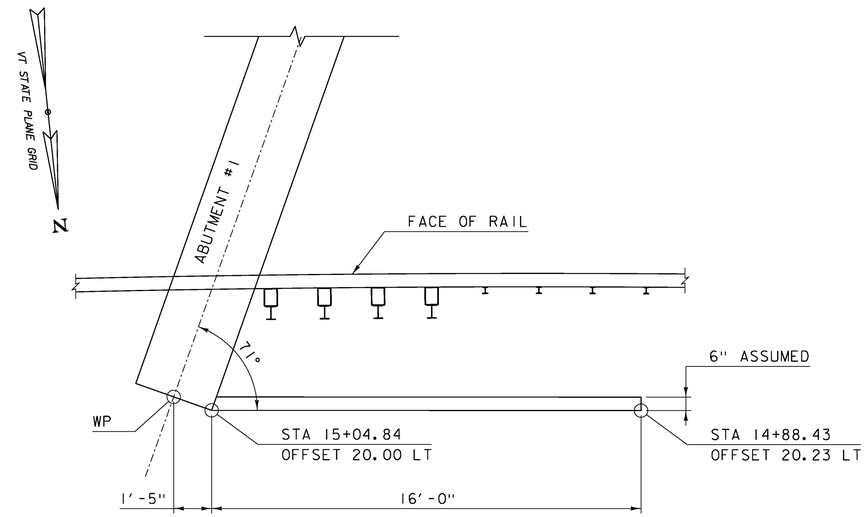



WINGWALL 1 PLAN VIEW

SCALE: 3/8" = 1'-0"

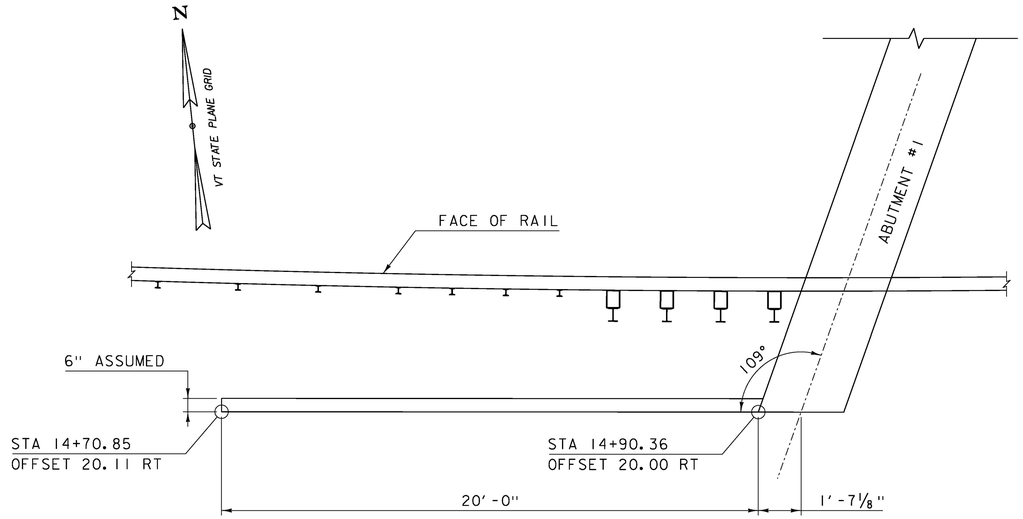



WINGWALL 2 PLAN VIEW

SCALE: 3/8" = 1'-0"

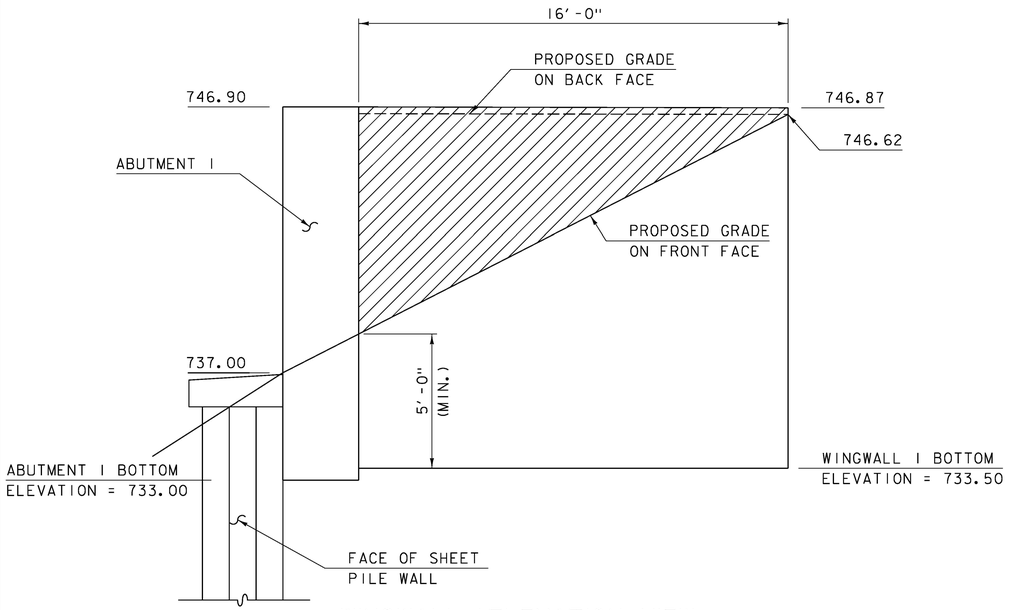


WINGWALL 1 ELEVATION VIEW

SCALE: 3/8" = 1'-0"

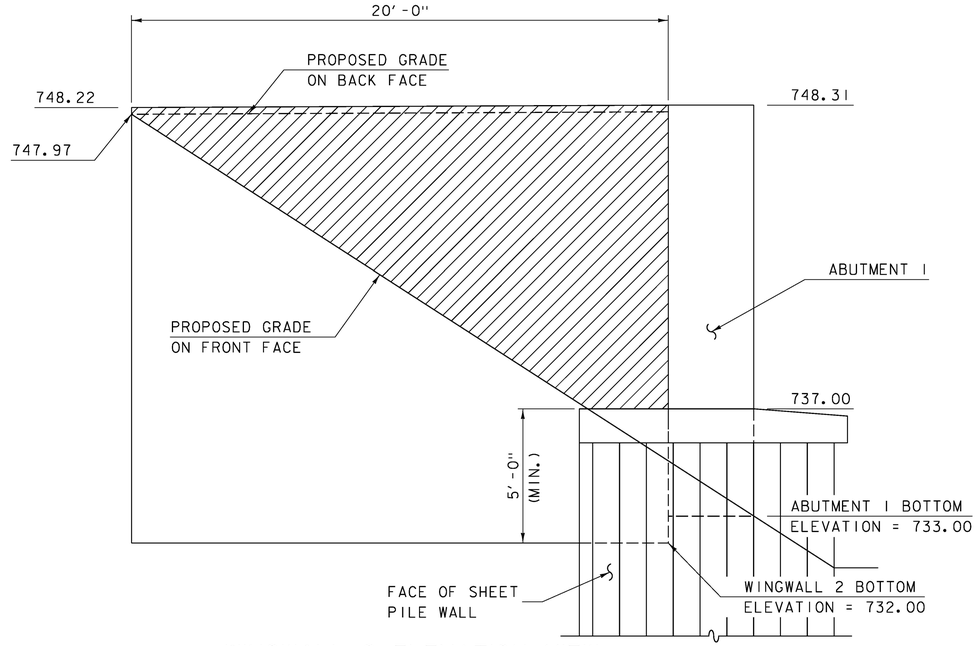



WINGWALL 2 ELEVATION VIEW

SCALE: 3/8" = 1'-0"

PAY LIMITS OF 900.670
"SPECIAL PROVISION
(RETAINING WALL)"


| | |
|---|---|
| PROJECT NAME: | STOWE |
| PROJECT NUMBER: | BRF 0235(15) |
| FILE NAME: z88c190sub.dgn | PLOT DATE: 5/8/2015 |
| PROJECT LEADER: J. BYATT | DRAWN BY: M. SMITH |
| DESIGNED BY: J. FRENCH | CHECKED BY: J. BYATT |
| WINGWALL PLAN AND ELEVATION (1 OF 2) | SHEET 46 OF 79 |

CLD 12-0120 MODEL: WINGWALL 1 AND 2

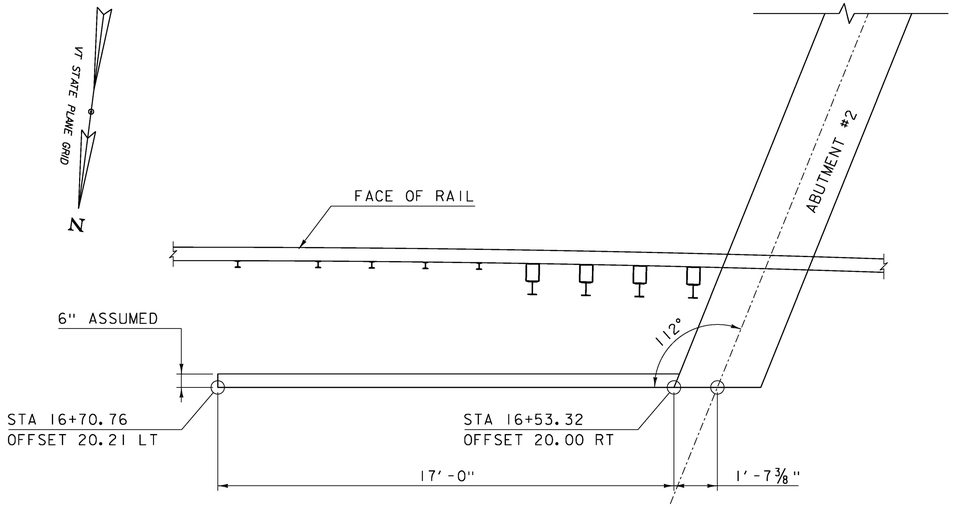



## WINGWALL 3 PLAN VIEW

SCALE: ⅜" = 1'-0"

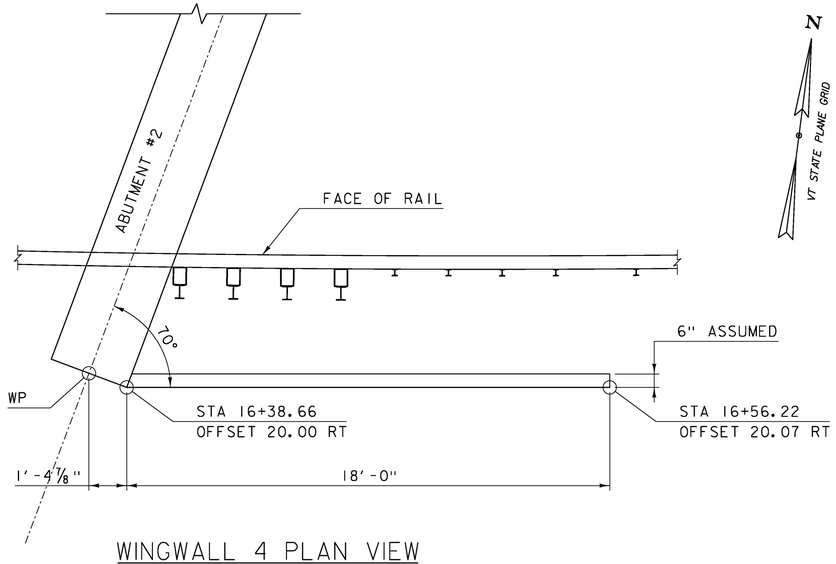



## WINGWALL 4 PLAN VIEW

SCALE: ⅜" = 1'-0"

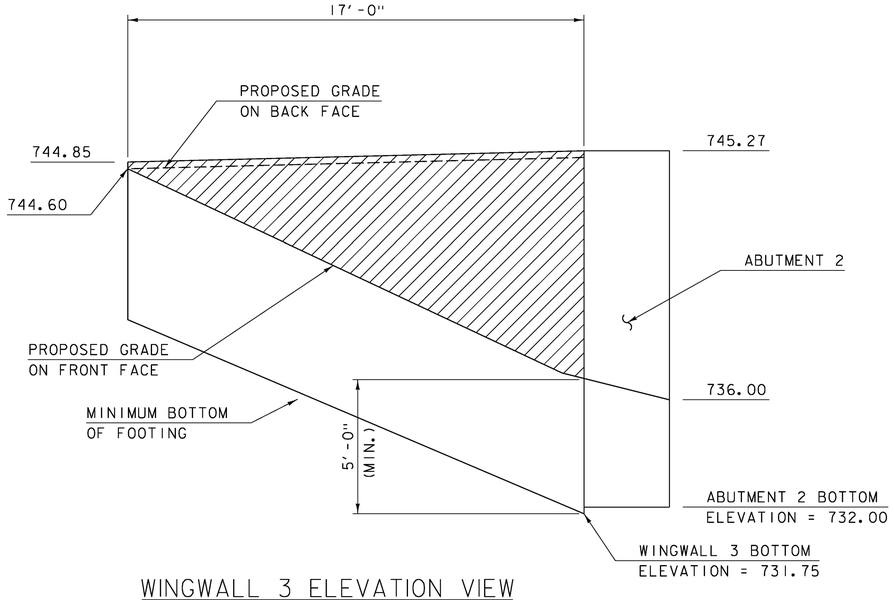


## WINGWALL 3 ELEVATION VIEW

SCALE: ⅜" = 1'-0"

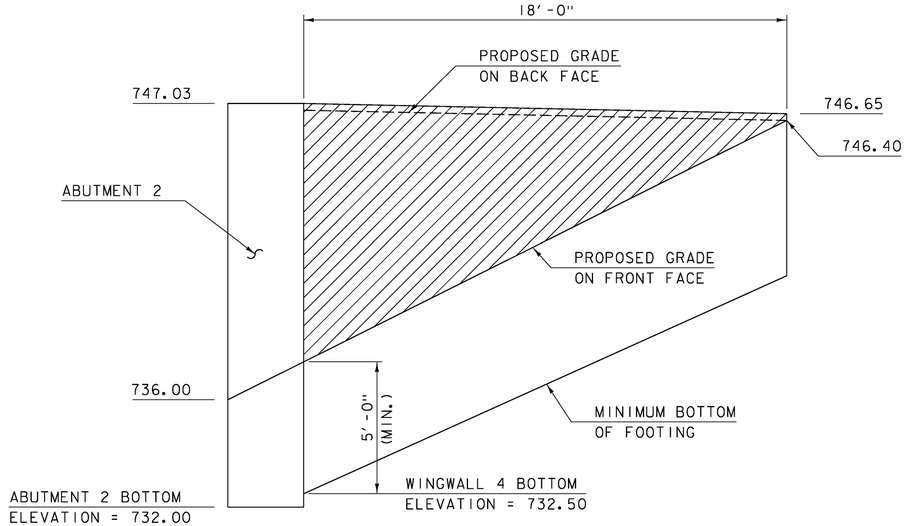


## WINGWALL 4 ELEVATION VIEW


SCALE: ⅜" = 1'-0"

PAY LIMITS OF 900.670
"SPECIAL PROVISION
(RETAINING WALL)"

CLD 12-0120 MODEL: WINGWALL 3 AND 4


| | |
|---|---|
| PROJECT NAME: | STOWE |
| PROJECT NUMBER: | BRF 0235(15) |
| FILE NAME: z88cl90sub.dgn | PLOT DATE: 5/8/2015 |
| PROJECT LEADER: J. BYATT | DRAWN BY: M. SMITH |
| DESIGNED BY: J. FRENCH | CHECKED BY: J. BYATT |
| WINGWALL PLAN AND ELEVATION (2 OF 2) | SHEET 47 OF 79 |

CLD CONSULTING ENGINEERS

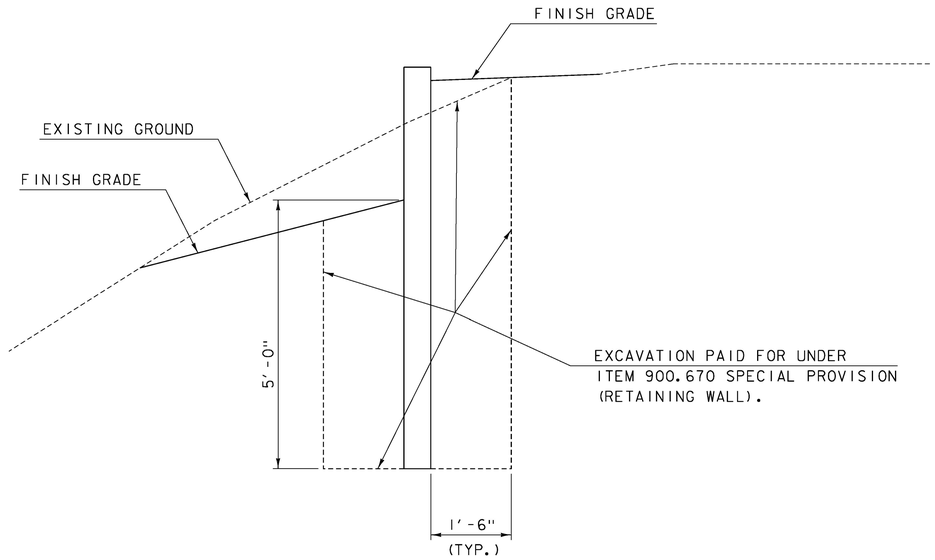


TYPICAL WINGWALL EXCAVATION DETAIL

SCALE: 3/8" = 1'-0"

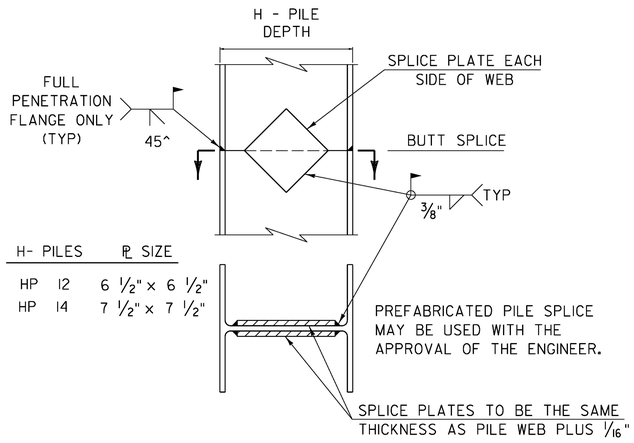


DETAIL OF PILE SPLICE

SCALE: 3/8" = 1'-0"

## NOTES:

1. ALL WINGWALLS SHALL BE SELECTED FROM THE LIST OF WALLS ON THE APPROVED RETAINING WALL DOCUMENT AVALABLE FROM VAOT MATERIALS & RESEARCH WEB SITE. THE RETAINING WALL SHALL HAVE CONCRETE FACING.

2. THE WALL SHALL BE PAID FOR UNDER ITEM 900.670 "SPECIAL PROVISION (RETAINING WALL)".

3. THE BOTTOM OF WALL SHALL BE A MINIMUM OF 5 FEET BELOW THE FINISH GRADE IN THE FRONT OF WALL.

4. THE WALL SHALL BE DESIGNED IN ACCORDANCE WITH 2012 AASHTO LRFD BRIDGE DESIGN SPECIFICATIONS AND ITS LATEST REVISIONS. THE DESIGN SHALL INCLUDE THE EFFECT OF ALL LOADS INCLUDING BUT NOT LIMITED TO LIVE LOAD, VEHICLE IMPACT ON ADJACENT GUARDRAIL AND POSTS, EARTH SURCHARGE, AND HYDROSTATIC PRESSURE.

5. THE TYPE OF WALL SELECTED SHALL BE COMPATIBLE WITH ADJACENT OBSTRUCTIONS SUCH AS GUARD RAIL POSTS. ANY CHANGES TO THE REINFORCING OR ANCHORING SYSTEM SHALL BE DETAILED IN THE FABRICATION DRAWINGS.

6. THE FOLLOWING SOIL PROPERTIES SHALL BE USED IN THE DESIGN OF THE WINGWALLS:

| | |
|---|---|
| FOUNDATION SOIL DESIGN VALUES | |
| NOMINAL BEARING RESISTANCE: | 13.5 KSF |
| FOUNDATION SOIL PARAMETERS | |
| UNIT WEIGHT: | 115 PCF |
| FRICTION ANGLE: | 34° |
| GRANULAR BACKFILL FOR STRUCTURES | |
| UNIT WEIGHT: | 140 PCF |
| FRICTION ANGLE: | 34° |
| ACTIVE EARTH PRESSURE COEFFICENT, Ka | 0.28 |
| BEARING RESISTANCE FACTORS (STRENGTH LIMIT STATE) | 0.45 |
| SLIDING RESISTANCE FACTORS | |
| MSEW: | 1.0 |
| GRAVITY/SEMI-GRAVITY (PROPRIETARY SYSTEM): | 1.0 |
| NON-GRAVITY CANTILEVERED AND ANCHORED: | 0.8 |
| GEOSYNTHETIC RESISTANCE FACTORS (IF APPLICABLE) | |
| TENSILE RESISTANCE OF GEOSYNTHETIC REINFORCEMENT AND CONNECTORS: | 0.9 |
| PULLOUT RESISTANCE OF TENSILE REINFORCEMENT: | 0.9 |

7. THE INTERFACE BETWEEN THE WINGWALL AND THE ABUTMENT STEM SHALL BE DESIGNED TO ALLOW 0.74 INCHES OF MOVEMENT. A JOINT DETAIL SHALL BE SUBMITTED TO THE PROJECT MANAGER FOR REVIEW AND APPROVAL. ALL COMPONENTS SHALL BE INCLUDED IN THE UNIT PRICE FOR ITEM 900.670 SPECIAL PROVISION (RETAINING WALL).


8. WATER REPELLENT, SILANE, SHALL BE APPLIED TO ALL EXPOSED CONCRETE SURFACES TO 1' BELOW GRADE. PAYMENT SHALL BE INCIDENTAL TO CONTRACT ITEM 900.670.

CLD 12-0120 MODEL: Pile Details

PROJECT NAME: STOWE
PROJECT NUMBER: BRF 0235(15)


FILE NAME: z88cl90sub.dgn
PROJECT LEADER: J. BYATT
DESIGNED BY: J. FRENCH
WINGWALL AND PILE DETAILS

PLOT DATE: 5/8/2015
DRAWN BY: M. SMITH
CHECKED BY: J. BYATT
SHEET 48 OF 79

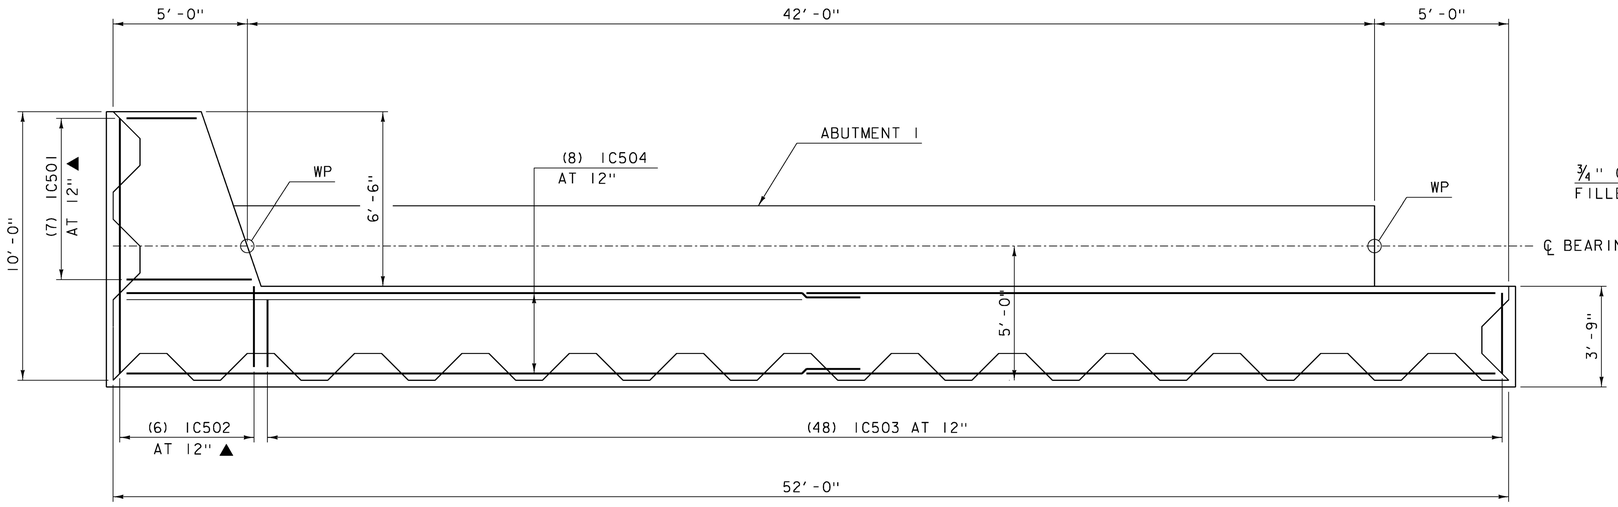



## SHEET PILE RETAINING WALL PLAN

SCALE: 3/8" = 1'-0"

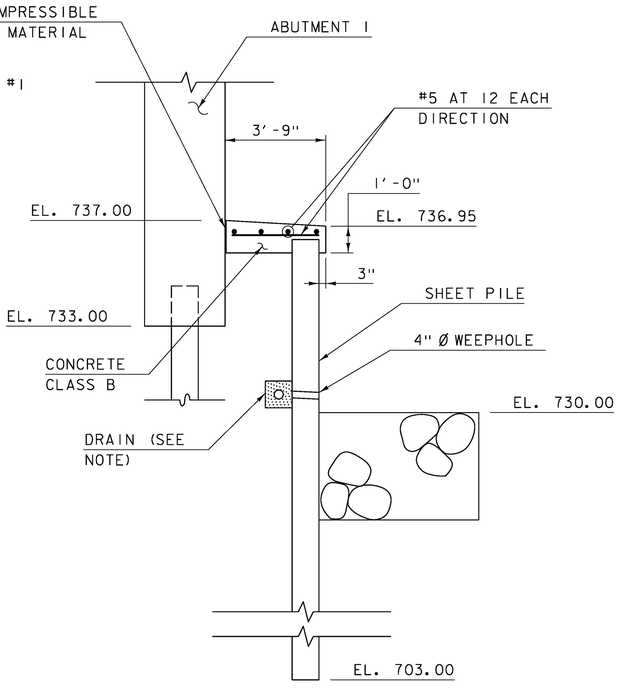


## SECTION A-A
## PERMANENT STEEL SHEET PILING WALL SECTION

SCALE: 3/8" = 1'-0"

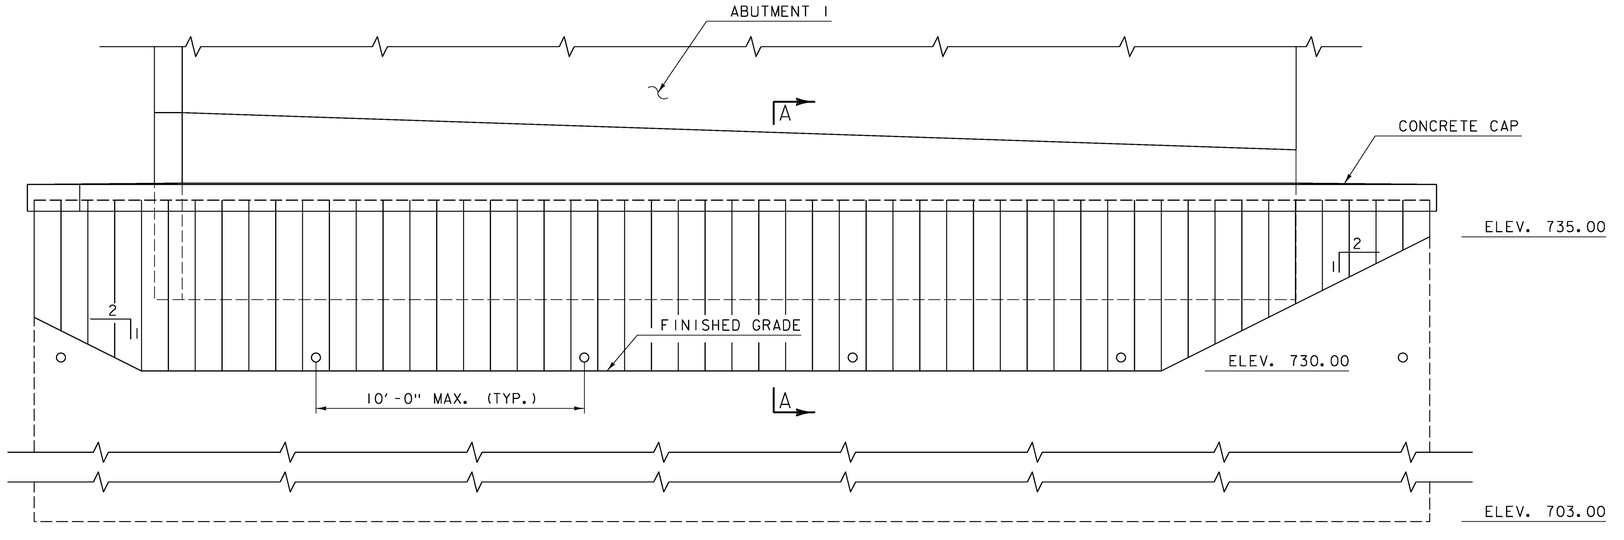


NOTE: SEE WINGWALL ELEVATIONS ON SHEET 46 FOR ADDITIONAL INFORMATION.

## SHEET PILE RETAINING WALL ELEVATION


SCALE: 3/8" = 1'-0"

NOTES:
1. PAYMENT FOR PERMANENT STEEL SHEET PILING SHALL BE UNDER ITEM 505.35.
2. DRAIN SHALL CONSIST OF A 4" PERFORATED PIPE WITHIN A 12" ZONE OF 3/4" STONE WITH GEOTEXTILE. PAYMENT WILL BE INCIDENTAL TO ITEM 505.35.

CONSULTING ENGINEERS


| | |
|---|---|
| PROJECT NAME: STOWE | |
| PROJECT NUMBER: BRF 0235(15) | |
| FILE NAME: z88cl90sub.dgn | PLOT DATE: 5/8/2015 |
| PROJECT LEADER: J. BYATT | DRAWN BY: M. SMITH |
| DESIGNED BY: J. FRENCH | CHECKED BY: J. BYATT |
| SHEET PILE RETAINING WALL DETAILS | SHEET 49 OF 79 |

CLD 12-020 MODEL: Sheet Pile Wall

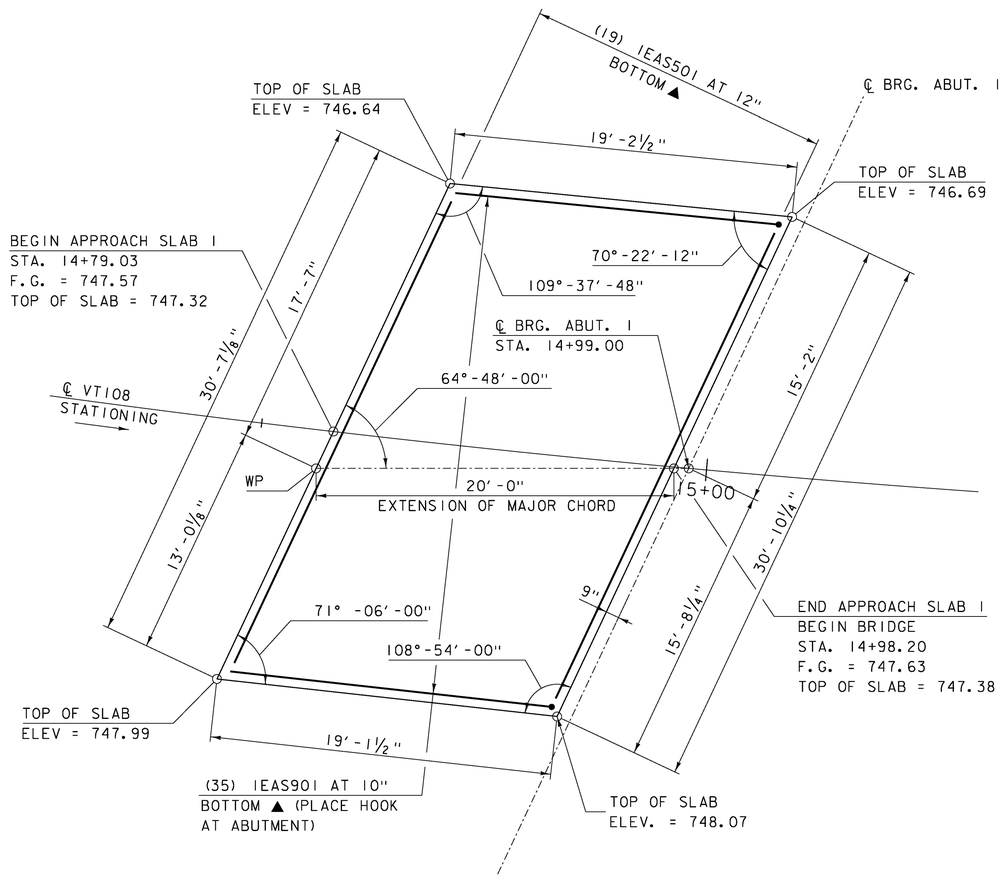



## APPROACH SLAB 1 LAYOUT

SCALE: ¼" = 1'-0"

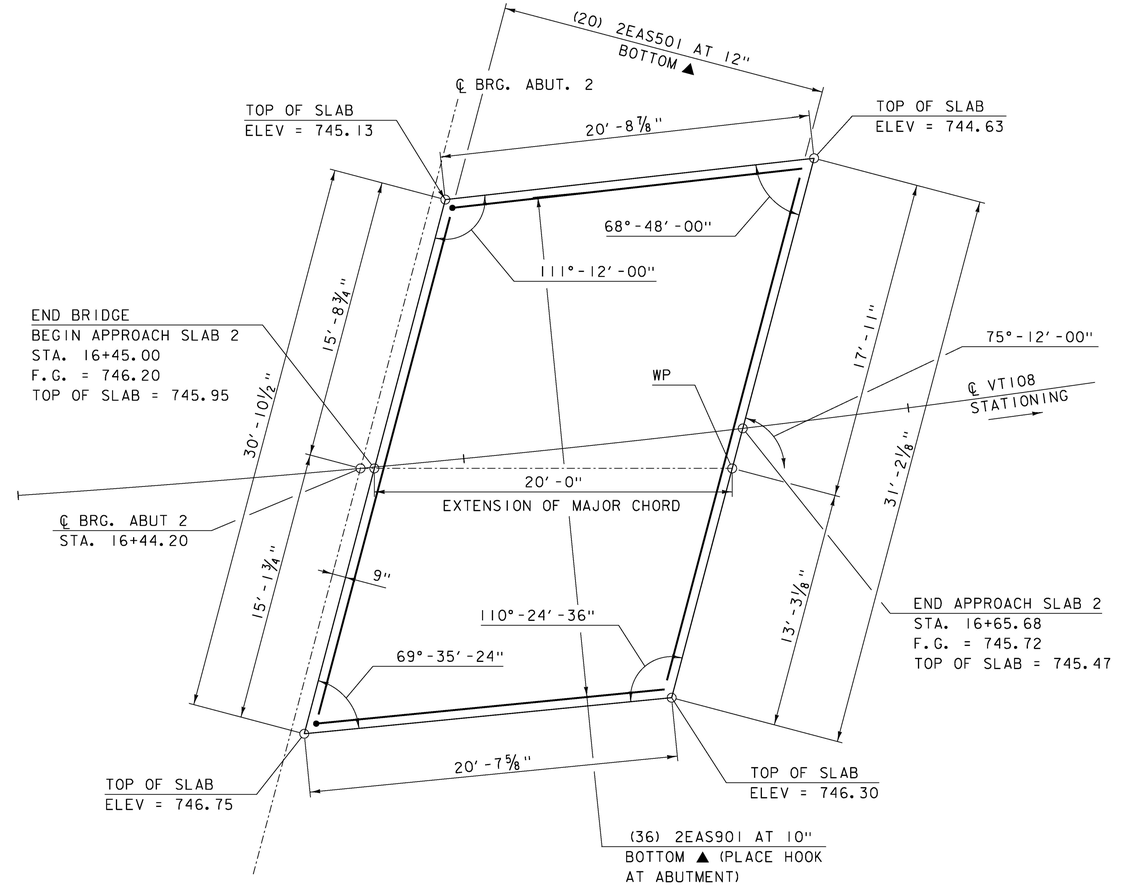


## APPROACH SLAB 2 LAYOUT

SCALE: ¼" = 1'-0"

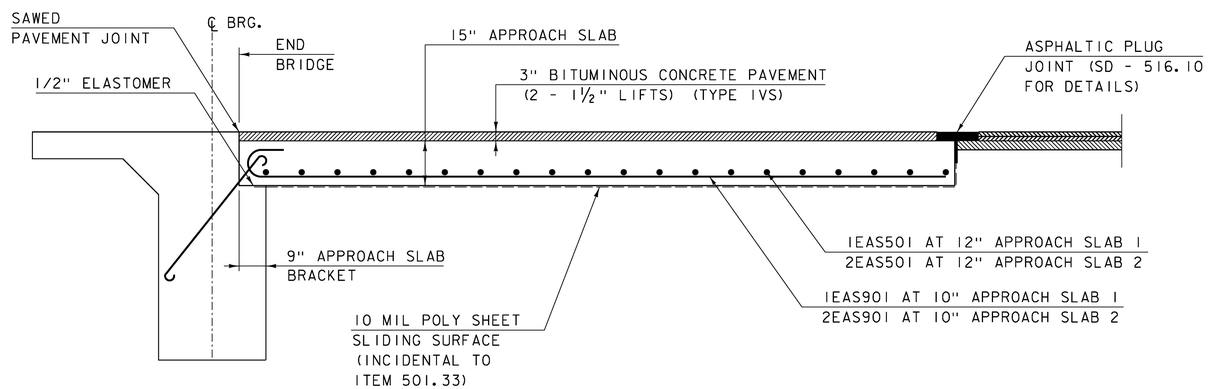


## TYPICAL APPROACH SLAB

SCALE: ½" = 1'-0"

| | |
|---|---|
| PROJECT NAME: | STOWE |
| PROJECT NUMBER: | BRF 0235(15) |
| FILE NAME: z88cl90sup.dgn | PLOT DATE: 5/8/2015 |
| PROJECT LEADER: J. BYATT | DRAWN BY: M. SMITH |
| DESIGNED BY: J. FRENCH | CHECKED BY: J. BYATT |
| APPROACH SLAB DETAILS | SHEET 50 OF 79 |

CLD 12-0120 MODEL: Approach Slab


STATE OF VERMONT
AGENCY OF TRANSPORTATION

# REINFORCING STEEL SCHEDULE

| ITEM | EACH | SIZE | LENGTH | MARK | TYPE | A | B | C | D | E | F | G | H | J | K | R | O |
|---|---|---|---|---|---|---|---|---|---|---|---|---|---|---|---|---|---|
| | **DECK** | | | | | | | | | | | | | | | | |
| | 210 | 5 | 39'- 9" | S501.2 | STR | 39'- 9" | | | | | | | | | | | |
| ✳ ▲ | 183 | 5 | 34'- 11" | S502.2 | STR | 34'- 11" | | | | | | | | | | | |
| ✳ ▲ | 274 | 5 | 30'- 11" | S503.2 | STR | 30'- 11" | | | | | | | | | | | |
| | 546 | 6 | 4'- 6" | S601.2 | 22 | | 2'- 6" | 2'- 0" | 0'- 0" | | | | 0'- 2" | 0'- 0" | 2'- 6" | 0'- 0" | |
| ✳ | 75 | 7 | 20'- 0" | S701.2 | STR | 20'- 0" | | | | | | | | | | | |
| | **ABUTMENT #1** | | | | | | | | | | | | | | | | |
| | 354 | 4 | 3'- 7" | 1A401 | 16 | 0'- 6" | 2'- 7" | 0'- 0" | 0'- 6" | | | | 0'- 4" | | 0'- 4" | | |
| ✳ | 25 | 5 | 21'- 11" | 1A501 | STR | 21'- 11" | | | | | | | | | | | |
| | 51 | 5 | 6'- 11" | 1A502 | 17 | | 2'- 2" | 2'- 7" | 2'- 2" | | | | | | | | |
| | 8 | 5 | 7'- 1" | 1A503 | 14 | 2'- 2" | 0'- 0" | 0'- 0" | 2'- 9" | 2'- 2" | | | 0'- 10" | | 2'- 5" | | |
| | 16 | 6 | 22'- 2" | 1A601 | STR | 22'- 2" | | | | | | | | | | | |
| | 330 | 4 | 3'- 7" | 1A401.2 | 16 | 0'- 6" | 2'- 7" | 0'- 0" | 0'- 6" | | | | 0'- 4" | | 0'- 4" | | |
| ✳ | 15 | 5 | 22'- 2" | 1A501.2 | STR | 22'- 2" | | | | | | | | | | | |
| | 31 | 5 | 3'- 5" | 1A502.2 | 17 | | 2'- 2" | 1'- 3" | 0'- 0" | | | | | | | | |
| | 9 | 5 | 7'- 1" | 1A503.2 | 14 | 2'- 2" | 0'- 0" | 0'- 0" | 2'- 9" | 2'- 2" | | | 0'- 10" | | 2'- 5" | | |
| | 32 | 5 | 5'- 8" | 1A504.2 | 1 | 0'- 11" | 3'- 10" | | | | | 0'- 11" | | 0'- 5" | | | |
| | 34 | 5 | 6'- 0" | 1A505.2 | 22 | | 3'- 6" | 2'- 6" | 0'- 0" | | | | 2'- 6" | | 2'- 6" | | |
| | 12 | 5 | 9'- 7" | 1A506.2 | 17 | | 3'- 6" | 2'- 7" | 3'- 6" | | | | | | | | |
| | 35 | 5 | 10'- 0" | 1A507.2 | STR | 10'- 0" | | | | | | | | | | | |
| | 9 | 5 | 6'- 11" | 1A508.2 | 17 | 6'- 11" | | | | | | | | | | | |
| | 114 | 7 | 13'- 4" | 1A701.2 | 17 | | 2'- 7" | 10'- 9" | 0'- 0" | | | | | | | | |
| | 114 | 7 | 6'- 3" | 1A702.2 | STR | 6'- 3" | | | | | | | | | | | |
| ✳ | 35 | 7 | 11'- 0" | 1A703.2 | 17 | | 7'- 6" | 3'- 6" | 0'- 0" | | | | | | | | |
| | **ABUTMENT #2** | | | | | | | | | | | | | | | | |
| | 354 | 4 | 3'- 7" | 2A401 | 16 | 0'- 6" | 2'- 7" | 0'- 0" | 0'- 6" | | | | 0'- 4" | | 0'- 4" | | |
| | 24 | 5 | 21'- 11" | 2A501 | STR | 21'- 11" | | | | | | | | | | | |
| | 51 | 5 | 6'- 11" | 2A502 | 17 | | 2'- 2" | 2'- 7" | 2'- 2" | | | | | | | | |
| | 8 | 5 | 7'- 1" | 2A503 | 14 | 2'- 2" | 0'- 0" | 0'- 0" | 2'- 9" | 2'- 2" | | | 0'- 11" | | 2'- 5" | | |
| ✳ | 17 | 6 | 22'- 2" | 2A601 | STR | 22'- 2" | | | | | | | | | | | |
| | 330 | 4 | 3'- 7" | 2A401.2 | 16 | 0'- 6" | 2'- 7" | 0'- 0" | 0'- 6" | | | | 0'- 4" | | 0'- 4" | | |
| | 14 | 5 | 22'- 2" | 2A501.2 | STR | 22'- 2" | | | | | | | | | | | |
| | 31 | 5 | 3'- 5" | 2A502.2 | 17 | | 2'- 2" | 1'- 3" | 0'- 0" | | | | | | | | |
| | 9 | 5 | 7'- 1" | 2A503.2 | 14 | 2'- 2" | 0'- 0" | 0'- 0" | 2'- 9" | 2'- 2" | | | 0'- 11" | | 2'- 5" | | |
| | 32 | 5 | 5'- 8" | 2A504.2 | 1 | 0'- 11" | 3'- 10" | | | | | 0'- 11" | | 0'- 5" | | | |
| | 34 | 5 | 6'- 0" | 2A505.2 | 22 | | 3'- 6" | 2'- 6" | 0'- 0" | | | | 2'- 6" | | 2'- 6" | | |
| | 12 | 5 | 9'- 7" | 2A506.2 | 17 | | 3'- 6" | 2'- 7" | 3'- 6" | | | | | | | | |
| | 35 | 5 | 10'- 0" | 2A507.2 | STR | 10'- 0" | | | | | | | | | | | |
| | 9 | 5 | 6'- 11" | 2A508.2 | 17 | 6'- 11" | | | | | | | | | | | |
| | 114 | 7 | 13'- 1" | 2A701.2 | 17 | | 2'- 7" | 10'- 6" | 0'- 0" | | | | | | | | |
| | 114 | 7 | 6'- 3" | 2A702.2 | STR | 6'- 3" | | | | | | | | | | | |
| | 34 | 7 | 11'- 0" | 2A703.2 | 17 | | 7'- 6" | 3'- 6" | 0'- 0" | | | | | | | | |
| | **APPROACH SLAB #1** | | | | | | | | | | | | | | | | |
| ▲ | 19 | 5 | 30'- 4" | 1EAS501 | STR | 30'- 4" | | | | | | | | | | | |
| ✳ ▲ | 36 | 9 | 20'- 2" | 1EAS901 | 1 | 1'- 6" | 18'- 8" | | | | | | | | 0'- 11" | | |
| | **APPROACH SLAB #2** | | | | | | | | | | | | | | | | |
| ▲ | 20 | 5 | 30'- 8" | 2EAS501 | STR | 30'- 8" | | | | | | | | | | | |
| ▲ | 36 | 9 | 21'- 8" | 2EAS901 | 1 | 1'- 5" | 20'- 3" | | | | | | | | 0'- 11" | | |
| | **SHEET PILE CONCRETE CAP** | | | | | | | | | | | | | | | | |
| ▲ | 7 | 5 | 4'- 6" | 1C501 | STR | 4'- 6" | | | | | | | | | | | |
| ▲ | 6 | 5 | 9'- 6" | 1C502 | STR | 9'- 6" | | | | | | | | | | | |
| | 48 | 5 | 3'- 3" | 1C503 | STR | 3'- 3" | | | | | | | | | | | |
| | 8 | 5 | 27'- 1" | 1C504 | STR | 27'- 1" | | | | | | | | | | | |

## ~ NOTES ~

1. UNLESS OTHERWISE DESIGNATED, ALL BAR REINFORCEMENT FOR CONCRETE IN SIZES UP TO AND INCLUDING NO. 18 SHALL CONFORM TO THE REQUIREMENTS OF THE "SPECIFICATIONS FOR DEFORMED BILLET-STEEL BARS FOR CONCRETE REINFORCEMENT", AASHTO M 31 (ASTM A 615-SI). ALL BARS SHALL BE GRADE 60, UNLESS OTHERWISE DESIGNATED.
2. FOR TYPICAL BENDING DETAILS, RECOMMENDED PIN DIAMETER "D" OF BENDS AND HOOKS, AND OTHER STANDARD PRACTICE, SEE CURRENT CONCRETE REINFORCING STEEL INSTITUTE "MANUAL OF STANDARD PRACTICE".
3. BARS WHICH REQUIRE MORE ACCURATE BENDING THAN STANDARD PRACTICES SHOULD HAVE LIMITS INDICATED.
4. ALL DIMENSIONS ARE OUT TO OUT OF BAR EXCEPT "A" AND "G" ON STANDARD 180 DEGREE AND 135 DEGREE HOOKS.
5. "J" DIMENSION ON 180 DEGREE HOOKS TO BE SHOWN ONLY WHERE NECESSARY TO RESTRICT HOOK SIZE. OTHERWISE, STANDARD HOOKS ARE TO BE USED.
6. "H" DIMENSION ON STIRRUPS TO BE SHOWN ONLY WHEN NECESSARY TO MAINTAIN CLEARANCES.
7. WHERE SLOPE DIFFERS FROM 45 DEGREES, DIMENSIONS "H" AND "K" MUST BE SHOWN.
8. ▲ DENOTES BARS TO BE CUT IN FIELD.
9. ✳ DENOTES ONE EXTRA BAR ADDED FOR TESTING PURPOSES.
10. △ DENOTES TWO EXTRA BARS ADDED FOR TESTING PURPOSES.
11. E IN BAR MARK PREFIX DENOTES EPOXY COATED REINFORCING STEEL.

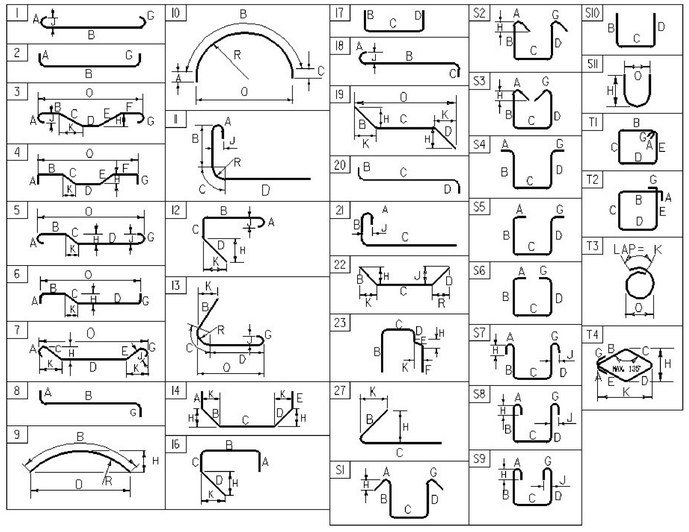


**ASTM STANDARD REINFORCING BARS**


| BAR SIZE DESIGNATION | WEIGHT POUNDS PER FOOT | NOMINAL DIMENSIONS ROUND SECTION | | |
|---|---|---|---|---|
| | | DIAMETER INCHES | AREA INCHES $^2$ | PERIMETER INCHES |
| #3 | 0.376 | 0.375 | 0.11 | 1.178 |
| #4 | 0.668 | 0.500 | 0.20 | 1.571 |
| #5 | 1.043 | 0.625 | 0.31 | 1.963 |
| #6 | 1.502 | 0.750 | 0.44 | 2.356 |
| #7 | 2.044 | 0.875 | 0.60 | 2.749 |
| #8 | 2.670 | 1.000 | 0.79 | 3.142 |
| #9 | 3.400 | 1.128 | 1.00 | 3.544 |
| #10 | 4.303 | 1.270 | 1.27 | 3.990 |
| #11 | 5.313 | 1.410 | 1.56 | 4.430 |
| #14 | 7.65 | 1.693 | 2.25 | 5.32 |
| #18 | 13.60 | 2.257 | 4.00 | 7.09 |

PROJECT NAME: **STOWE**
PROJECT NUMBER: **BRF 0235(15)**

FILE NAME: z88cl90schedule.dgn
PROJECT MANAGER: **J. BYATT**
DESIGNED BY: **A. GIRALDI**
**REINFORCING STEEL SCHEDULE SHEET**

PLOT DATE: **5/6/2015**
DRAWN BY: **M. SMITH**
CHECKED BY: **J. FRENCH**
SHEET 51 OF 79

MODEL: Schedule
CLD 12-0120

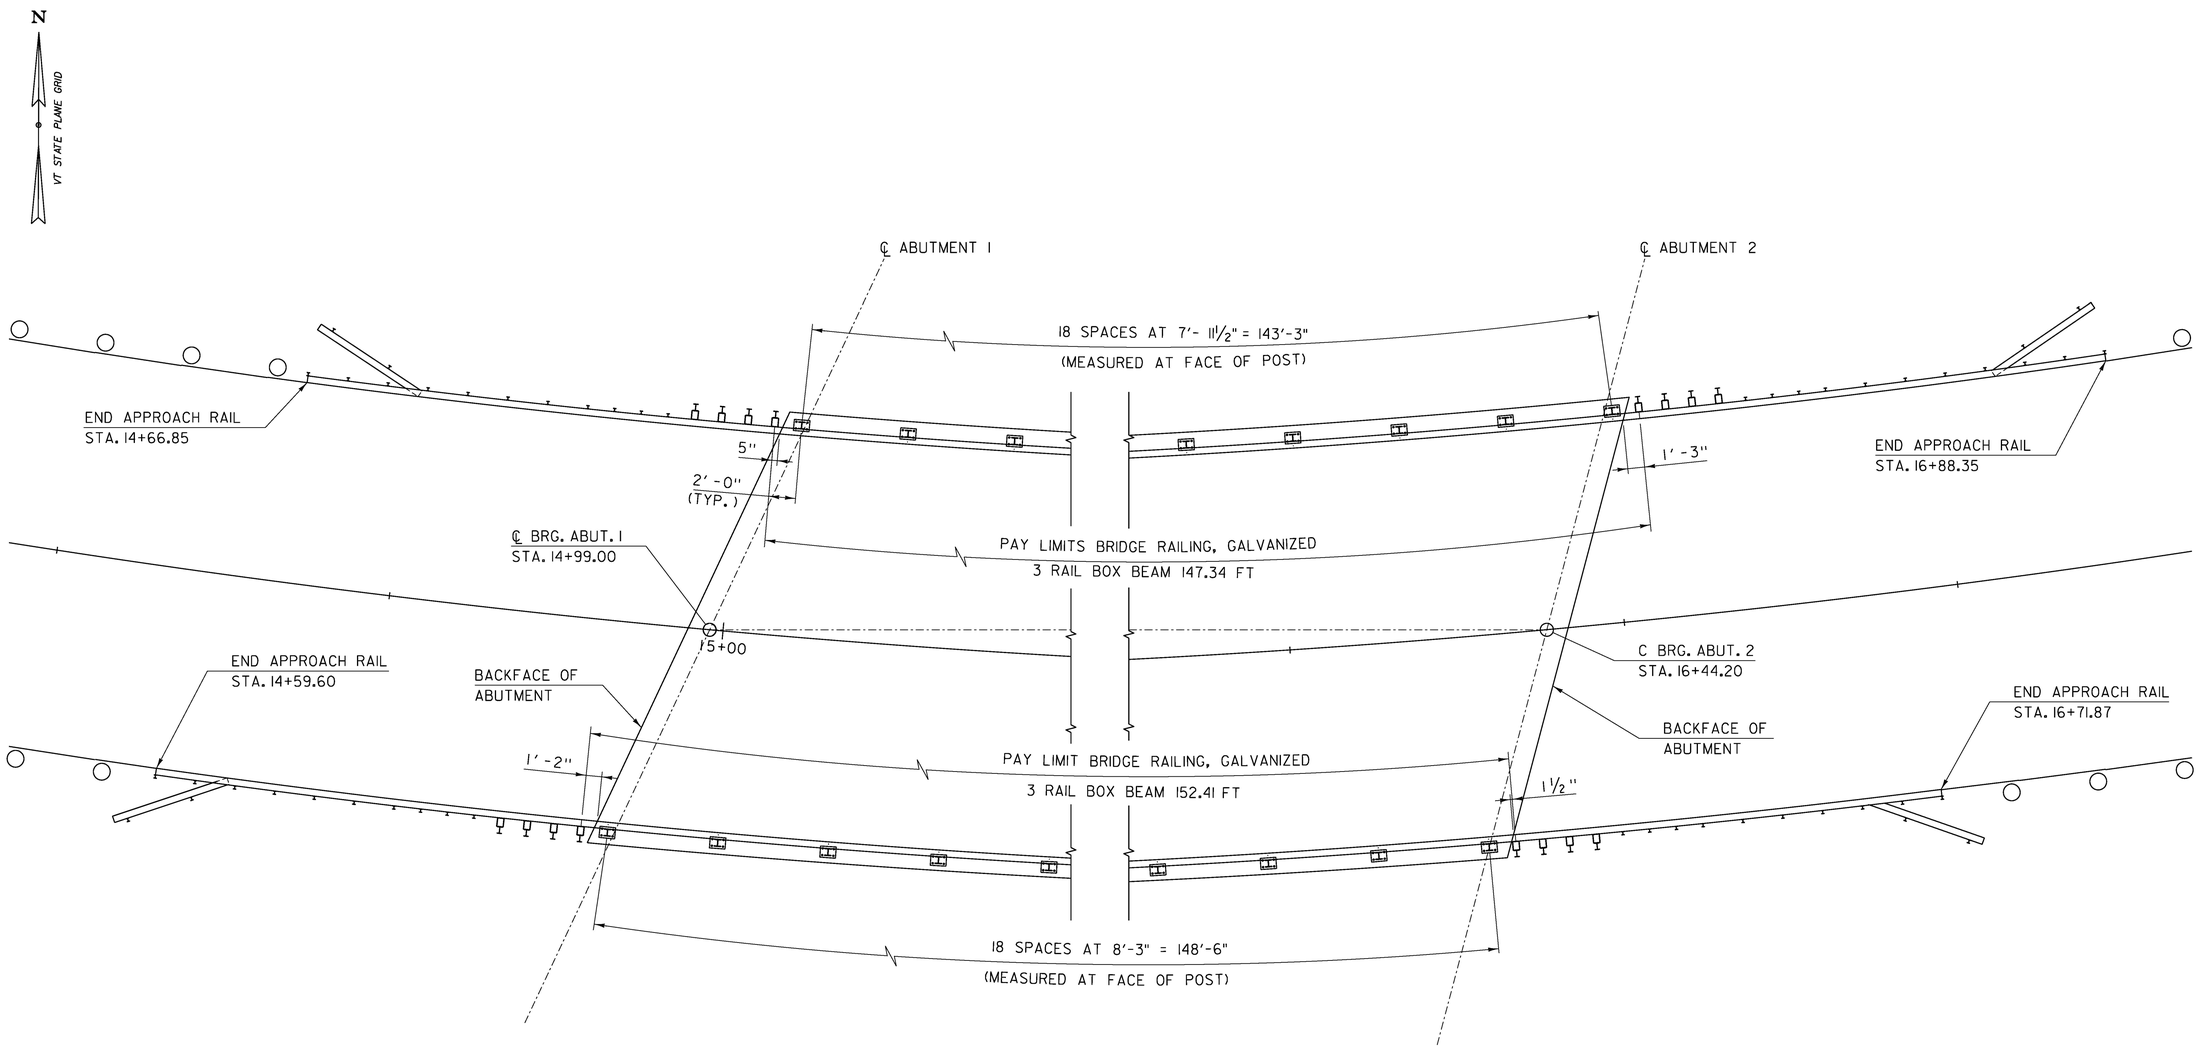



## BRIDGE RAIL LAYOUT

SCALE: 3/16" = 1'-0"


CLD 12-0120 MODEL: RailLayout

| | |
|---|---|
| PROJECT NAME: | STOWE |
| PROJECT NUMBER: | BRF 0235(15) |
| FILE NAME: z88c190rail.dgn | PLOT DATE: 5/8/2015 |
| PROJECT LEADER: J. BYATT | DRAWN BY: M. SMITH |
| DESIGNED BY: J. FRENCH | CHECKED BY: J. BYATT |
| BRIDGE RAIL LAYOUT | SHEET 52 OF 79 |


CLD CONSULTING ENGINEERS

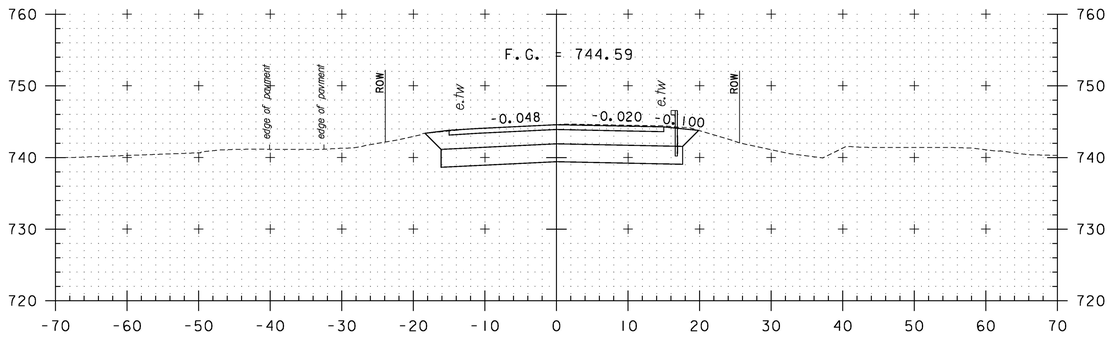



11+00
END APPROACH
BEGIN PROJECT

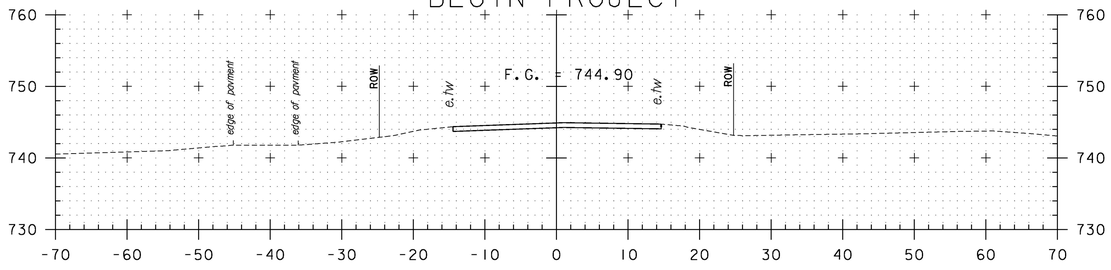



10+50

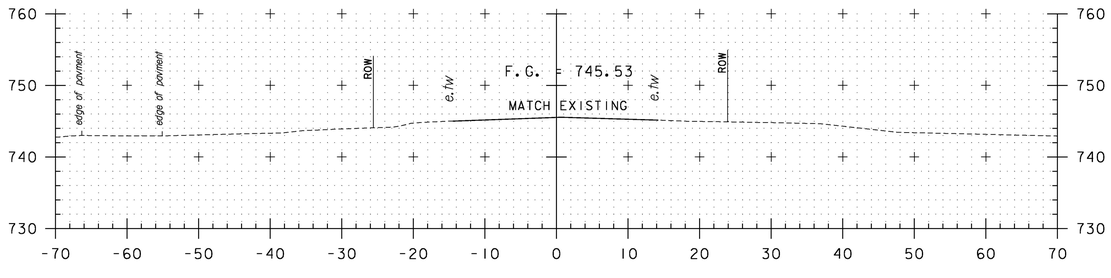



10+00
BEGIN APPROACH

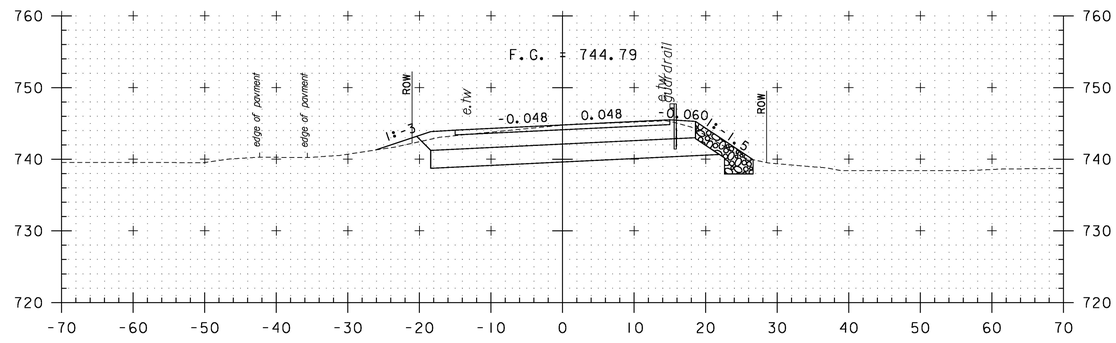


12+50

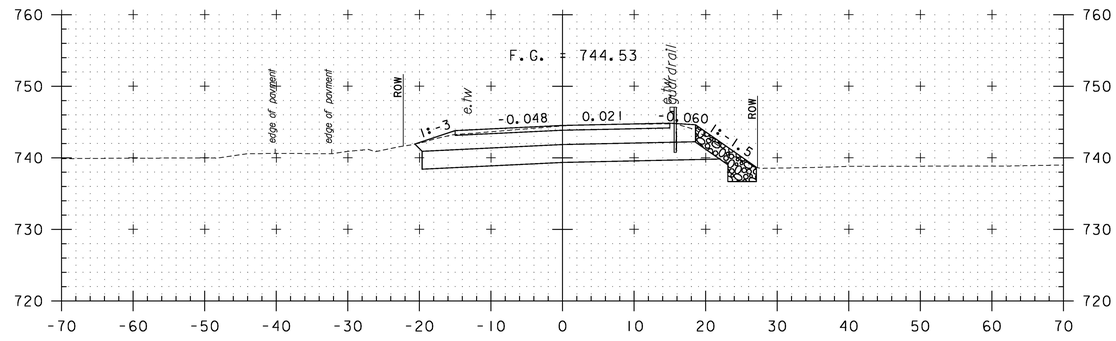


12+00

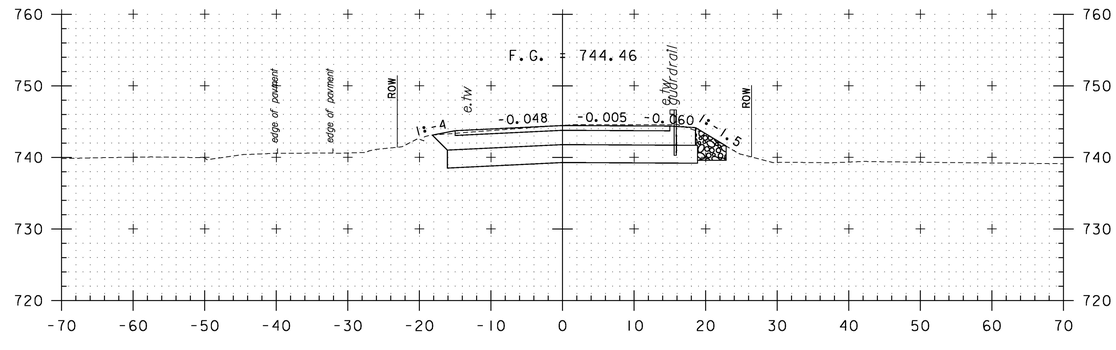


11+50


STA. 10+00 TO STA. 12+50

PROJECT NAME: STOWE
PROJECT NUMBER: BRF 0235(15)


FILE NAME: z88cl90xsl.dgn
PROJECT LEADER: J. BYATT
DESIGNED BY: K. RUTTER
VT 108 CROSS SECTIONS

PLOT DATE: 5/8/2015
DRAWN BY: K. RUTTER
CHECKED BY: C. GREGORY
SHEET 53 OF 79


CLD 12-0120 MODEL: VT108 XS 1

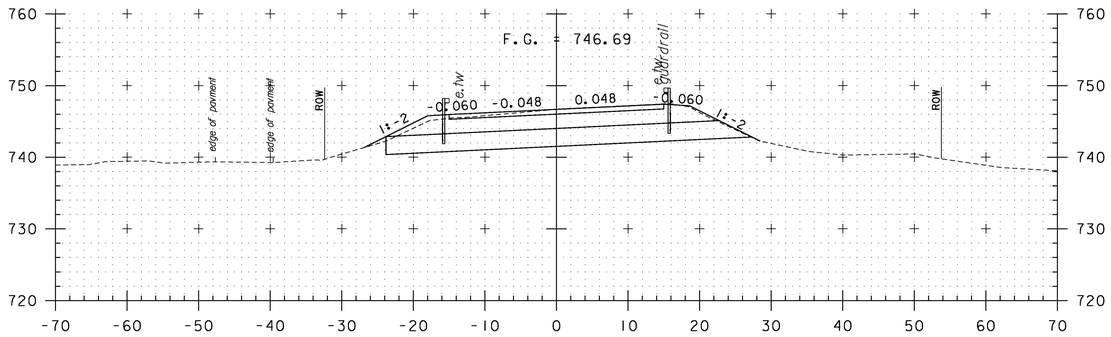



14+00

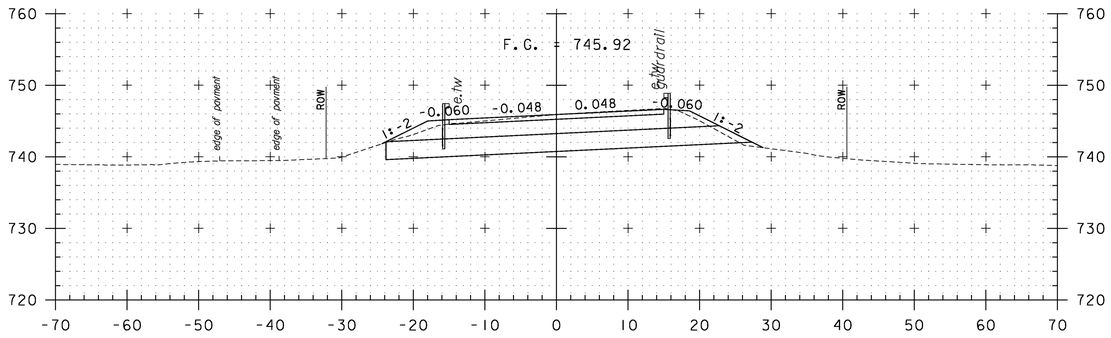



13+50

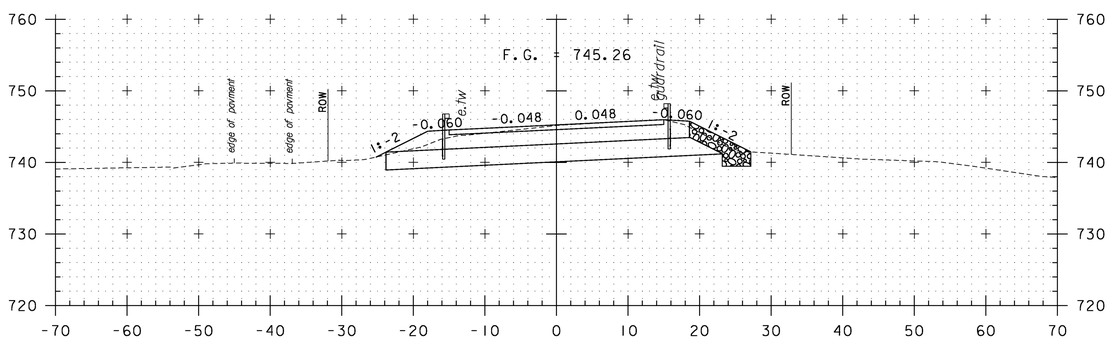


13+00

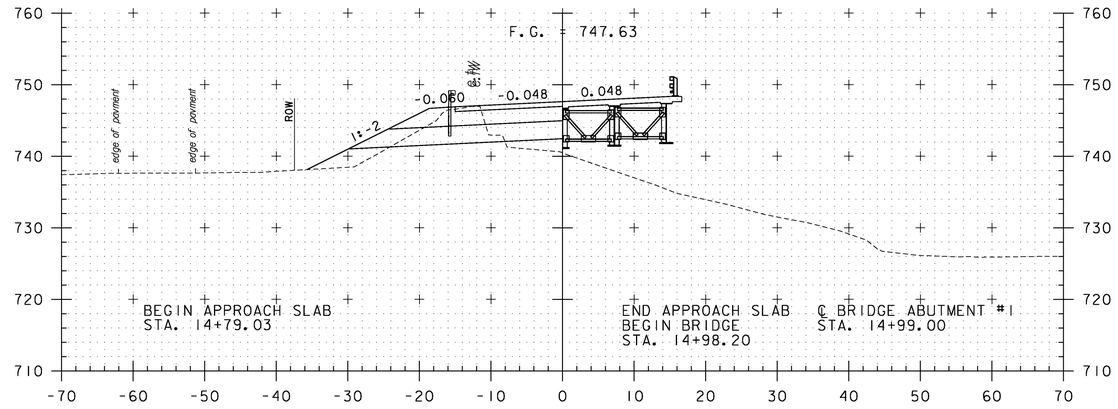


15+00

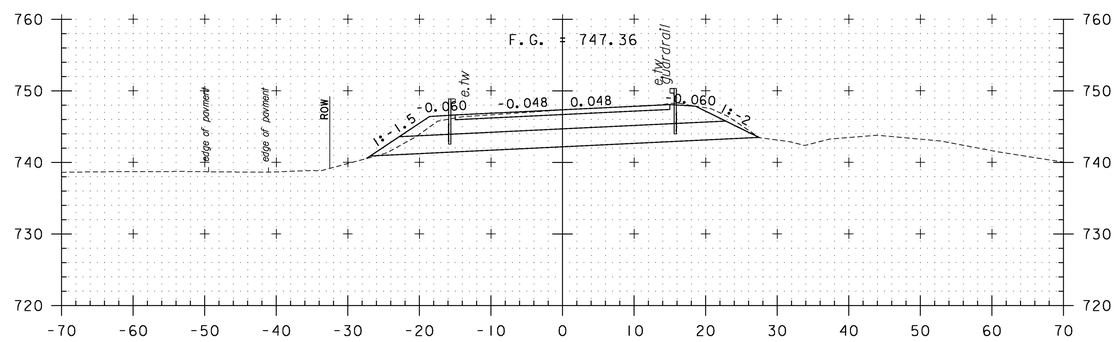


14+50


STA. 13+00 TO STA. 15+00

PROJECT NAME: STOWE
PROJECT NUMBER: BRF 0235(15)


FILE NAME: z88cl90xsl.dgn
PROJECT LEADER: J. BYATT
DESIGNED BY: K. RUTTER
VT 108 CROSS SECTIONS

PLOT DATE: 5/8/2015
DRAWN BY: K. RUTTER
CHECKED BY: C. GREGORY
SHEET 54 OF 79


CLD 12-0120 MODEL: VT108 XS 2

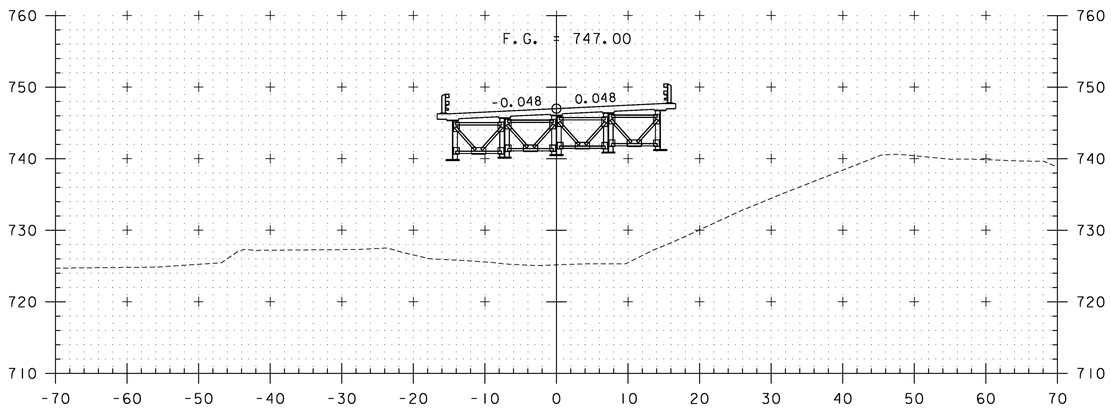



16+00

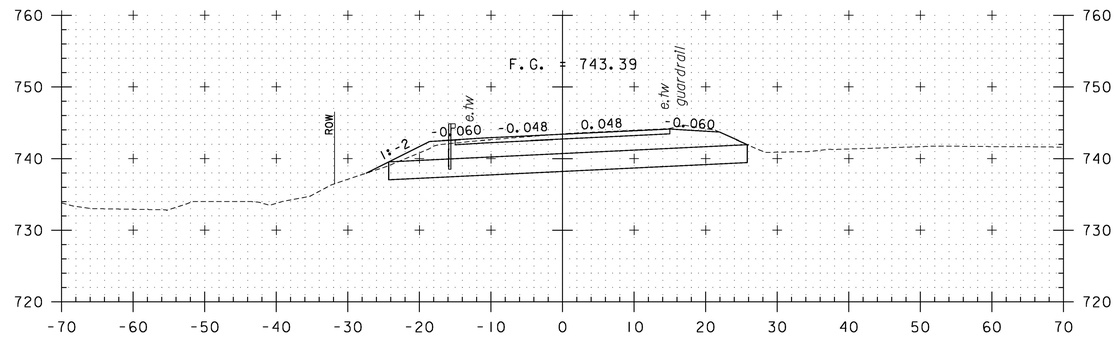



17+50

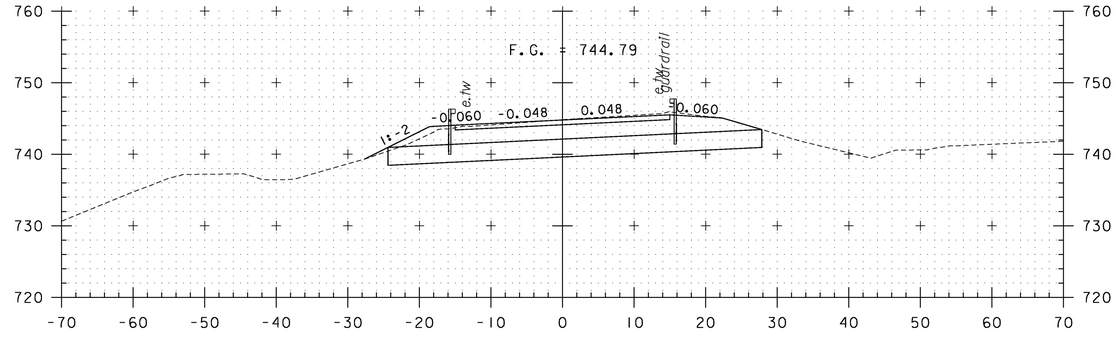


17+00

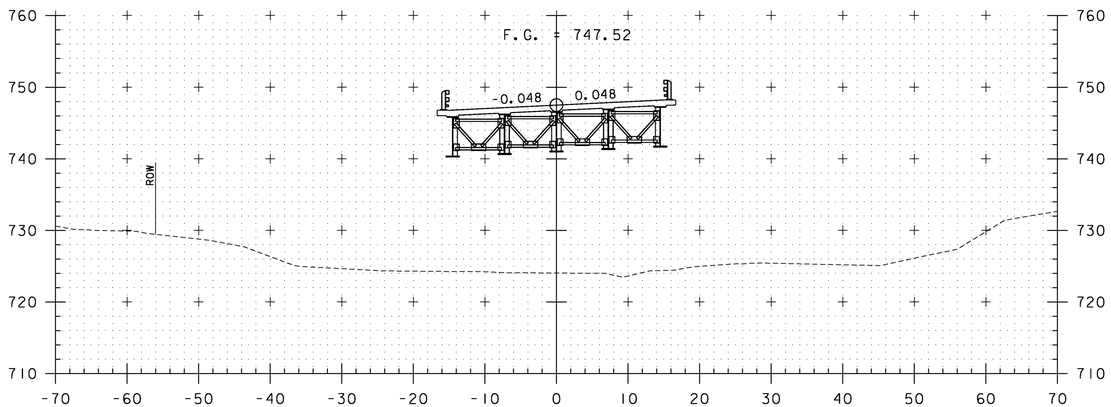


15+50

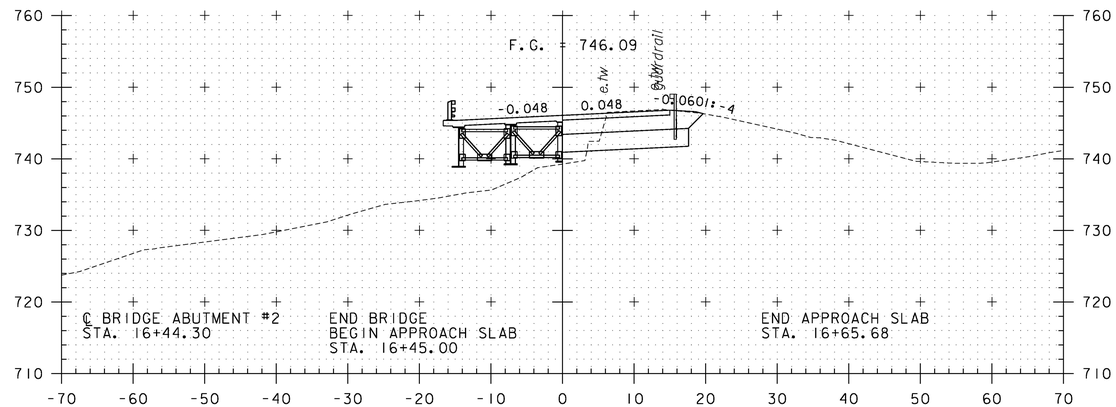



16+50

STA. 15+50 TO STA. 17+50


CLD 12-0020 MODEL: VT108 XS 3

| | |
|---|---|
| PROJECT NAME: | STOWE |
| PROJECT NUMBER: | BRF 0235(15) |
| FILE NAME: z88cl90xsl.dgn | PLOT DATE: 5/8/2015 |
| PROJECT LEADER: J. BYATT | DRAWN BY: K. RUTTER |
| DESIGNED BY: K. RUTTER | CHECKED BY: C. GREGORY |
| VT 108 CROSS SECTIONS | SHEET 55 OF 79 |


CONSULTING ENGINEERS

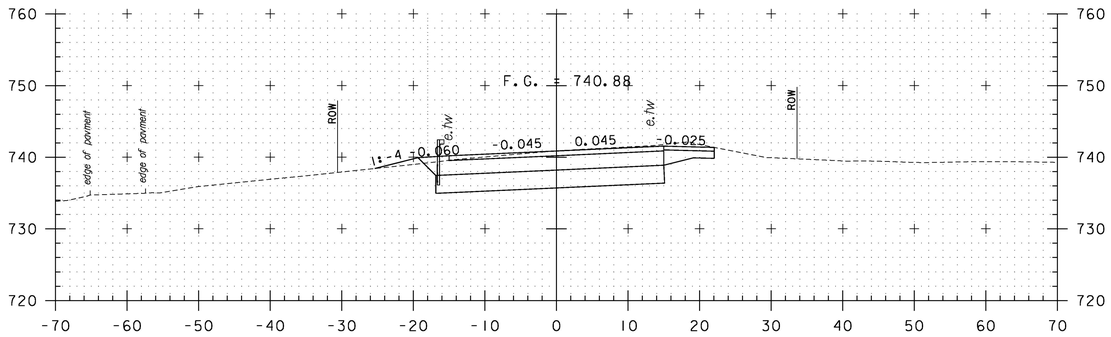



19+00

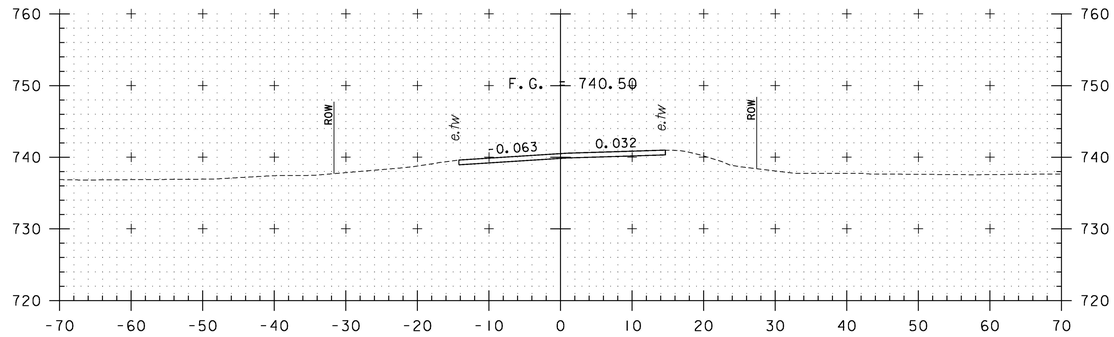



20+50

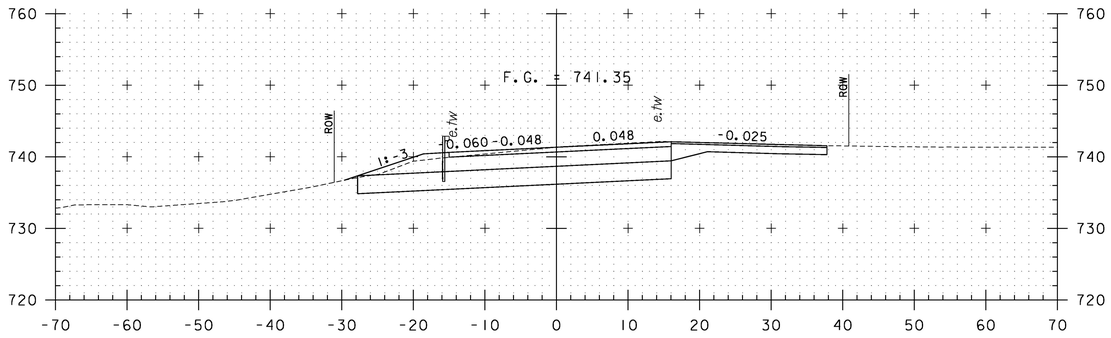



18+50

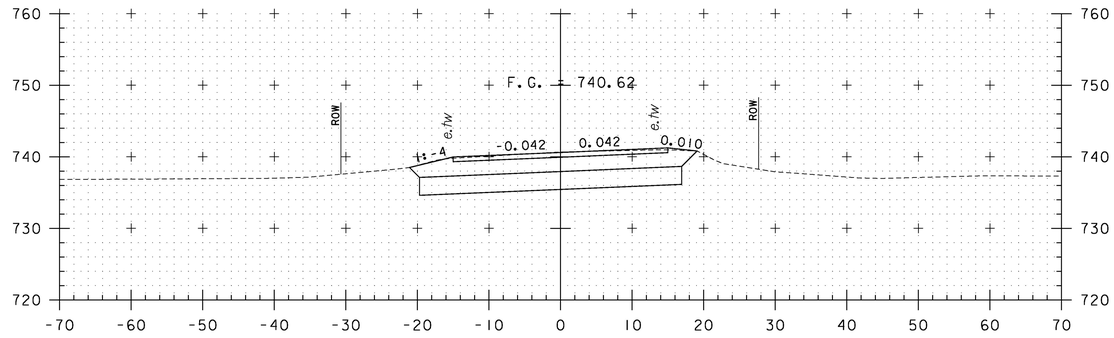


20+00
END PROJECT
BEGIN APPROACH

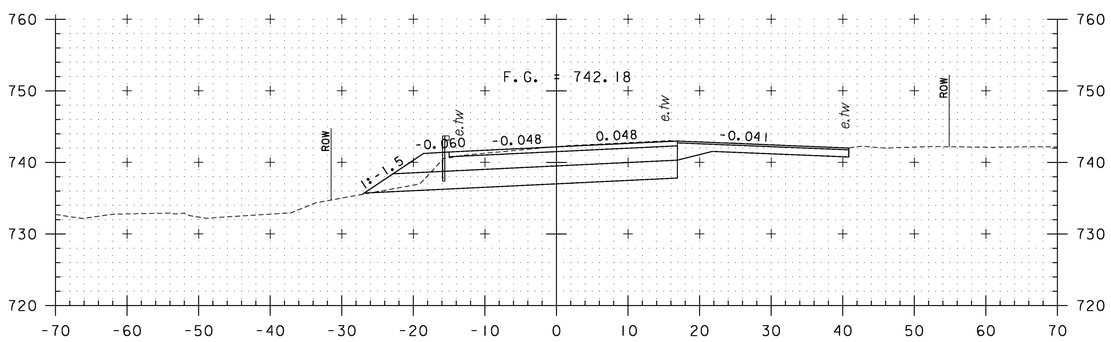


18+00

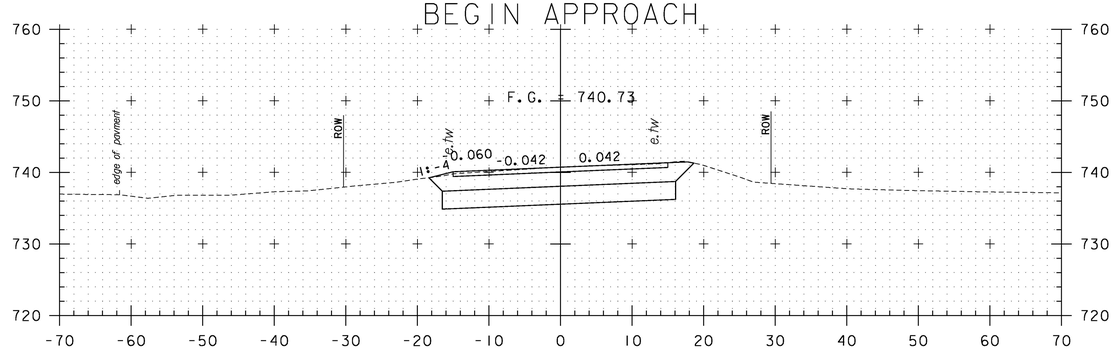



19+50

STA. 18+00 TO STA. 20+50


| | |
|---|---|
| PROJECT NAME: | STOWE |
| PROJECT NUMBER: | BRF 0235(15) |

| | |
|---|---|
| FILE NAME: z88c190xsl.dgn | PLOT DATE: 5/8/2015 |
| PROJECT LEADER: J. BYATT | DRAWN BY: K. RUTTER |
| DESIGNED BY: K. RUTTER | CHECKED BY: C. GREGORY |
| VT 108 CROSS SECTIONS | SHEET 56 OF 79 |


CLD 12-0120 MODEL: VT108 XS 4

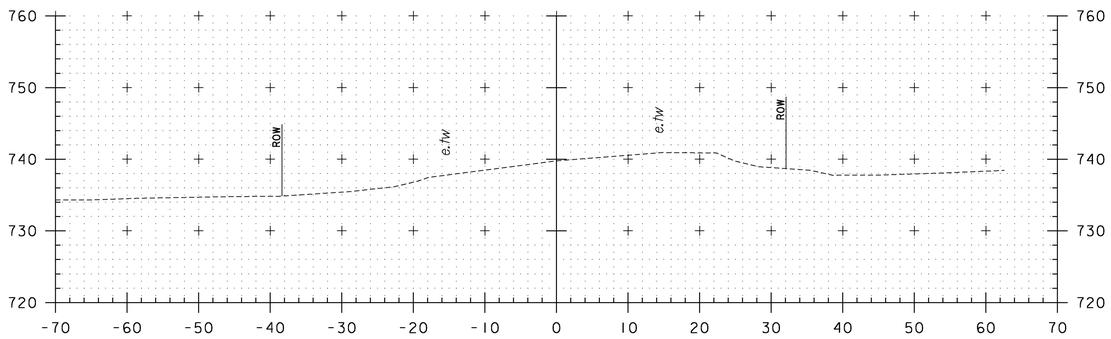


22+00

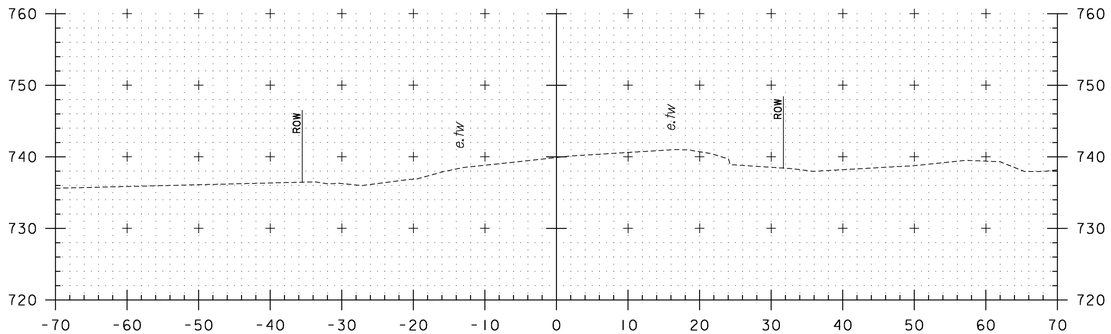


21+50

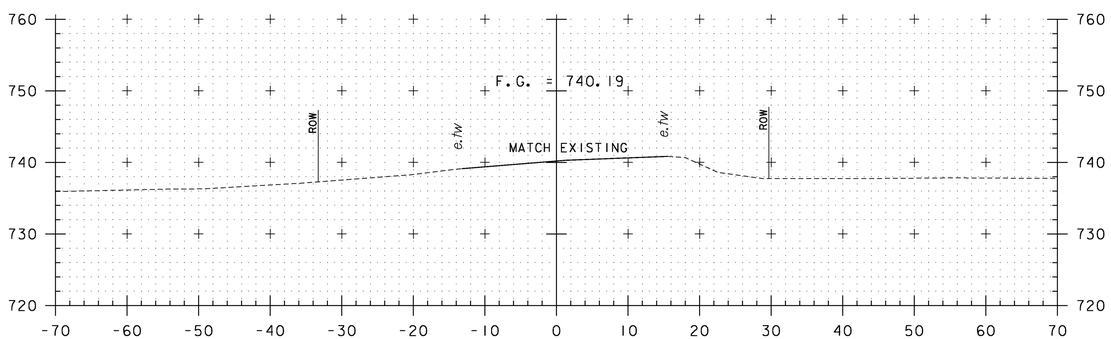



21+00
END APPROACH

STA. 21+00 TO STA. 22+00


PROJECT NAME: STOWE
PROJECT NUMBER: BRF 0235(15)

FILE NAME: z88c190xsl.dgn
PROJECT LEADER: J. BYATT
DESIGNED BY: K. RUTTER
VT 108 CROSS SECTIONS


PLOT DATE: 5/8/2015
DRAWN BY: K. RUTTER
CHECKED BY: C. GREGORY
SHEET 57 OF 79

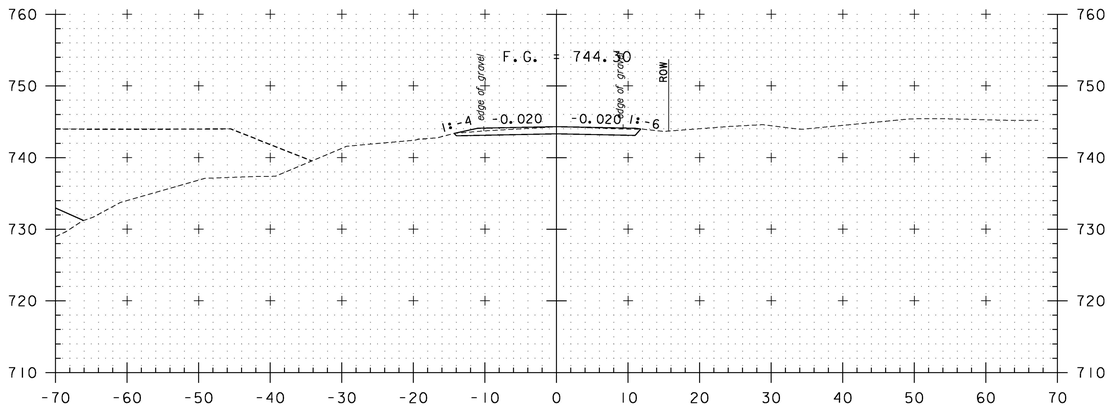



40+50

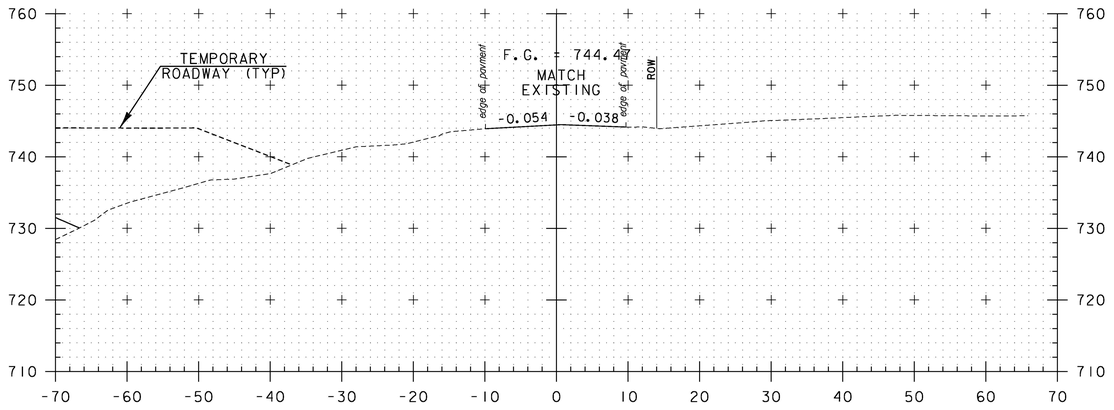



40+45

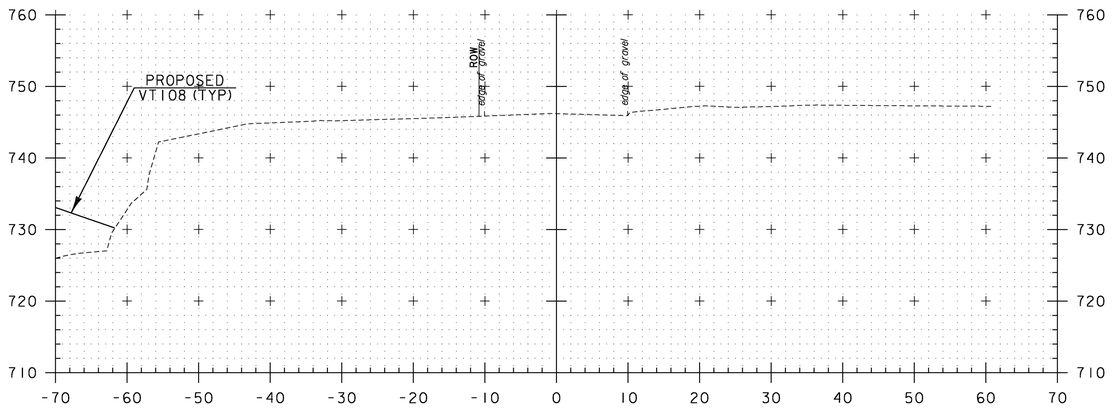



40+00

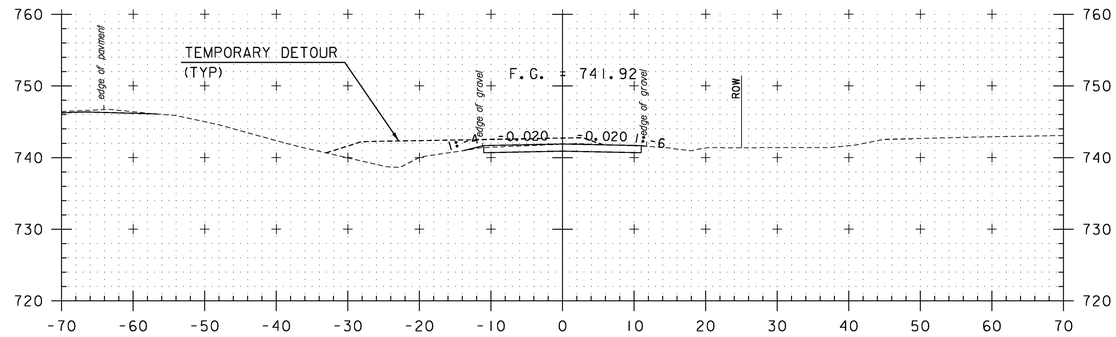


41+50

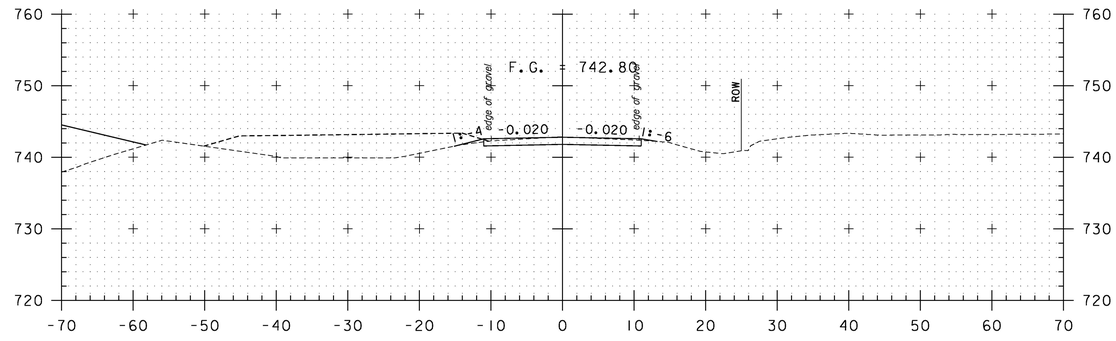


41+00

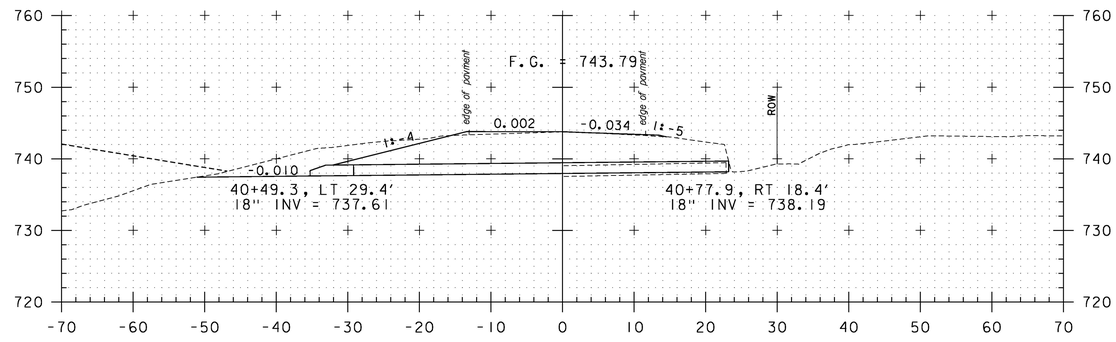


40+65
SKEWED


STA. 40+00 TO STA. 41+50

PROJECT NAME: STOWE
PROJECT NUMBER: BHF 0235(15)


FILE NAME: z88cl90xsMeadow.dgn
PROJECT LEADER: J. BYATT
DESIGNED BY: K. RUTTER
MEADOW LANE CROSS SECTIONS

PLOT DATE: 5/8/2015
DRAWN BY: K. RUTTER
CHECKED BY: C. GREGORY
SHEET 58 OF 79


CLD 12-020 MODEL: MEADOW LANE XS 1

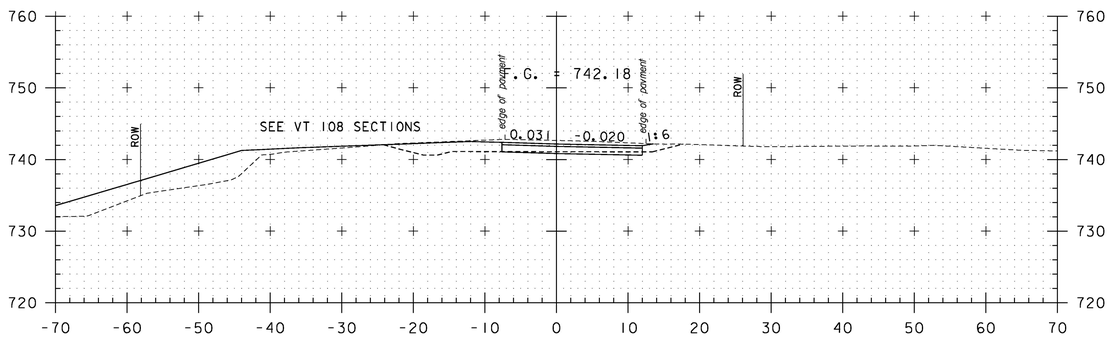



43+00

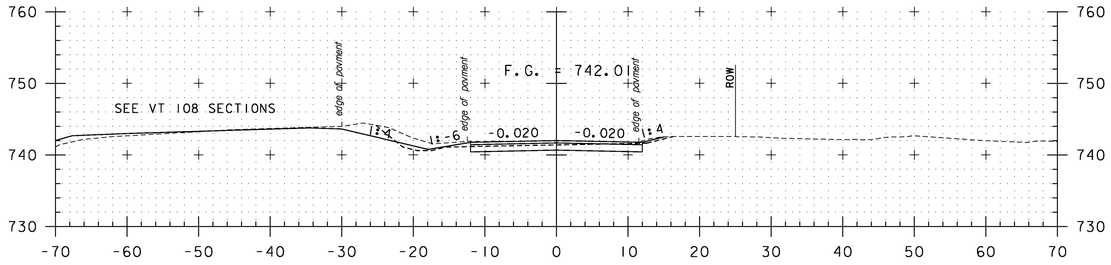



42+50

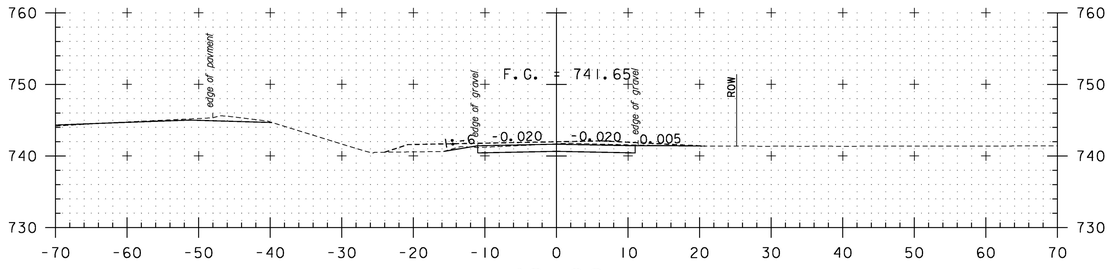



42+00
DRIVE RT

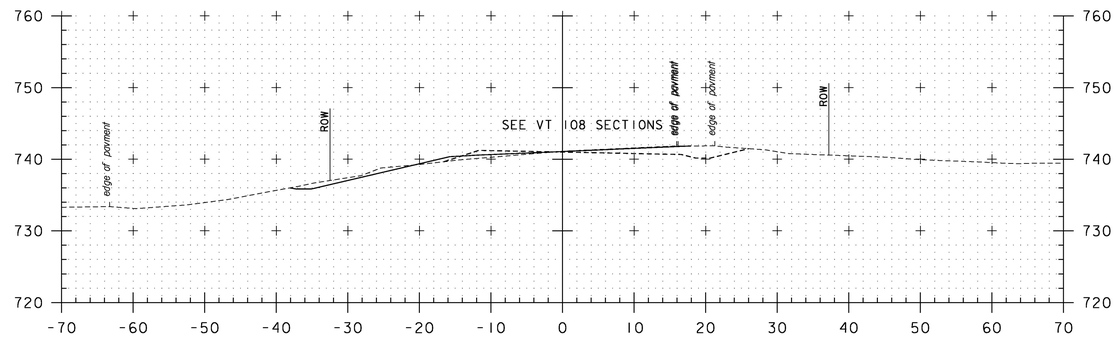


43+65

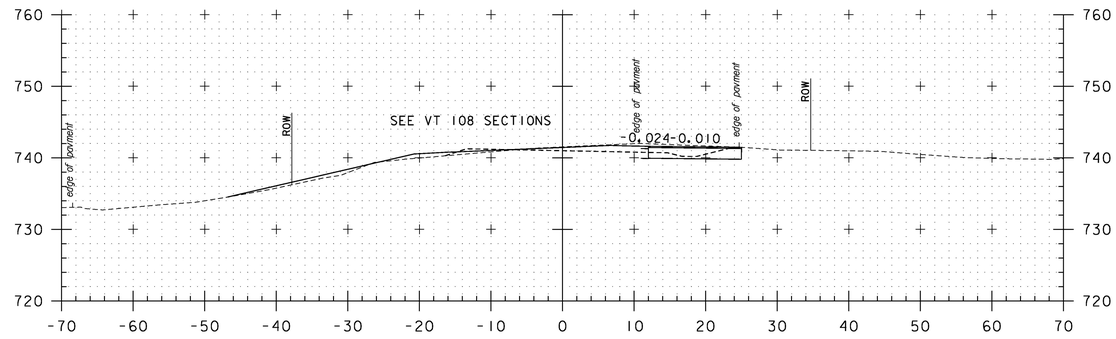


43+50

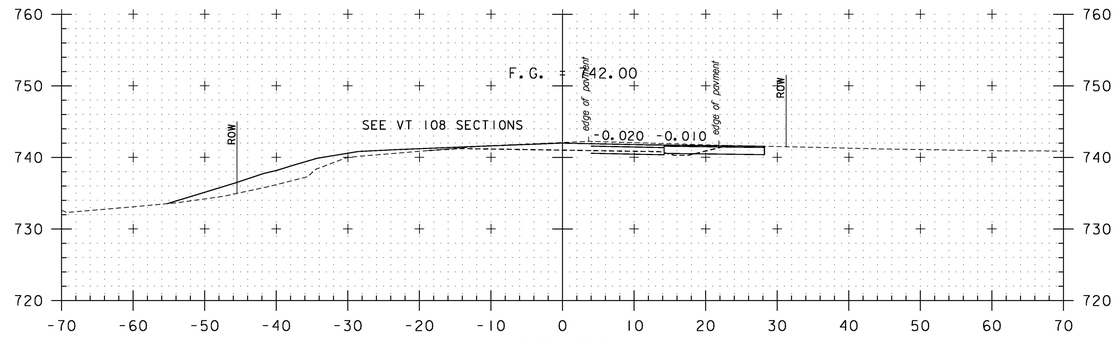


43+30
DRIVE RT


STA. 42+00 TO STA. 43+65

PROJECT NAME: STOWE
PROJECT NUMBER: BHF 0235(15)


FILE NAME: z88cl90xsMeadow.dgn
PROJECT LEADER: J. BYATT
DESIGNED BY: K. RUTTER
MEADOW LANE CROSS SECTIONS

PLOT DATE: 5/8/2015
DRAWN BY: K. RUTTER
CHECKED BY: C. GREGORY
SHEET 59 OF 79


CLD 12-0120 MODEL: MEADOW LANE XS 2

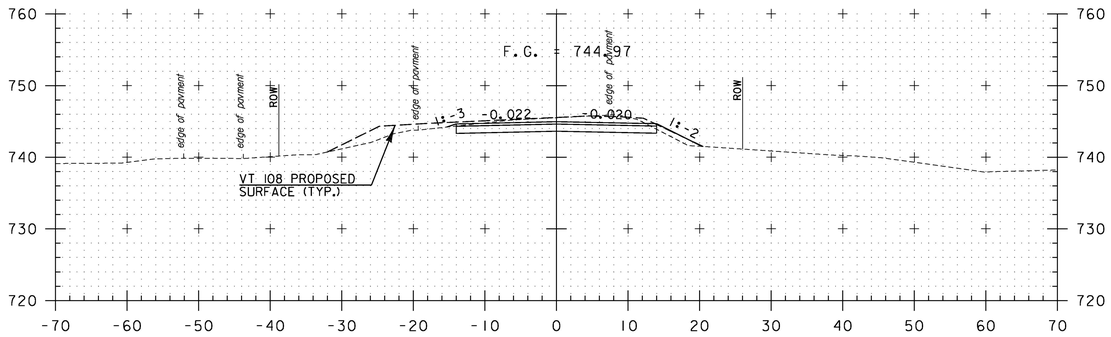



101+00

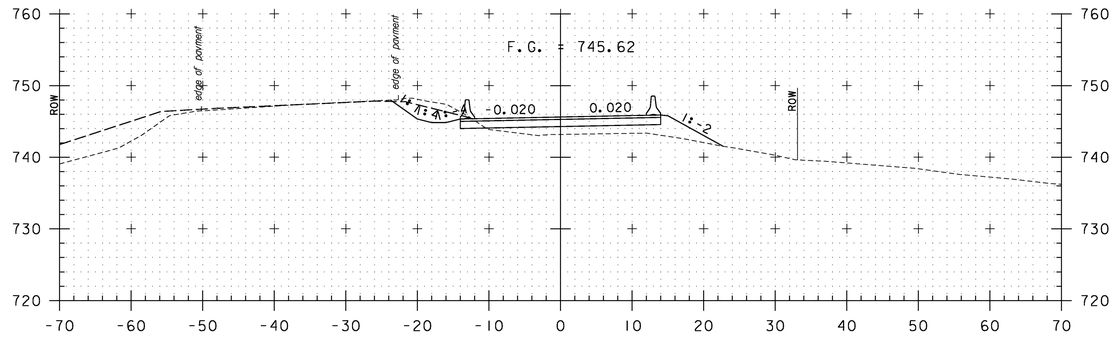



102+50

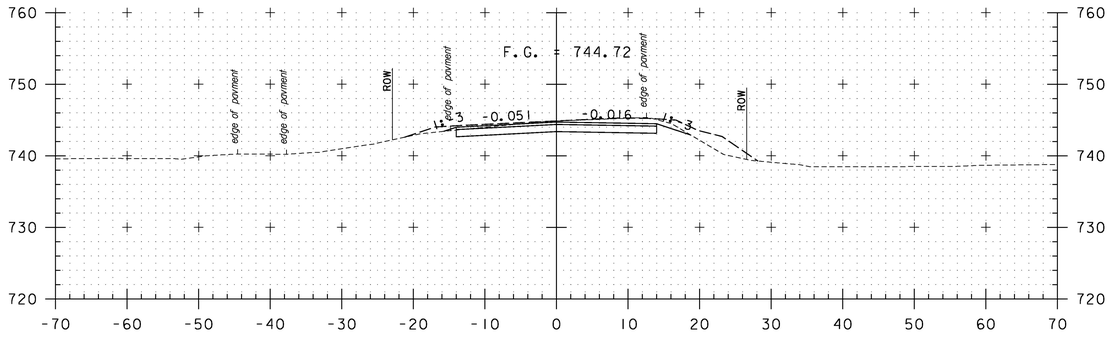



100+50

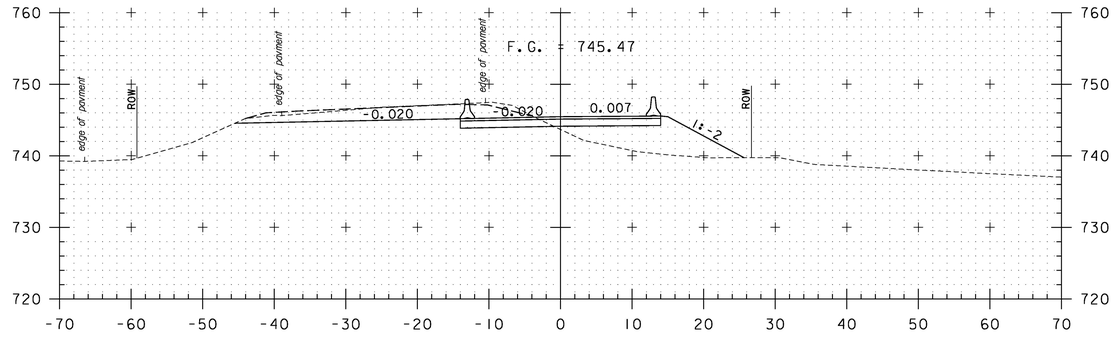


102+00

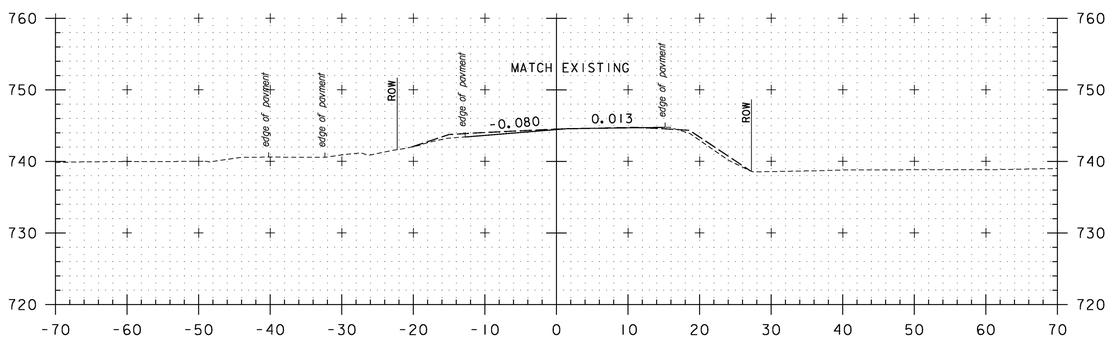


100+00

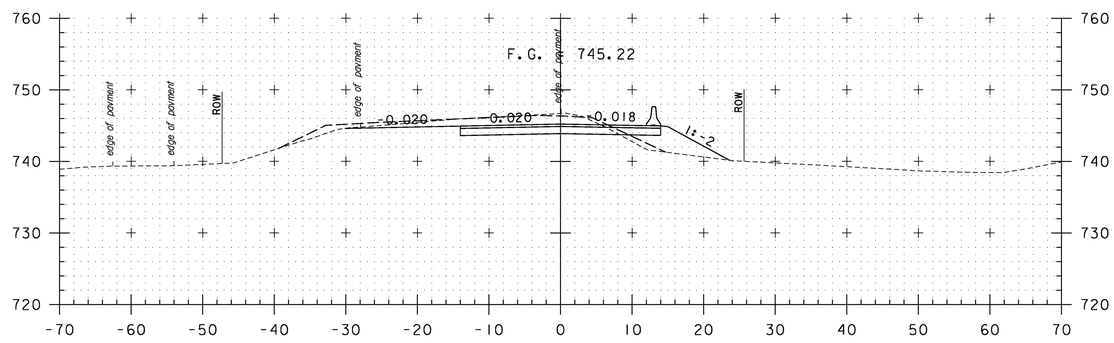


101+50


STA. 100+00 TO STA. 102+50

CLD 12-0120 MODEL: TEMP BRIDGE XS 1


PROJECT NAME: STOWE
PROJECT NUMBER: BRF 0235(15)

FILE NAME: z88cl90xsDetour.dgn
PROJECT LEADER: J. BYATT
DESIGNED BY: K. RUTTER
TEMP DETOUR CROSS SECTIONS


PLOT DATE: 5/8/2015
DRAWN BY: K. RUTTER
CHECKED BY: C. GREGORY
SHEET 60 OF 79

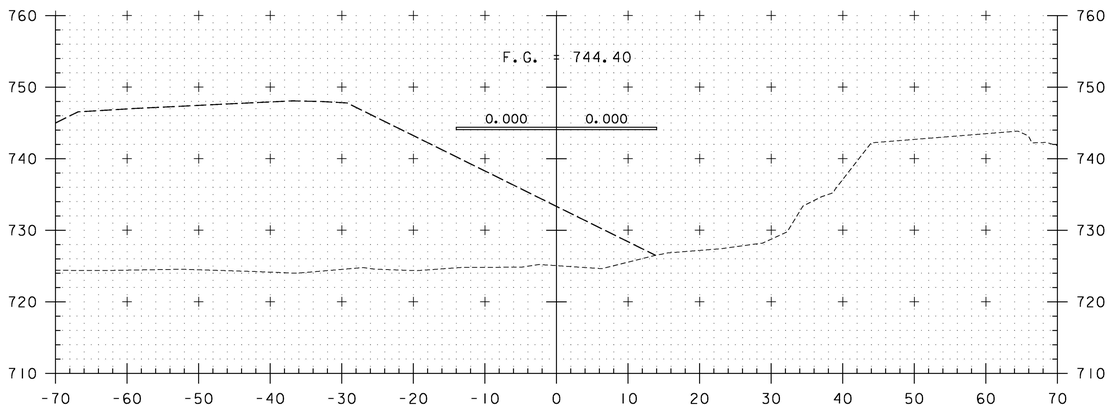



103+50

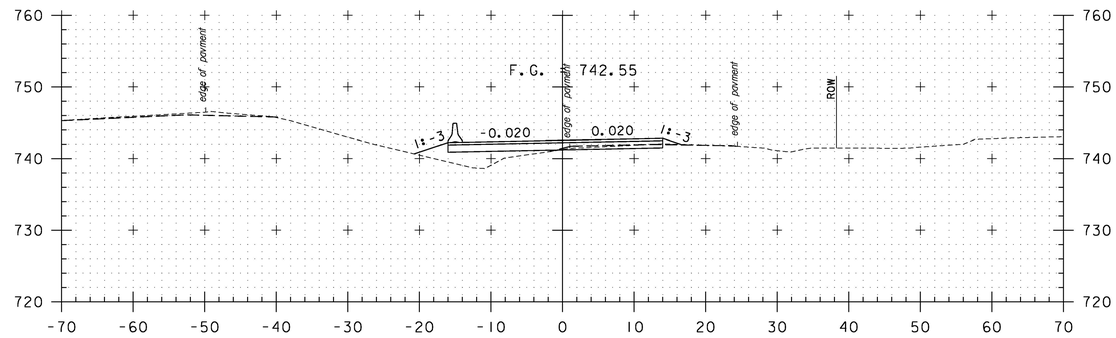



105+00

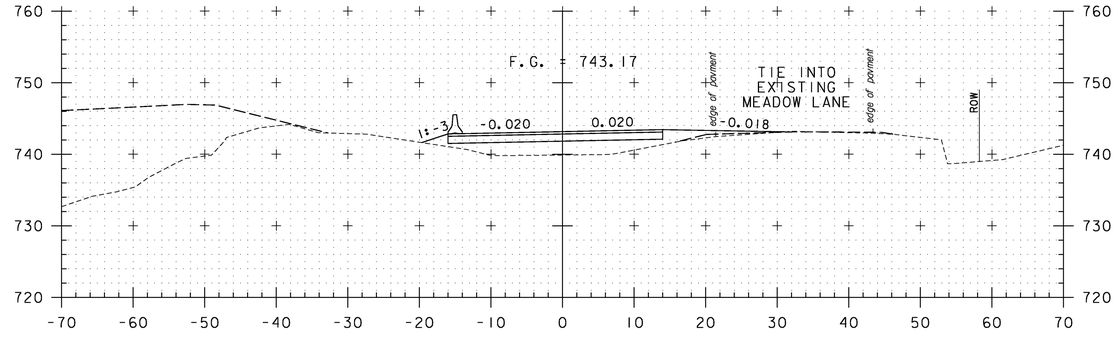


104+50

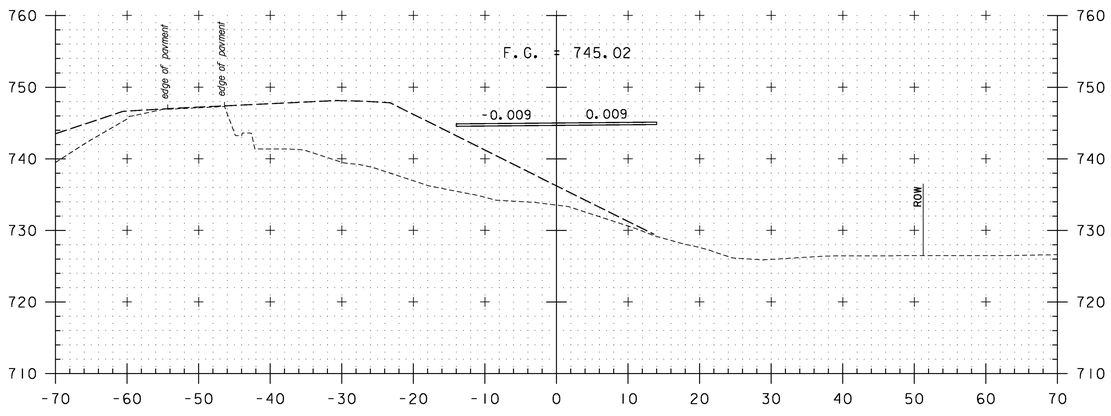


103+00

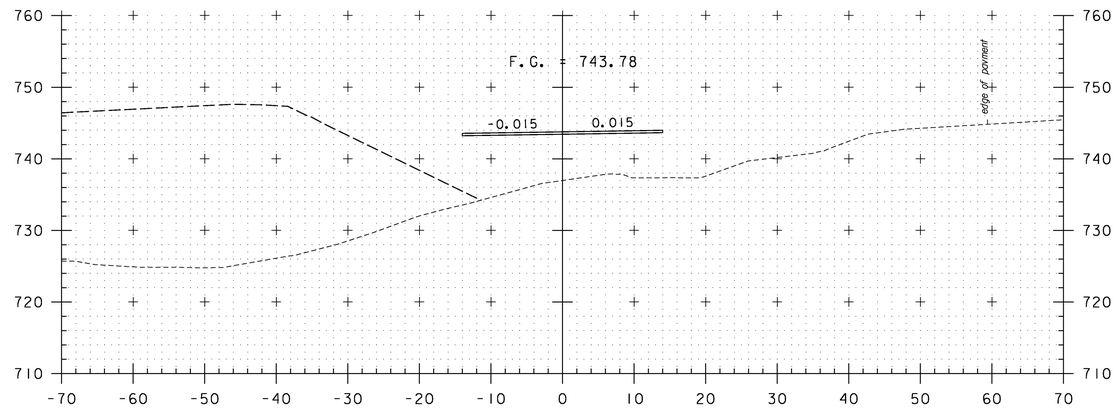


104+00


STA. 103+00 TO STA. 105+00

PROJECT NAME: STOWE
PROJECT NUMBER: BRF 0235(15)


FILE NAME: z88cl90xsDetour.dgn
PROJECT LEADER: J. BYATT
DESIGNED BY: K. RUTTER
TEMP DETOUR CROSS SECTIONS

PLOT DATE: 5/8/2015
DRAWN BY: K. RUTTER
CHECKED BY: C. GREGORY
SHEET 61 OF 79


CLD 12-020 MODEL: TEMP BRIDGE XS 2

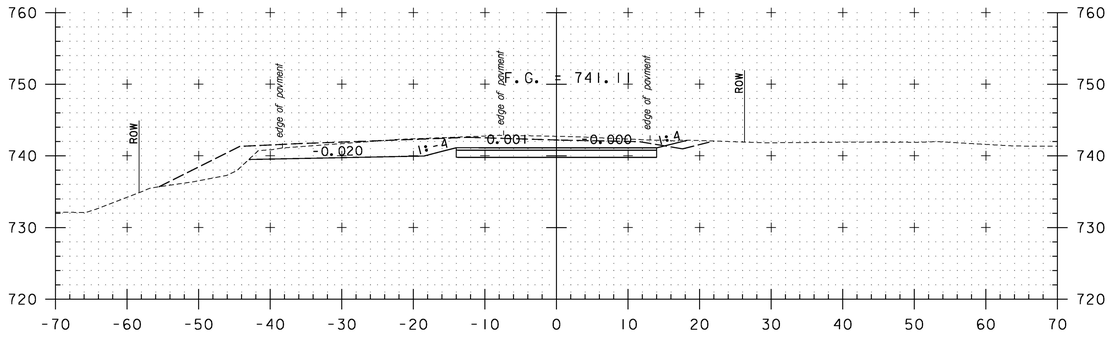



106+50

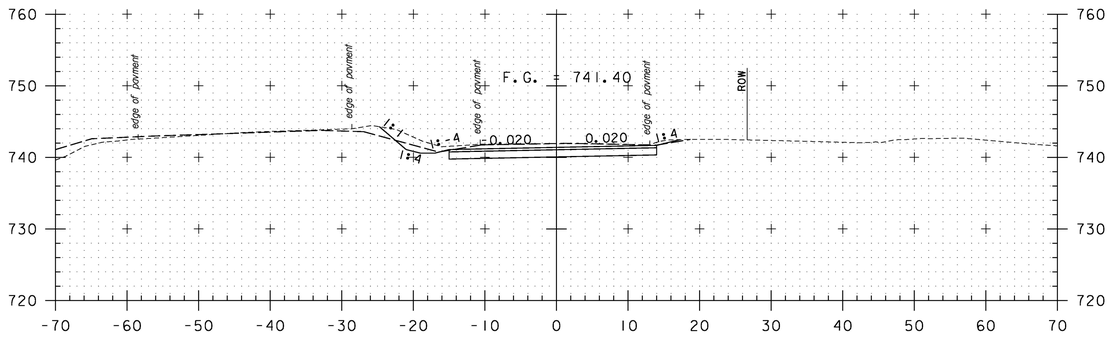



106+00

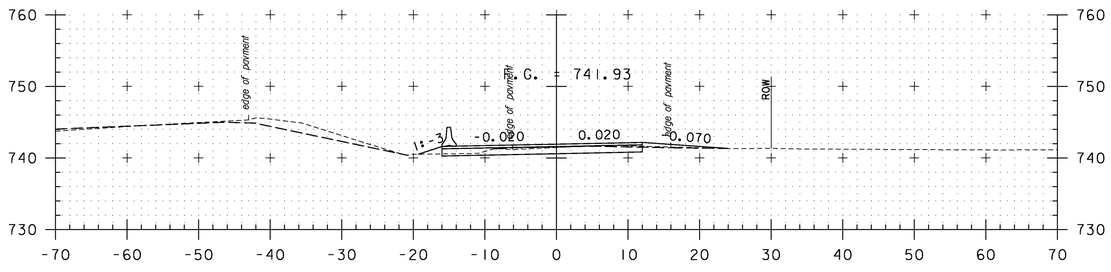



105+50

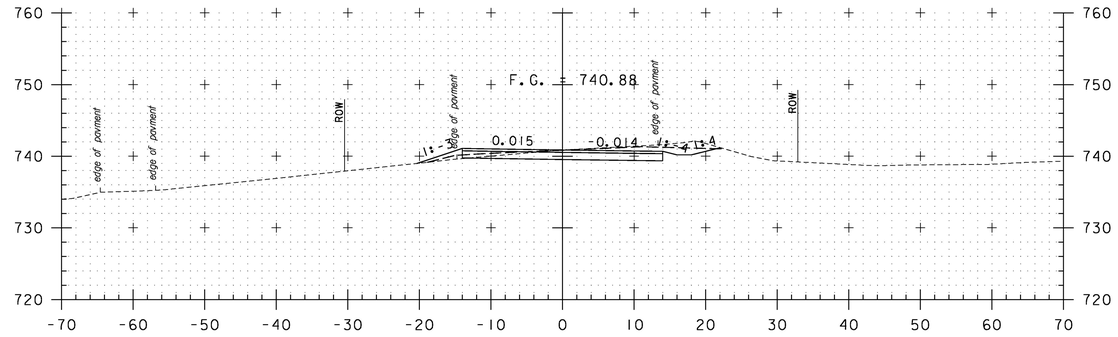


107+50

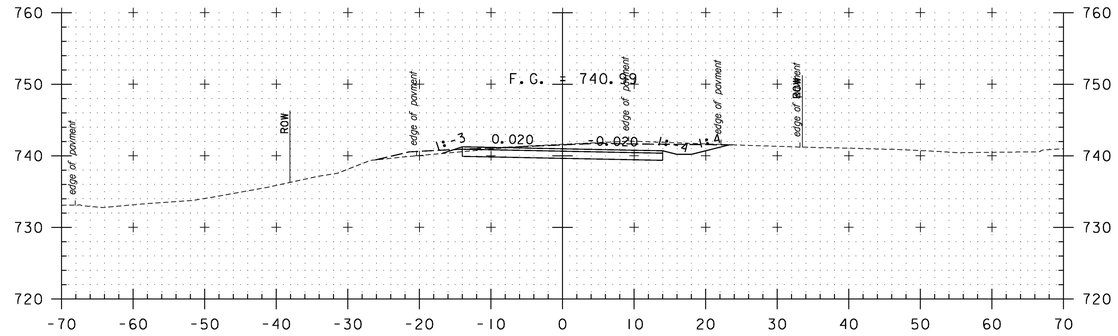


107+00

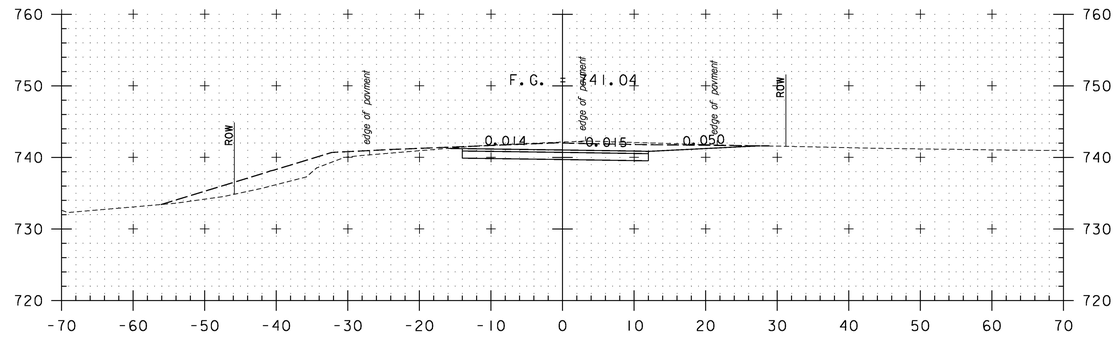


106+80


STA. 105+50 TO STA. 107+50

PROJECT NAME: STOWE
PROJECT NUMBER: BRF 0235(15)


FILE NAME: z88cl90xsDetour.dgn
PROJECT LEADER: J. BYATT
DESIGNED BY: K. RUTTER
TEMP DETOUR CROSS SECTIONS

PLOT DATE: 5/8/2015
DRAWN BY: K. RUTTER
CHECKED BY: C. GREGORY
SHEET 62 OF 79


CLD 12-0120 MODEL: TEMP BRIDGE XS 3

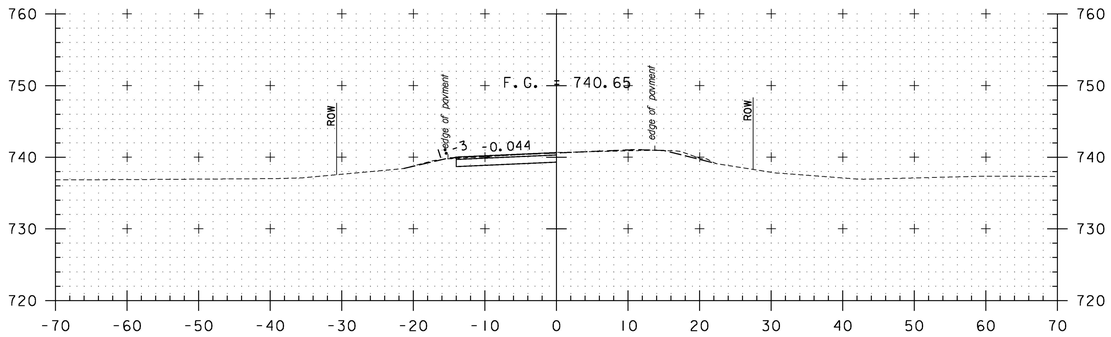



108+50

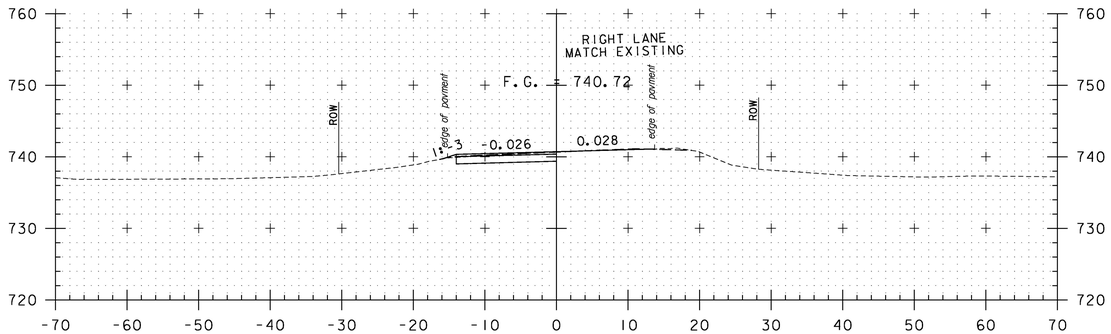



108+20

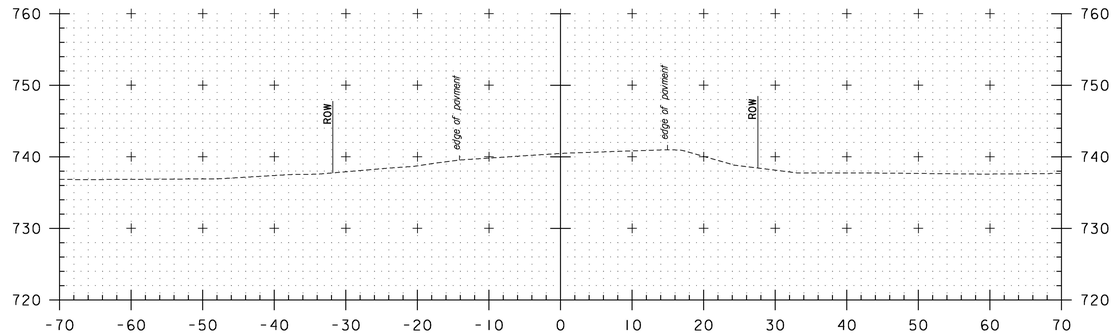


109+00

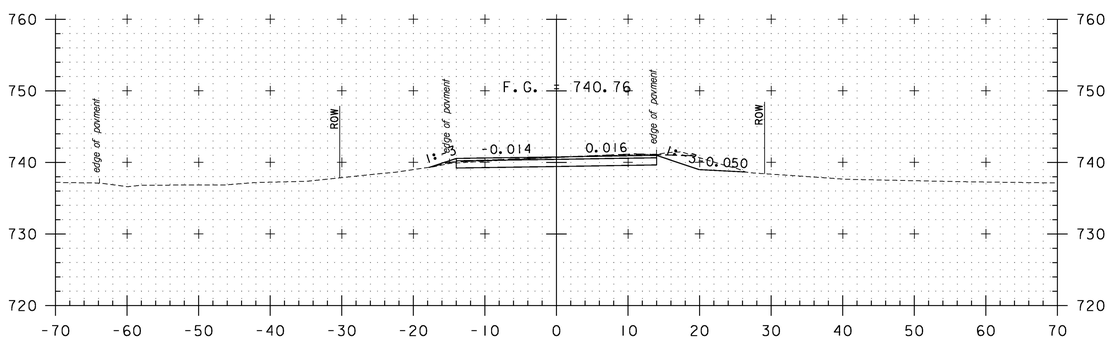


108+00

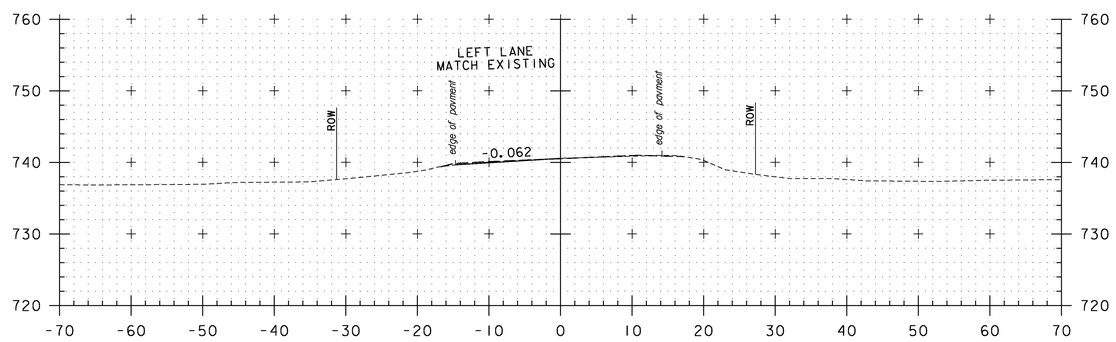


108+80


STA. 108+00 TO STA. 109+00

PROJECT NAME: STOWE
PROJECT NUMBER: BRF 0235(15)


FILE NAME: z88cl90xsDetour.dgn
PROJECT LEADER: J. BYATT
DESIGNED BY: K. RUTTER
TEMP DETOUR CROSS SECTIONS

PLOT DATE: 5/8/2015
DRAWN BY: K. RUTTER
CHECKED BY: C. GREGORY
SHEET 63 OF 79

CLD 12-0120 MODEL: TEMP BRIDGE XS 4

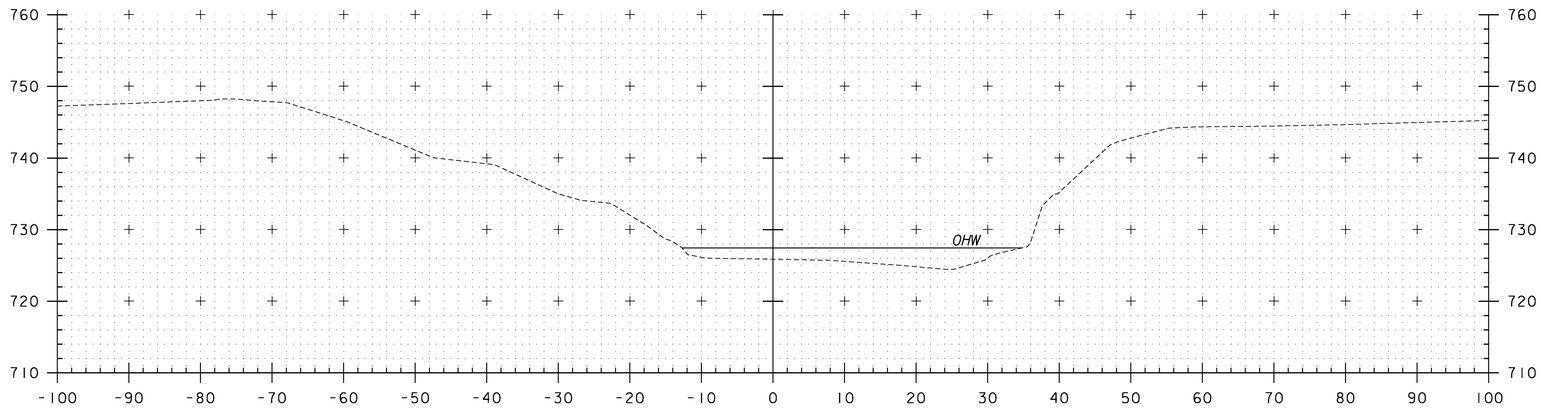


51+25

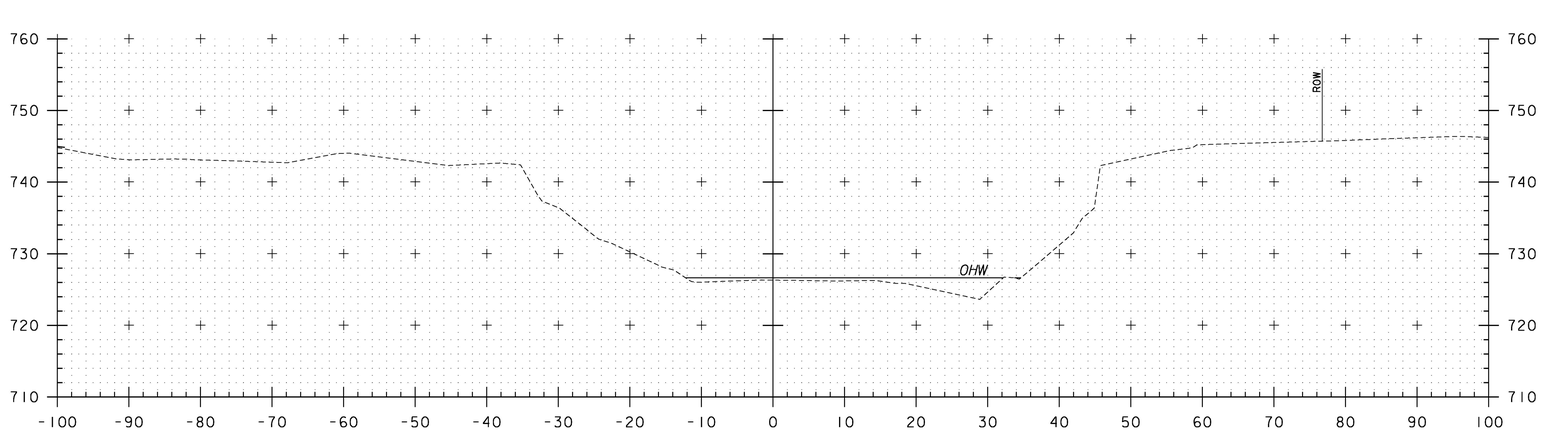



51+00

STA. 51+00 TO STA. 51+25


| | |
|---|---|
| PROJECT NAME: STOWE | |
| PROJECT NUMBER: BRF 0235(15) | |
| FILE NAME: z88cl90xsChan.dgn | PLOT DATE: 5/8/2015 |
| PROJECT LEADER: J. BYATT | DRAWN BY: M. SMITH |
| DESIGNED BY: J. FRENCH | CHECKED BY: J. BYATT |
| CHANNEL CROSS SECTIONS | SHEET 64 OF 79 |

CLD CONSULTING ENGINEERS

CLD 12-0120 MODEL: CHANNEL XS 1

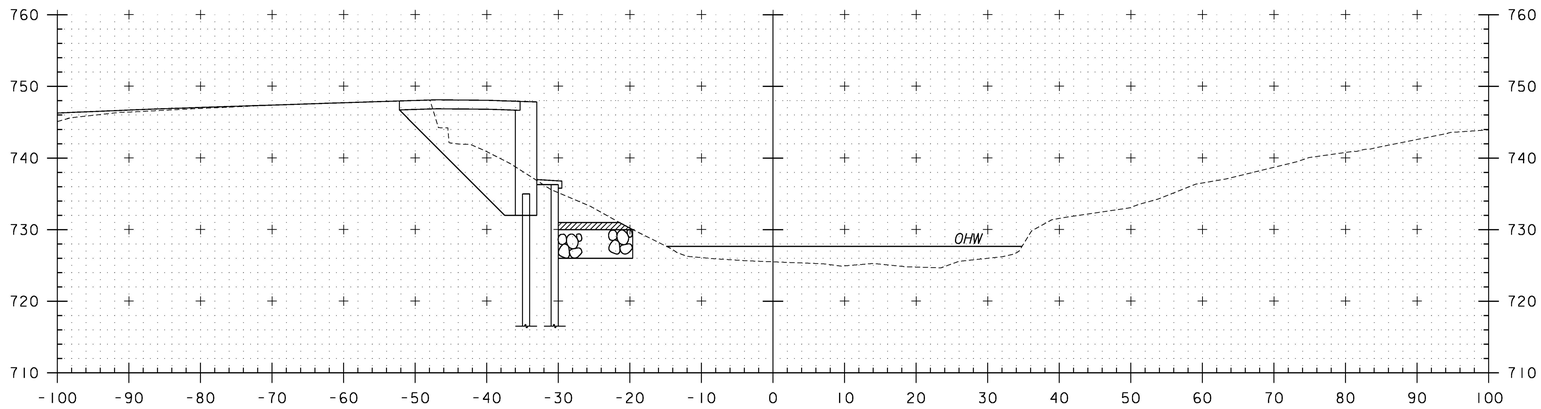


51+50

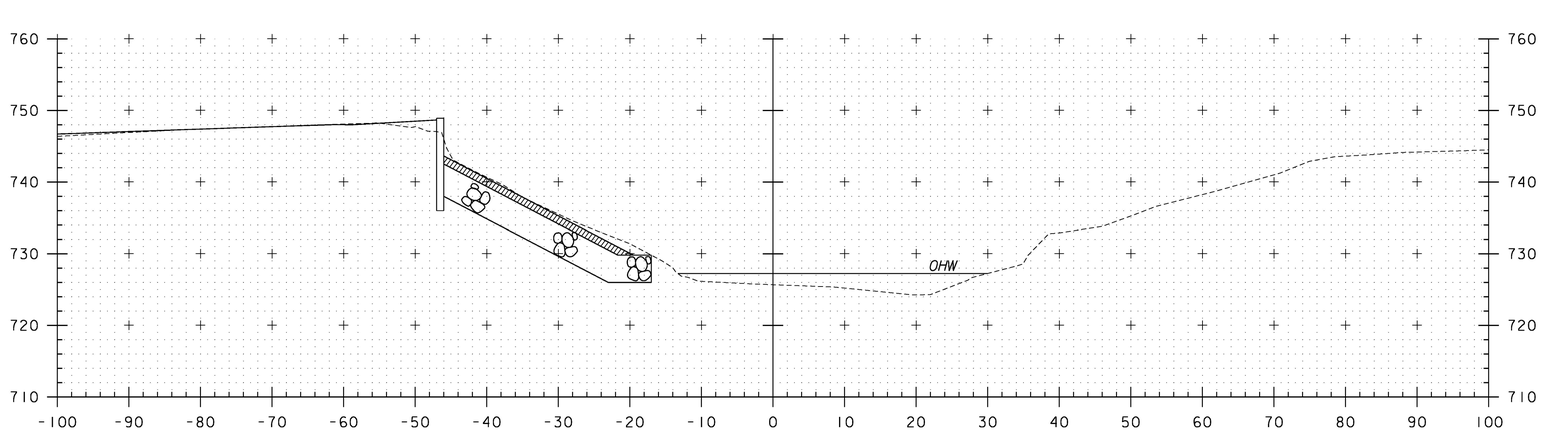



51+40

STA. 51+30 LT
BEGIN UNCLASSIFIED CHANNEL EXCAVATION
BEGIN GEOTEXTILE UNDER STONE FILL
BEGIN STONE FILL, TYPE IV
BEGIN GRUBBING MATERIAL

STA. 51+40 TO STA. 51+50


| | |
|---|---|
| PROJECT NAME: | STOWE |
| PROJECT NUMBER: | BRF 0235(15) |
| FILE NAME: z88cl90xsChan.dgn | PLOT DATE: 5/8/2015 |
| PROJECT LEADER: J. BYATT | DRAWN BY: M. SMITH |
| DESIGNED BY: J. FRENCH | CHECKED BY: J. BYATT |
| CHANNEL CROSS SECTIONS | SHEET 65 OF 79 |

CLD 12-0120 MODEL: CHANNEL XS 2

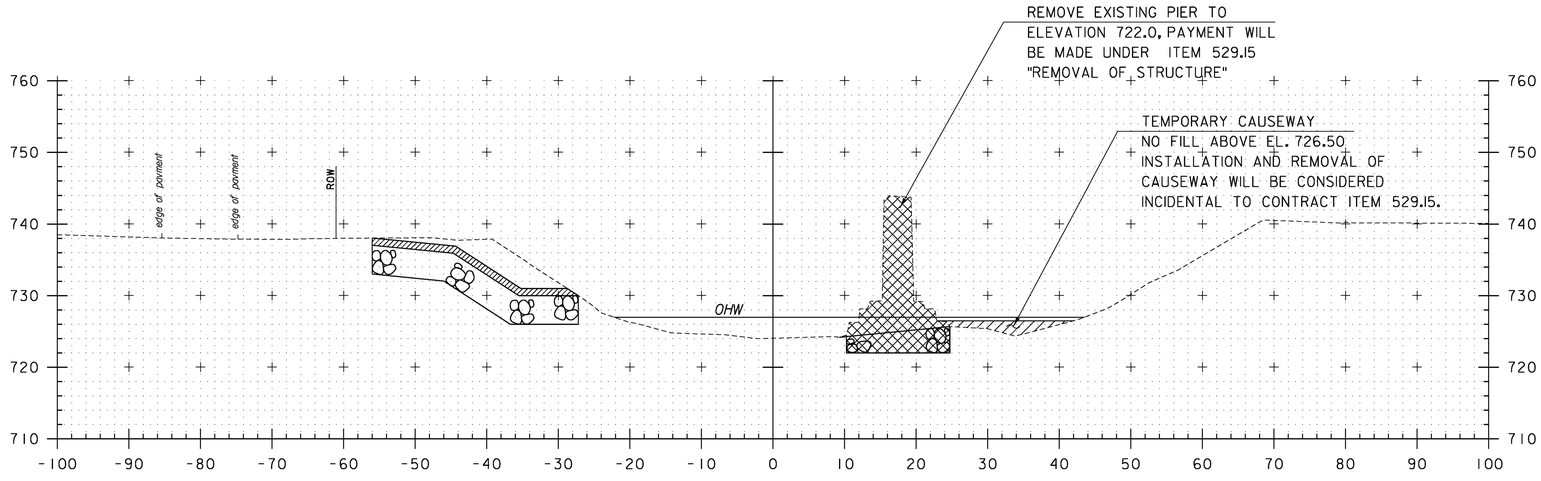


52+00

STA. 51+90.50 PIER
BEGIN GEOTEXTILE UNDER STONE FILL
BEGIN STONE FILL TYPE IV

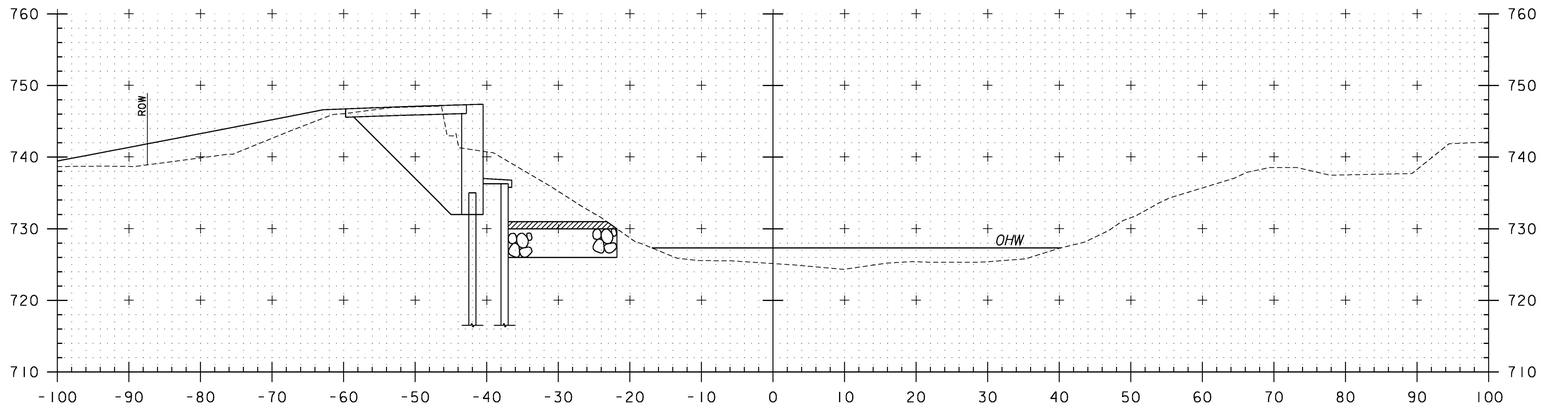


51+75


STA. 51+75 TO STA. 52+00

PROJECT NAME: STOWE
PROJECT NUMBER: BRF 0235(15)


FILE NAME: z88cl90xsChan.dgn
PROJECT LEADER: J. BYATT
DESIGNED BY: J. FRENCH
CHANNEL CROSS SECTIONS

PLOT DATE: 5/8/2015
DRAWN BY: M. SMITH
CHECKED BY: J. BYATT
SHEET 66 OF 79

CLD 12-0120 MODEL: CHANNEL XS 3

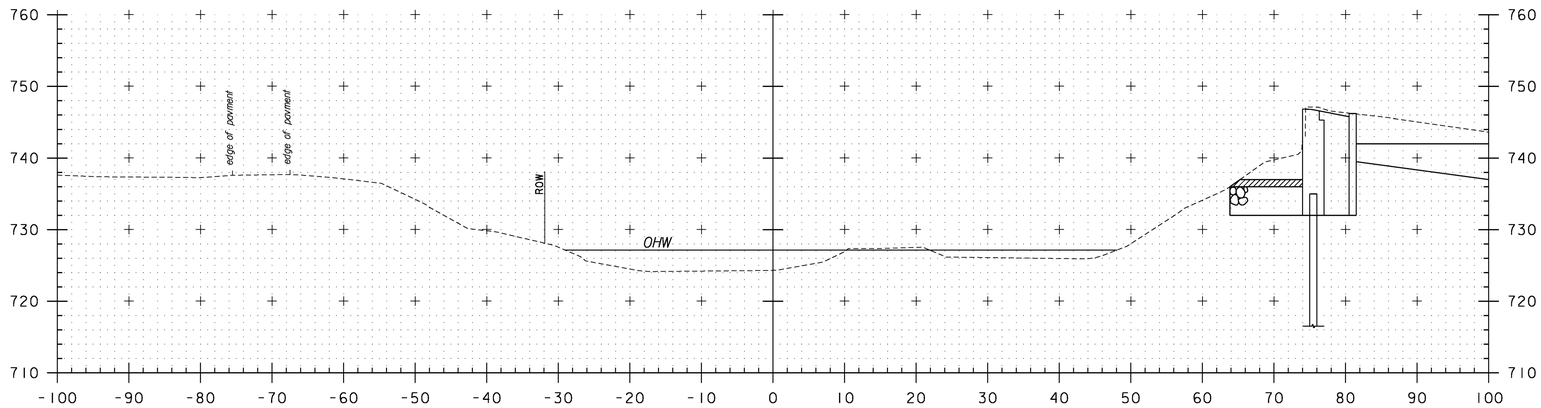


52+50

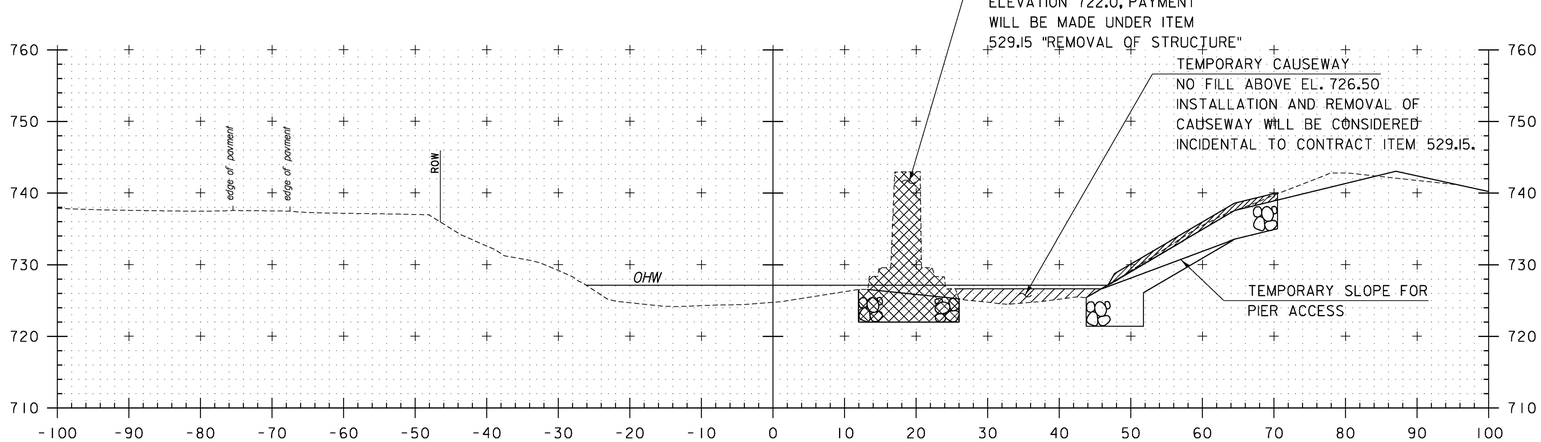


STA. 52+14 LT
END UNCLASSIFIED CHANNEL EXCAVATION
END GEOTEXTILE UNDER STONE FILL
END STONE FILL, TYPE IV
END GRUBBING MATERIAL

52+25

STA. 52+41.50
END GEOTEXTILE
UNDER STONE FILL
END STONE FILL, TYPE IV

STA. 52+15.25 RT
BEGIN UNCLASSIFIED CHANNEL EXCAVATION
BEGIN GEOTEXTILE UNDER STONE FILL
BEGIN STONE FILL, TYPE IV
BEGIN GRUBBING MATERIAL


STA. 52+25 TO STA. 52+50

PROJECT NAME: STOWE
PROJECT NUMBER: BRF 0235(15)

FILE NAME: z88cl90xsChan.dgn
PROJECT LEADER: J. BYATT
DESIGNED BY: J. FRENCH
CHANNEL CROSS SECTIONS


PLOT DATE: 5/8/2015
DRAWN BY: M. SMITH
CHECKED BY: J. BYATT
SHEET 67 OF 79

CLD 12-0120 MODEL: CHANNEL XS 4

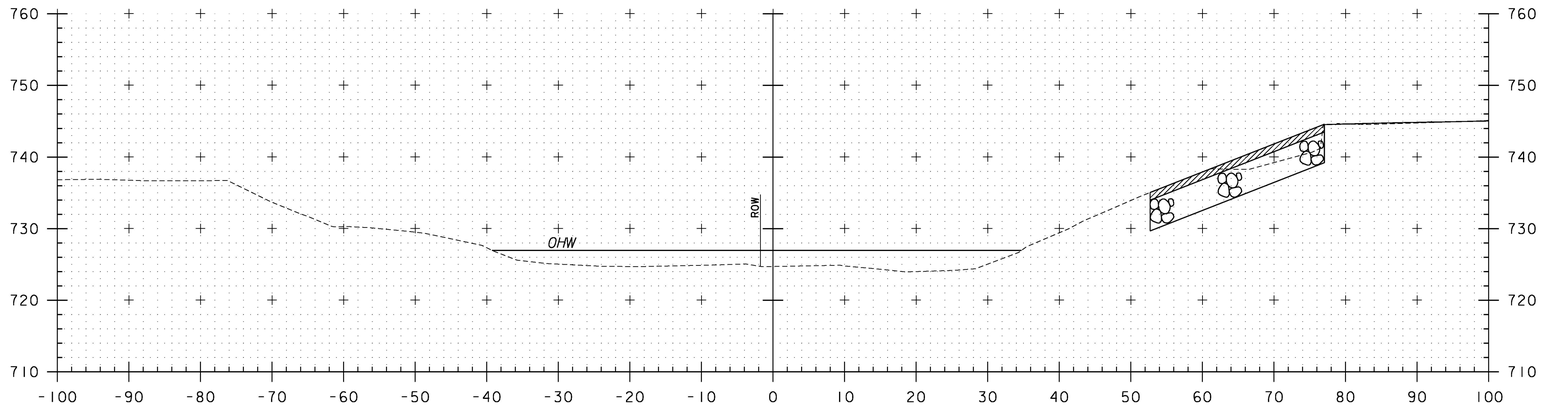


53+00

STA. 53+10.5 RT
END UNCLASSIFIED CHANNEL EXCAVATION
END GEOTEXTILE UNDER STONE FILL
END STONE FILL, TYPE IV
END GRUBBING MATERIAL

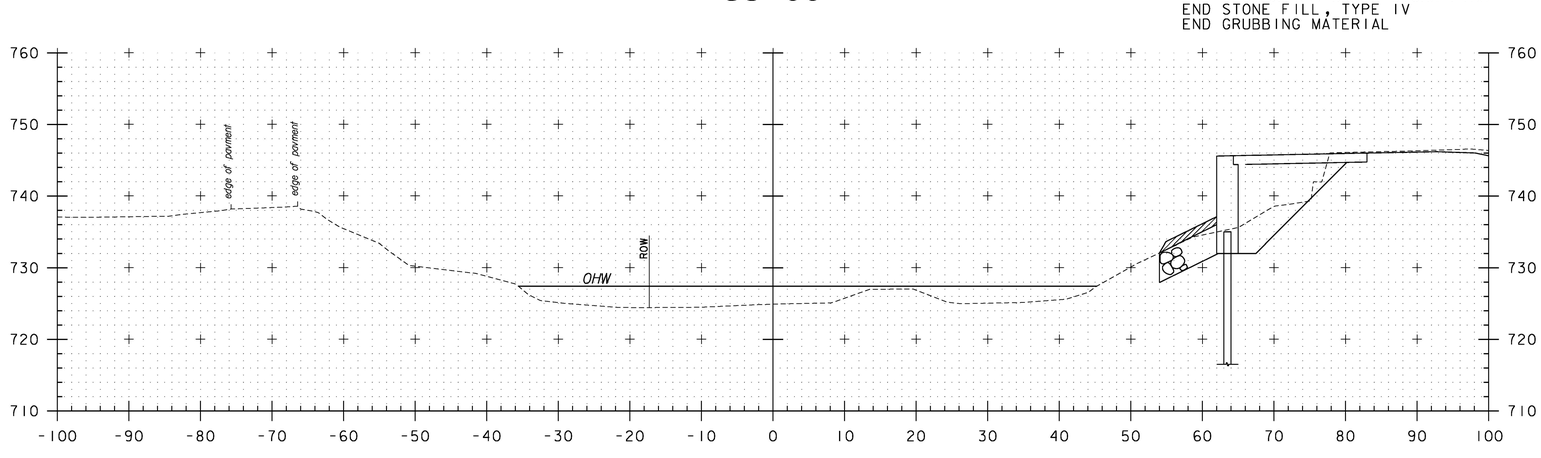


52+75


STA. 52+75 TO STA. 53+00

PROJECT NAME: STOWE
PROJECT NUMBER: BRF 0235(15)

FILE NAME: z88cl90xsChan.dgn
PROJECT LEADER: J. BYATT
DESIGNED BY: J. FRENCH
CHANNEL CROSS SECTIONS

PLOT DATE: 5/8/2015
DRAWN BY: M. SMITH
CHECKED BY: J. BYATT
SHEET 68 OF 79

CLD 12-0120 MODEL: CHANNEL XS 5

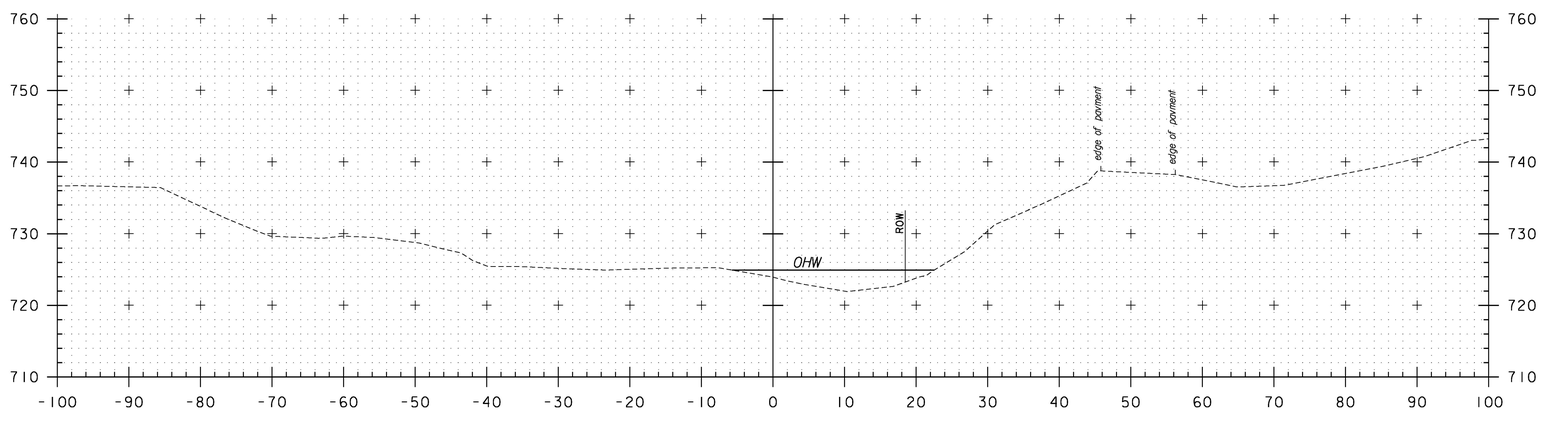


53+25

STA. 53+25

| | |
|---|---|
| PROJECT NAME: | STOWE |
| PROJECT NUMBER: | BRF 0235(15) |

| | |
|---|---|
| FILE NAME: z88cl90xsChan.dgn | PLOT DATE: 5/8/2015 |
| PROJECT LEADER: J. BYATT | DRAWN BY: M. SMITH |
| DESIGNED BY: J. FRENCH | CHECKED BY: J. BYATT |
| CHANNEL CROSS SECTIONS | SHEET 69 OF 79 |

CLD

CONSULTING ENGINEERS

CLD 12-0120 MODEL: CHANNEL XS 6

# EPSC PLAN NARRATIVE

## 1.1 PROJECT DESCRIPTION

THIS PROJECT INVOLVES THE REPLACEMENT OF VT ROUTE 108 BRIDGE 3 OVER THE WEST BRANCH OF THE LITTLE RIVER. VT ROUTE 108 BRIDGE 3 IS LOCATED IN THE TOWN OF STOWE, APPROXIMATELY AT THE INTERSECTION OF VT ROUTE 108 AND MEADOW LANE. A TEMPORARY DETOUR WILL BE REQUIRED AND A TEMPORARY BRIDGE WILL BE BUILT TO ACCOMMODATE THE DETOUR. THE TEMPORARY BRIDGE WILL BE LOCATED SOUTH OF THE BRIDGE REPLACEMENT. MEADOW LANE WILL BE PARTIALLY USED FOR THE DETOUR.

NOTE: AREA OF DISTURBANCE INCLUDES LIMITS OF EARTH DISTURBANCE WITHIN THE PROJECT AREA, AS WELL AS WASTE, BORROW AND STAGING AREAS, AND OTHER EARTH DISTURBING ACTIVITIES WITHIN OR DIRECTLY ADJACENT TO THE PROJECT LIMITS AS SHOWN ON THE ATTACHED EPSC PLAN.

TOTAL AREA OF DISTURBANCE AS SHOWN ON THE ATTACHED EPSC PLAN IS APPROXIMATELY 1.61 ACRES.

IT IS ANTICIPATED THAT THIS PROJECT WILL LAST ONE AND A HALF CONSTRUCTION SEASONS.

## 1.2 SITE INVENTORY

### 1.2.1 TOPOGRAPHY

THE TOPOGRAPHY OF THE AREA IS CHARACTERIZED AS HILLY TO MOUNTAINOUS. AN OPEN FIELD WITH A PAVED BIKE PATH IS LOCATED NORTH OF THE BRIDGE. SOUTHWEST OF THE BRIDGE IS AN INN WITH A LARGE DIRT/GRAVEL PARKING AREA AND LANDSCAPING ADJACENT TO THE TOP OF THE RIVER BANK. SOUTHEAST OF THE BRIDGE IS MEADOW LANE, WHICH IS UNPAVED. AN INN AND RESIDENCE ARE LOCATED ON MEADOW LANE WITHIN THE PROJECT AREA. THEY ARE BOTH LOCATED ON THE OPPOSITE SIDE OF MEADOW LANE FROM THE WEST BRANCH OF THE LITTLE RIVER.

### 1.2.2 DRAINAGE, WATERWAYS, BODIES OF WATER, AND PROXIMITY TO NATURAL OR MAN-MADE WATER FEATURES

THE WEST BRANCH OF THE LITTLE RIVER IS THE ONLY WATER SOURCE ON THE PROJECT SITE. THE STREAM IS CHARACTERIZED AS SINUOUS, SEMI-ALLUVIAL, INCISED, AND WITH PAST DEGRADATION. THE STREAM BED CONSISTS OF GRAVEL, COBBLES, SOME BOULDERS, AND SOME LEDGE UPSTREAM. THE DRAINAGE AREA IS 23.8 SQUARE MILES.

### 1.2.3 VEGETATION

THE VEGETATION IN THE PROJECT AREA CONSISTS MOSTLY OF OPEN LANDSCAPED AREAS OUTSIDE OF THE RIVER BANK WITH ONLY A FEW TREES ALONG THE BIKE PATH AND THE INN LOCATED SOUTHWEST OF THE BRIDGE. THE RIVER BANK IS MORE DENSE WITH TREES OF VARIOUS TYPES AND SIZES.

### 1.2.4 SOILS

ALL SOIL DATA CAME FROM THE U.S. DEPARTMENT OF AGRICULTURE SOIL CONSERVATION SERVICE FOR THE COUNTY OF LAMOILLE, VERMONT. SOILS ON THE PROJECT SITE ARE: COLTON-DUXBURY COMPLEX, 2 TO 8 PERCENT SLOPES, “K FACTOR” = 0.17, LYMAN-TUNBRIDGE FINE SANDY LOAMS, VERY ROCKY, 25 TO 60 PERCENT SLOPES, “K FACTOR” = 0.28, AND PODUNK FINE SANDY LOAM, “K FACTOR” = 0.24.

**NOTE**: K-VALUES GENERALLY INDICATE THE FOLLOWING:
0.0-0.23 = LOW EROSION POTENTIAL
0.24-0.36 = MODERATE EROSION POTENTIAL
0.37 AND HIGHER = HIGH EROSION POTENTIAL

### 1.2.5 SENSITIVE RESOURCE AREAS

CRITICAL HABITATS: NO
HISTORICAL OR ARCHEOLOGICAL AREAS: YES. THE INN AND RESIDENCE LOCATED ON MEADOW LANE SOUTHEAST OF THE BRIDGE ARE HISTORICAL BUILDINGS.
PRIME AGRICULTURAL LAND: NO
THREATENED AND ENDANGERED SPECIES: NO
WATER RESOURCE: WEST BRANCH OF THE LITTLE RIVER
WETLANDS: NO

## 1.3 RISK EVALUATION

THIS PROJECT FALLS UNDER THE JURISDICTION OF GENERAL PERMIT 3-9020 FOR STORMWATER RUNOFF FROM CONSTRUCTION SITES FOR LOW RISK PROJECTS. ANY MODIFICATIONS TO THE PROJECT THAT INCREASE THE RISK TO ENVIRONMENTAL RESOURCES SHALL BE EVALUATED IN ACCORDANCE WITH THE PERMIT REQUIREMENTS. THE CONTRACTOR WILL BE RESPONSIBLE FOR ANY ADDITIONAL PERMITTING.

## 1.4 EROSION PREVENTION AND SEDIMENT CONTROL

THE EROSION CONTROL PLANS ARE MEANT AS A GUIDELINE FOR PREVENTING EROSION AND CONTROLLING SEDIMENT TRANSPORT. THE PRINCIPLES OUTLINED IN THIS NARRATIVE CONSIST OF APPLYING MEASURES THROUGHOUT CONSTRUCTION OF THE PROJECT IN ORDER TO MINIMIZE SEDIMENT TRANSPORT TO THE RECEIVING WATERS. THE MEASURES INCLUDE STABILIZATION AND STRUCTURAL PRACTICES, STORM WATER CONTROLS AND OTHER POLLUTION PREVENTION PRACTICES. THEY HAVE BEEN PROPOSED BY THE DESIGNER AS A BASIS FOR PROTECTING RESOURCES AND WILL NEED TO BE BUILT UPON BASED ON THE SPECIFIC MEANS AND METHODS OF THE CONTRACTOR. REFER TO THE LOW RISK SITE HANDBOOK AND APPROPRIATE DETAIL SHEETS FOR SPECIFIC GUIDANCE AND CONSTRUCTION DETAILING.

ALL MEASURES SHALL BE REGULARLY MAINTAINED AND SHALL BE CHECKED FOR SEDIMENT BUILD-UP. SEDIMENT SHALL BE DISPOSED OF AT AN APPROVED SITE WHERE IT WILL NOT BE SUBJECT TO EROSION.

### 1.4.1 MARK SITE BOUNDARIES

SITE BOUNDARIES AND AREAS CONSTRUCTION EQUIPMENT CAN ACCESS SHALL BE DELINEATED.

PROJECT DEMARCATION FENCING (PDF) SHALL BE USED TO PHYSICALLY MARK SITE BOUNDARIES. BECAUSE THIS PROJECT FALLS UNDER THE CGP 3-9020, BARRIER FENCE SHALL BE USED INSTEAD OF PROJECT DEMARCATION FENCE WITHIN 100 FEET OF A WATER RESOURCE (STREAM, BROOK, LAKE, POND, WETLAND, ETC).

### 1.4.2 LIMIT DISTURBANCE AREA

PREVENTING INITIAL SOIL EROSION BY MINIMIZING THE EXPOSED AREA IS MUCH MORE EFFECTIVE THAN TREATING ERODED SEDIMENT. EARTH DISTURBANCE CAN BE MINIMIZED THROUGH CONSTRUCTION PHASING BY ONLY OPENING UP EARTH AS NECESSARY. THIS CAN LIMIT THE AREA THAT WILL BE DISTURBED AND EXPOSED TO EROSION. EMPLOY TEMPORARY CONSTRUCTION STABILIZATION PRACTICES IN INCREMENTAL STAGES AS PHASES CHANGE. FOR PROJECTS WHICH FALL UNDER THE CONSTRUCTION GENERAL PERMIT, ONLY THE ACREAGE LISTED ON THE PERMIT AUTHORIZATION MAY BE EXPOSED AT ANY GIVEN TIME.

MAINTAINING VEGETATED BUFFERS ALONG STREAM BANKS, WETLANDS OR OTHER SENSITIVE AREAS IS A CRUCIAL EROSION AND SEDIMENT CONTROL MEASURE THAT SHOULD BE ESTABLISHED WHEREVER POSSIBLE.

### 1.4.3 SITE ENTRANCE/EXIT STABILIZATION

TRACKING OF SEDIMENT ONTO PUBLIC HIGHWAYS SHALL BE MINIMIZED TO REDUCE THE POTENTIAL FOR RUNOFF ENTERING RECEIVING WATERS. INSTALLATION SHALL COINCIDE WITH THE CONTRACTOR’S PROGRESS SCHEDULE.

STABILIZED CONSTRUCTION ENTRANCES SHALL BE PLACED ANYWHERE EQUIPMENT WILL BE GOING FROM AREAS OF EXPOSED SOILS TO PAVED SURFACES.

STABILIZED CONSTRUCTION ENTRANCES ARE NOT ANTICIPATED ON THIS PROJECT. THE EXISTING ROADWAY WILL BE USED TO ACCESS THE BRIDGE.

### 1.4.4 INSTALL SEDIMENT BARRIERS

SEDIMENT BARRIERS SHALL BE UTILIZED TO INTERCEPT RUNOFF AND ALLOW SUSPENDED SEDIMENT TO SETTLE OUT. THEY SHALL BE INSTALLED PRIOR TO ANY UP SLOPE WORK.

SILT FENCE WILL BE INSTALLED AS PROPOSED ON THE EPSC PLAN. BECAUSE THIS PROJECT FALLS UNDER THE CGP 3-9020, WOVEN WIRE REINFORCED SILT FENCE SHALL BE USED INSTEAD OF SILT FENCE WITHIN 100 FEET UPSLOPE OF RECEIVING WATERS.

FILTER CURTAINS WILL BE INSTALLED AS PROPOSED ON THE EPSC PLAN.

### 1.4.5 DIVERT UPLAND RUNOFF

DIVERSIONARY MEASURES SHALL BE USED TO INTERCEPT RUNOFF FROM ABOVE THE CONSTRUCTION AND DIRECT IT AROUND THE DISTURBED AREA SO THAT CLEAN WATER DOES NOT BECOME MUDDIED WHILE TRAVELING OVER EXPOSED SOILS ON THE CONSTRUCTION SITE.

THE PROJECT AREA IS RELATIVELY FLAT. THEREFORE IT IS NOT ANTICIPATED THAT DIVERSION MEASURES WILL BE NECESSARY.

### 1.4.6 SLOW DOWN CHANNELIZED RUNOFF

CHECK STRUCTURES SHALL BE UTILIZED TO REDUCE THE VELOCITY, AND THUS THE EROSIVE POTENTIAL, OF CONCENTRATED FLOW IN CHANNELS.

STONE CHECK DAMS ARE NOT ANTICIPATED TO BE NEEDED AS DESIGNED.

### 1.4.7 CONSTRUCT PERMANENT CONTROLS

PERMANENT STORMWATER TREATMENT DEVICES SHALL BE INSTALLED AS SHOWN ON THE PLANS AND IN ACCORDANCE WITH PERMIT CONDITIONS.

### 1.4.8 STABILIZE EXPOSED SOILS DURING CONSTRUCTION

ALL AREAS OF DISTURBANCE MUST HAVE TEMPORARY STABILIZATION IN PLACE WITHIN 48 HOURS OF DISTURBANCE OR IN ACCORDANCE WITH THE CONSTRUCTION GENERAL PERMIT 3-9020 AUTHORIZATION.

SURFACE ROUGHENING OF ALL EXPOSED SLOPES, COMBINED WITH TEMPORARY MULCHING, SHALL BE UTILIZED ON A REGULAR BASIS. BIODEGRADABLE EROSION CONTROL MATTING OR AN EQUIVALENT SHALL BE USED TO STABILIZE ALL SLOPES STEEPER THAN 1:3.

THE FORECAST OF RAINFALL EVENTS SHALL TRIGGER IMMEDIATE PROTECTION OF EXPOSED SOILS.

TEMPORARY EROSION CONTROL MATTING WILL BE INSTALLED AS PROPOSED ON THE EPSC PLAN, AT A MINIMUM.

### 1.4.9 WINTER STABILIZATION

VARIOUS MEASURES SPECIFIC TO WINTER MAY BE NECESSARY SHOULD THE PROJECT EXTEND INTO WINTER (OCTOBER 15 THROUGH APRIL 15). REFER TO THE LOW RISK SITE HANDBOOK FOR GUIDANCE.

### 1.4.10 STABILIZE SOIL AT FINAL GRADE

EXPOSED SOIL MUST BE STABILIZED WITHIN 48 HOURS OF REACHING FINAL GRADE.

SEED, MULCH, FERTILIZER AND LIME SHALL BE USED TO ESTABLISH PERMANENT VEGETATION. FOR SLOPES STEEPER THAN 1:3, BIODEGRADABLE EROSION CONTROL MATTING OR AN EQUIVALENT SHALL BE USED INSTEAD OF MULCH.

### 1.4.11 DE-WATERING ACTIVITIES

DISCHARGE FROM DEWATERING ACTIVITIES THAT FLOWS OFF OF THE CONSTRUCTION SITE MUST NOT CAUSE OR CONTRIBUTE TO A VIOLATION OF THE VERMONT WATER QUALITY STANDARDS.

### 1.4.12 INSPECT YOUR SITE

INSPECT THE PROJECT SITE BASED ON SPECIAL PROVISION REQUIREMENTS OR CONSTRUCTION GENERAL PERMIT AUTHORIZATION STIPULATIONS.

## 1.5 SEQUENCE AND STAGING

THIS SECTION WILL BE DEVELOPED BY THE CONTRACTOR USING THE GUIDANCE OUTLINED IN THE VTRANS EPSC PLAN CONTRACTOR CHECKLIST.

### 1.5.1 OFF-SITE ACTIVITIES

IN ADDITION TO THE CONTRACTOR CHECKLIST, ANY ACTIVITIES OUTSIDE THE CONSTRUCTION LIMITS SHALL FOLLOW SUBSECTION 105.25 - 105.29 OF THE STANDARD SPECIFICATIONS FOR CONSTRUCTION.

CLD 12-0120 MODEL: 01

CONSULTING ENGINEERS

PROJECT NAME: STOWE
PROJECT NUMBER: BRF 0235(15)

FILE NAME: z88cl90erodet.dgn
PROJECT LEADER: J. BYATT
DESIGNED BY: S. FORTIER
EPSC NARRATIVE

PLOT DATE: 5/8/2015
DRAWN BY: S. FORTIER
CHECKED BY: K. RUTTER
SHEET 70 OF 79

N

VT STATE PLANE GRID

**COLTON–DUXBURY COMPLEX**
**(NOT HIGHLY ERODIBLE)**
**K–FACTOR = 0.17, 2%–8% SLOPES**
**HYDROLOGICAL SOIL GROUP: A**

**PODUNK FINE SANDY LOAM**
**(NOT HIGHLY ERODIBLE)**
**K–FACTOR = 0.24, 0%–2% SLOPES**
**HYDROLOGICAL SOIL GROUP: B**

MATCH LINE 14+75

BIKE PATH

VT 108 WEST
TO CAMBRIDGE

S 65° 19' 55.45" E

11+00 12+00 13+00 14±00

AER E&T

STOWE COUNTRY CLUB

STOWE GOLF PARK

SUN AND SKI INN

ROCK GDN

ROCK GARDEN

PAVED DRIVE

BRICK

RESTROOM

WOODS

BRUSH

BM#10
RRSIR M.BSPRUCE
ELEV:

TIE 77/35/5
TIE=47.3

SGR WITH STEEL POSTS

TEL JCT BOX #1 78/57

WARNING BICYCLES

SLOW

HVCTRL

VCV

LAST SWC IS SWC2 ST

RHODODENDRON (2)

PROPANE GAS

WEST BRANCH OF LITTLE RIVER FLOW

## LEGEND

SOIL TYPE BOUNDARY

RIPARIAN BUFFER ZONE

SCALE 1" = 20'-0"
20 0 20

79-2

CONSULTING ENGINEERS

| | |
|---|---|
| PROJECT NAME: STOWE | |
| PROJECT NUMBER: BRF 0235(15) | |
| FILE NAME: z88cl90bdreroex.dgn | PLOT DATE: 5/8/2015 |
| PROJECT LEADER: J. BYATT | DRAWN BY: S. FORTIER |
| DESIGNED BY: S. FORTIER | CHECKED BY: K. RUTTER |
| EPSC EXISTING CONDITIONS SHEET 1 | SHEET 71 OF 79 |

CLD 12-0120 MODEL: 01

## LEGEND

SOIL TYPE BOUNDARY

RIPARIAN BUFFER ZONE

N

VT STATE PLANE GRID

VT108 STA 15+50.00 ±
CHANNEL STA 52+00.00
△ = 50° 00' 00"
(TANGENT TO CURVE)

50' RIPARIAN BUFFER

CHANNEL STA 53+50.00

WEST BRANCH OF FLOW
LITTLE RIVER

**COLTON–DUXBURY COMPLEX**
**(NOT HIGHLY ERODIBLE)**
**K–FACTOR = 0.17, 2%–8% SLOPES**
**HYDROLOGICAL SOIL GROUP: A**

MEMORIAL SANDRA GAMOREFF

WOODS

BIKE PATH

GARBAGE

BRUSH

PARK BENCH
FLOWER GDN.
WITH SITTING BENCH

S.W.BIRCH (3)
M.POP
S.POP
S.POP (3)

S.BALSUM

FISHERIES–
COLD WATER

S.WBIRCH (3)
S.WBIRCH (2)
CONIF

BRIDGE 3 VT 108

SL 30

MATCH LINE 14+75

CHANNEL LINE
N 41° 21' 18.84" E

WEST BRANCH OF
LITTLE RIVER

CHANNEL
STA 50+75.00

**LYMAN–TUNBRIDGE**
**FINE SANDY LOAMS,**
**VERY ROCKY**
**(NOT HIGHLY ERODIBLE)**
**K–FACTOR = 0.28, 25%–60% SLOPES**
**HYDROLOGICAL SOIL GROUP: D**

PLUGGED
STONE
HEADWALL

GRAVEL ROAD

MEADOW LANE
(TH 38)

M.APPLE

LILAC

M.MASH

M.CEDARS

FLOWERS

GRAPES

POOL IN
GROUND

STONE HEADWALL

WOODS

LEDGE

FENCE

SEWER LINE

HVCTRL

AER E&T

UT

W

S

D

P L

53+00
52+00
51+00
19+00
18+00
17+00
16+00
15+00
20+00
21+00
41+00
42+00
43+00

N 64° 06' 12.06" E

N 50° 27' 12.70" E

Φ MEADOW LANE

STOP

WARNING

4" PVC
STAND PIPE

M.SPRUCE

GRAVEL
DRIVE

WOOD
FENCE

GABLE INN

FLOWERS

BRIDAL WREATH

THANK YOU

SHRUB

YEW

LILAC

M.BSPRUCE

2 STORY
BUILDING

THE GABLES INN
& RESTAURANT

HOT TUB

AIR
CONDITION
UNIT

ROSE & FLOWERS

GABLES INN

VT 108 EAST
TO STOWE

L.MAPLE
M.MAPLE

**LYMAN–TUNBRIDGE**
**FINE SANDY LOAMS, VERY ROCKY**
**(NOT HIGHLY ERODIBLE)**
**K–FACTOR = 0.28, 25%–60% SLOPES**
**HYDROLOCIGAL SOIL GROUP: D**

SCALE 1" = 20'-0"
20 0 20

CONSULTING ENGINEERS

| | |
|---|---|
| PROJECT NAME: STOWE | |
| PROJECT NUMBER: BRF 0235(15) | |
| FILE NAME: z88c190bdreroex.dgn | PLOT DATE: 5/8/2015 |
| PROJECT LEADER: J. BYATT | DRAWN BY: S. FORTIER |
| DESIGNED BY: S. FORTIER | CHECKED BY: K. RUTTER |
| EPSC EXISTING CONDITIONS SHEET 2 | SHEET 72 OF 79 |

CLD 12-020 MODEL: 02

N

VT STATE PLANE GRID

PROJECT DEMARCATION FENCE
10+12 TO 13+72 RT
10+00 TO 14+26 LT


TEMPORARY EROSION MATTING
13+00 TO 14+80 RT
13+00 TO 14+75 LT

BARRIER FENCE
14+26 TO 14+75 LT

GEOTEXTILE FOR SILT FENCE
10+00 TO 14+25 LT
10+12 TO 13+75 RT

GEOTEXTILE FOR SILT FENCE, WOVEN WIRE REINFORCED
14+25 TO 14+75 LT
13+75 TO 14+65 RT

GEOTEXTILE FOR FILTER CURTAIN
14+62 TO 14+75 RT

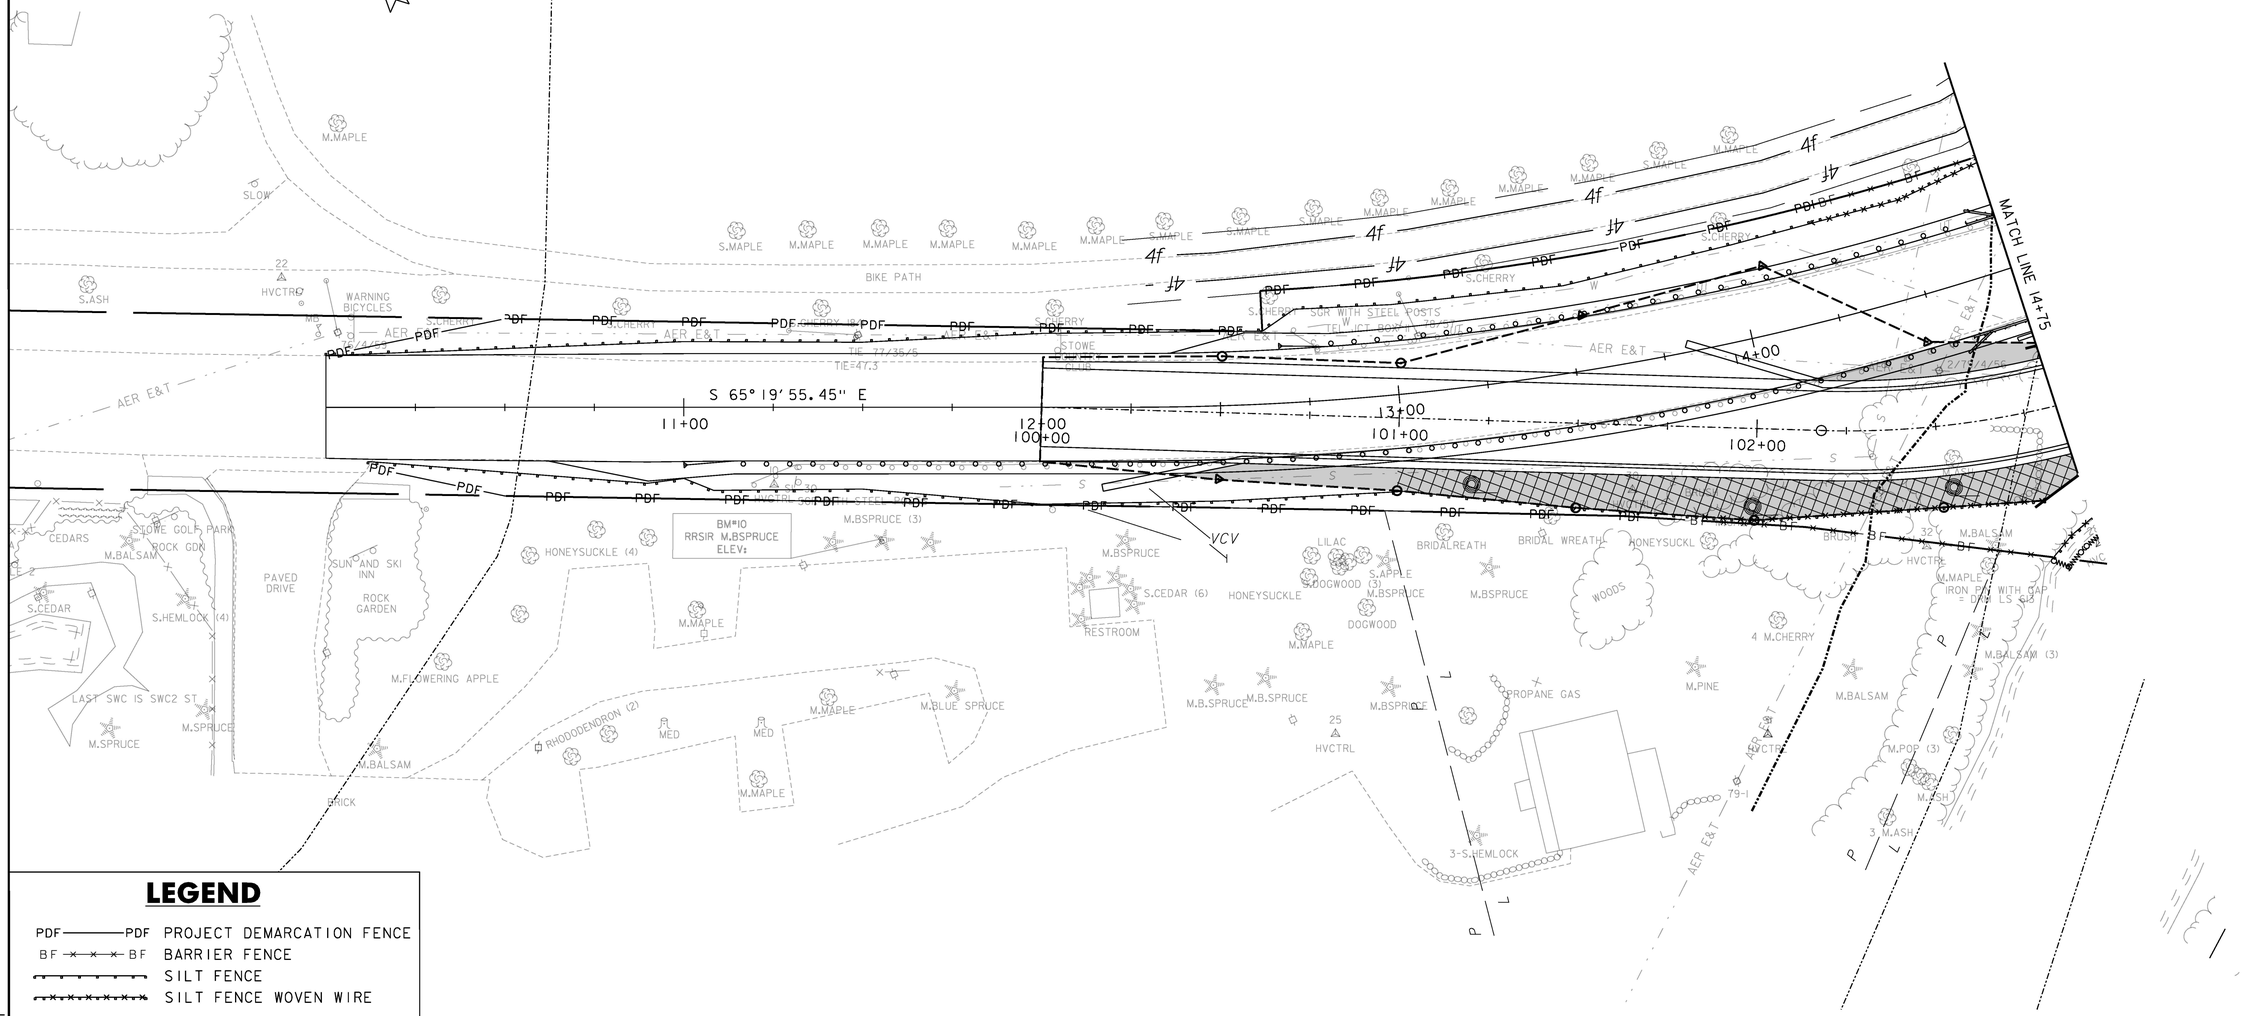


## LEGEND

- PDF——PDF PROJECT DEMARCATION FENCE
- BF—×—×—BF BARRIER FENCE
- SILT FENCE
- SILT FENCE WOVEN WIRE
- DISTURBED AREAS REQUIRING TEMPORARY RE-VEGETATION
- TEMPORARY EROSION MATTING
- SOIL TYPE BOUNDARY
- RIPARIAN BUFFER ZONE
- FILTER CURTAIN

SCALE 1" = 20'-0"
20 0 20

CONSULTING ENGINEERS

| | |
|---|---|
| PROJECT NAME: | STOWE |
| PROJECT NUMBER: | BRF 0235(15) |
| FILE NAME: z88cl90bdrerocn.dgn | PLOT DATE: 5/8/2015 |
| PROJECT LEADER: J. BYATT | DRAWN BY: S. FORTIER |
| DESIGNED BY: S. FORTIER | CHECKED BY: K. RUTTER |
| EPSC CONSTRUCTION PLAN SHEET 1 | SHEET 73 OF 79 |

MODEL: 01
CLD 12-0120

N

VT STATE PLANE GRID

PROJECT DEMARCATION FENCE
18+66 TO 21+00 RT
17+73 TO 21+00 LT
40+35 TO 41+81 RT
42+22 TO 43+14 RT

BARRIER FENCE
14+75 TO 15+60 LT
16+44 TO 17+73 LT

GEOTEXTILE FOR SILT FENCE
WOVEN WIRE REINFORCED
16+64 TO 17+74 LT
50+80 TO 52+50 LT (CHANNEL)
51+50 TO 52+90 RT (CHANNEL)

GEOTEXTILE FOR SILT FENCE
17+74 TO 21+00 RT

GEOTEXTILE FOR FILTER CURTAIN
50+80 TO 52+50 LT
51+50 TO 52+90 RT

VT108 STA 15+50.00 ±
CHANNEL STA 52+00.00
△ = 50° 00' 00"
(TANGENT TO CURVE)

50' RIPARIAN BUFFER

FISHERIES-
COLD WATER

MATCH LINE 14+75


BRIDGE 3 VT 108

THE GABLES INN
& RESTAURANT

## LEGEND

- PDF——PDF PROJECT DEMARCATION FENCE
- BF ×—×—× BF BARRIER FENCE
- SILT FENCE
- SILT FENCE WOVEN WIRE
- DISTURBED AREAS REQUIRING TEMPORARY RE-VEGETATION
- TEMPORARY EROSION MATTING
- SOIL TYPE BOUNDARY
- RIPARIAN BUFFER ZONE
- FILTER CURTAIN

SCALE 1" = 20'-0"
20 0 20

CLD CONSULTING ENGINEERS

| | |
|---|---|
| PROJECT NAME: | STOWE |
| PROJECT NUMBER: | BRF 0235(15) |
| FILE NAME: z88cl90bdrerocn.dgn | PLOT DATE: 5/8/2015 |
| PROJECT LEADER: J. BYATT | DRAWN BY: S. FORTIER |
| DESIGNED BY: S. FORTIER | CHECKED BY: K. RUTTER |
| EPSC CONSTRUCTION PLAN SHEET 2 | SHEET 74 OF 79 |

CLD 12-0120 MODEL: 02

PERMANENT EROSION MATTING
13+00 TO 14+75 LT
13+00 TO 14+71 RT

PROPOSED 12" WATER
BY OTHERS

MATCH LINE 14+75

EXISTING STATE
RIGHT-OF-WAY

WEST BRANCH OF
LITTLE RIVER
FLOW

BIKE PATH


STOWE GOLF PARK


PAVED DRIVE

ROCK GDN

ROCK GARDEN

RESTROOM

BRICK

LAST SWC IS SWC2 ST

WOODS

BM#10
RRSIR W.BSPRUCE
ELEV:

## LEGEND

- SOIL TYPE BOUNDARY
- RIPARIAN BUFFER ZONE
- DISTURBED AREAS REQUIRING RE-VEGETATION
- TEMPORARY EROSION MATTING
- STONE FILL, TYPE II

NOTES:

1. SEE CROSS SECTIONS FOR FINISHED GRADING.

SCALE 1" = 20'-0"
20 0 20

CONSULTING ENGINEERS

| | |
|---|---|
| PROJECT NAME: | STOWE |
| PROJECT NUMBER: | BRF 0235(15) |
| FILE NAME: z88cl90bdrerofl.dgn | PLOT DATE: 5/8/2015 |
| PROJECT LEADER: J. BYATT | DRAWN BY: S. FORTIER |
| DESIGNED BY: S. FORTIER | CHECKED BY: K. RUTTER |
| EPSC FINAL PLAN SHEET 1 | SHEET 75 OF 79 |

CLD 12-0120 MODEL: 01

## LEGEND

- SOIL TYPE BOUNDARY
- RIPARIAN BUFFER ZONE
- DISTURBED AREAS REQUIRING RE-VEGETATION
- TEMPORARY EROSION MATTING
- STONE FILL, TYPE II

PERMANENT EROSION MATTING
14+75 TO 15+04 LT
17+00 TO 18+50 LT

N

VT STATE PLANE GRID

VT108 STA 15+50.00 ±
CHANNEL STA 52+00.00
Δ = 50° 00' 00"
(TANGENT TO CURVE)

50' RIPARIAN BUFFER

CHANNEL STA 53+50.00

WEST BRANCH OF LITTLE RIVER

PROPOSED 12" WATER
BY OTHERS

EXISTING TOWN
RIGHT-OF-WAY

EXISTING STATE
RIGHT-OF-WAY

FISHERIES-
COLD WATER

MATCH LINE 14+75

CHANNEL LINE
N 41° 21' 18.84" E

CHANNEL
STA 50+75.00

MEADOW LANE
(TH 38)

REMOVE
18" CMP

N 64° 06' 12.06" E

N 50° 27' 12.70" E

40+77.5 RT — 40+49.3 LT
NEW 18"x22" CREPSL
W/ FES AT OUTLET
CONSTRUCT RC STRAIGHT
HW @ INLET
STONE FILL, TYPE II
AT OUTLET (3'x6')

THE GABLES INN
& RESTAURANT

SCALE 1" = 20'-0"
20 0 20

CLD CONSULTING ENGINEERS

| | |
|---|---|
| PROJECT NAME: | STOWE |
| PROJECT NUMBER: | BRF 0235(15) |
| FILE NAME: z88cl90bdrerofl.dgn | PLOT DATE: 5/8/2015 |
| PROJECT LEADER: J. BYATT | DRAWN BY: S. FORTIER |
| DESIGNED BY: S. FORTIER | CHECKED BY: K. RUTTER |
| EPSC FINAL PLAN SHEET 2 | SHEET 76 OF 79 |

CLD 12-0120 MODEL: 02

## VAOT RURAL AREA MIX

| LBS/AC | | | | | |
|---|---|---|---|---|---|
| % WEIGHT | BROADCAST | HYDROSEED | NAME | GERM % | PURITY % |
| 37.5% | 22.5 | 45 | CREEPING RED FESCUE | 85% | 98% |
| 37.5% | 22.5 | 45 | TALL FESCUE | 90% | 95% |
| 5.0% | 3 | 6 | RED TOP | 90% | 95% |
| 15.0% | 9 | 18 | BIRDSFOOT TREFOIL | 85% | 98% |
| 5.0% | 3 | 6 | ANNUAL RYE GRASS | 85% | 95% |
| 100% | 60 | 120 | | | |

## VAOT URBAN AREA MIX

| LBS/AC | | | | | |
|---|---|---|---|---|---|
| % WEIGHT | BROADCAST | HYDROSEED | NAME | GERM % | PURITY % |
| 42.5% | 34 | 68 | CREEPING RED FESCUE | 85% | 98% |
| 10.0% | 8 | 16 | PERENNIAL RYE GRASS | 90% | 95% |
| 42.5% | 34 | 68 | KENTUCKY BLUE GRASS | 85% | 85% |
| 5.0% | 4 | 8 | ANNUAL RYE GRASS | 85% | 95% |
| 100% | 80 | 160 | | | |

## SOIL AMENDMENT GUIDANCE

| FERTILIZER | | LIME | |
|---|---|---|---|
| BROADCAST | HYDROSEED | BROADCAST | HYDROSEED |
| 10-20-10 | *FOLLOW* | PELLETIZED | *FOLLOW* |
| 500 LBS/AC | *MANUFACTURER* | 2 TONS/AC | *MANUFACTURER* |


### CONSTRUCTION GUIDANCE

1. RURAL SEED MIX: USE AS INDICATED IN THE PLANS AND/OR FOR ALL ESTABLISHED UPLAND (NON WETLAND) AREAS DISTURBED BY THE CONTRACTOR.
2. URBAN SEED MIX: USE AS INDICATED IN THE PLANS AND/OR FOR ALL ESTABLISHED LAWN AREAS DISTURBED BY THE CONTRACTOR.
3. ALL SEED MIXTURES: SHALL NOT HAVE A WEED CONTENT EXCEEDING 0.40% BY WEIGHT AND SHALL BE FREE OF ALL NOXIOUS SEED.
4. FERTILIZER AND LIMESTONE: SHALL FOLLOW RATES SHOWN ON PLAN OR AS DIRECTED BY THE ENGINEER.
5. HAY MULCH: TO BE PLACED ON EARTH SLOPES AT THE RATE OF 2 TONS/ACRE, ACHIEVE 90% GROUND COVER OR AS DIRECTED BY THE ENGINEER.
6. TOPSOIL: TO BE USED WITH SEED AS INDICATED ON THE PLANS, OR AS DIRECTED BY THE ENGINEER.
7. HYDROSEEDING: ALTHOUGH GUIDANCE IS GIVEN ABOVE THE SITE CONDITIONS AND THE TYPE OF HYDROSEED WILL ULTIMATELY DICTATE THE AMOUNTS AND TYPES OF SOIL AMENDMENTS TO BE APPLIED.
8. TURF ESTABLISHMENT: PLACING SEED, FERTILIZER, LIME AND MULCH PRIOR TO SEPTEMBER 15 AND AFTER APRIL 15 CAN BETTER ENSURE A VIGOROUS GROWTH OF GRASS.

ADAPTED FROM VTRANS TECHNICAL LANDSCAPE MANUAL FOR ROADWAYS AND TRANSPORTATION FACILITIES

# TURF ESTABLISHMENT

| REVISIONS | |
|---|---|
| JUNE 23, 2009 | WHF |
| JANUARY 15, 2010 | WHF |
| FEBRUARY 16, 2011 | WHF |
| | |
| | |

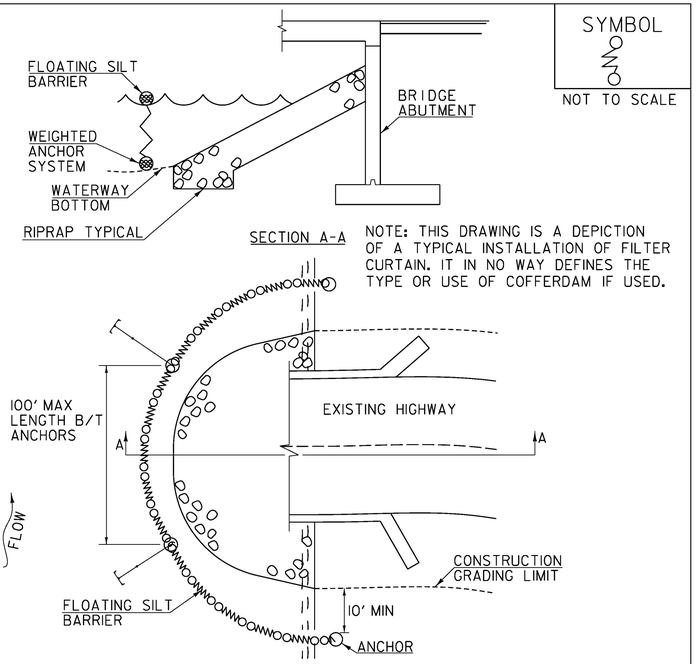



### CONSTRUCTION SPECIFICATIONS

1. FILTER CURTAIN SHALL NOT BE PLACED ACROSS A FLOWING WATERWAY, OR IN A WATERWAY WITH STREAM VELOCITIES GREATER THAN 1.5 FEET/SECOND.
2. MAXIMUM 100' LENGTH BETWEEN ANCHORS.
3. LAST SECTION SHALL TERMINATE A MINIMUM OF 10' BEYOND LIMIT OF DISTURBANCE.
4. THE WEIGHTED ANCHOR SYSTEM SHALL BE A TYPE WHICH ALLOWS THE CURTAIN TO CONFORM TO THE BOTTOM OF THE WATERWAY.
5. THE CURTAIN SHALL BE REMOVED BY SLOWLY PULLING TOWARD THE SHORE MINIMIZING THE ESCAPE OF SEDIMENTS INTO WATERWAY.

# FILTER CURTAIN

THIS WORK SHALL BE PERFORMED IN ACCORDANCE WITH SECTION 649 FOR GEOTEXTILE FOR FILTER CURTAIN (PAY ITEM 649.61).

| REVISIONS | |
|---|---|
| APRIL 1, 2008 | WHF |
| JANUARY 13, 2009 | WHF |
| SEPTEMBER 4, 2009 | WHF |
| | |
| | |

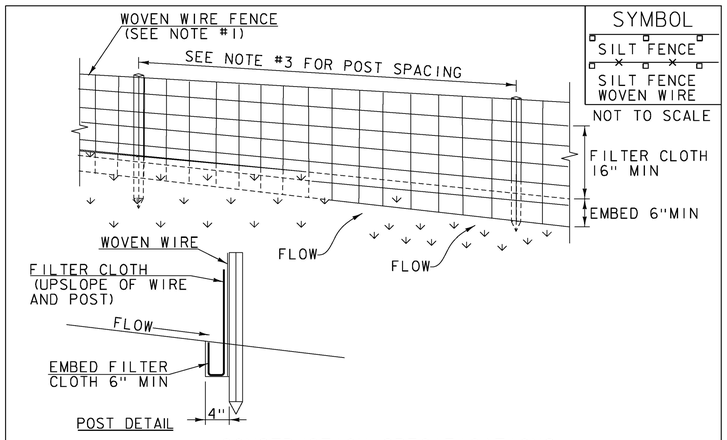


### CONSTRUCTION SPECIFICATIONS

1. WOVEN WIRE REINFORCED FENCE IS REQUIRED WITHIN 100' UPSLOPE OF RECEIVING WATERS WHEN THE PROJECT FALLS UNDER A CONSTRUCTION STORMWATER PERMIT. WOVEN WIRE SHALL BE A MIN. 14 GAUGE WITH A 6" MAX. MESH OPENING.
2. FILTER CLOTH SHALL BE EITHER FILTER X, MIRAFI100X, STABILINKA T140N OR APPROVED EQUIVALENT.
3. POST SPACING FOR WIRE-BACKED FENCE SHALL BE 10' MAXIMUM. FOR FILTER-CLOTH FENCE, WHEN ELONGATION IS >50%, POST SPACING SHALL NOT EXCEED 4' AND WHEN ELONGATION IS <50%, POST SPACING SHALL NOT EXCEED 6'.
4. WOVEN WIRE FENCE IS TO BE FASTENED SECURELY TO FENCE POSTS WITH WIRE TIES. FILTER CLOTH IS TO BE FASTENED SECURELY TO WOVEN WIRE FENCE WITH TIES SPACED EVERY 24" AT TOP AND MID SECTION.
5. WHEN TWO SECTIONS OF FILTER CLOTH ADJOIN EACH OTHER THEY SHALL BE OVER-LAPPED BY 6" AND FOLDED.
6. MAINTENANCE SHALL BE PERFORMED AS NEEDED AND MATERIAL REMOVED WHEN SEDIMENT REACHES HALF OF FABRIC HEIGHT.

ADAPTED FROM DETAILS PROVIDED BY: NEW YORK STATE DEC ORIGINALLY DEVELOPED BY USDA-NRCS VERMONT DEPARTMENT OF ENVIRONMENTAL CONSERVATION

# SILT FENCE

NOTES:
REFER TO "THE VERMONT STANDARDS & SPECIFICATIONS FOR EROSION PREVENTION & SEDIMENT CONTROL -2006- "FROM THE VT AGENCY OF NATURAL RESOURCES FOR ADDITIONAL GUIDANCE.

THIS WORK SHALL BE PERFORMED IN ACCORDANCE WITH SECTION 649 AND AS SHOWN IN THE PLANS FOR GEOTEXTILE FOR SILT FENCE (PAY ITEM 649.51) OR GEOTEXTILE FOR SILT FENCE, WOVEN WIRE REINFORCED (PAY ITEM 649.515).

| REVISIONS | |
|---|---|
| MARCH 21, 2008 | WHF |
| DECEMBER 11, 2008 | WHF |
| JANUARY 13, 2009 | WHF |
| | |
| | |


CLD 12-0120 MODEL: 02

CLD CONSULTING ENGINEERS

PROJECT NAME: STOWE
PROJECT NUMBER: BRF 0235(15)

FILE NAME: z88cl90erodet.dgn
PROJECT LEADER: J. BYATT
DESIGNED BY: S. FORTIER
EPSC DETAILS 1

PLOT DATE: 5/8/2015
DRAWN BY: S. FORTIER
CHECKED BY: K. RUTTER
SHEET 77 OF 79

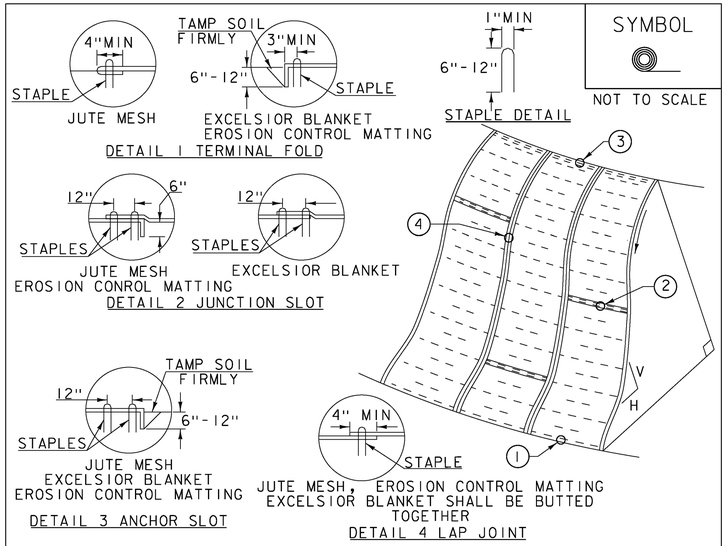


SYMBOL

NOT TO SCALE

## CONSTRUCTION SPECIFICATIONS


1. APPLY TO SLOPES GREATER THAN 3H:1V OR WHERE NECESSARY TO AID IN ESTABLISHING VEGETATION.
2. APPLY FERTILIZER, LIME AND SEED PRIOR TO PLACING MATTING.
3. STAPLES ARE TO BE PLACED ALTERNATELY, IN COLUMNS APPROXIMATELY 2' APART AND IN ROWS APPROXIMATELY 3' APART. APPROXIMATELY 175 STAPLES ARE REQUIRED PER 4'X225' ROLL OF MATERIAL AND 125 STAPLES ARE REQUIRED PER 4'X150' ROLL OF MATERIAL.
4. DISTURBED AREAS SHALL BE SMOOTHLY GRADED. EROSION CONTROL MATERIAL SHALL BE PLACED LOOSELY OVER GROUND SURFACE. DO NOT STRETCH.
5. ALL TERMINAL ENDS AND TRANSVERSE LAPS SHALL BE STAPLED AT APPROXIMATELY 12" INTERVALS.

ADAPTED FROM DETAILS PROVIDED BY: NEW YORK STATE DEC
ORIGINALLY DEVELOPED BY USDA-NRCS
VERMONT DEPARTMENT OF ENVIRONMENTAL CONSERVATION

# ROLLED EROSION CONTROL PRODUCT (RECP) SIDE SLOPE

NOTES:
REFER TO "THE VERMONT STANDARDS & SPECIFICATIONS FOR EROSION PREVENTION & SEDIMENT CONTROL -2006- " FROM THE VT AGENCY OF NATURAL RESOURCES FOR ADDITIONAL GUIDANCE.
THIS WORK SHALL BE PERFORMED IN ACCORDANCE WITH SECTION 653 AND AS SHOWN IN THE PLANS FOR TEMPORARY EROSION MATTING (PAY ITEM 653.20) OR PERMANENT EROSION MATTING (PAY ITEM 653.21).

| REVISIONS | |
|---|---|
| APRIL 16, 2007 | JMF |
| JANUARY 13, 2009 | WHF |

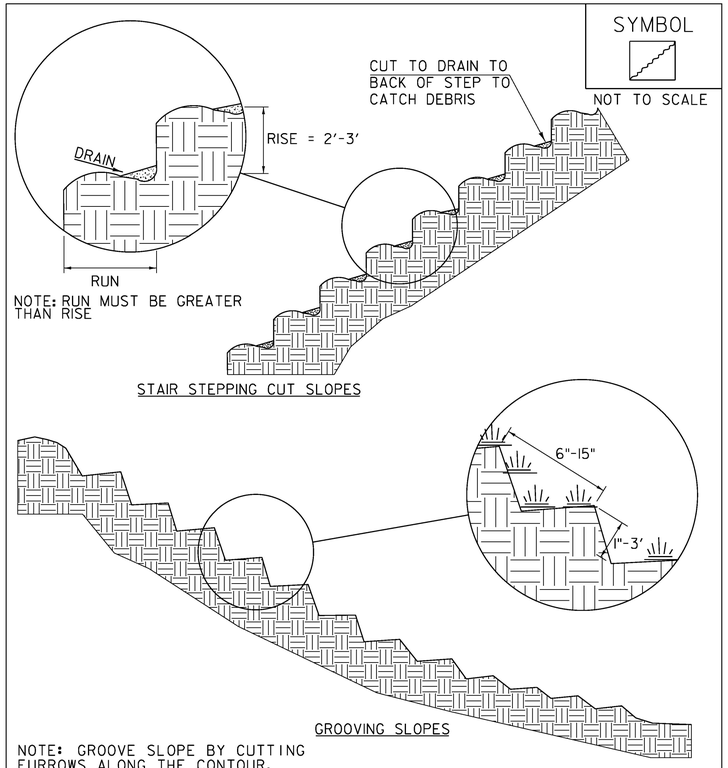


SYMBOL

NOT TO SCALE

NOTE: RUN MUST BE GREATER THAN RISE

STAIR STEPPING CUT SLOPES

GROOVING SLOPES

NOTE: GROOVE SLOPE BY CUTTING FURROWS ALONG THE CONTOUR. IRREGULARITIES IN THE SOIL SURFACE CATCH RAINWATER AND RETAIN LIME, FERTILIZER AND SEED.

ADAPTED FROM DETAILS PROVIDED BY: NEW YORK STATE DEC
ORIGINALLY DEVELOPED BY USDA-NRCS
VERMONT DEPARTMENT OF ENVIRONMENTAL CONSERVATION

# SURFACE ROUGHENING

NOTES:
REFER TO "THE VERMONT STANDARDS & SPECIFICATIONS FOR EROSION PREVENTION & SEDIMENT CONTROL -2006- " FROM THE VT AGENCY OF NATURAL RESOURCES FOR ADDITIONAL GUIDANCE.

THIS WORK SHALL BE CONSIDERED INCIDENTAL TO THE CONTRACT

| REVISIONS | |
|---|---|
| APRIL 1, 2008 | WHF |
| JANUARY 13, 2009 | WHF |

CLD 12-0120 MODEL: 03

CONSULTING ENGINEERS

| | |
|---|---|
| PROJECT NAME: | STOWE |
| PROJECT NUMBER: | BRF 0235(15) |
| FILE NAME: z88cl90erodet.dgn | PLOT DATE: 5/8/2015 |
| PROJECT LEADER: J. BYATT | DRAWN BY: S. FORTIER |
| DESIGNED BY: S. FORTIER | CHECKED BY: K. RUTTER |
| EPSC DETAILS 2 | SHEET 78 OF 79 |

# Town of Stowe
# Gables Bridge Water Main Relocation
# Plan View

DETAIL "B"

STA 0+00 - 1+70
PROPOSED 12' DUCTILE
IRON WATER MAIN

STA 1+70 - 4+80
PROPOSED 14" HDPE WATER MAIN
DIRECTIONALLY DRILLED/INSTALLED

DETAIL "C"

DETAIL "A"

VERIFY SEWER INVERT

12" GATE VALVE
STA. 104+39

12"x6" TEE w/HYD.
STA. 101+25

12"-45°
STA. 100+99

12"-45°
STA. 100+38

24"ø STEEL CASING
STA. 100+40 TO STA. 100+97

CASING
TO 105+01

BRIDGE #3

CORE BRIDGE ABUTMENT (TYP.)

12"-45°
STA. 104+47, LIMITS
OF BRIDGE CROSSING

12"-22½°
STA. 102+76, LIMITS
OF BRIDGE CROSSING

12" GATE VALVE
STA. 102+56

DETAIL "D"

ROUTE 108

MOUNTAIN ROAD

WEST BRANCH LITTLE RIVER

MATCH TO

THE GABLES INN

PLAN
SCALE: 1" = 40'

STOWE
BRF 0235(15)
SHEET 79 OF 79
FOR REFERENCE ONLY


TOWN OF STOWE
DEPARTMENT OF PUBLIC WORKS
PO BOX 730
67 MAIN STREET
STOWE, VT 05672

PROJECT Gables Bridge Water Main Relocation
SHEET NO. 2 OF 3
CALCULATED BY RLG DATE 12/06/2013
CHECKED BY DATE
SCALE 1" = 40' PROJECT NO. 12013.01


CLD 12-0120 MODEL: Reference

## CONCRETE GENERAL NOTES

1. ALL EXPOSED EDGES OF CONCRETE SHALL BE CHAMFERED 1" x 1"
2. REINFORCING STEEL SIZE AND SPACING SHOWN IN THE PLANS IS BASED ON 60 KSI STEEL, UNLESS NOTED OTHERWISE. WITH THE ENGINEER'S PERMISSION, BAR SIZE AND SPACING MAY BE MODIFIED ACCORDING TO THE LATEST AASHTO LRFD BRIDGE DESIGN SPECIFICATION AND STRUCTURES DESIGN MANUAL WHEN USING HIGHER STRENGTH STEEL.

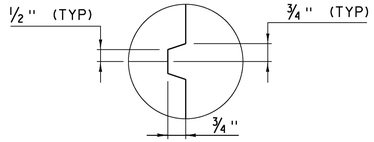



SCORE MARK DETAIL
(NOT TO SCALE)

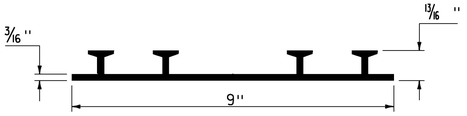


P.V.C. WATERSTOP FOR CONSTRUCTION JOINTS
(NOT TO SCALE)


PAYMENT FOR THE P.V.C. WATERSTOP SHALL BE INCIDENTAL TO THE UNIT BID PRICE FOR THE ADJACENT CONCRETE.

OTHER CONFIGURATIONS OF WATERSTOP MAY BE USED UPON APPROVAL OF THE ENGINEER.

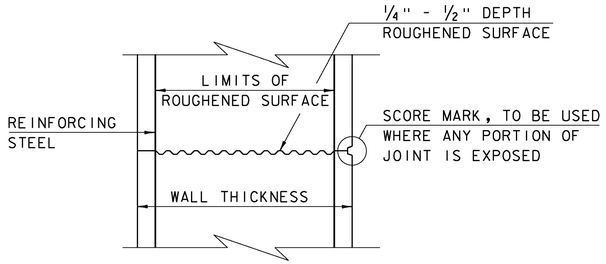



TYPICAL HORIZONTAL CONSTRUCTION JOINT
(NOT TO SCALE)

1. THE SURFACE OF THE CONCRETE CONSTRUCTION JOINTS SHALL BE CLEANED AND FREE OF LAITANCE.
2. IMMEDIATELY BEFORE NEW CONCRETE IS PLACED, ALL CONSTRUCTION JOINTS SHALL BE WETTED AND STANDING WATER REMOVED.

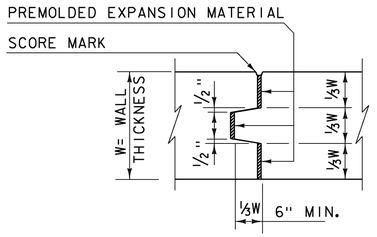



TYPICAL CONCRETE EXPANSION JOINT
(NOT TO SCALE)

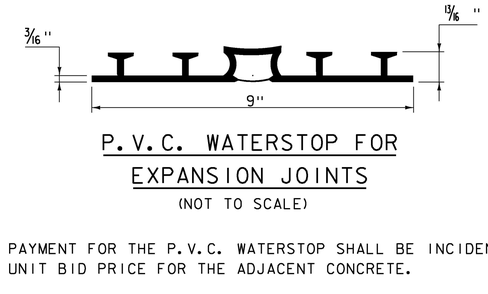



P.V.C. WATERSTOP FOR EXPANSION JOINTS
(NOT TO SCALE)

PAYMENT FOR THE P.V.C. WATERSTOP SHALL BE INCIDENTAL TO THE UNIT BID PRICE FOR THE ADJACENT CONCRETE.


OTHER CONFIGURATIONS OF WATERSTOP MAY BE USED UPON APPROVAL OF THE ENGINEER.

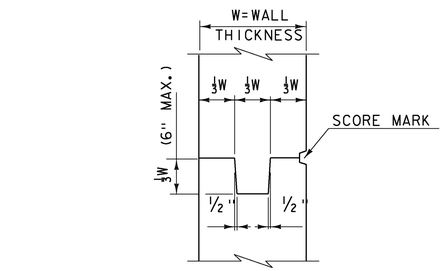


TYPICAL CONCRETE CONSTRUCTION JOINT
(NOT TO SCALE)

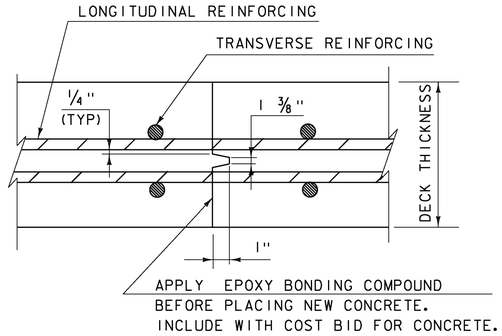


TRANSVERSE BRIDGE SLAB CONSTRUCTION JOINT DETAILS
(NOT TO SCALE)

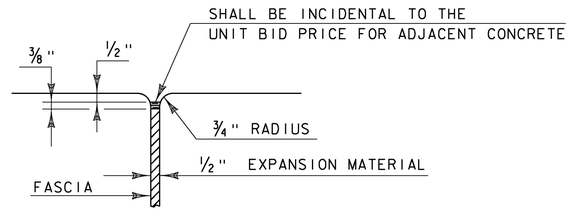



JOINT BETWEEN FASCIA AND WINGWALL
(NOT TO SCALE)

| REVISIONS | |
|---|---|
| MAY 7, 2010 | APPROVED FOR USE BY VAOT STRUCTURES SECTION |
| FEBRUARY 9, 2012 | REBAR SUBSTITUTION ALLOWANCE ADDED TO CONCRETE GENERAL NOTES. |
| | |
| | |
| | |
| | |
| | |
| | |


# CONCRETE DETAILS AND NOTES

VERMONT AGENCY OF TRANSPORTATION
STRUCTURES - SECTION


STRUCTURES DETAIL
SD-501.00

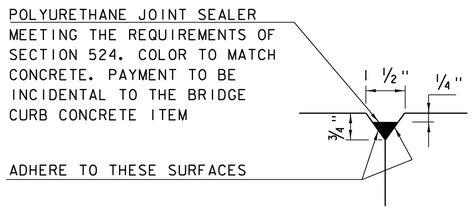



DETAIL "B"
(NOT TO SCALE)

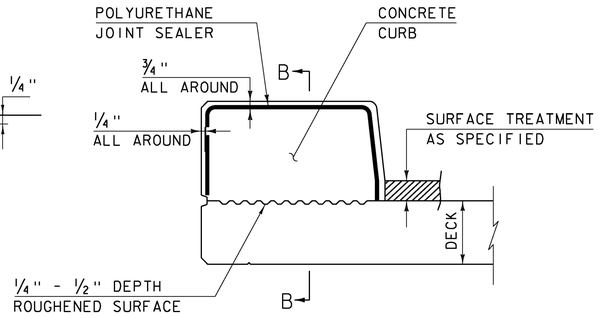


CONCRETE CURB JOINT SECTION
(NOT TO SCALE)

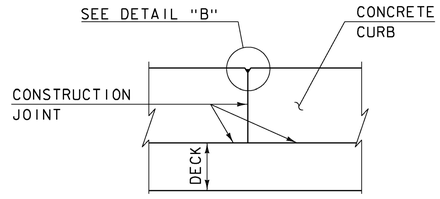


SECTION B - B
(NOT TO SCALE)

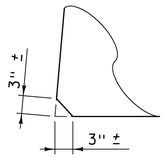


ACUTE ANGLE CLIP DETAIL
(NOT TO SCALE)

1. SEE TYPICAL HORIZONTAL CONSTRUCTION JOINT DETAIL FOR ADDITIONAL INFORMATION

## CONCRETE CURB JOINT NOTES

1. CONCRETE CURBS MAY BE PLACED IN ONE CONTINUOUS OPERATION IF AN APPROVED SHRINKAGE REDUCING ADMIXTURE LISTED IN THE SPECIAL PROVISIONS IS USED WITH THE CONCRETE MIX DESIGN. PAYMENT FOR THE SHRINKAGE REDUCING ADMIXTURE WILL BE INCIDENTAL TO THE BRIDGE CURB CONCRETE ITEM.


2. IF THE CONTRACTOR CHOOSES NOT TO USE AN APPROVED SHRINKAGE REDUCING ADMIXTURE, THE CURBS SHALL BE CONSTRUCTED WITH CONSTRUCTION JOINTS SPACED AT A MAXIMUM OF 15'-0" CENTER TO CENTER AND 2'-0" MINIMUM FROM THE CENTER OF NEAREST BRIDGE RAILING POST.

3. ON MULTI-SPAN CONTINUOUS SUPERSTRUCTURES, REGARDLESS OF WHETHER APPROVED SHRINKAGE REDUCING ADMIXTURE IS USED, CURB JOINTS SHALL BE LOCATED OVER THE CENTERLINE OF PIERS AND 7'-0" EACH SIDE OF THE CENTERLINE OF EACH PIER.


4. WHEN CURB JOINTS ARE USED THE CURBS SHALL BE PLACED IN ALTERNATE SECTIONS WITH A MINIMUM OF 48 HOUR DELAY BETWEEN ADJACENT PLACEMENTS.

5. LONGITUDINAL REINFORCING SHALL BE CONTINUOUS THROUGH CURB CONSTRUCTION JOINTS. CURB STIRRUP BARS SHALL BE TURNED AS NECESSARY TO MAINTAIN COVER IN THE FLARED CURB ENDS.


6. THE JOINT SPACING AND DETAILS SHOWN SHALL APPLY TO SIDEWALKS WHEN SHOWN IN THE PLANS.

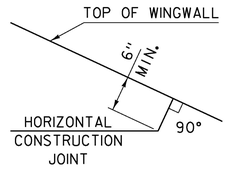



HORIZONTAL WINGWALL CONSTRUCTION JOINT
(NOT TO SCALE)

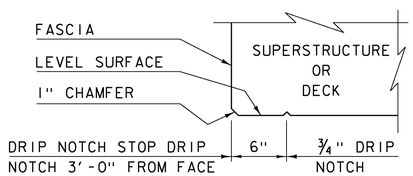


DRIP NOTCH DETAIL
(NOT TO SCALE)

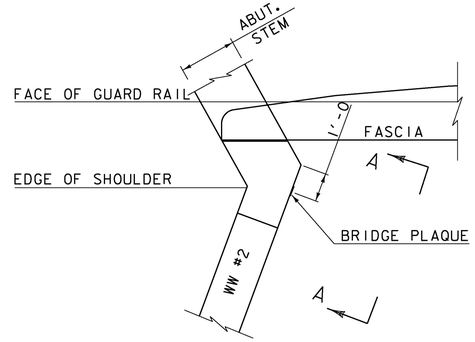


PLAN

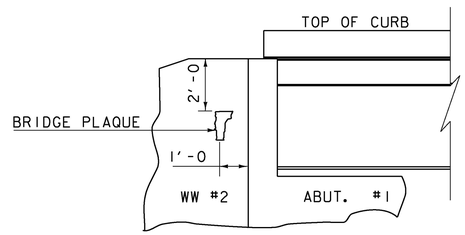


VIEW "A - A"

BRIDGE PLAQUE
(NOT TO SCALE)

THE BRIDGE PLAQUE WILL BE SUPPLIED BY THE AGENCY OF TRANSPORTATION AND SHALL BE INSTALLED BY THE CONTRACTOR AT ABUTMENT #1 ON THE RIGHT SIDE AS SHOWN OR AS DIRECTED BY THE ENGINEER.


PAYMENT FOR INSTALLATION OF THE BRIDGE PLAQUE SHALL BE INCIDENTAL TO THE ADJACENT CONCRETE.

| REVISIONS | |
|---|---|
| MAY 7, 2010 | APPROVED FOR USE BY VAOT STRUCTURES SECTION |
| JUNE 4, 2010 | MODIFIED AND ADDED TWO DETAILS |
| OCTOBER 10, 2012 | MODIFIED HORZ. JOINT WINGWALL ADD 6" MIN. DIMENSION |
| | |
| | |
| | |
| | |
| | |

# CONCRETE DETAILS AND NOTES

VERMONT AGENCY OF TRANSPORTATION
STRUCTURES - SECTION

STRUCTURES DETAIL
SD-502.00

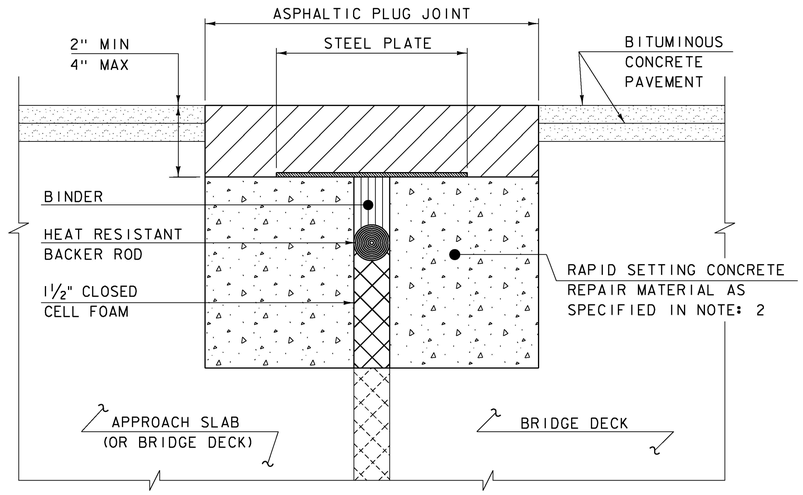


## ASPHALTIC PLUG JOINT DETAIL - REHAB


NOTES:

1. THE CONTRACTOR SHALL REMOVE ALL ASPHALTIC PLUG JOINT MATERIAL AND DETERIORATED CONCRETE AS DIRECTED BY THE ENGINEER. REMOVAL OF THE FIRST 4 INCHES OF MATERIAL SHALL BE INCLUDED IN THE BID PRICE FOR ITEM 516.10 BRIDGE EXPANSION JOINT, ASPHALTIC PLUG. ANY REMOVAL OF MATERIAL GREATER THAN 4 INCHES SHALL BE INCLUDED IN THE BID PRICE OF ITEM 580.20 RAPID SETTING CONCRETE REPAIR MATERIAL WITH COARSE AGGREGATE.

2. THE CONTRACTOR SHALL REPLACE REMOVED MATERIAL THAT IS LESS THAN 4" FROM FINISHED GRADE WITH ASPHALTIC PLUG JOINT MATERIAL MEETING THE REQUIREMENTS OF SUBSECTION 707.15. ALL REMOVED MATERIAL THAT IS GREATER THAN 4 INCHES FROM FINISHED GRADE SHALL BE REPLACED WITH RAPID SETTING CONCRETE REPAIR MATERIAL WITH COARSE AGGREGATE MEETING THE REQUIREMENTS OF SUBSECTION 780.04.


3. REINFORCING STEEL NOT SHOWN FOR CLARITY.

4. PLACE 1/4" THICK BY 8" WIDE SECTIONS OF STEEL PLATE OVER THE CENTER OF THE MOVEMENT GAP. SECURE THE PLATES FROM MOVING BY INSERTING LOCATING PINS THROUGH THE PRE-STAMPED HOLES INTO BACKER ROD AND COVER WITH HOT BINDER. THE STEEL PLATES MAY BE OMITTED WHERE THE ENGINEER DETERMINES THAT THE APPROACH SLAB OR BRIDGE DECK WILL PROVIDE INADEQUATE SUPPORT AND WHERE VERTICAL MOVEMENT OF THE PLATES MIGHT OCCUR.

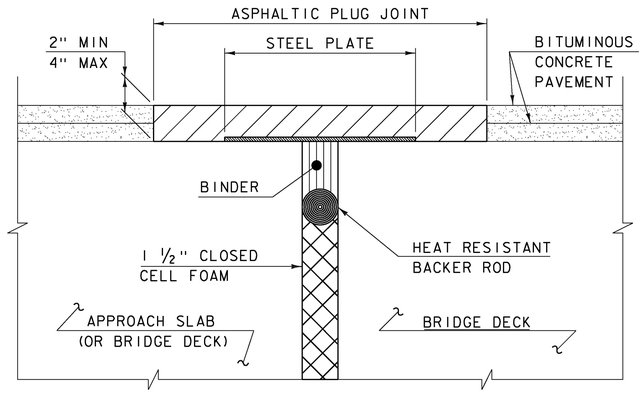


## ASPHALTIC PLUG JOINT DETAIL "A" - NEW

NOTE:
PLACE 1/4" THICK BY 8" WIDE SECTIONS OF STEEL PLATE OVER THE CENTER OF THE MOVEMENT GAP. SECURE THE PLATES FROM MOVING BY INSERTING LOCATING PINS THROUGH THE PRE-STAMPED HOLES INTO BACKER ROD AND COVER WITH HOT BINDER.

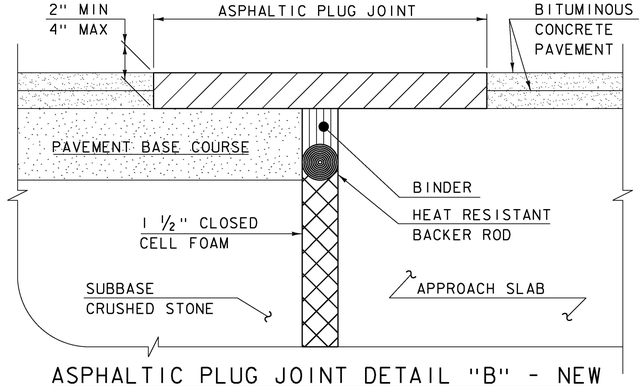


## ASPHALTIC PLUG JOINT DETAIL "B" - NEW

## ASPHALTIC PLUG JOINT NOTES

INSTALLATION:

1. LOCATE THE JOINT CENTRALLY OVER THE DECK OVERLAY EXPANSION GAP OR FIXED JOINT, MARKED OUT TO THE MANUFACTURER'S RECOMMENDED WIDTH.
2. REMOVE THE BITUMINOUS CONCRETE PAVEMENT FULL DEPTH AS SHOWN ON THE PLANS. THE PAVEMENT SHALL BE DRY AND SAW CUT TO THE LIMITS REQUIRED TO PLACE THE JOINT. A PNEUMATIC HAMMER AND CHISEL MAY BE USED ADJACENT TO THE CURB ONLY WHEN SAW CUTTING IS NOT POSSIBLE.
3. BLAST CLEAN THE JOINT AREA OF DEBRIS, ASPHALT AND SHEET MEMBRANE. THOROUGHLY DRY THE JOINT AREA WITH COMPRESSED AIR PRIOR TO APPLYING BINDER MATERIAL.
4. PLACE PROPERLY SIZED HEAT RESISTANT BACKER ROD IN THE MOVEMENT GAP ALLOWING FOR 1" +/- OF BINDER ABOVE THE ROD.
5. HEAT AND PLACE THE BINDER MATERIAL AS RECOMMENDED BY THE MANUFACTURER.
6. IMMEDIATELY AFTER TOP COATING, CAST AN ANTI-SKID MATERIAL OVER THE JOINT TO REDUCE THE RISK OF TRACKING.

WEATHER LIMITATIONS

APPLY BINDER MATERIAL ONLY WHEN THE FOLLOWING CONDITIONS PREVAIL OR AS RECOMMENDED BY THE MANUFACTURER:

1. THE AMBIENT AIR TEMPERATURE IS AT LEAST 10 DEG C (50 DEG F) AND RISING.
2. THE ROAD SURFACE IS DRY.
3. WEATHER CONDITIONS OR OTHER CONDITIONS ARE FAVORABLE AND ARE EXPECTED TO REMAIN SO FOR THE PERFORMANCE OF SATISFACTORY WORK.


DETAILS ON THIS SHEET ARE NOT TO SCALE.

| REVISIONS | |
|---|---|
| MAY 7, 2010 | APPROVED FOR USE BY VAOT STRUCTURES SECTION |
| AUGUST 29, 2011 | ADD DETAIL "B" AND REV. NOTES |
| | |
| | |
| | |
| | |
| | |
| | |

# BRIDGE JOINT
# ASPHALTIC PLUG


VERMONT AGENCY OF TRANSPORTATION
STRUCTURES - DIVISION

STRUCTURES DETAIL
SD-516.10

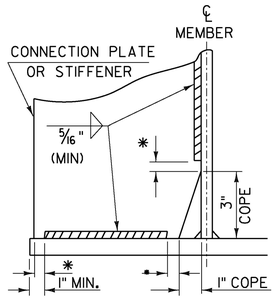



## WELD TERMINATION AND COPING DETAILS FOR STEEL MEMBERS

*NO WELD FOR 3/8" MIN. 7/8" MAX. (EXCEPT MUST MAINTAIN 1" MINIMUM FROM EDGE OF FLANGE)

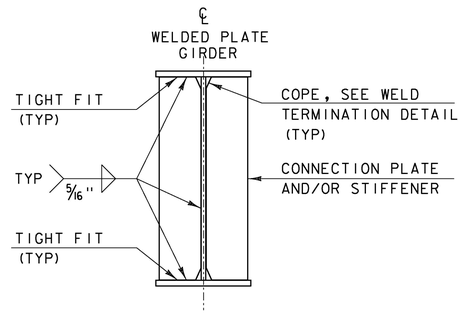



## INTERMEDIATE CONNECTION PLATES AND/OR STIFFENERS FOR WELDED PLATE GIRDERS


INTERMEDIATE DETAIL IS ONLY USED WHEN PLATE DOES NOT OCCUR AT AN ABUTMENT OR PIER.

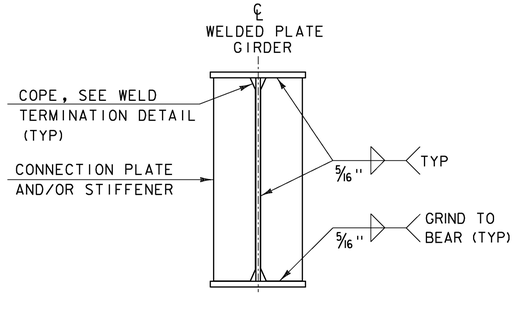


## ABUTMENT BEARING STIFFENERS AND/OR CONNECTION PLATES FOR WELDED PLATE GIRDERS

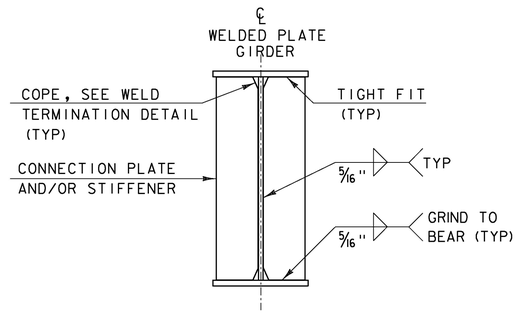



## PIER BEARING STIFFENERS AND/OR CONNECTION PLATES FOR WELDED PLATE GIRDERS

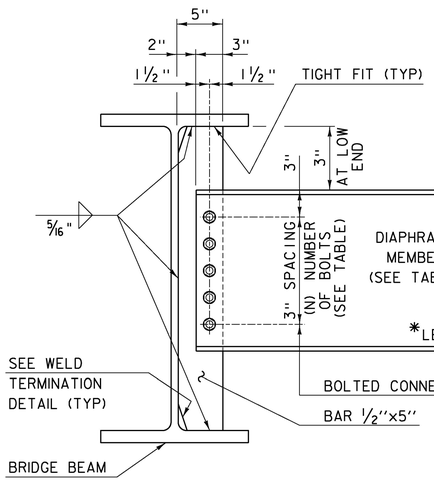



| DEPTH | | DIAPHRAGM MEMBER | (N) BOLTS |
|---|---|---|---|
| ROLLED BEAM | 24" 30" | C15x33.9 | 4 |
| | 31" 36" | MC18x42.7 | 5 |
| | 37" 42" | W21x44 | 6 |
| PLATE GIRDER WEB | 31" 36" | W27x84 | 7 |
| | 37" 42" | W33x118 | 9 |
| | 43" 48" | W36x135 | 10 |

## INTERMEDIATE DIAPHRAGMS FOR 24" TO 48" BRIDGE BEAMS

*IF CLEARANCE CANNOT BE MET, DIAPHRAGM MAY BE SLOPED.

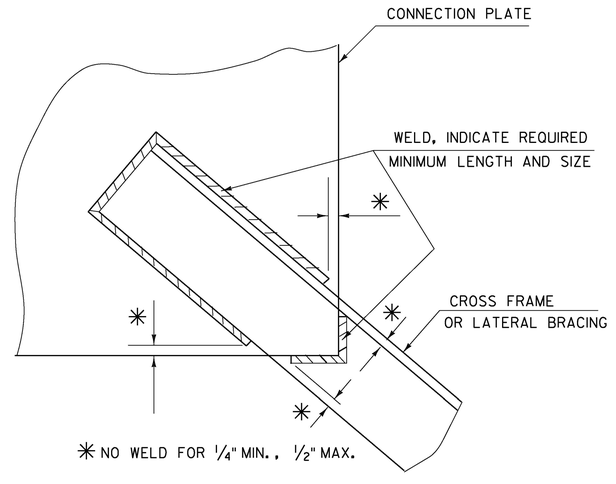


## WELD LOCATION DETAIL AT CROSS FRAMES AND LATERAL BRACING

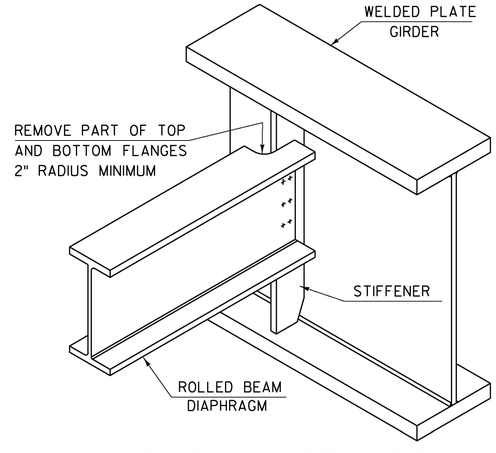


SEE CONTRACT DRAWINGS FOR SIZES OF MEMBERS AND CONNECTION DETAILS

## ROLLED BEAM USED AS DIAPHRAGM


DETAILS ON THIS SHEET ARE "NOT TO SCALE" UNLESS NOTED OTHERWISE.

| REVISIONS | |
|---|---|
| MAY 7, 2010 | APPROVED FOR USE BY VAOT STRUCTURES SECTION |
| MAY 2, 2011 | ADD INTERMEDIATE DIAPHRAGMS DETAIL & ADD NOT TO SCALE NOTE |
| | |
| | |
| | |
| | |
| | |

# STRUCTURAL STEEL PLATE GIRDER DETAILS AND NOTES


VERMONT AGENCY OF TRANSPORTATION
STRUCTURES - SECTION

STRUCTURES DETAIL
SD-602.00

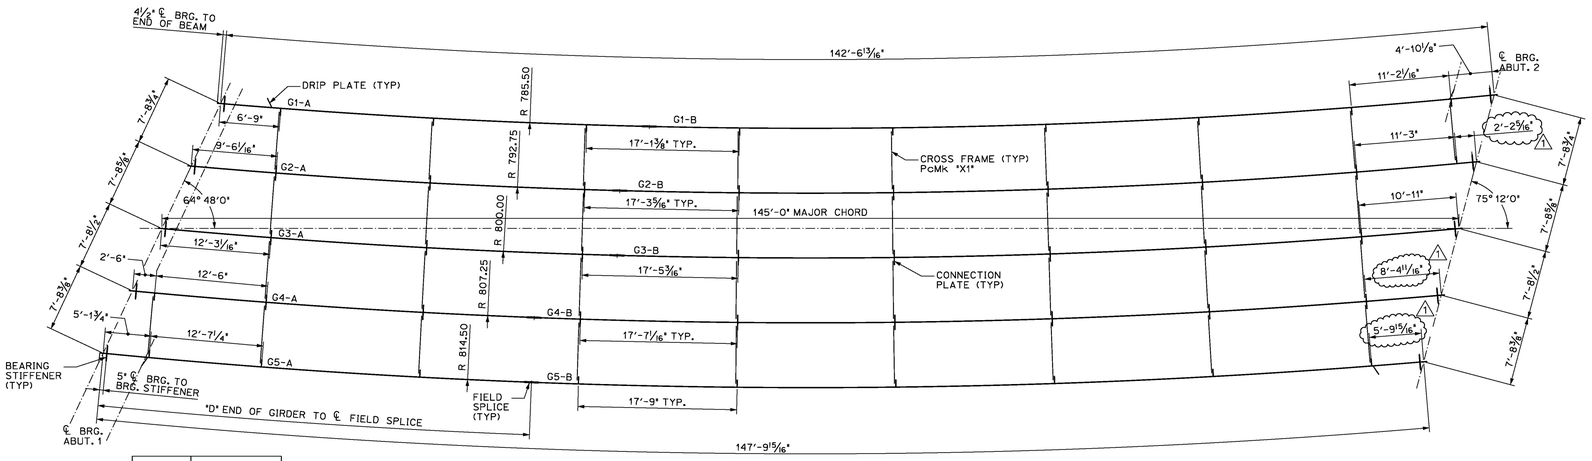



| GIRDER | "D" DIMENSION |
|---|---|
| G1 | 48'-0" |
| G2 | 48'-0" |
| G3 | 51'-0" |
| G4 | 45'-0" |
| G5 | 48'-0" |

## FRAMING PLAN
SCALE: ⅛" = 1'-0"

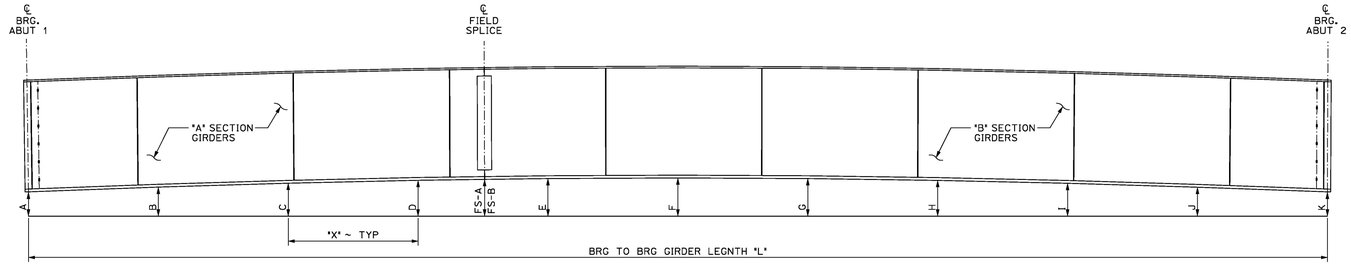



## BLOCKING DIAGRAM ~ SEE CHART
NTS
ALL DIMENSIONS ARE TO THE OUTSIDE OF BOTTOM FLANGES

| | BRG TO BRG GIRDER LENGTH "L" | 10 SPACES AT "X" | ABUT 1 ℄ BRG. "A" | 0.10L "B" | 0.20L "C" | 0.30L "D" | FIELD SPLICE FS-A | FIELD SPLICE FS-B | 0.40L "E" | 0.50L "F" | 0.60L "G" | 0.70L "H" | 0.80L "I" | 0.90L "J" | ABUT 2 ℄ BRG. "K" |
|---|---|---|---|---|---|---|---|---|---|---|---|---|---|---|---|
| GIRDER 1 | 142'-6 13/16" | 14'-3/16" | 6" | 8⅝" | 11" | 1'-0⅜" | 1'-0¾" | 1'-0¾" | 1'-1⅜" | 1'-1 1/16" | 1'-1⅜" | 1'-0⅜" | 11" | 8⅝" | 6" |
| GIRDER 2 | 143'-10 9/16" | 14'-4 1/16"* | 6" | 8⅞" | 11½" | 1'-1" | 1'-1⅝" | 1'-1⅝" | 1'-2" | 1'-2⅛" | 1'-2" | 1'-1" | 11½" | 8⅞" | 6" |
| GIRDER 3 | 145'-2⅜" | 14'-6¼"* | 6" | 9⅜" | 11 13/16" | 1'-1¾" | 1'-2⅜" | 1'-2⅜" | 1'-2 5/16" | 1'-3⅝" | 1'-2 5/16" | 1'-1¾" | 11 13/16" | 9⅜" | 6" |
| GIRDER 4 | 146'-6⅛" | 14'-7 13/16"* | 6" | 9⅞" | 1'=0 5/16" | 1'-2 7/16" | 1'-2½" | 1'-2⅝" | 1'-3¾" | 1'-4¼" | 1'-3¾" | 1'-2⅝" | 1'=0 5/16" | 9⅞" | 6" |
| GIRDER 5 | 147'-9 15/16" | 14'-9 7/16"* | 6" | 9¾" | 1'-0⅞" | 1'-3¼" | 1'-3⅝" | 1'-3⅝" | 1'-4¾" | 1'-5¼" | 1'-4¾" | 1'-3¼" | 1'-0⅞" | 9¾" | 6" |

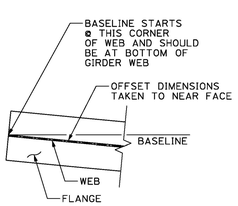


## BASELINE DETAIL
N.T.S.

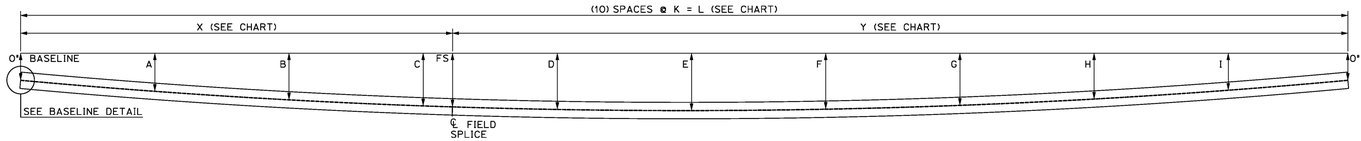


## ASSEMBLED GIRDER SWEEP DETAIL
SCALE: ⅛" = 1'-0"

| SWEEP DIMENSIONS | | | | | | | | | | | | | | |
|---|---|---|---|---|---|---|---|---|---|---|---|---|---|---|
| GIRDER | K | L | X | Y | A | B | C | FS | D | E | F | G | H | I |
| G1 | 14'-3¾"* | 143'-1⅝" | 48'-3⅜" | 94'-9¾" | 1'-2⅛" | 2'-1 1/16" | 2'-8 15/16" | 2'-11 1/16" | 3'-1⅝" | 3'-3⅜" | 3'-1⅝" | 2'-8 15/16" | 2'-1⅛" | 1'-2⅛" |
| G2 | 14'-5⅝"* | 144'-5⅛" | 48'-3⅜" | 96'-1 11/16" | 1'-2¼" | 2'-1⅝" | 2'-9¼" | 2'-11 1/16" | 3'-2" | 3'-3⅜" | 3'-2" | 2'-9¼" | 2'-1⅝" | 1'-2¼" |
| G3 | 14'-6⅞"* | 145'-8 15/16" | 51'-3⅝" | 94'-5⅝" | 1'-2⅜" | 2'-1⅜" | 2'-9⅜" | 3'-0 1/16" | 3'-2⅝" | 3'-3 15/16" | 3'-2⅝" | 2'-9⅜" | 2'-1⅜" | 1'-2⅜" |
| G4 | 14'-8⅞"* | 147'-0⅝" | 45'-3⅜" | 101'-9⅞" | 1'-2½" | 2'-1 3/16" | 2'-9⅝" | 2'-10 5/16" | 3'-2 11/16" | 3'-4¼" | 3'-2 11/16" | 2'-9⅞" | 2'-1 3/16" | 1'-2⅝" |
| G5 | 14'-10"* | 148'-4⅜" | 48'-3 1/16" | 100'-1 5/16" | 1'-2⅝" | 2'-2" | 2'-10⅛" | 2'-11 1/16" | 3'-3" | 3'-4⅝" | 3'-3" | 2'-10⅛" | 2'-2 1/16" | 1'-2 11/16" |

## GENERAL FABRICATION NOTES

MATERIAL SPECIFICATIONS

1.) ALL MATERIAL SHALL BE AASHTO M270 GRADE 50W (UNO)

2.) ALL M270 GRADE 50 MATERIAL DENOTED "CVN" SHALL MEET THE CHARPY V-NOTCH TESTING REQUIREMENTS OF ZONE 2, H FREQUENCY: 15 FT-LB AT 40° (UP TO 2" WELDED)

ITEMS SHALL CALL OUT "CVN" FOR EACH APPLICABLE ITEM IN THE BILL OF MATERIALS

3.) BOLTS SHALL BE HIGH STRENGTH BOLTS ASTM A325, TYPE 3
NUTS SHALL BE A563 GRADE C3 OR DH3
WASHERS SHALL BE ASTM F436, TYPE 3

BOLTS AND NUTS SHALL BE ROTATIONAL CAPACITY TESTED. DO NOT MIX NUTS AND BOLTS FROM DIFFERENT CONTAINERS UNLESS ALL NUTS AND BOLTS HAVE THE SAME LOT NUMBER.

FABRICATION

1.) DIE STAMPING IS ALLOWED IN SPECIFIC LOCATIONS WITH THE APPROVAL OF THE ENGINEER.

2.) ALL EDGES OF FLAME CUT MATERIAL SUBJECTED TO CALCULATED STRESSES SHALL BE ROUNDED TO A MINIMUM RADIUS OF 1/16" per STANDARD SPEC. 506.12(d)

3.) ALL PLATES, FLAME CUT FROM LARGER PLATES, SHALL BE CUT SO THAT THE PRIMARY DIRECTION OF ROLLING IS PARALLEL TO THE MAIN TENSILE OR COMPRESSIVE STRESS per STANDARD 506.08 of 2011 SPECIFICATIONS.

4.) FLANGE PLATE MATERIAL SHALL HAVE AN EDGE HARDNESS NOT GREATER THAN HRc 30, ALLOWED per STANDARD SPEC. 506.09.

WELDING

1.) ALL WELDING PROCEDURES SHALL BE IN ACCORDANCE WITH THE PROVISIONS OF SUBSECTION 506.10.

2.) NON DESTRUCTIVE TESTING OF WELDS SHALL BE IN ACCORDANCE WITH ANSI/AASHTO/AWS D1.5 ~ SECTION 6. FLANGE WELDS WILL BE CALLED OUT AS BEING IN EITHER COMPRESSION OR TENSION. WEB WELDS WILL LABEL EITHER TOP OR BOTTOM AS BEING IN COMPRESSION, OR BE LABELED AS BEING IN A STRESS REVERSAL AREA.

FLANGE SPLICES SHALL BE TESTED AS FOLLOWS:
FLANGE SPLICES IN TENSION ~ TESTED 100%
FLANGE SPLICES IN STRESS REVERSAL AREAS ~ TESTED 100%
FLANGE SPLICES IN COMPRESSION ~ TESTED 25%

WEB SPLICES SHALL BE TESTED AS FOLLOWS:
FOR 1/6 THE DEPTH OF THE WEB (TENSION AREA) ~ TESTED 100%
FOR THE REMAINING DEPTH OF WEB (COMPRESSION AREA) ~ TESTED 25 %

FOR 1/6 DEPTH OF THE WEB @ TOP & BTM. (STRESS REVERSAL) ~ TESTED 100%
THE REMAINING 2/3 OF THE WEB ~ TESTED 25%

3.) TERMINATE STIFFENER WELDS AS SHOWN IN THE "WELD TERMINATION DETAILS" ON SHEETS M2 & M3

FIELD CONNECTIONS

1.) FIELD BOLTS SHALL HAVE A HEAVY HEX NUT, HEX HEAD, AND ONE HARDENED WASHER EACH.

2.) PIECE MARKS WILL BE LOCATED AS SHOWN ON ERECTION DRAWINGS. ALL ERECTION MARKS, MATCH MARKS, AND WEIGHT MARKS MUST NOT BE EXPOSED IN THE FINISHED STRUCTURE.

3.) HARDENED WASHERS ARE REQUIRED OVER OVERSIZED HOLES.

CLEANING AND PAINTING

1.) UNPAINTED STEEL SHALL BE BLAST CLEANED TO SSPC SP-6 TO ACHIEVE A UNIFORM WEATHERED APPEARANCE.

## SHOP DRAWING REVIEW

[X] REVIEWED AS REQUIRED BY THE CONSTRUCTION CONTRACT DOCUMENTS AND APPROVED, BUT ONLY FOR CONFORMANCE TO THE DESIGN CONCEPT OF THE WORK, AND SUBJECT TO FURTHER LIMITATIONS AND REQUIREMENTS CONTAINED IN THE CONSTRUCTION CONTRACT DOCUMENTS.

[ ] REJECTED [ ] REVISE AND RESUBMIT [ ] APPROVED AS NOTED

CORRECTIONS OR COMMENTS MADE ON THE SHOP DRAWINGS DURING THIS REVIEW DID NOT RELIEVE CONTRACTOR FROM COMPLIANCEWITH REQUIREMENTS OF THE DRAWINGS AND SPECIFICATIONS. THIS CHECK IS ONLY FOR REVIEW OF GENERAL CONFORMANCE WITH THE DESIGN CONCEPT OF THE PROJECT AND GENERAL COMPLIANCE WITH THE INFORMATION GIVEN IN THE CONTRACT DOCUMENTS. THE CONTRACTOR IS RESPOINSIBLE FOR: CONFIRMING AND CORRELATING ALL QUANTITIES AND DIMENSIONS: SELECTING FABRICATION PROCESSES AND TECHNIQUES OF CONSTRUCTION: COORDINATING THEIR WORK WITH THAT OF ALL OTHER TRADES: AND PERFORMING THEIR WORK IN A SAFE AND SATISFACTORY MANNER.

CLD Consulting Engineers
540 Commercial Street
Manchester, NH 03101
603-668-8223

Job Number: 12-0120
Reviewed by: JF
Date: 11/17/15

| | | | | |
|---|---|---|---|---|
| FINISH | N/A | | | |
| MATERIAL | SEE DETAIL SHEETS | | | |
| HOLES | | | | |
| ELECTRODES | PER WELD PROCEDURE | | | |
| WELDS | PER WELD PROCEDURE | | | |
| SURFACE PREP | | 1 | 11/16/15 | Addressed Comments DLM |
| | | NO | DATE | DESCRIPTION BY |
| | | REVISIONS | | |


ARC ENTERPRISES, INC.


ADVANCED RESOURCES & CONST. ENTERPRISES, INCORPORATED
P.O. BOX 120 KINGFIELD, ME. 04947
PHONE: (207) 265-2646 – FAX: (207) 265-4054


| | |
|---|---|
| DRAFTER | DLM |
| DATE | OCT. 2015 |
| CHECKED | JJH |
| DATE | OCT. 2015 |

PROPOSED SHOP SPLICE LOCATIONS
STOWE, VT. Route 108 (Major Collector) Bridge No. 3
Project No. BRF 0235(15)
cc: CCS CONSTRUCTORS, INC.


PROJECT NO. 15-144
DWG. NO. 1

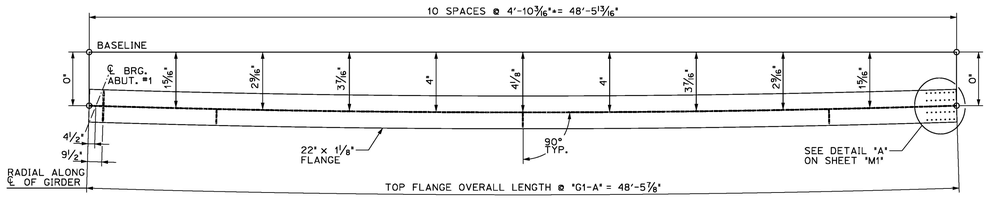

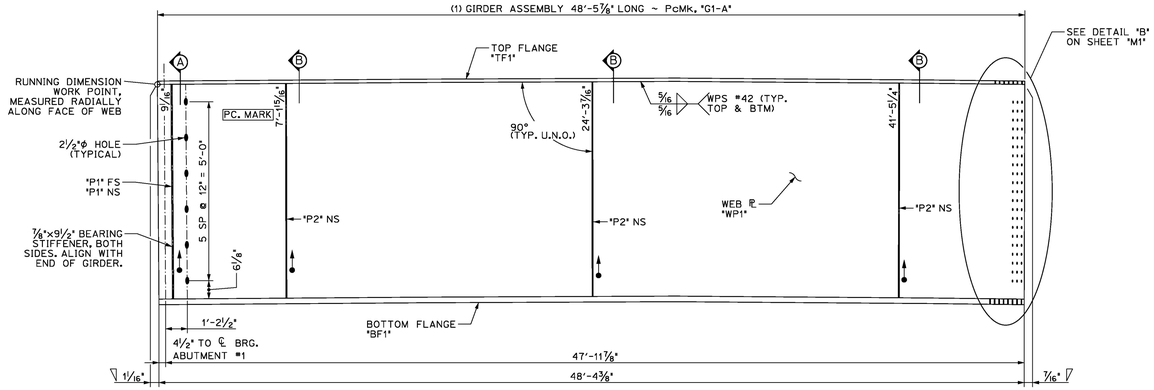


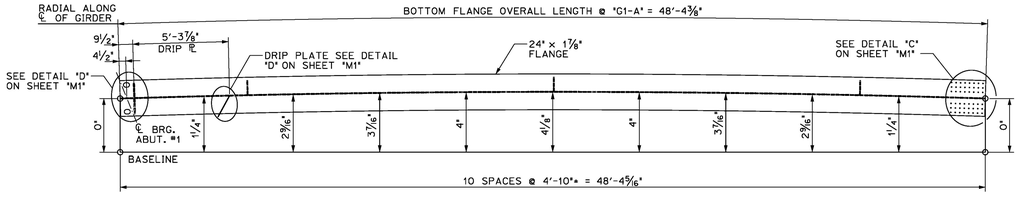

1/2 DIMENSIONAL PLANS & ELEVATIONS ~ GIRDER "G1-A"
HORIZONTAL SCALE: 1/4" = 1'-0"
VERTICAL SCALE EXAGGERATED 2:1

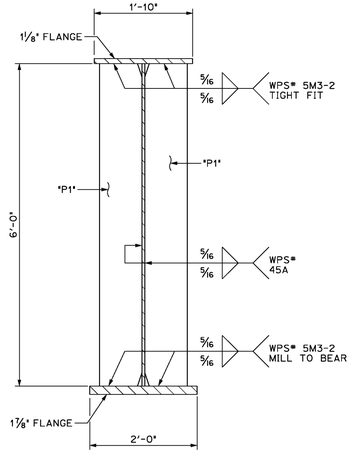



A/2 DIMENSIONAL SECTION
SCALE: 3/4" = 1'-0"

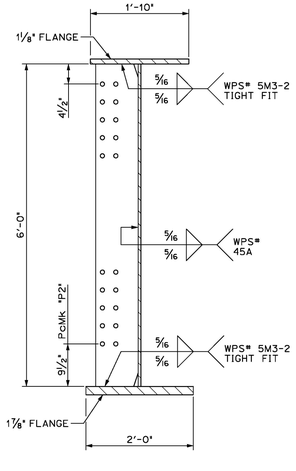


B/2 DIMENSIONAL SECTION
SCALE: 3/4" = 1'-0"

THE TWO CAMBER DIMENSIONS SHOWN REPRESENT THE FOLLOWING
TOP DIMENSION ~ TOTAL CAMBER IN FINISHED BEAM IN A NO-LOAD POSTION
BOTTOM DIMENSION ~ TOTAL CAMBER IN WEB ℄ AT TIME OF FABRICATION

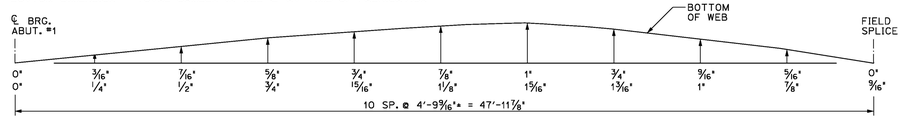


GIRDER "G1-A" CAMBER
N.T.S.

BILL OF MATERIALS


| SHIP | SHIP MARK | NO. PCS. | PIECE MARK | DESCRIPTION | LENGTH | WT. | MATERIAL |
|---|---|---|---|---|---|---|---|
| 1 | G1-A | | | BRIDGE GIRDER ASSEMBLY | 48'-5 7/8" | 19800# EACH | |
| | | 1 | WP1 | ℄ 5/8" x 72" | 48'-5 7/8" | 7450# EACH | CVN |
| | | 1 | TF1 | ℄ 1 1/8" x 22" | 48'-5 7/8" | 4100# EACH | CVN |
| | | 1 | BF1 | ℄ 1 7/8" x 24" | 48'-4 3/8" | 7420# EACH | CVN |
| | | | | | | | |
| | | 1 | DP1 | SEE SHEET M1 | | | |
| | | 2 | P1 | SEE SHEET M2 | | | |
| | | 3 | P2 | SEE SHEET M2 | | | |
| | | | | | | | |
| | | | | | | | |
| | | | | | | | |


| | |
|---|---|
| FINISH | N/A |
| MATERIAL | SEE DETAIL SHEETS |
| HOLES | |
| ELECTRODES | PER WELD PROCEDURE |
| WELDS | PER WELD PROCEDURE |
| SURFACE PREP | |


| NO | DATE | DESCRIPTION | BY |
|---|---|---|---|
| | | REVISIONS | |

ARC ENTERPRISES, INC.
ADVANCED RESOURCES & CONST. ENTERPRISES, INCORPORATED
P.O. BOX 120 KINGFIELD, ME. 04947
PHONE: (207) 265-2646 – FAX: (207) 265-4054


| | | | |
|---|---|---|---|
| DRAFTER | DLM | GIRDER G1-A | PROJECT NO. 15-144 |
| DATE | OCT. 2015 | STOWE, VT. Route 108 (Major Collector) Bridge No. 3 Project No. BRF 0235(15) | |
| CHECKED | JJH | | DWG. NO. 2 |
| DATE | OCT. 2015 | CC: CCS CONSTRUCTORS, INC. | |

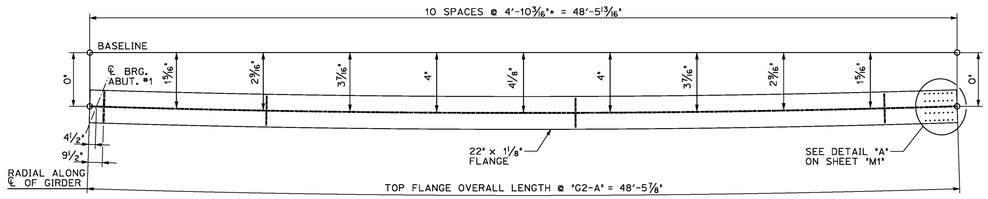

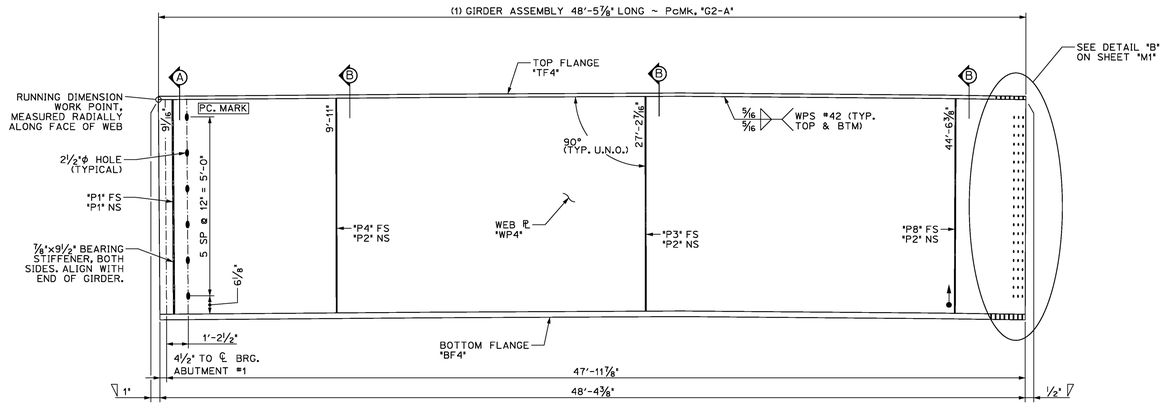


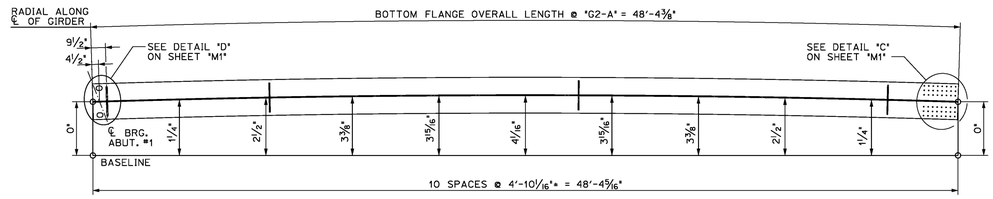
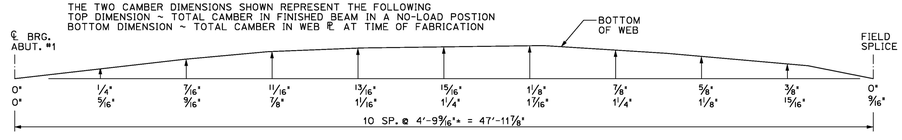

1 / 3 DIMENSIONAL PLANS & ELEVATIONS ~ GIRDER "G2-A"
HORIZONTAL SCALE: 1/4" = 1'-0"
VERTICAL SCALE EXAGGERATED 2:1

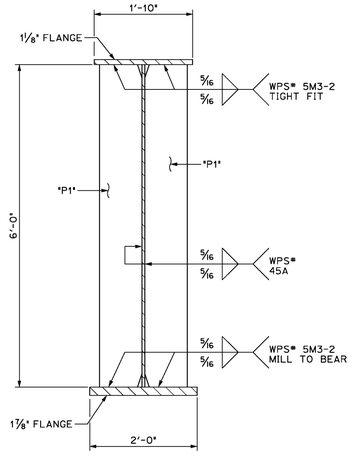


A / 3 DIMENSIONAL SECTION
SCALE: 3/4" = 1'-0"

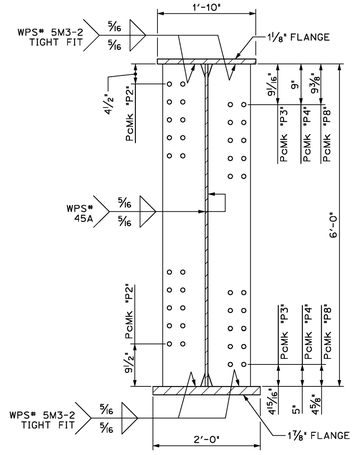


B / 3 DIMENSIONAL SECTION
SCALE: 3/4" = 1'-0"




GIRDER "G2-A" CAMBER
N.T.S.

BILL OF MATERIALS


| SHIP | SHIP MARK | NO. PCS. | PIECE MARK | DESCRIPTION | LENGTH | WT. | MATERIAL |
|---|---|---|---|---|---|---|---|
| 1 | G2-A | | | BRIDGE GIRDER ASSEMBLY | 48'-5 7/8" | 20000# EACH | |
| | | 1 | WP4 | ℄ 5/8" x 72" | 48'-5 7/8" | 7500# EACH | CVN |
| | | 1 | TF4 | ℄ 1 1/8" x 22" | 48'-5 7/8" | 4100# EACH | CVN |
| | | 1 | BF4 | ℄ 1 7/8" x 24" | 48'-4 3/8" | 7450# EACH | CVN |
| | | | | | | | |
| | | 2 | P1 | SEE SHEET M2 | | | |
| | | 3 | P2 | SEE SHEET M2 | | | |
| | | 1 | P3 | SEE SHEET M2 | | | |
| | | 1 | P4 | SEE SHEET M2 | | | |
| | | 1 | P8 | SEE SHEET M2 | | | |
| | | | | | | | |

| | |
|---|---|
| FINISH | N/A |
| MATERIAL | SEE DETAIL SHEETS |
| HOLES | |
| ELECTRODES | PER WELD PROCEDURE |
| WELDS | PER WELD PROCEDURE |
| SURFACE PREP | |

| NO | DATE | DESCRIPTION | BY |
|---|---|---|---|
| REVISIONS | | | |

ARC ENTERPRISES, INC.
ADVANCED RESOURCES & CONST. ENTERPRISES, INCORPORATED
P.O. BOX 120 KINGFIELD, ME. 04947
PHONE: (207) 265-2646 – FAX: (207) 265-4054

| | | | |
|---|---|---|---|
| DRAFTER | DLM | GIRDER G2-A | PROJECT NO. 15-144 |
| DATE | OCT. 2015 | STOWE, VT. Route 108 (Major Collector) Bridge No. 3 Project No. BRF 0235(15) | |
| CHECKED | JJH | CC: CCS CONSTRUCTORS, INC. | DWG. NO. 03 |
| DATE | OCT. 2015 | | |

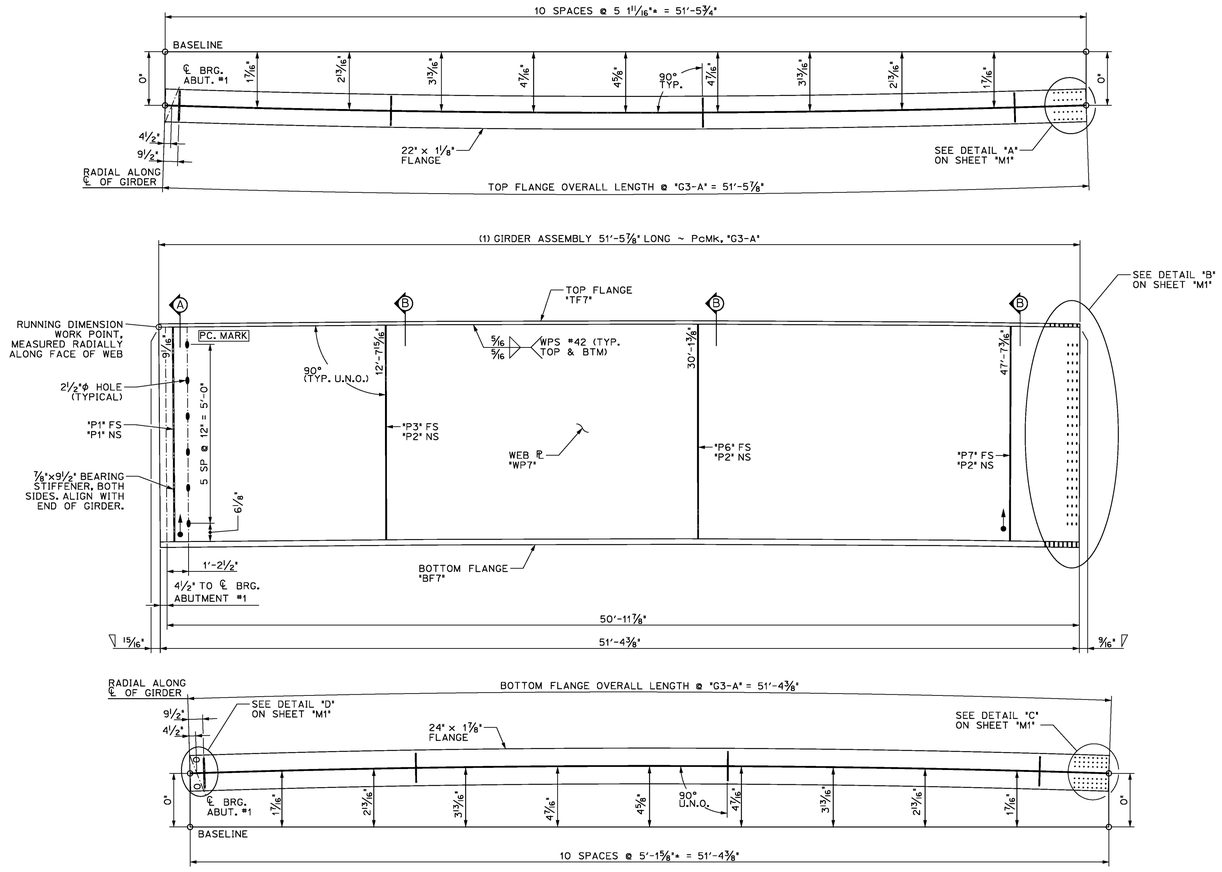











1/4 DIMENSIONAL PLANS & ELEVATIONS ~ GIRDER "G3-A"
HORIZONTAL SCALE: 1/4" = 1'-0"
VERTICAL SCALE EXAGGERATED 2:1

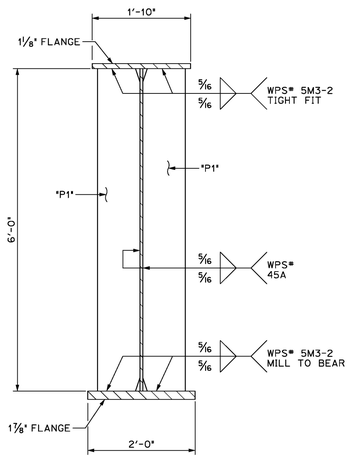


A/4 DIMENSIONAL SECTION
SCALE: ¾" = 1'-0"

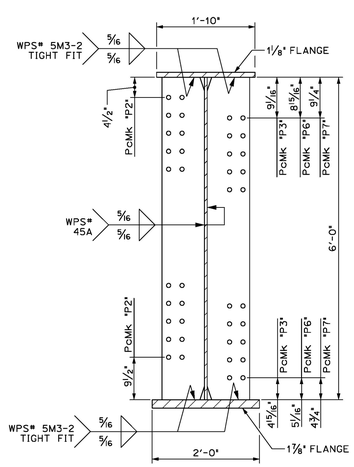


B/4 DIMENSIONAL SECTION
SCALE: ¾" = 1'-0"

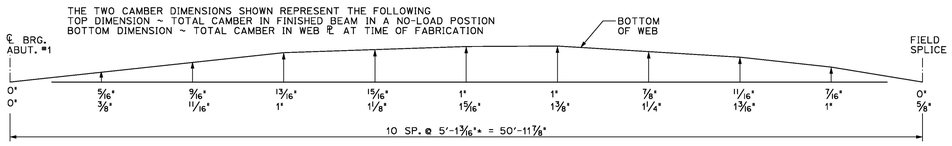


GIRDER "G3-A" CAMBER
N.T.S.

BILL OF MATERIALS


| SHIP | SHIP MARK | NO. PCS. | PIECE MARK | DESCRIPTION | LENGTH | WT. | MATERIAL |
|---|---|---|---|---|---|---|---|
| 1 | G3-A | | | BRIDGE GIRDER ASSEMBLY | 51 5⅞" | 22000# EACH | |
| | | 1 | WP7 | ℙ ⅝" x 72" | 51 5⅞" | 7900# EACH | CVN |
| | | 1 | TF7 | ℙ 1⅛" x 22" | 51 5⅞" | 4400# EACH | CVN |
| | | 1 | BF7 | ℙ 1⅛" x 24" | 51'-4⅜" | 7900# EACH | CVN |
| | | | | | | | |
| | | | | | | | |
| | | 2 | P1 | SEE SHEET M2 | | | |
| | | 3 | P2 | SEE SHEET M2 | | | |
| | | 1 | P3 | SEE SHEET M2 | | | |
| | | 1 | P6 | SEE SHEET M2 | | | |
| | | 1 | P7 | SEE SHEET M2 | | | |


| | |
|---|---|
| FINISH | N/A |
| MATERIAL | SEE DETAIL SHEETS |
| HOLES | |
| ELECTRODES | PER WELD PROCEDURE |
| WELDS | PER WELD PROCEDURE |
| SURFACE PREP | |

| NO | DATE | DESCRIPTION | BY |
|---|---|---|---|
| REVISIONS | | | |


ARC ENTERPRISES, INC.
ADVANCED RESOURCES & CONST. ENTERPRISES, INCORPORATED
P.O. BOX 120 KINGFIELD, ME. 04947
PHONE: (207) 265-2646 – FAX: (207) 265-4054

| | | | |
|---|---|---|---|
| DRAFTER | DLM | GIRDER G3-A | PROJECT NO. 15-144 |
| DATE | OCT. 2015 | STOWE, VT. Route 108 (Major Collector) Bridge No. 3 Project No. BRF 0235(15) | |
| CHECKED | JJH | | DWG. NO. 4 |
| DATE | OCT. 2015 | cc: CCS CONSTRUCTORS, INC. | |

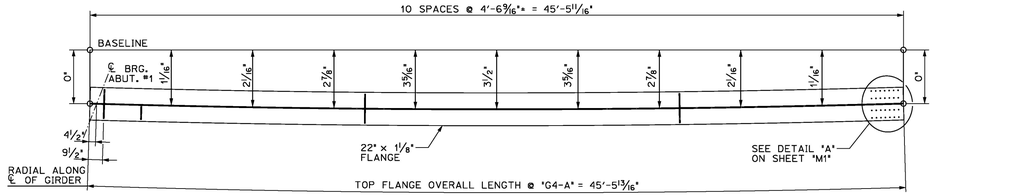


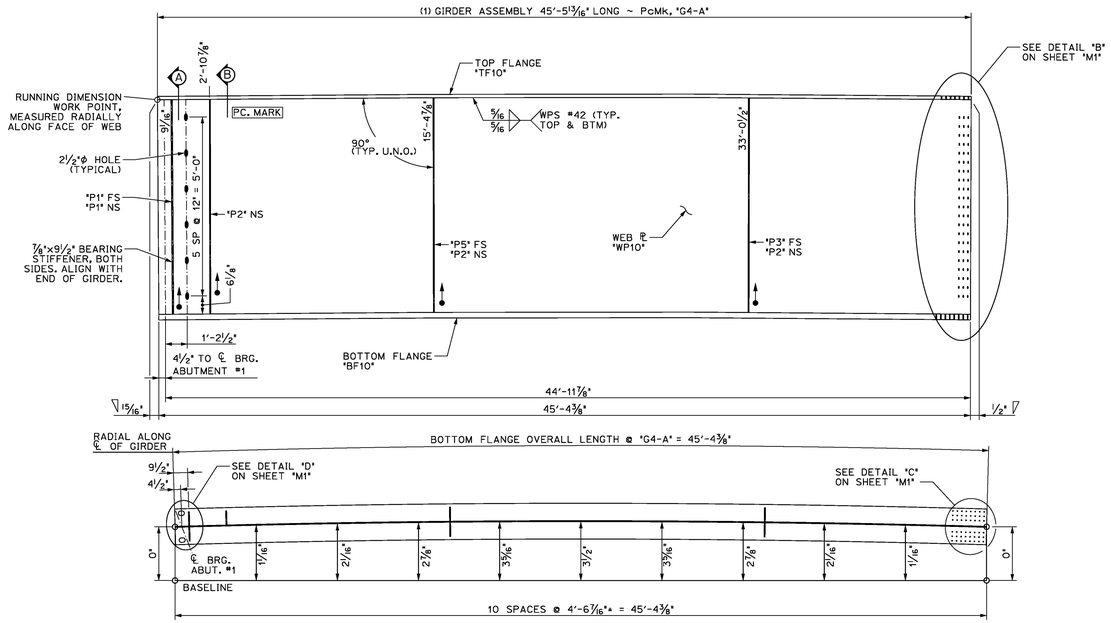

1/5 DIMENSIONAL PLANS & ELEVATIONS ~ GIRDER "G4-A"
HORIZONTAL SCALE: 1/4" = 1'-0"
VERTICAL SCALE EXAGGERATED 2:1

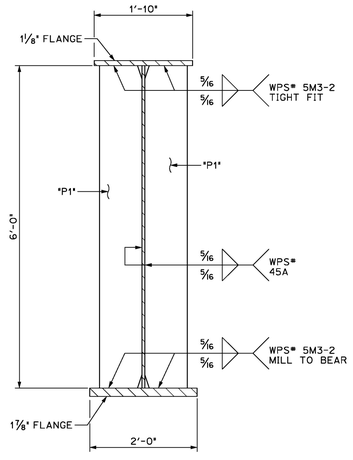


A/5 DIMENSIONAL SECTION
SCALE: 3/4" = 1'-0"

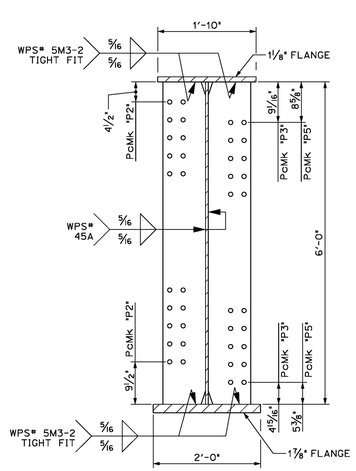


B/5 DIMENSIONAL SECTION
SCALE: 3/4" = 1'-0"

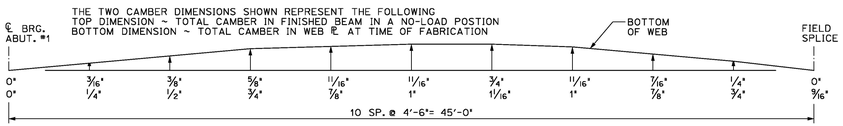


GIRDER "G4-A" CAMBER
N.T.S.

BILL OF MATERIALS

| SHIP | SHIP MARK | NO. PCS. | PIECE MARK | DESCRIPTION | LENGTH | WT. | MATERIAL |
|---|---|---|---|---|---|---|---|
| 1 | G4-A | | | BRIDGE GIRDER ASSEMBLY | 45'-5 13/16" | 19000# EACH | |
| | | 1 | WP10 | ℄ 5/8" x 72" | 45'-5 13/16" | 7000# EACH | CVN |
| | | 1 | TF10 | ℄ 1 1/8" x 22" | 45'-5 13/16" | 3900# EACH | CVN |
| | | 1 | BF10 | ℄ 1 7/8" x 24" | 45'-4 3/8" | 7000# EACH | CVN |
| | | | | | | | |
| | | | | | | | |
| | | 2 | P1 | SEE SHEET M2 | | | |
| | | 3 | P2 | SEE SHEET M2 | | | |
| | | 1 | P3 | SEE SHEET M2 | | | |
| | | 1 | P5 | SEE SHEET M2 | | | |


| | |
|---|---|
| FINISH | N/A |
| MATERIAL | SEE DETAIL SHEETS |
| HOLES | |
| ELECTRODES | PER WELD PROCEDURE |
| WELDS | PER WELD PROCEDURE |
| SURFACE PREP | |


| NO | DATE | DESCRIPTION | BY |
|---|---|---|---|


REVISIONS

ARC ENTERPRISES, INC.
ADVANCED RESOURCES & CONST. ENTERPRISES, INCORPORATED
P.O. BOX 120 KINGFIELD, ME. 04947
PHONE: (207) 265-2646 – FAX: (207) 265-4054


| | | | |
|---|---|---|---|
| DRAFTER | DLM | GIRDER G4-A | PROJECT NO. 15-144 |
| DATE | OCT. 2015 | STOWE, VT. Route 108 (Major Collector) Bridge No. 3 Project No. BRF 0235(15) | |
| CHECKED | JJH | CC: CCS CONSTRUCTORS, INC. | DWG. NO. 5 |
| DATE | OCT. 2015 | | |

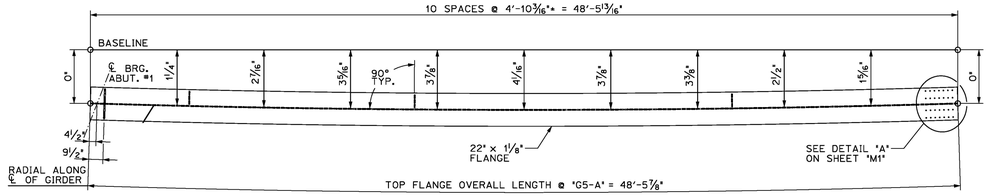

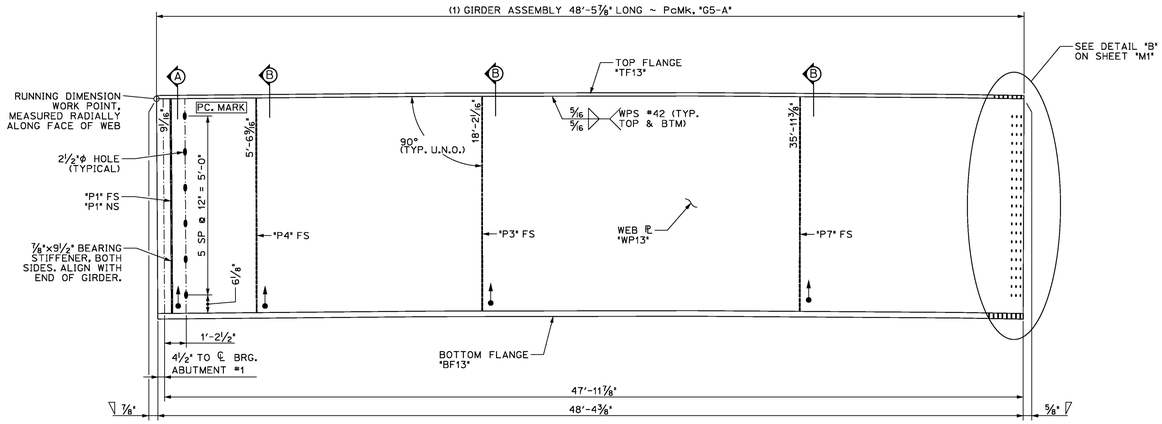


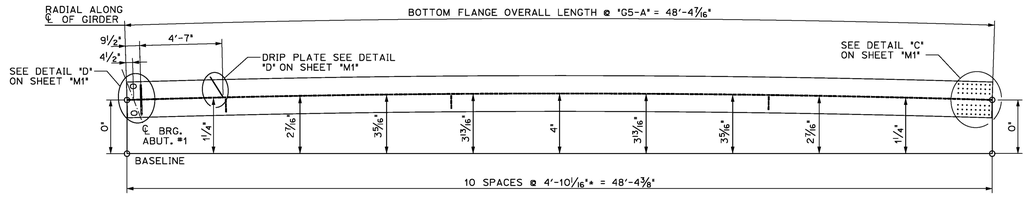
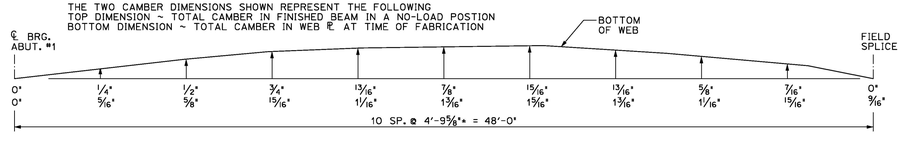

1/6 DIMENSIONAL PLANS & ELEVATIONS ~ GIRDER "G5-A"
HORIZONTAL SCALE: 1/4" = 1'-0"
VERTICAL SCALE EXAGGERATED 2:1

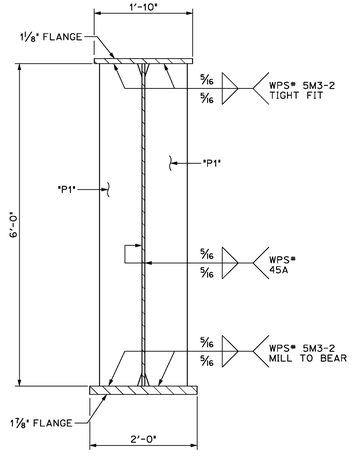


A/6 DIMENSIONAL SECTION
SCALE: 3/4" = 1'-0"

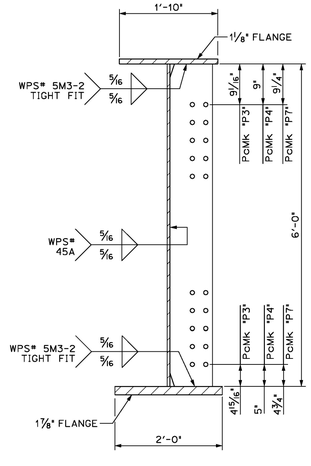


B/6 DIMENSIONAL SECTION
SCALE: 3/4" = 1'-0"




GIRDER "G5-A" CAMBER
N.T.S.

BILL OF MATERIALS

| SHIP | SHIP MARK | NO. PCS. | PIECE MARK | DESCRIPTION | LENGTH | WT. | MATERIAL |
|---|---|---|---|---|---|---|---|
| 1 | G5-A | | | BRIDGE GIRDER ASSEMBLY | 48'-5 7/8" | 19700# EACH | |
| | | 1 | WP13 | ℞ 5/8" x 72" | 48'-5 7/8" | 7450# EACH | CVN |
| | | 1 | TF13 | ℞ 1 1/8" x 22" | 48'-5 7/8" | 4100# EACH | CVN |
| | | 1 | BF13 | ℞ 1 7/8" x 24" | 48'-4 7/16" | 7420# EACH | CVN |
| | | | | | | | |
| | | 1 | DP1 | SEE SHEET M1 | | | |
| | | 2 | P1 | SEE SHEET M2 | | | |
| | | 1 | P3 | SEE SHEET M2 | | | |
| | | 1 | P4 | SEE SHEET M2 | | | |
| | | 1 | P7 | SEE SHEET M2 | | | |
| | | | | | | | |


| | |
|---|---|
| FINISH | N/A |
| MATERIAL | SEE DETAIL SHEETS |
| HOLES | |
| ELECTRODES | PER WELD PROCEDURE |
| WELDS | PER WELD PROCEDURE |
| SURFACE PREP | |

| NO | DATE | DESCRIPTION | BY |
|---|---|---|---|


REVISIONS

ARC ENTERPRISES, INC.
ADVANCED RESOURCES & CONST. ENTERPRISES, INCORPORATED
P.O. BOX 120 KINGFIELD, ME. 04947
PHONE: (207) 265-2646 – FAX: (207) 265-4054

| | | | |
|---|---|---|---|
| DRAFTER | DLM | GIRDER G5-A | PROJECT NO. 15-144 |
| DATE | OCT. 2015 | STOWE, VT. Route 108 (Major Collector) Bridge No. 3 Project No. BRF 0235(15) | DWG. NO. 06 |
| CHECKED | JJH | cc: CCS CONSTRUCTORS, INC. | |
| DATE | OCT. 2015 | | |

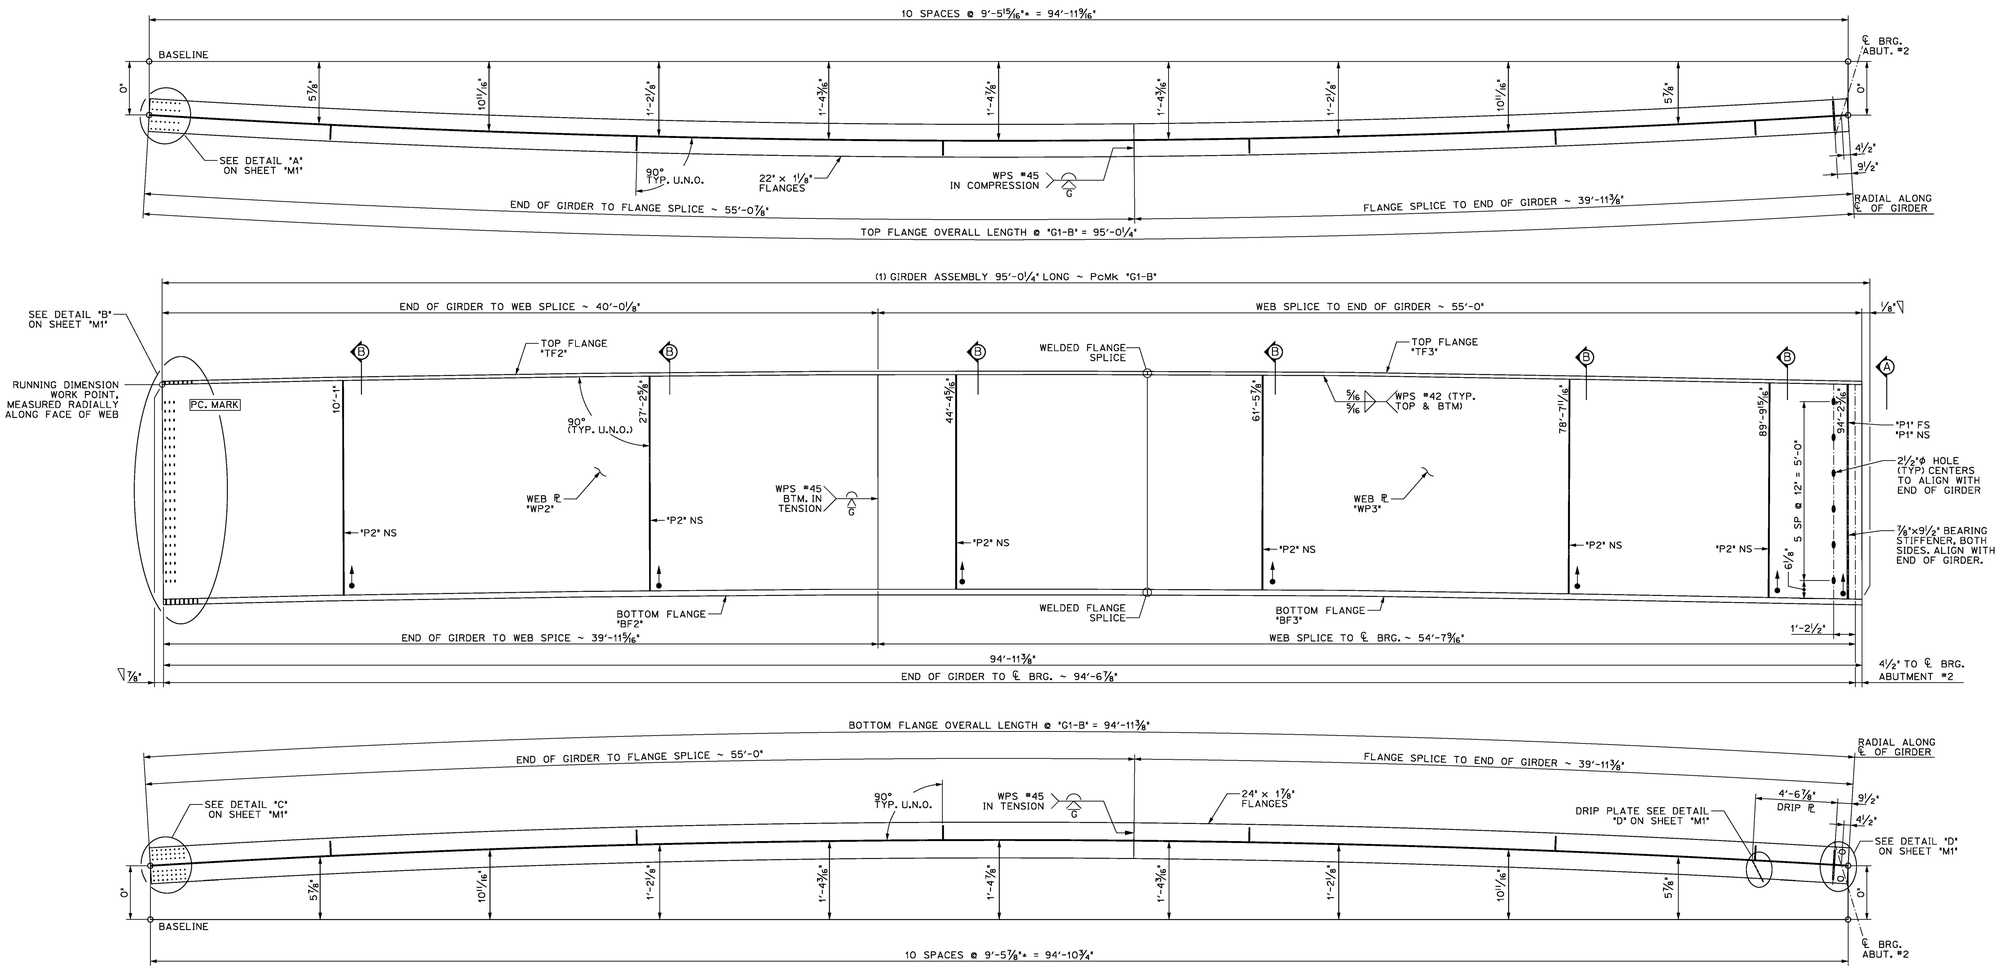



1/7 DIMENSIONAL PLANS & ELEVATIONS ~ GIRDER "G1-B"
HORIZONTAL SCALE: 1/4" = 1'-0"
VERTICAL SCALE EXAGGERATED 2:1

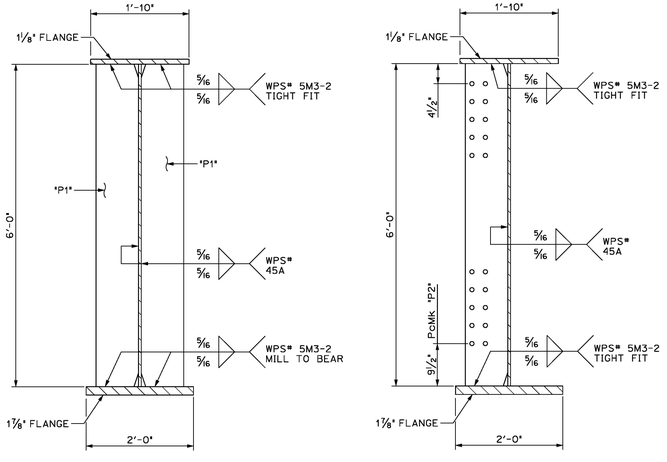


A 1/7 DIMENSIONAL SECTION
SCALE: 3/4" = 1'-0"




B 1/7 DIMENSIONAL SECTION
SCALE: 3/4" = 1'-0"

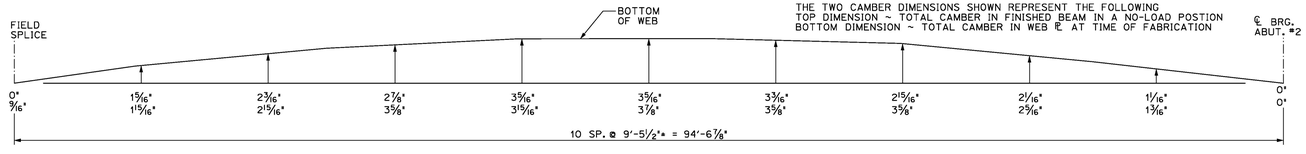


GIRDER "G1-B" CAMBER
N.T.S.

BILL OF MATERIALS

| SHIP | SHIP MARK | NO. PCS. | PIECE MARK | DESCRIPTION | LENGTH | WT. | MATERIAL |
|---|---|---|---|---|---|---|---|
| 1 | G1-B | | | BRIDGE GIRDER ASSEMBLY | 95'-0 1/4" | 39000# EACH | |
| | | 1 | WP2 | ℙ 5/8" x 72" | 40'-0 1/8" | 6200# EACH | CVN |
| | | 1 | WP3 | ℙ 5/8" x 72" | 55'-0" | 8500# EACH | CVN |
| | | 1 | TF2 | ℙ 1 1/8" x 22" | 55'-0 7/8" | 4700# EACH | CVN |
| | | 1 | TF3 | ℙ 1 1/8" x 22" | 39'-11 3/8" | 3400# EACH | CVN |
| | | 1 | BF2 | ℙ 1 1/8" x 24" | 55'-0" | 8500# EACH | CVN |
| | | 1 | BF3 | ℙ 1 1/8" x 24" | 39'-11 3/8" | 6200# EACH | CVN |
| | | | | | | | |
| | | 1 | DP1 | SEE SHEET M1 | | | |
| | | 2 | P1 | SEE SHEET M2 | | | |
| | | 6 | P2 | SEE SHEET M2 | | | |


| | |
|---|---|
| FINISH | N/A |
| MATERIAL | SEE DETAIL SHEETS |
| HOLES | |
| ELECTRODES | PER WELD PROCEDURE |
| WELDS | PER WELD PROCEDURE |
| SURFACE PREP | |


| NO | DATE | DESCRIPTION | BY |
|---|---|---|---|


REVISIONS

ARC ENTERPRISES, INC.
ADVANCED RESOURCES & CONST. ENTERPRISES, INCORPORATED
P.O. BOX 120 KINGFIELD, ME. 04947
PHONE: (207) 265-2646 ~ FAX: (207) 265-4054

| | | | |
|---|---|---|---|
| DRAFTER | DLM | GIRDER G1-B | PROJECT NO. 15-144 |
| DATE | OCT. 2015 | STOWE, VT. Route 108 (Major Collector) Bridge No. 3 Project No. BRF 0235(15) | |
| CHECKED | JJH | cc: CCS CONSTRUCTORS, INC. | DWG. NO. 07 |
| DATE | OCT. 2015 | | |

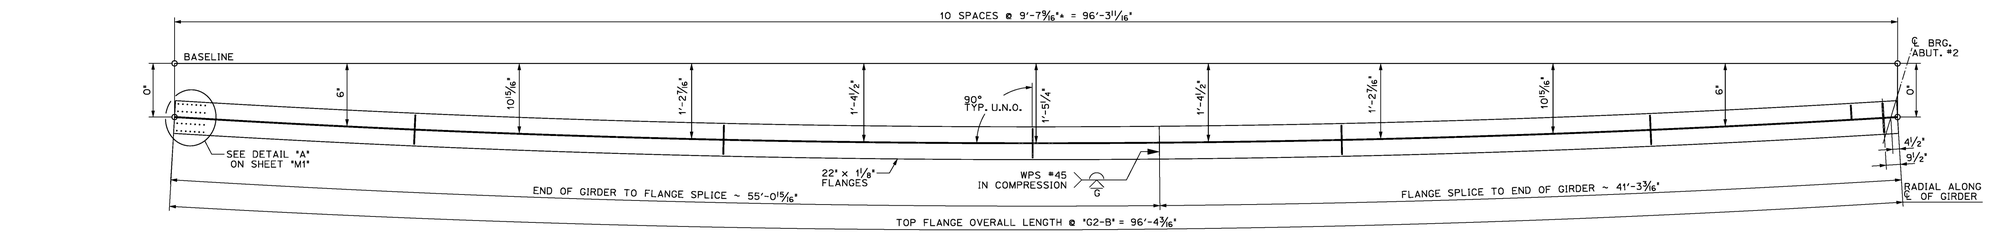


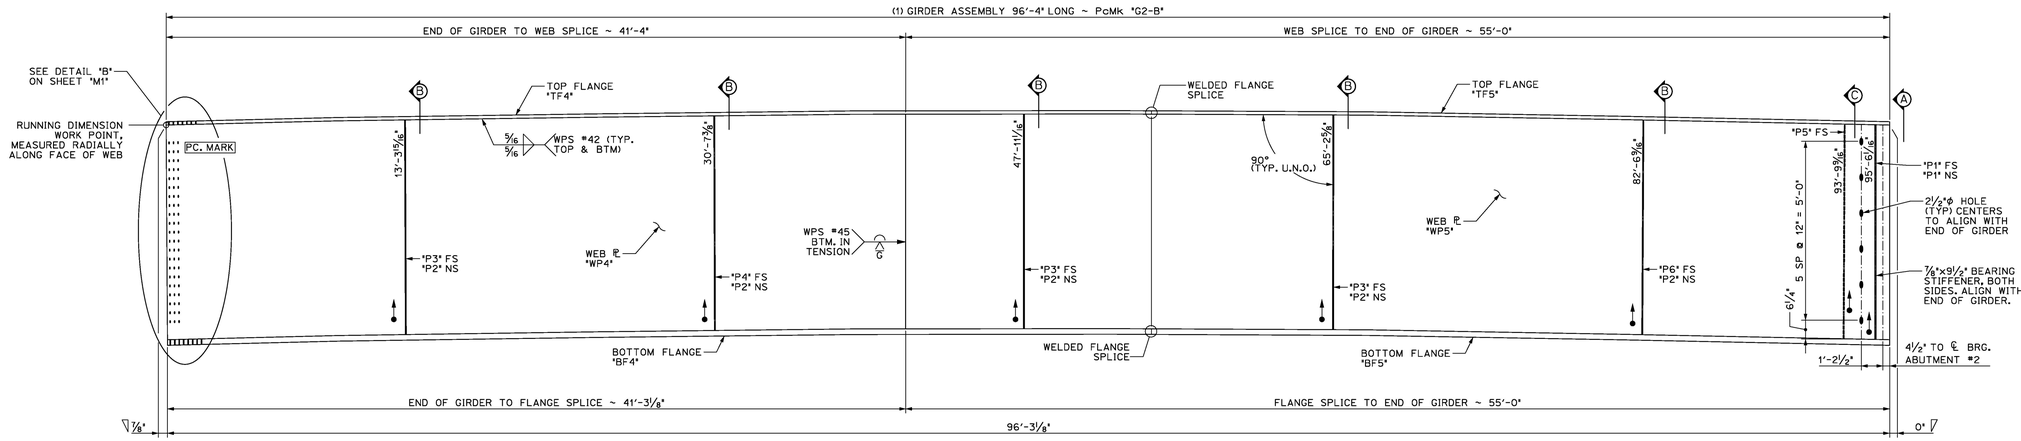


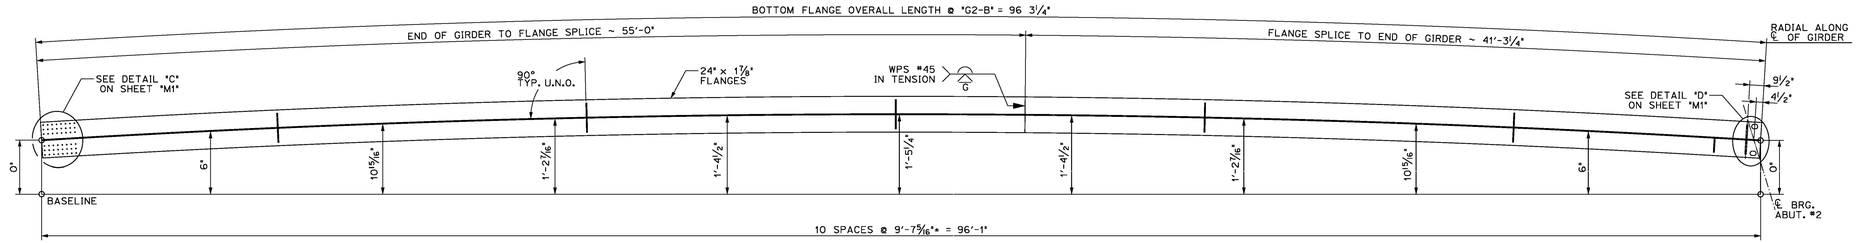

## 1/8 DIMENSIONAL PLANS & ELEVATIONS ~ GIRDER "G2-B"


HORIZONTAL SCALE: 1/4" = 1'-0"
VERTICAL SCALE EXAGGERATED 2:1

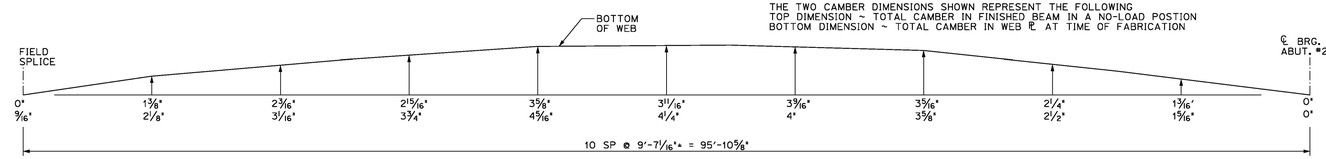

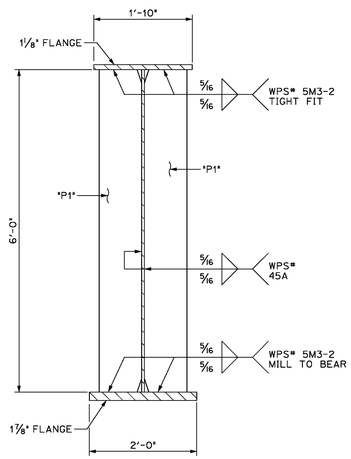

GIRDER "G2-B" CAMBER
N.T.S.




A 8 DIMENSIONAL SECTION
SCALE: 3/4" = 1'-0"

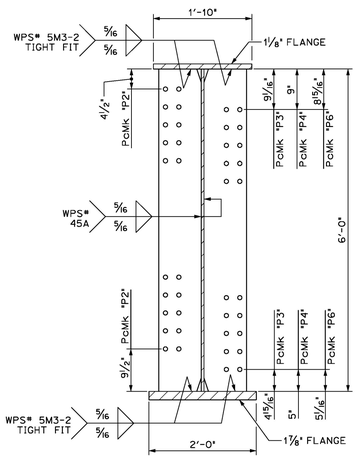


B 8 DIMENSIONAL SECTION
SCALE: 3/4" = 1'-0"

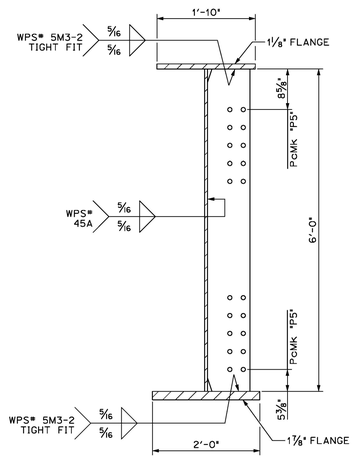


C 8 DIMENSIONAL SECTION
SCALE: 3/4" = 1'-0"

## BILL OF MATERIALS

| SHIP | SHIP MARK | NO. PCS. | PIECE MARK | DESCRIPTION | LENGTH | WT. | MATERIAL |
|---|---|---|---|---|---|---|---|
| 1 | G2-B | | | BRIDGE GIRDER ASSEMBLY | 96'-4" | 39500# EACH | |
| | | 1 | WP4 | ℄ 5/8" x 72" | 41'-4" | 6500# EACH | CVN |
| | | 1 | WP5 | ℄ 5/8" x 72" | 55'-0" | 8500# EACH | CVN |
| | | 1 | TF4 | ℄ 1 1/8" x 22" | 55'-0 15/16" | 4800# EACH | CVN |
| | | 1 | TF5 | ℄ 1 1/8" x 22" | 41'-3 3/16" | 3600# EACH | CVN |
| | | 1 | BF4 | ℄ 1 1/8" x 24" | 55'-0" | 8500# EACH | CVN |
| | | 1 | BF5 | ℄ 1 1/8" x 24" | 41'-3 1/4" | 6500# EACH | CVN |
| | | 2 | P1 | SEE SHEET M2 | | | |
| | | 5 | P2 | SEE SHEET M2 | | | |
| | | 3 | P3 | SEE SHEET M2 | | | |
| | | 1 | P4 | SEE SHEET M2 | | | |
| | | 1 | P5 | SEE SHEET M2 | | | |
| | | 1 | P6 | SEE SHEET M2 | | | |


| | |
|---|---|
| FINISH | N/A |
| MATERIAL | SEE DETAIL SHEETS |
| HOLES | |
| ELECTRODES | PER WELD PROCEDURE |
| WELDS | PER WELD PROCEDURE |
| SURFACE PREP | |


| NO | DATE | DESCRIPTION | BY |
|---|---|---|---|


REVISIONS

ARC ENTERPRISES, INC.
ADVANCED RESOURCES & CONST. ENTERPRISES, INCORPORATED
P.O. BOX 120 KINGFIELD, ME. 04947
PHONE: (207) 265-2646 – FAX: (207) 265-4054

| | | | |
|---|---|---|---|
| DRAFTER | DLM | GIRDER G2-B | PROJECT NO. 15-144 |
| DATE | OCT. 2015 | STOWE, VT. Route 108 (Major Collector) Bridge No. 3 Project No. BRF 0235(15) | |
| CHECKED | JJH | cc: CCS CONSTRUCTORS, INC. | DWG. NO. 08 |
| DATE | OCT. 2015 | | |

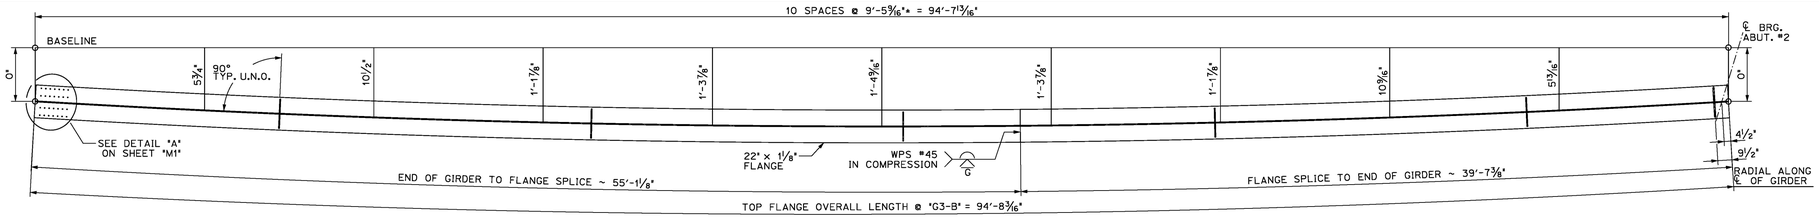


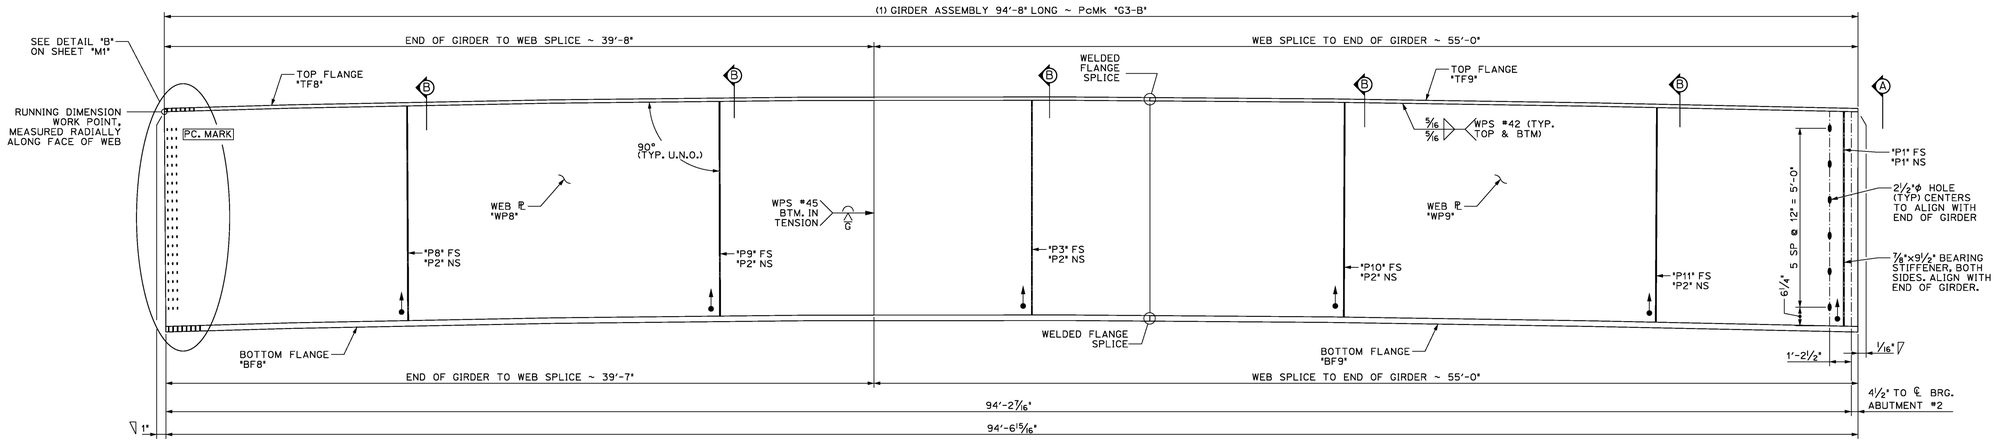


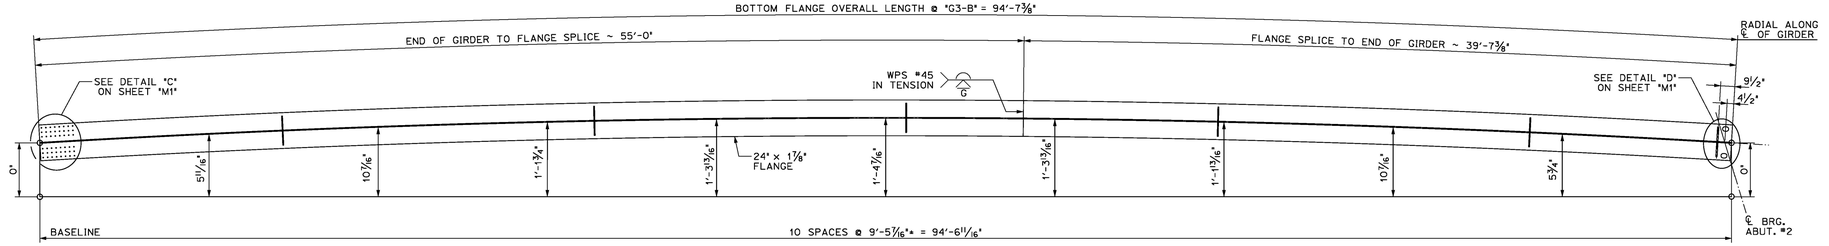

DENOTES DIRECTION OF WELD


1/9 DIMENSIONAL PLANS & ELEVATIONS ~ GIRDER "G3-B"
HORIZONTAL SCALE: 1/4" = 1'-0"
VERTICAL SCALE EXAGGERATED 2:1

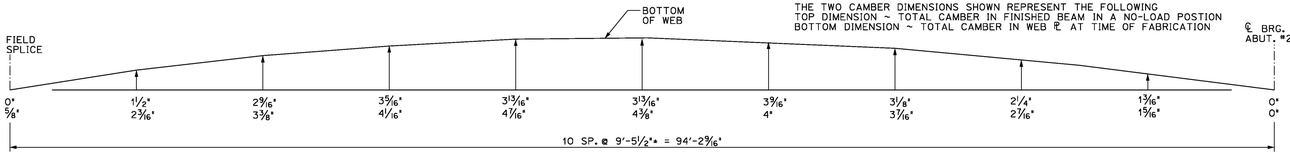

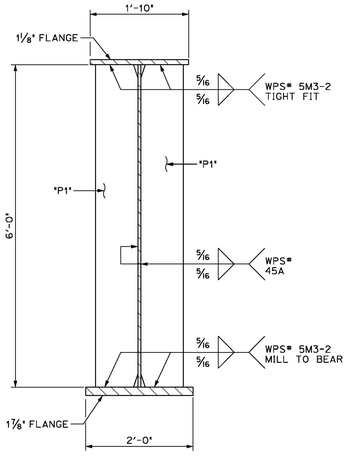
GIRDER "G3-B" CAMBER
N.T.S.




A 9 DIMENSIONAL SECTION
SCALE: 3/4" = 1'-0"

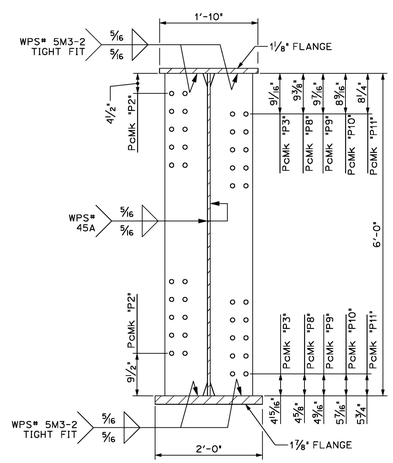


B 9 DIMENSIONAL SECTION
SCALE: 3/4" = 1'-0"

BILL OF MATERIALS

| SHIP | SHIP MARK | NO. PCS. | PIECE MARK | DESCRIPTION | LENGTH | WT. | MATERIAL |
|---|---|---|---|---|---|---|---|
| 1 | G3-B | | | BRIDGE GIRDER ASSEMBLY | 94'-8" | 39000# EACH | |
| | | 1 | WP8 | ℄ 5/8" x 72" | 39'-8" | 6100# EACH | CVN |
| | | 1 | WP9 | ℄ 5/8" x 72" | 55'-0" | 8500# EACH | CVN |
| | | 1 | TF8 | ℄ 1 1/8" x 22" | 55'-1 1/8" | 4700# EACH | CVN |
| | | 1 | TF9 | ℄ 1 1/8" x 22" | 39'-7 3/8" | 3500# EACH | CVN |
| | | 1 | BF8 | ℄ 1 7/8" x 24" | 55'-0" | 8500# EACH | CVN |
| | | 1 | BF9 | ℄ 1 7/8" x 24" | 39'-7 3/8" | 6100# EACH | CVN |
| | | | | | | | |
| | | 2 | P1 | SEE SHEET M2 | | | |
| | | 5 | P2 | SEE SHEET M2 | | | |
| | | 1 | P3 | SEE SHEET M2 | | | |
| | | 1 | P8 | SEE SHEET M2 | | | |
| | | 1 | P9 | SEE SHEET M2 | | | |
| | | 1 | P10 | SEE SHEET M2 | | | |
| | | 1 | P11 | SEE SHEET M2 | | | |

| | |
|---|---|
| FINISH | N/A |
| MATERIAL | SEE DETAIL SHEETS |
| HOLES | |
| ELECTRODES | PER WELD PROCEDURE |
| WELDS | PER WELD PROCEDURE |
| SURFACE PREP | |


| NO | DATE | DESCRIPTION | BY |
|---|---|---|---|
| REVISIONS | | | |

ARC ENTERPRISES, INC.
ADVANCED RESOURCES & CONST. ENTERPRISES, INCORPORATED
P.O. BOX 120 KINGFIELD, ME. 04947
PHONE: (207) 265-2646 – FAX: (207) 265-4054

| | |
|---|---|
| DRAFTER | DLM |
| DATE | OCT. 2015 |
| CHECKED | JJH |
| DATE | OCT. 2015 |

GIRDER G3-B
STOWE, VT. Route 108 (Major Collector) Bridge No. 3
Project No. BRF 0235(15)
CC: CCS CONSTRUCTORS, INC.

PROJECT NO. 15-144
DWG. NO. 09

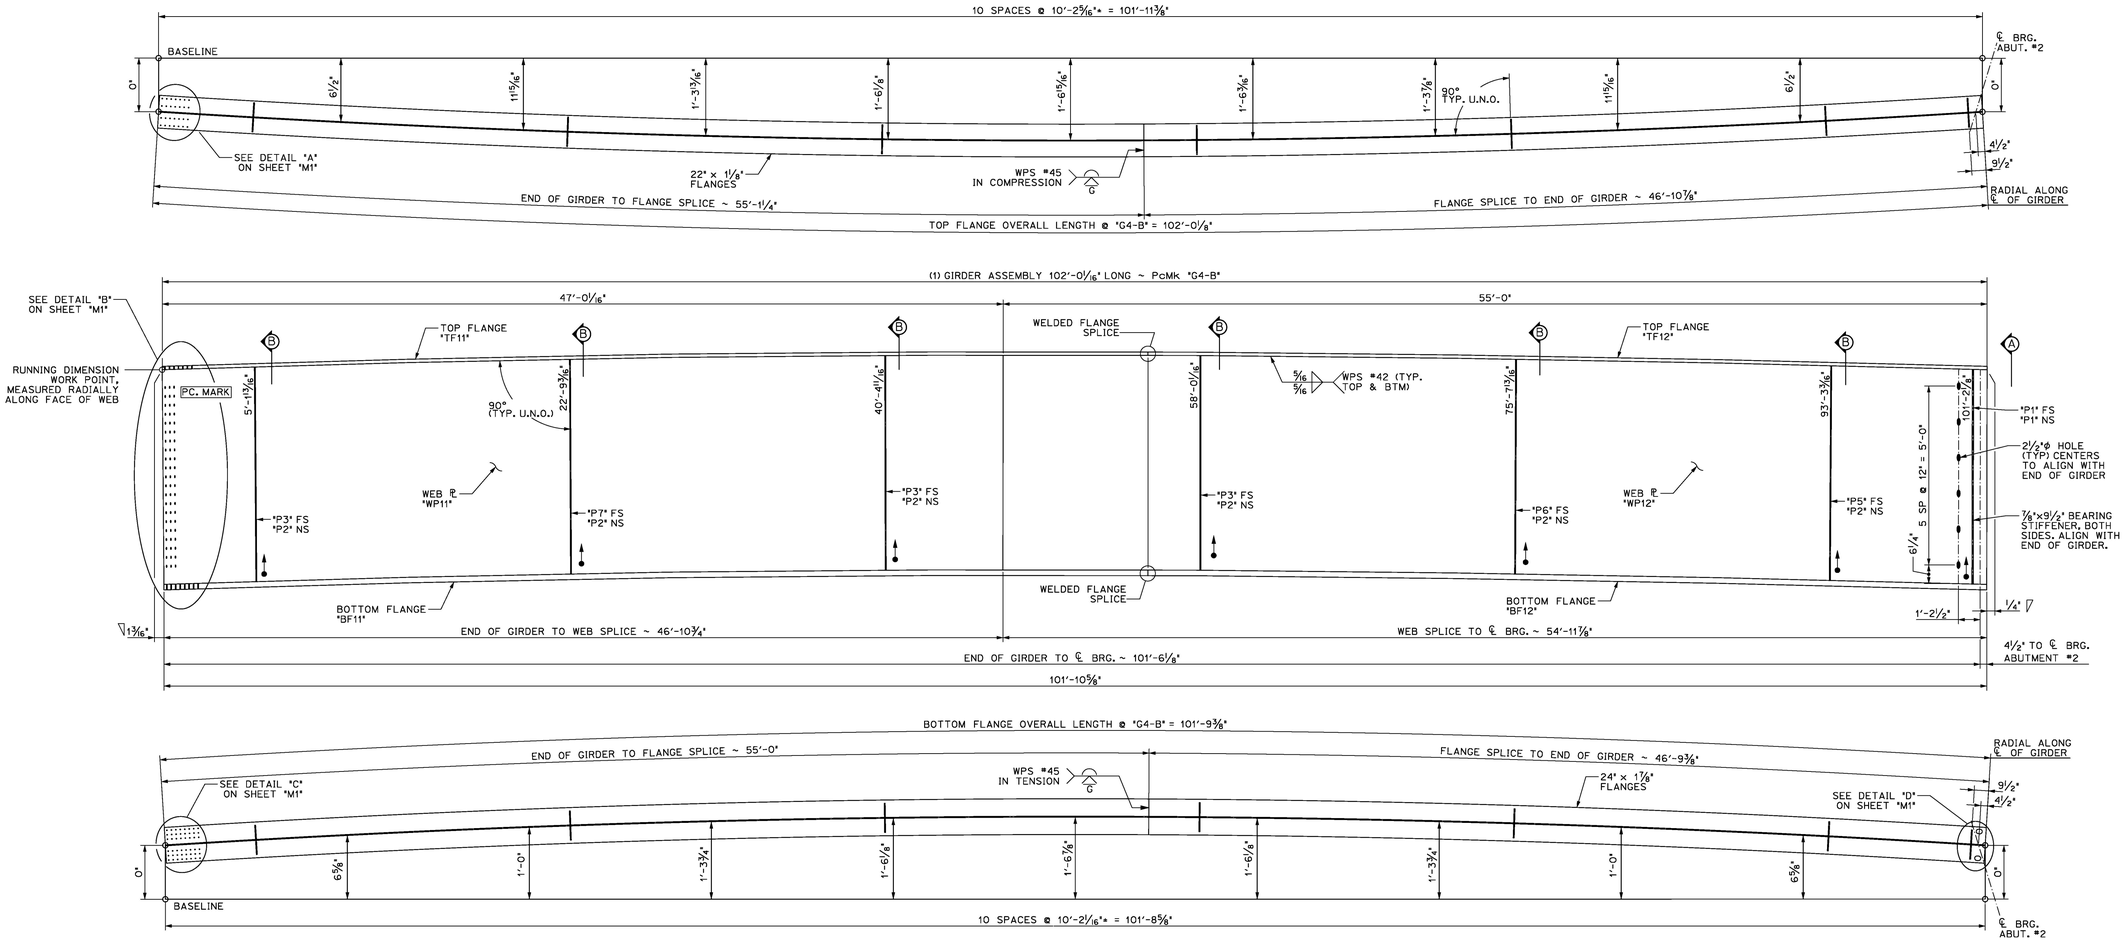











1 / 10 DIMENSIONAL PLANS & ELEVATIONS ~ GIRDER "G4-B"
HORIZONTAL SCALE: 1/4" = 1'-0"
VERTICAL SCALE EXAGGERATED 2:1

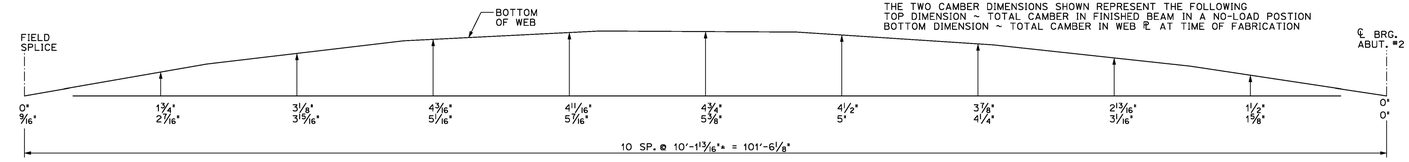


GIRDER "G4-B" CAMBER
N.T.S.

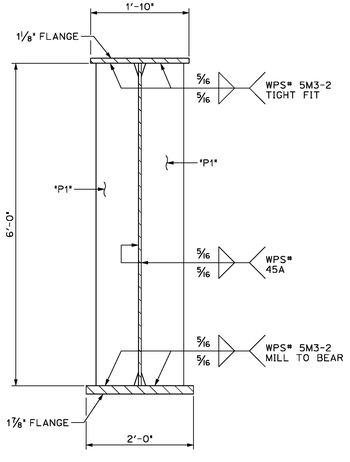


A / 10 DIMENSIONAL SECTION
SCALE: 3/4" = 1'-0"

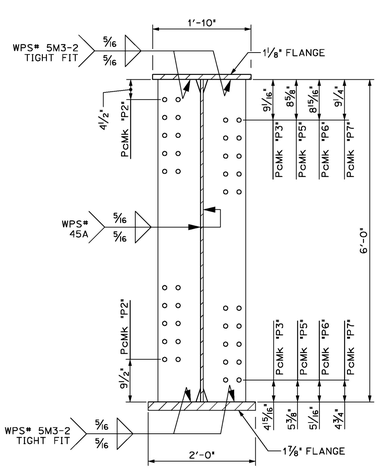


B / 10 DIMENSIONAL SECTION
SCALE: 3/4" = 1'-0"

BILL OF MATERIALS


| SHIP | SHIP MARK | NO. PCS. | PIECE MARK | DESCRIPTION | LENGTH | WT. | MATERIAL |
|---|---|---|---|---|---|---|---|
| 1 | G4-B | | | BRIDGE GIRDER ASSEMBLY | 102 0/16" | 41700# EACH | |
| | | 1 | WP11 | ℜ 5/8" x 72" | 47'-0/16" | 7500# EACH | CVN |
| | | 1 | WP12 | ℜ 5/8" x 72" | 55'-0" | 8500# EACH | CVN |
| | | 1 | TF11 | ℜ 1 1/8" x 22" | 55'-1 1/4" | 4700# EACH | CVN |
| | | 1 | TF12 | ℜ 1 1/8" x 22" | 46'-10 7/8" | 4000# EACH | CVN |
| | | 1 | BF11 | ℜ 1 1/8" x 24" | 55'-0" | 8500# EACH | CVN |
| | | 1 | BF12 | ℜ 1 1/8" x 24" | 46'-9 3/8" | 7500# EACH | CVN |
| | | | | | | | |
| | | 2 | P1 | SEE SHEET M2 | | | |
| | | 6 | P2 | SEE SHEET M2 | | | |
| | | 3 | P3 | SEE SHEET M2 | | | |
| | | 1 | P5 | SEE SHEET M2 | | | |
| | | 1 | P6 | SEE SHEET M2 | | | |
| | | 1 | P7 | SEE SHEET M2 | | | |

| | |
|---|---|
| FINISH | N/A |
| MATERIAL | SEE DETAIL SHEETS |
| HOLES | |
| ELECTRODES | PER WELD PROCEDURE |
| WELDS | PER WELD PROCEDURE |
| SURFACE PREP | |

| NO | DATE | DESCRIPTION | BY |
|---|---|---|---|
| REVISIONS | | | |

ARC ENTERPRISES, INC.
ADVANCED RESOURCES & CONST. ENTERPRISES, INCORPORATED
P.O. BOX 120 KINGFIELD, ME. 04947
PHONE: (207) 265-2646 – FAX: (207) 265-4054

| | | | |
|---|---|---|---|
| DRAFTER | DLM | GIRDER G4-B | PROJECT NO. 15-144 |
| DATE | OCT. 2015 | STOWE, VT. Route 108 (Major Collector) Bridge No. 3 Project No. BRF 0235(15) | |
| CHECKED | JJH | CC: CCS CONSTRUCTORS, INC. | DWG. NO. 10 |
| DATE | OCT. 2015 | | |

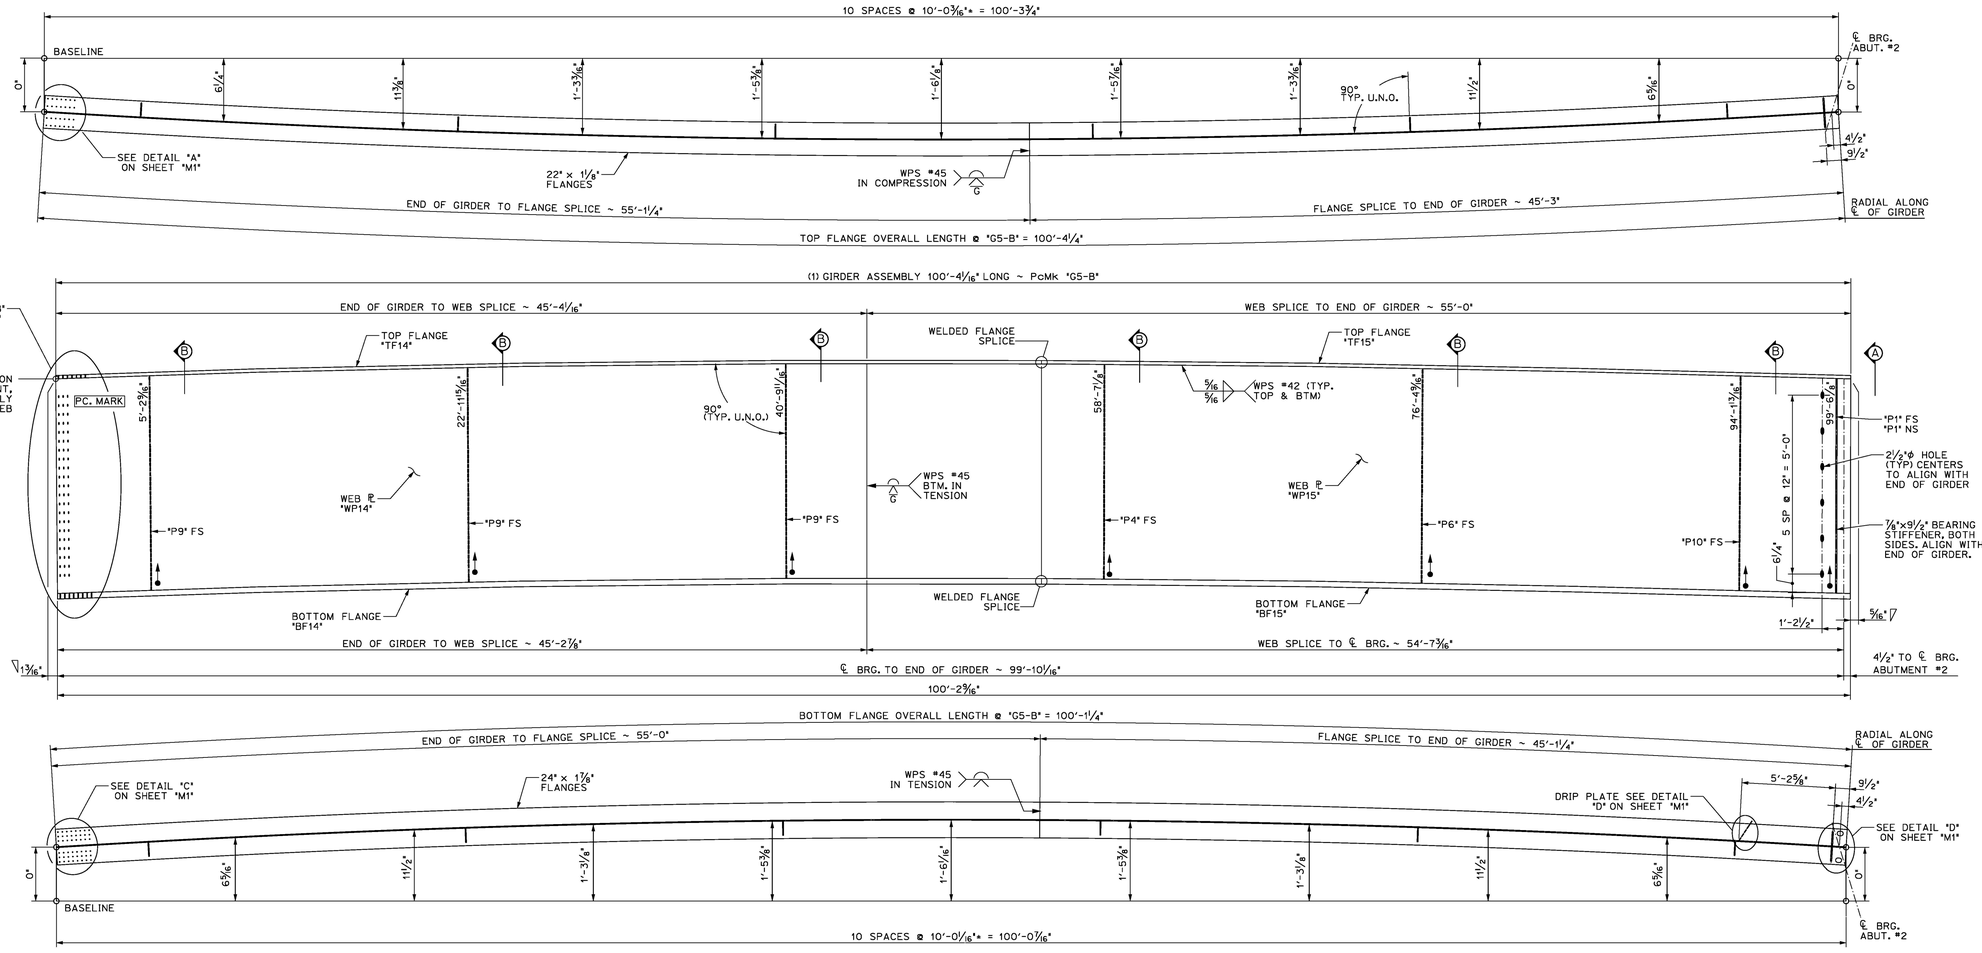











1 / 11 DIMENSIONAL PLANS & ELEVATIONS ~ GIRDER "G5-B"
HORIZONTAL SCALE: 1/4" = 1'-0"
VERTICAL SCALE EXAGGERATED 2:1

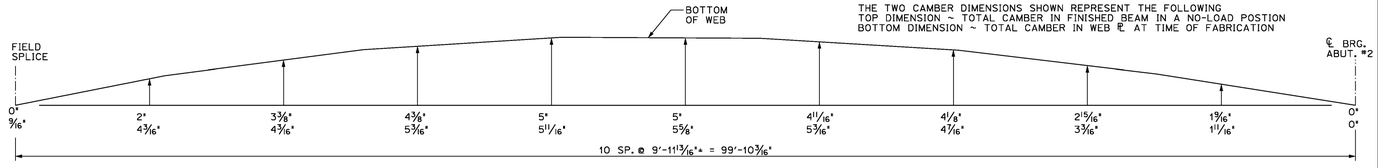


GIRDER "G5-B" CAMBER
N.T.S.

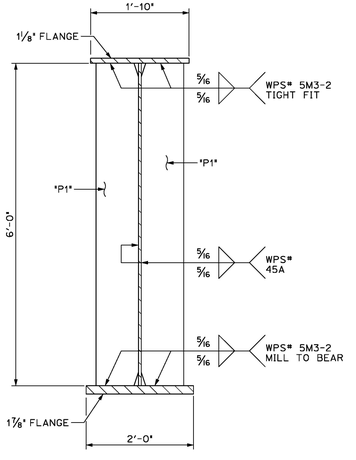


A / 11 DIMENSIONAL SECTION
SCALE: 3/4" = 1'-0"

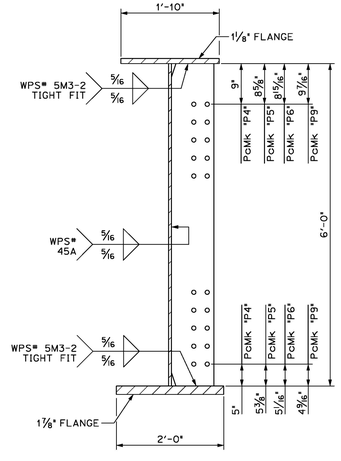


B / 11 DIMENSIONAL SECTION
SCALE: 3/4" = 1'-0"

BILL OF MATERIALS

| SHIP | SHIP MARK | NO. PCS. | PIECE MARK | DESCRIPTION | LENGTH | WT. | MATERIAL |
|---|---|---|---|---|---|---|---|
| 1 | G5-B | | | BRIDGE GIRDER ASSEMBLY | 100'-4 1/16" | 40500# EACH | |
| | | 1 | WP14 | ℞ 5/8" x 72" | 45'-4 1/16" | 7000# EACH | CVN |
| | | 1 | WP15 | ℞ 5/8" x 72" | 55'-0" | 8500# EACH | CVN |
| | | 1 | TF14 | ℞ 1 1/8" x 22" | 55'-1 1/4" | 4700# EACH | CVN |
| | | 1 | TF15 | ℞ 1 1/8" x 22" | 45'-3" | 3900# EACH | CVN |
| | | 1 | BF14 | ℞ 1 7/8" x 24" | 55'0" | 8500# EACH | CVN |
| | | 1 | BF15 | ℞ 1 7/8" x 24" | 45'-1 1/4" | 7000# EACH | CVN |
| | | | | | | | |
| | | 1 | DP1 | SEE SHEET M1 | | | |
| | | 2 | P1 | SEE SHEET M2 | | | |
| | | 1 | P4 | SEE SHEET M2 | | | |
| | | 1 | P6 | SEE SHEET M2 | | | |
| | | 3 | P9 | SEE SHEET M2 | | | |
| | | 1 | P10 | SEE SHEET M2 | | | |

| | |
|---|---|
| FINISH | N/A |
| MATERIAL | SEE DETAIL SHEETS |
| HOLES | |
| ELECTRODES | PER WELD PROCEDURE |
| WELDS | PER WELD PROCEDURE |
| SURFACE PREP | |


| NO | DATE | DESCRIPTION | BY |
|---|---|---|---|
| | | REVISIONS | |

ARC ENTERPRISES, INC.
ADVANCED RESOURCES & CONST. ENTERPRISES, INCORPORATED
P.O. BOX 120 KINGFIELD, ME. 04947
PHONE: (207) 265-2646 – FAX: (207) 265-4054


| | |
|---|---|
| DRAFTER | DLM |
| DATE | OCT. 2015 |
| CHECKED | JJH |
| DATE | OCT. 2015 |

GIRDER G5-B
STOWE, VT. Route 108 (Major Collector) Bridge No. 3
Project No. BRF 0235(15)
SC: CCS CONSTRUCTORS, INC.


PROJECT NO. 15-144
DWG. NO. 11

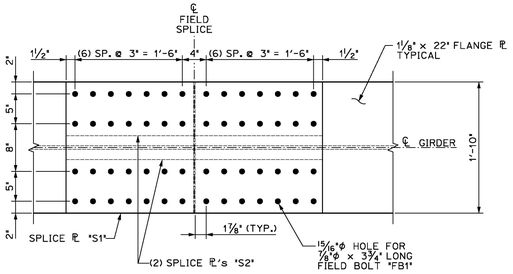


A/M1 TOP FLANGE FIELD SPLICE
SCALE: 1" = 1'-0"

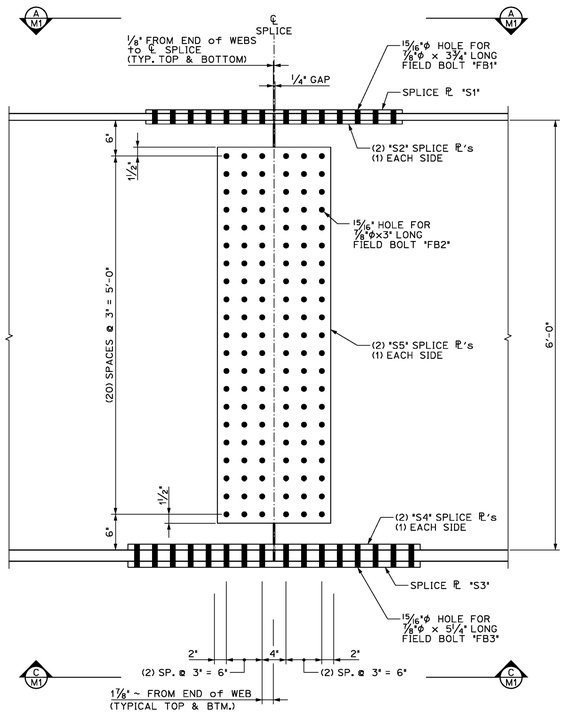



B/M1 WEB FIELD SPLICE
SCALE: 1" = 1'-0"

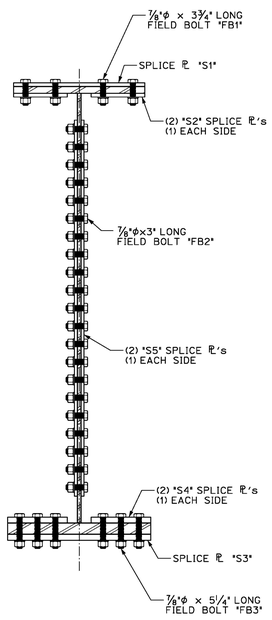



SECTION AT WEB FIELD SPLICE
SCALE: 1" = 1'-0"





C/M1 BOTTOM FLANGE FIELD SPLICE
SCALE: 1" = 1'-0"

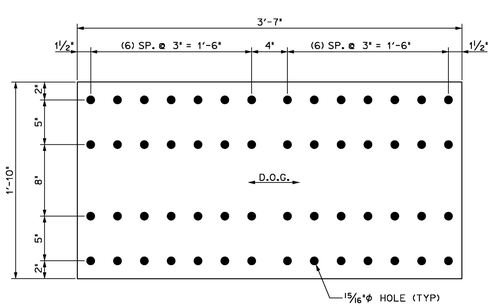



⅝" SPLICE PL, PcMk. "S1"
SCALE: 1½" = 1'-0"

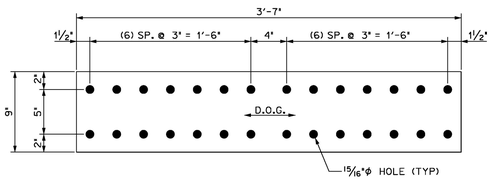



⅝" SPLICE PL, PcMk. "S2"
SCALE: 1½" = 1'-0"

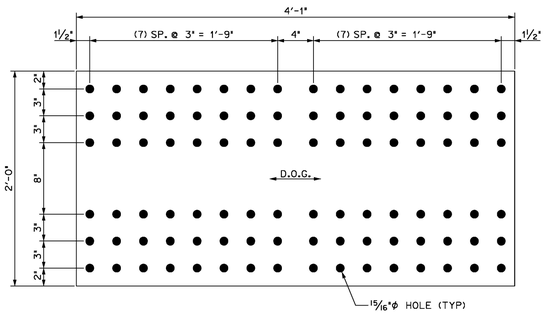



1" SPLICE PL, PcMk. "S3"
SCALE: 1½" = 1'-0"

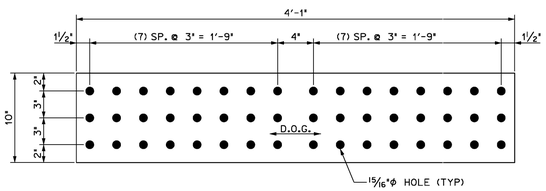



1" SPLICE PL, PcMk. "S4"
SCALE: 1½" = 1'-0"

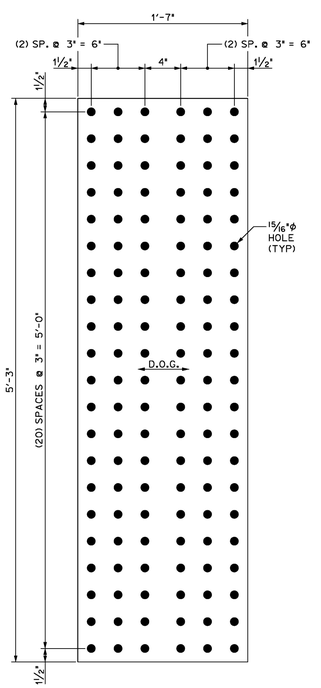



½" SPLICE PL, PcMk. "S5"
SCALE: 1½" = 1'-0"

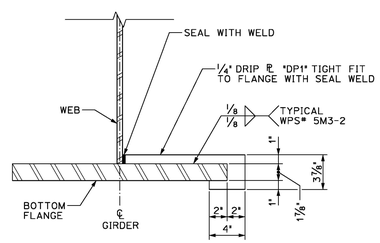



X/M1 DRIP PLATE SECTION
SCALE: 1½" = 1'-0"

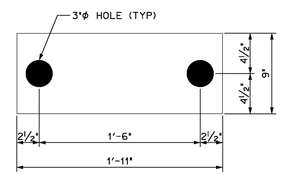



1⅝" SOLE PL "SP1"
SCALE: 1½" = 1'-0"

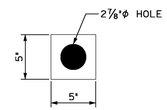


½" PL WASHER "PW"
SCALE: 1½" = 1'-0"

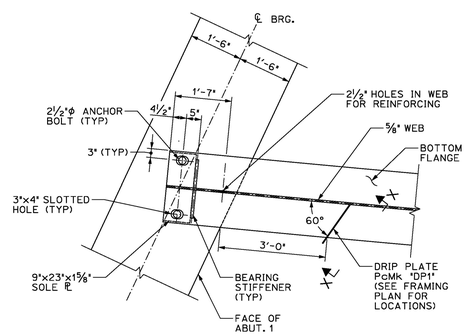



D/M1 END OF GIRDER DETAIL
SCALE: 1/2" = 1'-0"

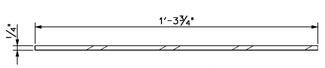


"DP1" PLAN VIEW
SCALE: 3" = 1'-0"

*NOTE:
DIMENSION INCLUDES A 1/16" TOLERANCE AN THE TOP AND BOTTOM OF THE FLANGE TO FACILITATE INSTALLATION.

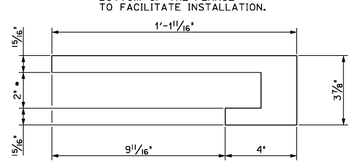


DRIP PL, PcMk "DP1"
SCALE: 3" = 1'-0"

## COMPLETE BOLT SCHEDULE

| NO. BOLTS | PIECE MARK | LENGTH | DESCRIPTION | LOCATION |
|---|---|---|---|---|
| 280 | FB1 | 3¾" | ⅞"ϕ BOLT w/N&W (WEATHERING) AASHTO M164, TYPE 3 | TOP FLANGE AT FIELD SPLICE |
| 630 | FB2 | 3" | ⅞"ϕ BOLT w/N&W (WEATHERING) AASHTO M164, TYPE 3 | WEB AT FIELD SPLICE |
| 480 | FB3 | 5¼" | ⅞"ϕ BOLT w/N&W (WEATHERING) AASHTO M164, TYPE 3 | BOTTOM FLANGE AT FILED SPLICE |
| 1088 | FB4 | 2¾" | ⅞"ϕ BOLT w/N&W (WEATHERING) ASTM A325, TYPE 3 | CONNECTION PLATES AT CROSS FRAMES |
| 20 | ANC | 36" | 2½"ϕ GR55 OR HIGHER STRENGTH SWEDGED ANCHOR ROD. THREADED 18", WITH MIN. 18" EMBEDMENT. •3 NUTS PER ANCHOR ROD.• | SOLE PLATE LOCATIONS |
| 60 | N1 | | 2½"ϕ NUTS FOR ANCHOR ROD | SOLE PLATE LOCATIONS |

## BILL OF MATERIALS

| SHIP | SHIP MARK | NO. PCS. | PIECE MARK | DESCRIPTION | LENGTH | WT. | MATERIAL |
|---|---|---|---|---|---|---|---|
| 5 | S1 | | | PL ⅝" x 22" | 3'-7" | 170# EACH | CVN |
| 10 | S2 | | | PL ⅝" x 9" | 3'-7" | 70# EACH | CVN |
| 5 | S3 | | | PL 1" x 24" | 4'-1" | 340# EACH | CVN |
| 10 | S4 | | | PL 1" x 10" | 4'-1" | 140# EACH | CVN |
| 10 | S5 | | | PL ½" x 19" | 5'-3" | 175# EACH | CVN |
| 4 | DP1 | | | PL ¼" x 3⅜" | 1'-3¾" | 5# EACH | |
| 10 | SP1 | | | PL 1⅝" x 9" SOLE PLATE | 1'-11" | 100# EACH | |
| 40 | PW | | | PL ½" x 5" PLATE WASHER | 5" | 4# EACH | |

| | | | |
|---|---|---|---|
| FINISH | SSPC SP10 | | |
| MATERIAL | AASHTO M270 (ASTM A709) GRADE 50W | | |
| HOLES | 15/16" DIA. (U.N.O.) | | |
| ELECTRODES | PER WELD PROCEDURE | | |
| WELDS | PER WELD PROCEDURE | | |
| SURFACE PREP | SSPC SP6 | | |


| NO | DATE | DESCRIPTION | BY |
|---|---|---|---|
| | | REVISIONS | |

ARC ENTERPRISES, INC.
ADVANCED RESOURCES & CONST. ENTERPRISES, INCORPORATED
P.O. BOX 120 KINGFIELD, ME. 04947
PHONE: (207) 265-2646 – FAX: (207) 265-4054


| | |
|---|---|
| DRAFTER | DLM |
| DATE | OCT. 2015 |
| CHECKED | JJH |
| DATE | OCT. 2015 |

MISCELLANEOUS DETAILS
STOWE, VT. Route 108 (Major Collector) Bridge No. 3
Project No. BRF 0235(15)
cc: CCS CONSTRUCTORS, INC.


PROJECT NO. 15-144
DWG. NO. M1

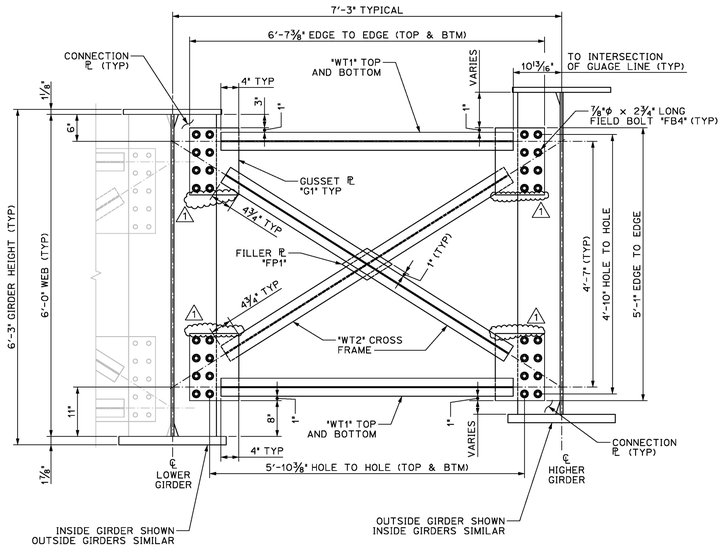


A / M2 TYPICAL CROSS FRAME DETAIL
SCALE: 3/4" = 1'-0"

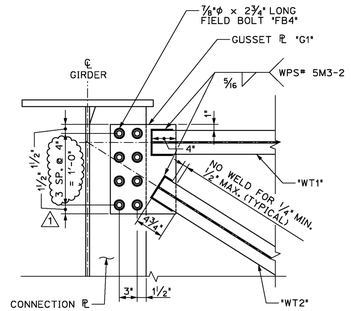



GUSSET ℄ CONNECTION DETAIL
SCALE: 1" = 1'-0"

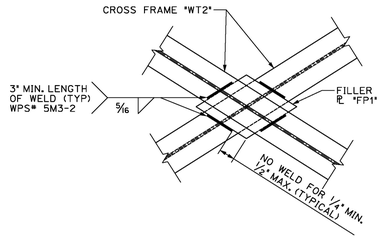



FILLER PLATE WELD DETAIL
SCALE: 1 1/2" = 1'-0"

| | | | | BILL OF MATERIALS | | | |
|---|---|---|---|---|---|---|---|
| SHIP | SHIP MARK | NO. PCS. | PIECE MARK | DESCRIPTION | LENGTH | WT. | MATERIAL |
| 34 | X1 | | | CROSS FRAME | | 370# EACH | |
| | | 68 | WT1 | WT4x7.5 | 3'-7" | 50# EACH | CVN |
| | | 68 | WT2 | WT4x7.5 | 4'-1" | 50# EACH | CVN |
| | | 136 | G1 | ℄ 5/8" x 15" (1) | 11" | 35# EACH (1) | |
| | | 34 | FP1 | ℄ 5/8" x 6" | 9 1/2" | 10# EACH | |
| | | | | | | | |
| 20 | P1 | | | 7/8" x 9 1/2" BEARING STIFFENER | 6'-0" | 170# EACH | CVN |
| 34 | P2 | | | 5/8" x 9 1/2" CONNECTION ℄ | 6'-0" | 125# EACH | CVN |
| 11 | P3 | | | 5/8" x 9 1/2" CONNECTION ℄ | 6'-0" | 125# EACH | CVN |
| 4 | P4 | | | 5/8" x 9 1/2" CONNECTION ℄ | 6'-0" | 125# EACH | CVN |
| 3 | P5 | | | 5/8" x 9 1/2" CONNECTION ℄ | 6'-0" | 125# EACH | CVN |
| 4 | P6 | | | 5/8" x 9 1/2" CONNECTION ℄ | 6'-0" | 125# EACH | CVN |
| 3 | P7 | | | 5/8" x 9 1/2" CONNECTION ℄ | 6'-0" | 125# EACH | CVN |
| 2 | P8 | | | 5/8" x 9 1/2" CONNECTION ℄ | 6'-0" | 125# EACH | CVN |
| 4 | P9 | | | 5/8" x 9 1/2" CONNECTION ℄ | 6'-0" | 125# EACH | CVN |
| 2 | P10 | | | 5/8" x 9 1/2" CONNECTION ℄ | 6'-0" | 125# EACH | CVN |
| 1 | P11 | | | 5/8" x 9 1/2" CONNECTION ℄ | 6'-0" | 125# EACH | CVN |

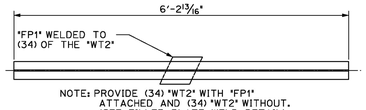



NOTE: PROVIDE (34) "WT2" WITH "FP1" ATTACHED AND (34) "WT2" WITHOUT. (SEE FILLER PLATE WELD DETAIL).


WT 4x7.5 "WT2"
SCALE: 3/4" = 1'-0"

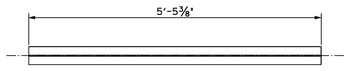


WT 4x7.5 "WT1"
SCALE: 3/4" = 1'-0"

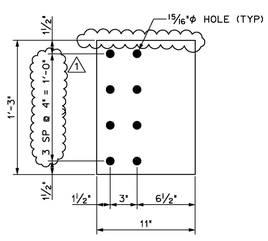


5/8" GUSSET ℄ "G1"
SCALE: 1 1/2" = 1'-0"

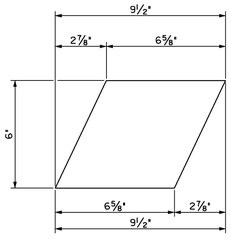



5/8" FILLER ℄ "FP1"
SCALE: 3" = 1'-0"




7/8" STIFFENER ℄, PcMk "P1"
SCALE: 1 1/2" = 1'-0" (20 REQ'D)




5/8" CONNECTION ℄, PcMk VARIES
SCALE: 1 1/2" = 1'-0"

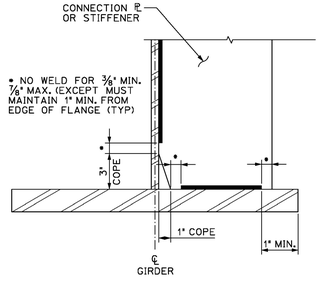


WELD TERMINATION AND COPING DETAIL
SCALE: 2" = 1'-0"

| | | | | |
|---|---|---|---|---|
| FINISH SSPC SP10 | | | | |
| MATERIAL AASHTO M270 (ASTM A709) GRADE 50W | | | | |
| HOLES 15/16" DIA. (U.N.O.) | | | | |
| ELECTRODES PER WELD PROCEDURE | | | | |
| WELDS PER WELD PROCEDURE | | | | |
| SURFACE PREP SSPC SP6 | 1 | 11/16/15 | CHANGED GUSSET PLATE | DLM |
| | NO | DATE | DESCRIPTION | BY |
| | | | REVISIONS | |

ARC ENTERPRISES, INC.
ADVANCED RESOURCES & CONST. ENTERPRISES, INCORPORATED
P.O. BOX 120 KINGFIELD, ME. 04947
PHONE: (207) 265-2646 – FAX: (207) 265-4054

| | | |
|---|---|---|
| DRAFTER DLM | MISCELLANEOUS DETAILS | PROJECT NO. 15-144 |
| DATE OCT. 2015 | STOWE, VT. Route 108 (Major Collector) Bridge No. 3 Project No. BRF 0235(15) | |
| CHECKED JJH | SC: CCS CONSTRUCTORS, INC. | DWG. NO. M2 |
| DATE OCT. 2015 | | |

American Welding Society®

## AWS CERTIFIED WELDER
**Welders, Brazers and Operators**

**John L Ellsworth**

Cert # **0111012W** SSN # **XXX-XX-7074**

**1-800-443-9353 Ext. 273** Information relating to identification and certification of the bearer of this card may be verified by calling or writing:
**Certification Department of the American Welding Society**
8669 NW 36th St., #130, Miami, FL 33166
Verification of the information on this card, including the test date and expiration date can be obtained by visiting the AWS website at *www.aws.org/certification/cw_search.html.*

**VALID ONLY IF ACCOMPANIED BY PHOTO ID**

## American Welding Society®
## CERTIFIED WELDER

*This Card is the property of AWS and shall be returned on demand.*

John L Ellsworth

| # | Test Date | Sup | Code | Process(es) | GAS | Filler Metal | Base Metal | Pos | Thickness,Backing Thickness,Pipe;OD & Backing | Expires |
|---|---|---|---|---|---|---|---|---|---|---|
| 1 | 9/28/2001 | G | D1.1 | SMAW | N/A | F4 | P1 | A | U | 1/10/2016 |
| 2 | 12/12/2011 | G | D1.1 | FCAW | 75/25 | E71T-1 | A36 | ALL | UNLIMITED | 1/10/2016 |
| 3 | 12/12/2011 | G | D1.5 | SMAW | N/A | E7018 | M1 | ALL | UNLIMITED | 1/10/2016 |

## Welding Procedure Specification

Material specification A572 GRADE 50
Welding process SMAW
Manual or machine MANUAL
Position of welding HORIZONTAL & VERTICAL
Filler metal specification AWS A5.1
Filler metal classification E7018
Flux
Shielding gas N/A Flow rate
Single or multiple pass SINGLE
Single or multiple arc SINGLE
Welding current AC/DC
Polarity DCEP
Welding progression STINGER
Root treatment CLEAN TO REMOVE ALL CONTAMINANTS
Preheat and interpass temperature PRE-HEAT AS NEEDED
Postheat treatment

**WELDING PROCEDURE**


| Pass no. | Electrode size | Welding current | | Travel speed | Joint detail |
|---|---|---|---|---|---|
| | | Amperes | Volts | | |
| | 1/8" | 60-140 | 7-10 | VARIES | PILE TIP & SPLICE CONNECTION<br>5/16"<br>PILE FLANGE WELD 5/16" (TYP) |

This procedure may vary due to fabrication sequence, fit-up, pass size, etc., within the limitation of variables given in Section 5. **(of the AASHTO/AWS D1.5 Bridge Welding Code and latest revision)**

Procedure no.
Revision no.
**Welder**
Contractor CCS CONSTRUCTORS, INC
Authorized by
Date 12/30/15

## *Pile tip detail*

- Pile Tips shall be welded onto piles per the specifications of the Manufacturer. These can be welded in the field or in a fabrication plant, however in either case, pre-approval is required for procedures and welder/fabricator by the Agency's Shop Inspector. Piles that arrive to the construction site with tips welded to them without pre-approved procedures/welders are rejectable.

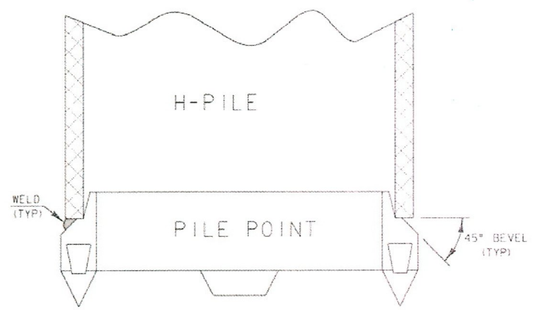


NOTES:

H-PILE SHALL HAVE A SQUARE CUT END FOR THE PILE POINT TO FIT ON TO.

PILE POINT SHALL BE WELDED IN EITHER THE FLAT OF VERTICAL POSITION USING 70XX OR 60XX ELECTRODES.


WELD ACROSS THE FULL WIDTH OF BOTH FLANGES WHILE MAINTAINING THE MINIMUM WELD SIZE ACCORDING TO THE CHART BELOW.

| Pile Size | Flange Thickness | Min. Size Groove Weld* |
|---|---|---|
| HP 14 x 117 | 0.805 | 7/16 |
| HP 14 x 102 | 0.705 | 3/8 |
| HP 14 x 89 | 0.615 | 3/8 |
| HP 14 x 73 | 0.505 | 5/16 |
| HP 12 x 84 | 0.685 | 3/8 |
| HP 12 x 74 | 0.610 | 3/8 |
| HP 12 x 63 | 0.515 | 5/16 |
| HP 12 x 53 | 0.435 | 5/16 |
| HP 10 x 57 | 0.565 | 5/16 |
| HP 10 x 42 | 0.420 | 5/16 |
| HP 8 x 36 | 0.445 | 5/16 |

* UNLESS OTHERWISE SPECIFIED BY THE MANUFACTURER.



Pile Point

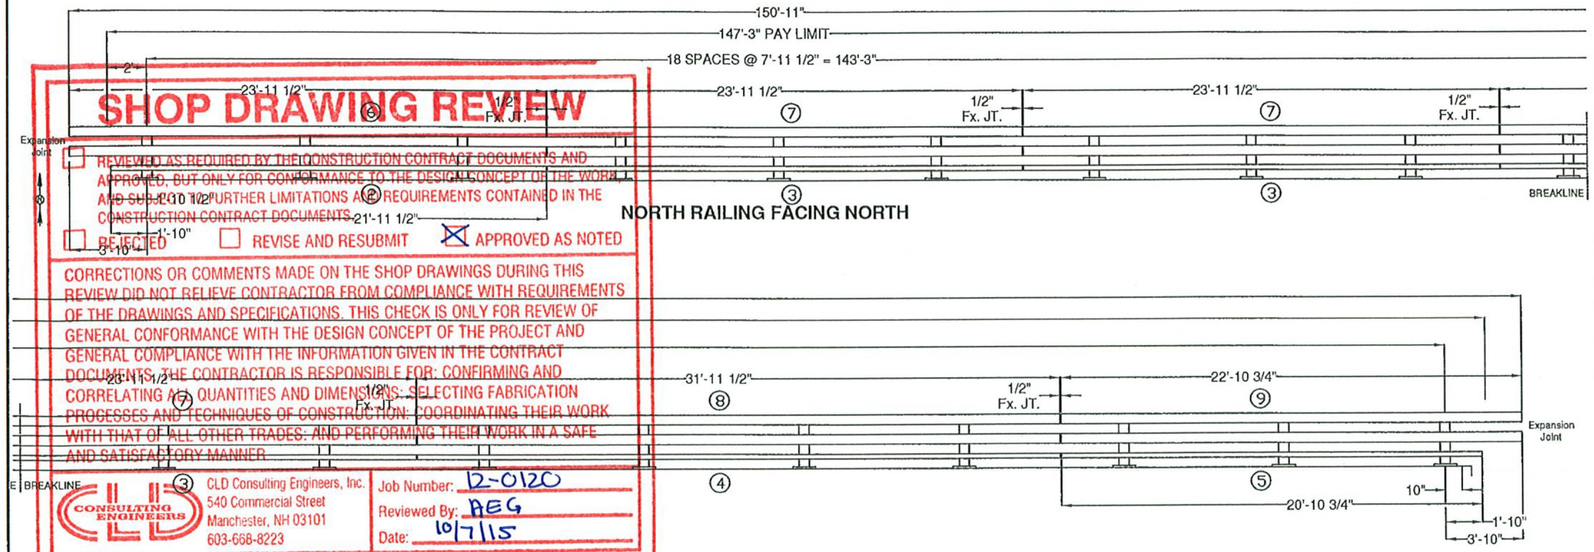


SHOP DRAWING REVIEW

REVIEWED AS REQUIRED BY THE CONSTRUCTION CONTRACT DOCUMENTS AND APPROVED, BUT ONLY FOR CONFORMANCE TO THE DESIGN CONCEPT OF THE WORK AND SUBJECT TO FURTHER LIMITATIONS AND REQUIREMENTS CONTAINED IN THE CONSTRUCTION CONTRACT DOCUMENTS.

☐ REJECTED ☐ REVISE AND RESUBMIT ☒ APPROVED AS NOTED


CORRECTIONS OR COMMENTS MADE ON THE SHOP DRAWINGS DURING THIS REVIEW DID NOT RELIEVE CONTRACTOR FROM COMPLIANCE WITH REQUIREMENTS OF THE DRAWINGS AND SPECIFICATIONS. THIS CHECK IS ONLY FOR REVIEW OF GENERAL CONFORMANCE WITH THE DESIGN CONCEPT OF THE PROJECT AND GENERAL COMPLIANCE WITH THE INFORMATION GIVEN IN THE CONTRACT DOCUMENTS. THE CONTRACTOR IS RESPONSIBLE FOR: CONFIRMING AND CORRELATING ALL QUANTITIES AND DIMENSIONS; SELECTING FABRICATION PROCESSES AND TECHNIQUES OF CONSTRUCTION; COORDINATING THEIR WORK WITH THAT OF ALL OTHER TRADES; AND PERFORMING THEIR WORK IN A SAFE AND SATISFACTORY MANNER.

CLD Consulting Engineers, Inc.
540 Commercial Street
Manchester, NH 03101
603-668-8223


Job Number: 12-0120
Reviewed By: AEG
Date: 10/7/15

GENERAL NOTES:


1) ALL RAILING IS TO BE FABRICATED AND ERECTED ACCORDING TO SECTION 525 OF THE STANDARD SPECIFICATIONS.
2) PRIOR TO GALVANIZING THE ASSEMBLED POST, GRIND ALL EDGES TO A MINIMUM RADIUS OF 1/16".
3) ALL POST SHALL BE SET NORMAL TO GRADE. THE MAXIMUM CENTER TO CENTER SPACING OF BRIDGE RAIL POST IS 8' 3".
4) SECTIONS OF RAIL TUBE SHALL BE ATTACHED TO A MINIMUM OF TWO BRIDGE POSTS AND PREFERABLY TO AT LEAST 4 POSTS.
5) RAIL TUBE EXPANSION JOINTS SHALL BE PROVIDED IN ANY RAIL BAY SPANNING THE END OF AN INTEGRAL ABUTMENT BRIDGE AND AT ALL SUPER STRUCTURE EXPANSION JOINTS. EXPANSION JOINT WIDTH SHALL BE 4"@ 68°F AND WILL BE ADJUSTED IN THE FIELD BY THE ENGINEER FOR OTHER TEMPERATURES.
6) STD. SPLICE HOLES ONLY IN BRIDGE RAIL TUBES. REST TO BE DRILLED BY CUSTOMER. FIELD DRILLED HOLES TO BE COATED WITH AN APPROVED ZINC-RICH PAINT PRIOR TO INSTALLATION.
7) BOLTS SHALL BE TORQUED SNUG TIGHT (APPROXIMATELY 100 FT-LB).
8) SEE STANDARD DRAWING G-1 FOR DETAILS OF DELINEATORS. A DELINEATOR SHALL BE INSTALLED AT 30 FOOT SPACING OR THE NEAREST POST. WHITE IS TO BE INSTALLED ON THE DRIVER'S RIGHT. FOR ONE WAY BRIDGES, YELLOW IS TO BE INSTALLED ON THE DRIVER'S LEFT. PAYMENT FOR DELINEATORS SHALL BE INCIDENTAL TO OTHER ITEMS.
9) ANY BENDING OF RAIL SHALL BE DONE AT THE FABRICATION PLANT ACCORDING TO A PROCEDURE PROVIDED BY THE FABRICATOR.
10) THE MINIMUM DISTANCE FROM THE POST TO AN EXPANSION JOINT SHALL BE DETERMINED BY THE MINIMUM EDGE DISTANCE OF 5" FROM ANY ANCHOR STUD TO THE END OF THE SLAB, OR THE EXPANSION JOINT RECESS POUR, IF ONE IS USED.
11) PROTRUSIONS CAUSED BY WELDING OR GALVANIZING ARE NOT PERMITTED ON THE ADJOINING SURFACES OF THE BOX BEAM RAILS, SPLICE TUBES AND FILL PLATES.
12) THIS RAILING MEETS THE REQUIREMENTS FOR A TL-4 SERVICE LEVEL.

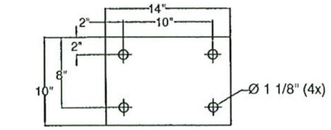



1/8" FABRIC PAD

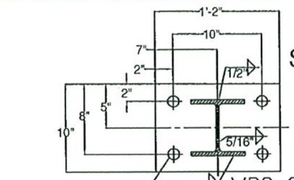



SECTION A-A

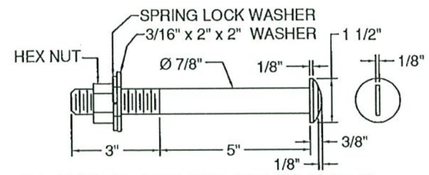


SLOTTED ROUND HEAD BOLT

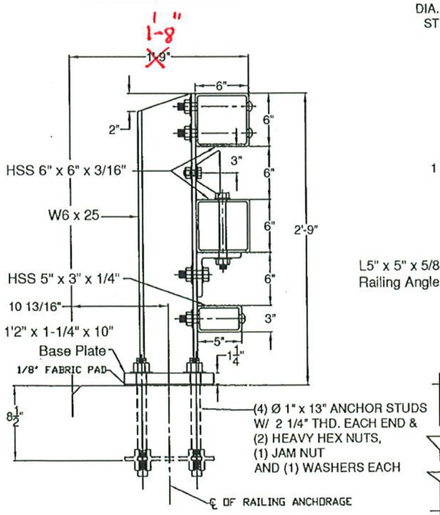



SECTION

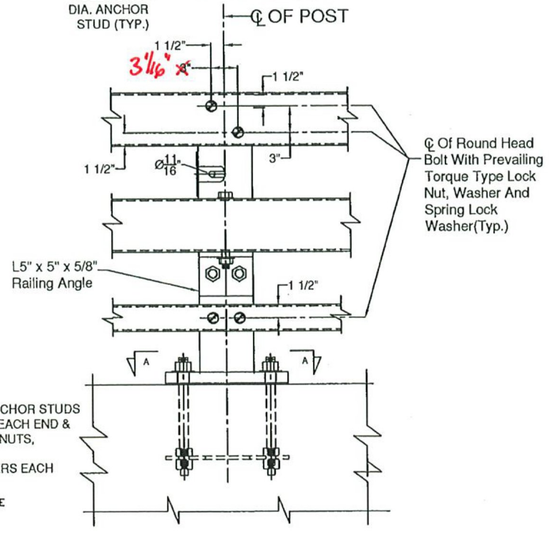



ELEVATION

STEEL BRIDGE RAILING

BRIDGE POST DETAIL

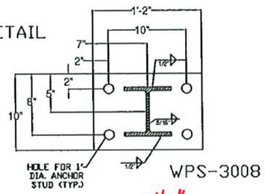

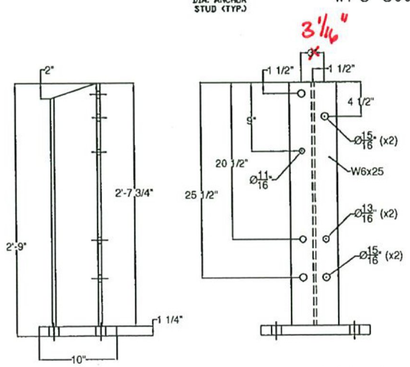
BILL OF MATERIAL - NORTH

| ITEM # | QTY | PART # | DESCRIPTION | ASTM DESIGNATION |
|---|---|---|---|---|
| 1 | 19 | 0033.03610 | W6x25, THREE RAIL POST @ 2'-9" OA ON 1 1/4x10x1'-2" B.P. | A572 Gr. 50 |
| 2 | 1 | 0033.22200 | HSS 3" X 5" X 1/4" RAIL @ 21'-11 1/2" (EXP) | A500 Gr. B |
| 3 | 3 | 0033.12400 | HSS 3" X 5" X 1/4" RAIL @ 23'-11 1/2" | A500 Gr. B |
| 4 | 1 | 0033.13200 | HSS 3" X 5" X 1/4" RAIL @ 31'-11 1/2" | A500 Gr. B |
| 5 | 1 | 0033.22003 | HSS 3" X 5" X 1/4" RAIL @ 20'-10 3/4" (EXP) | A500 Gr. B |
| 6 | 2 | 0033.62400 | HSS 6" X 6" X 3/16" RAIL @ 23'-11 1/2" (EXP) | A500 Gr. B |
| 7 | 6 | 0033.52400 | HSS 6" X 6" X 3/16" RAIL @ 23'-11 1/2" | A500 Gr. B |
| 8 | 2 | 0033.53200 | HSS 6" X 6" X 3/16" RAIL @ 31'-11 1/2" | A500 Gr. B |
| 9 | 2 | 0033.62211 | HSS 6" X 6" X 3/16" RAIL @ 22'-10 3/4" (EXP) | A500 Gr. B |
| 10 | 5 | 0033.00840 | 2-1/8" X 4-1/4" FIX. SPLICE BAR @ 2'-3" | A572 Gr. 50 |
| 11 | 10 | 0033.00640 | HSS 5" X 5" X 5/16" FIX. SPLICE TUBE @ 2'-3" | A500 Gr. B, A572 Gr. 50 |
| 12 | 19 | 0033.00220 | 3/8" X 10" X 14" ANCHOR PLATES | A572 Gr. 50 |
| 13 | 19 | 0033.90050 | 1/8" X 10" X 14" FABRIC PAD | AASHTO M251 |
| 14 | 78* | 0042.21013 | Ø 1" X 13" ANCHOR STUDS, W/ 2 1/4" THD. EACH END | A449 |
| 15 | 154* | 0080.18901 | Ø 1" HEAVY HEX NUTS | A563 DH |
| 16 | 76 | 0080.18911 | Ø 1" FLAT WASHERS | F436 |
| 17 | 76 | 0080.18905 | Ø 1" HEX JAM NUTS | A563 DH |
| 18 | 76 | 0080.07500 | Ø 7/8" X 8" ROUND HEAD BOLT, NUT, SQ. WASHER, L.W. | A449, A563 DH, F436, ASME D18.2 |
| 19 | 19 | 0080.06400 | Ø 3/4" X 8" HEX BOLT, NUT, (2) F.W., & L.W. | A325, A563 DH, F436, & ASME D18.2 |
| 20 | 38 | 0080.06140 | Ø 3/4" X 2-3/4" HEX BOLT, NUT, (2) F.W., & L.W. | A325, A563 DH, F436, & ASME D18.2 |
| 21 | 40 | 0080.06340 | Ø 3/4" X 7-1/2" HEX BOLT, NUT, & (2) F.W. | A325, A563 DH, & F436 |
| 22 | 20 | 0080.06255 | Ø 3/4" X 4-1/2" HEX BOLT, NUT, & (2) F.W. | A325, A563 DH, & F436 |
| 23 | 19 | 0033.00500 | L5" X 5" X 5/8" RAILING ANGLE @ 6' | A572 Gr. 50 |
| 24 | 5 | | DELINEATORS - NOT SHOWN | (SUPPLIED BY CUSTOMER) |

*-2 EXTRA FOR VOAT TESTING

ITEM #: 525.335

STRUCTURAL STEEL TO COMPLY W/ ASTM A6

TOLERANCE UNLESS OTHERWISE NOTED:
FRACTIONS = ± 1/16"
ANGLES = ± 1/2°
DIAMETERS = ± 1/32"

SHEET 1 OF 3

# BRIDGE RAIL DETAILS SHEET

VT ROUTE 108 (MAJOR COLLECTOR), BRIDGE # 3
TOWN OF STOWE, COUNTY OF LAMOILLE, VT.

| R/E/V | NO. | DATE | DESCRIPTION | BY |
|---|---|---|---|---|
| | | | | |

| R/E/V | NO. | DATE | DESCRIPTION | BY |
|---|---|---|---|---|
| | | | | |


ELDERLEE, INC.
OAKS CORNERS, NEW YORK 14518
email: dlong@elderlee.com / epeck@elderlee.com
Tel: 315-789-6670 Fax: 315-789-6615

AISC CERTIFIED FABRICATOR


ORTHOGRAPHIC PROJECTION

| | | |
|---|---|---|
| DRAWN | E.P. | 9/1/15 |
| CHECKED | D.L. | 9/1/15 |
| APPROVED | . | . |
| SCALE | SCHEMATIC | |

DRAWING NO. F.R.L.-STOWE BRF 0235 (15)

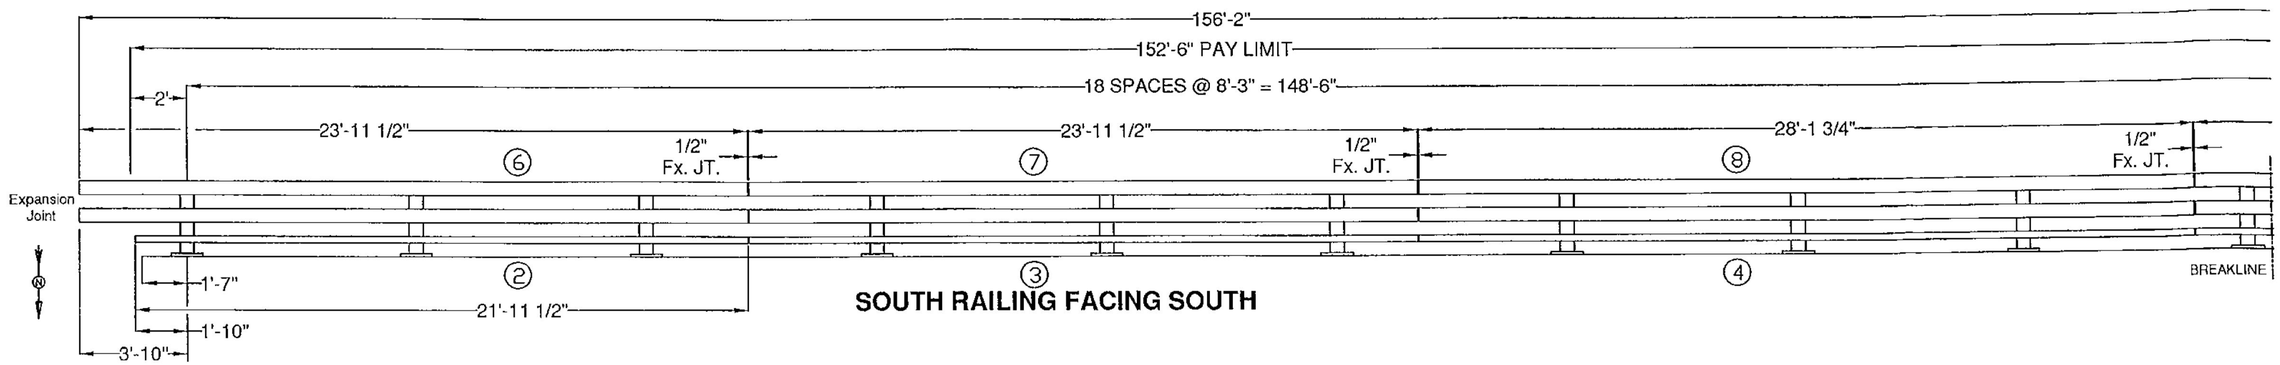


## SOUTH RAILING FACING SOUTH

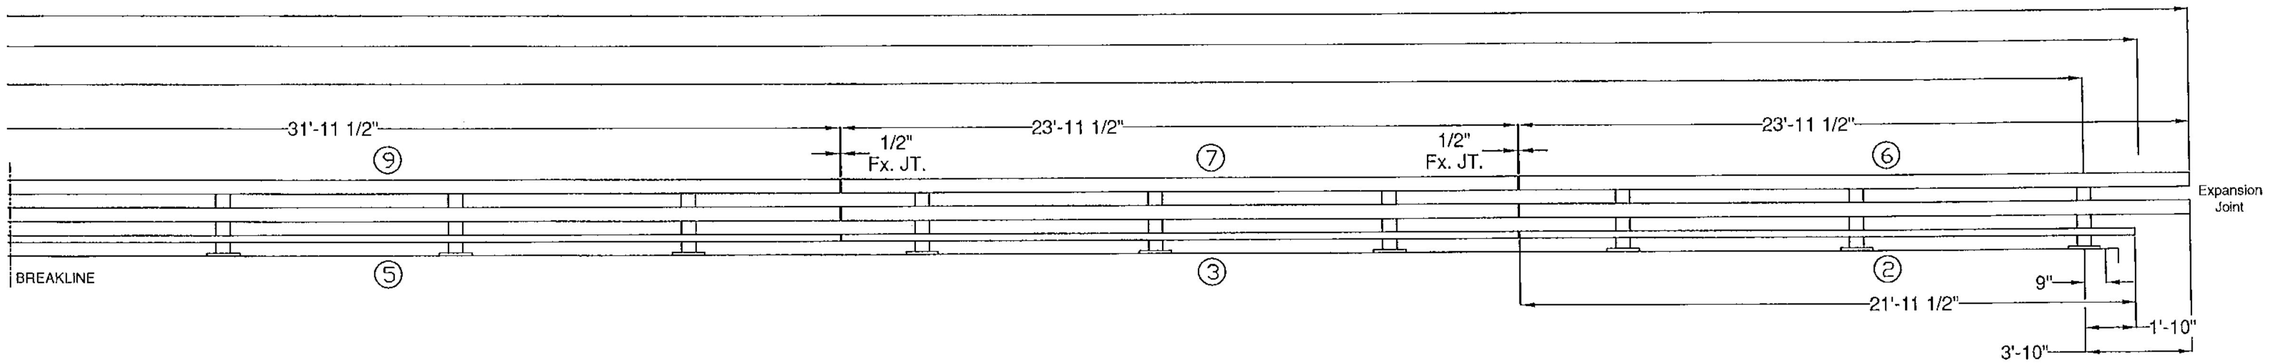


| BILL OF MATERIAL - SOUTH | | | | |
|---|---|---|---|---|
| ITEM # | QTY | PART # | DESCRIPTION | ASTM DESIGNATION |
| 1 | 19 | 0033.03610 | W6x25, THREE RAIL POST @ 2'-9" OA ON 1 1/4x10x1'-2" B.P. | A572 Gr. 50 |
| 2 | 2 | 0033.22200 | HSS 3" X 5" X 1/4" RAIL @ 21'-11 1/2" (EXP) | A500 Gr. B |
| 3 | 2 | 0033.12400 | HSS 3" X 5" X 1/4" RAIL @ 23'-11 1/2" | A500 Gr. B |
| 4 | 1 | 0033.128011 | HSS 3" X 5" X 1/4" RAIL @ 28'-1 3/4" | A500 Gr. B |
| 5 | 1 | 0033.23200 | HSS 3" X 5" X 1/4" RAIL @ 31'-11 1/2" (EXP) | A500 Gr. B |
| 6 | 4 | 0033.62400 | HSS 6" X 6" X 3/16" RAIL @ 23'-11 1/2" (EXP) | A500 Gr. B |
| 7 | 4 | 0033.52400 | HSS 6" X 6" X 3/16" RAIL @ 23'-11 1/2" | A500 Gr. B |
| 8 | 2 | 0033.528011 | HSS 6" X 6" X 3/16" RAIL @ 28'-1 3/4" | A500 Gr. B |
| 9 | 2 | 0033.53200 | HSS 6" X 6" X 3/16" RAIL @ 31'-11 1/2" | A500 Gr. B |
| 10 | 5 | 0033.00840 | 2-1/8" X 4-1/4" FIX. SPLICE BAR @ 2'-3" | A572 Gr. 50 |
| 11 | 10 | 0033.00640 | HSS 5" X 5" X 5/16" FIX. SPLICE TUBE @ 2'-3" | A500 Gr. B, A572 Gr. 50 |
| 12 | 19 | 0033.00220 | 3/8" X 10" X 14" ANCHOR PLATES | A572 Gr. 50 |
| 13 | 19 | 0033.90050 | 1/8" X 10" X 14" FABRIC PAD | AASHTO M251 |
| 14 | 76 | 0042.21013 | ø 1" X 13" ANCHOR STUDS, W/ 2 1/4" THD. EACH END | A449 |
| 15 | 152 | 0080.18901 | ø 1" HEAVY HEX NUTS | A563 DH |
| 16 | 76 | 0080.18911 | ø 1" FLAT WASHERS | F436 |
| 17 | 76 | 0080.18905 | ø 1" HEX JAM NUTS | A563 DH |
| 18 | 76 | 0080.07500 | ø 7/8" X 8" ROUND HEAD BOLT, NUT, SQ. WASHER, L.W. | A449, A563 DH, F436, ASME D18.2 |
| 19 | 19 | 0080.06400 | ø 3/4" X 8" HEX BOLT, NUT, (2) F.W., & L.W. | A325, A563 DH, F436, & ASME D18.2 |
| 20 | 38 | 0080.06140 | ø 3/4" X 2-3/4" HEX BOLT, NUT, (2) F.W., & L.W. | A325, A563 DH, F436, & ASME D18.2 |
| 21 | 40 | 0080.06340 | ø 3/4" X 7-1/2" HEX BOLT, NUT, & (2) F.W. | A325, A563 DH, & F436 |
| 22 | 20 | 0080.06255 | ø 3/4" X 4-1/2" HEX BOLT, NUT, & (2) F.W. | A325, A563 DH, & F436 |
| 23 | 19 | 0033.00500 | L5" X 5" X 5/8" RAILING ANGLE @ 6" | A572 Gr. 50 |
| 24 | 5 | | DELINEATORS - NOT SHOWN | (SUPPLIED BY CUSTOMER) |

ITEM #: 525.335

SHEET 2 OF 3

STRUCTURAL STEEL TO COMPLY W/ ASTM A6

TOLERANCE UNLESS OTHERWISE NOTED:
FRACTIONS = ± 1/16"
ANGLES = ± 1/2°
DIAMETERS = ± 1/32"

# BRIDGE RAIL DETAILS SHEET

VT ROUTE 108 (MAJOR COLLECTOR), BRIDGE # 3
TOWN OF STOWE, COUNTY OF LAMOILLE, VT.

| R E V | NO. | DATE | DESCRIPTION | BY | R E V | NO. | DATE | DESCRIPTION | BY |
|---|---|---|---|---|---|---|---|---|---|
| | | | | | | | | | |

ELDERLEE, INC.
OAKS CORNERS, NEW YORK 14518
email: dlong@elderlee.com / spesk@elderlee.com
Tel: 315-789-6670 Fax: 315-789-6615


AISC CERTIFIED FABRICATOR


ORTHOGRAPHIC PROJECTION


| | | |
|---|---|---|
| DRAWN | E.P. | 9/1/15 |
| CHECKED | D.L. | 9/1/15 |
| APPROVED | . | . |
| SCALE | SCHEMATIC | |


DRAWING NO. F.R.L.-STOWE BRF 0235 (15)


## SPLICE BAR - FIXED

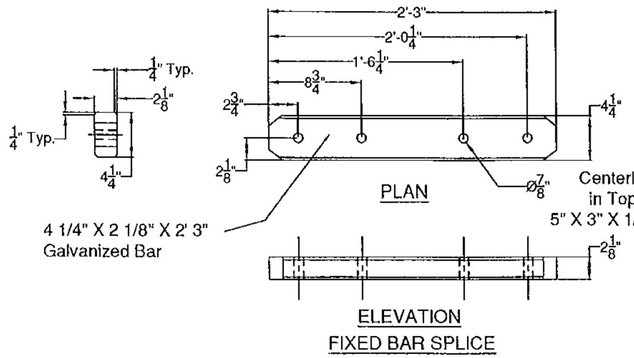


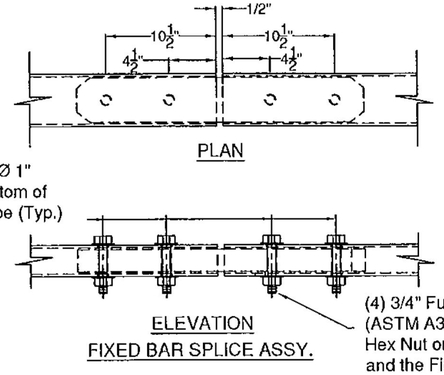


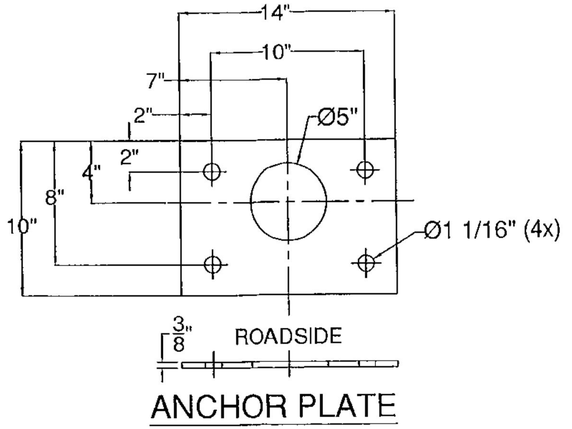
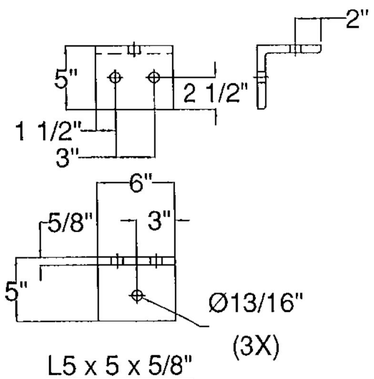


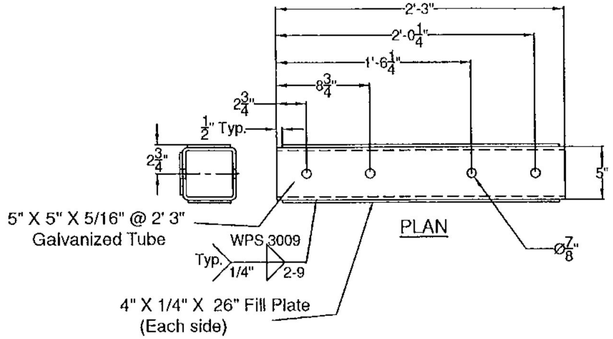
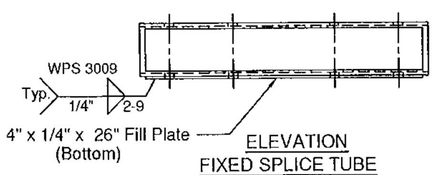
## SPLICE TUBE - FIXED

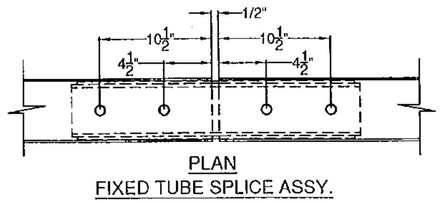ITEM #: 525.335

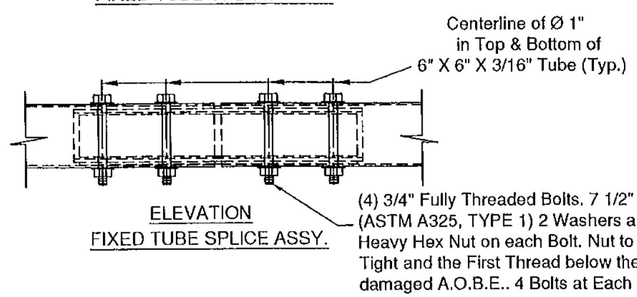STRUCTURAL STEEL TO COMPLY W/ ASTM A6

TOLERANCE UNLESS OTHERWISE NOTED:
FRACTIONS = ± 1/16"
ANGLES = ± 1/2°
DIAMETERS = ± 1/32"

SHEET 3 OF 3

# BRIDGE RAIL DETAILS SHEET

VT ROUTE 108 (MAJOR COLLECTOR), BRIDGE # 3
TOWN OF STOWE, COUNTY OF LAMOILLE, VT.

| R E V | NO. | DATE | DESCRIPTION | BY | R E V | NO. | DATE | DESCRIPTION | BY |
|---|---|---|---|---|---|---|---|---|---|
| | | | | | | | | | |


ELDERLEE, INC.
OAKS CORNERS, NEW YORK 14518
email:dlong@elderlee.com / epeek@elderlee.com
Tel:315-789-6670 Fax:315-789-6615


AISC CERTIFIED FABRICATOR
ORTHOGRAPHIC PROJECTION

| | | |
|---|---|---|
| DRAWN | E.P. | 9/1/15 |
| CHECKED | D.L. | 9/1/15 |
| APPROVED | | |
| SCALE | SCHEMATIC | |
| DRAWING NO. | F.R.L.-STOWE BRF 0235 (15) | |


## WELDING PROCEDURE SPECIFICATION

PQR ELDERLEE#1

| | | | |
|---|---|---|---|
| Material Specification | A572 GRD. 50 /A992-06a | | |
| Welding Process | FCAW | | |
| Manual or Machine | SEMAUTOMATIC | | |
| Position of Welding | FLAT/HORIZONTAL | | |
| Filler Metal Specification | A5.20 | | |
| Filler Metal Classification | E70 LINCOLN OUTERSHEILD | | |
| Flux | N/A | | |
| Shielding Gas | CO 2 | Dew Point -40DEG F | Flow Rate 50 CFM (45 TO 63 CFM) |
| Single or Multiple Pass | SINGLE | | |
| Single or Multiple Arc | N/A | | |
| Welding Current | DC | | |
| Polarity | DCEP | | |
| Welding Progression | STRINGER | | |
| Root Treatment | PER D1.5 | | |
| Preheat and Interpass Temperature | PER D1.5 | | |
| Postheat Temperature | NONE | | |
| Heat Input | Min | Max | |

### WELDING PROCEDURE

| Pass no. | Electrode size | Welding Current Amperes | Welding Current Volts | Travel speed | Joint detail |
|---|---|---|---|---|---|
| 1 | 3/32 | 390 | 27 | 12 | |
| Variable | LIMITS | 351 TO 429 | 25 TO 29 | 11 TO 13 | |

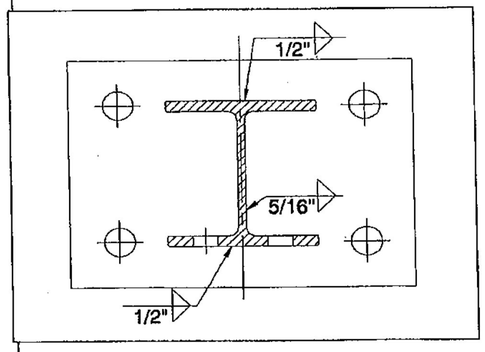


This procedure may vary due to fabrication sequence, fit-up, pass size, etc., within the limitation of variables given in Section 5.

Procedure No. 3008

Revision No.

Contractor Elderlee, Inc.

Authorized By RANDY SCOTT


Date 5/29/2013

## WELDING PROCEDURE SPECIFICATION

PQR ELDERLEE #3

| | |
|---|---|
| Material Specification | A709 TO A500 GR B |
| Welding Process | FCAW-G |
| Manual or Machine | SEMAUTOMATIC |
| Position of Welding | FLAT/HORIZONTAL |
| Filler Metal Specification | A5.29 |
| Filler Metal Classification | E81T1-Ni1C-JH4 |
| Flux | N/A |
| Shielding Gas | CO 2 Dew Point -40DEG F Flow Rate 50CFH |
| Single or Multiple Pass | SINGLE |
| Single or Multiple Arc | SINGLE |
| Welding Current | DC |
| Polarity | REVERSE ELECTRODE POSITIVE |
| Welding Progression | STRINGER |
| Root Treatment | D1.5 |
| Preheat and Interpass Temperature | D1.5 |
| Postheat Temperature | NONE |
| Heat Input | Min _____ Max _____ |

### WELDING PROCEDURE
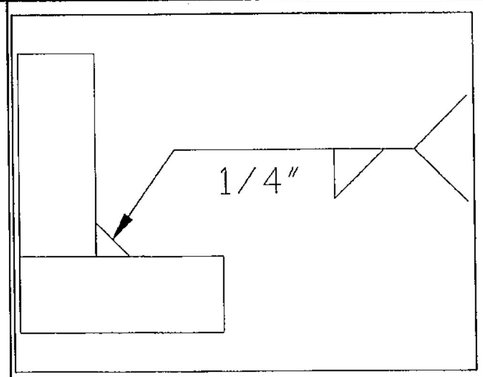
| Pass no. | Electrode size | Welding Current Amperes | Welding Current Volts | Travel speed | Joint detail |
|---|---|---|---|---|---|
| 1 | 1/16 | 310 | 25 | 11 |  |
| Variable | LIMITS | 341 TO 269 | 27 TO 23 | 12 TO 10 | |



This procedure may vary due to fabrication sequence, fit-up, pass size, etc., within the limitation of variables given in Section 5.

Procedure No. 3009

Revision No. _____


Contractor Elderlee, Inc.


Authorized By RANDY SCOTT

Date 3/20/2014

32' - PAY LIMIT FOR TRANSITION - BRIDGE RAILING TO BOX BEAM GUIDE RAIL

ELEVATION VIEW

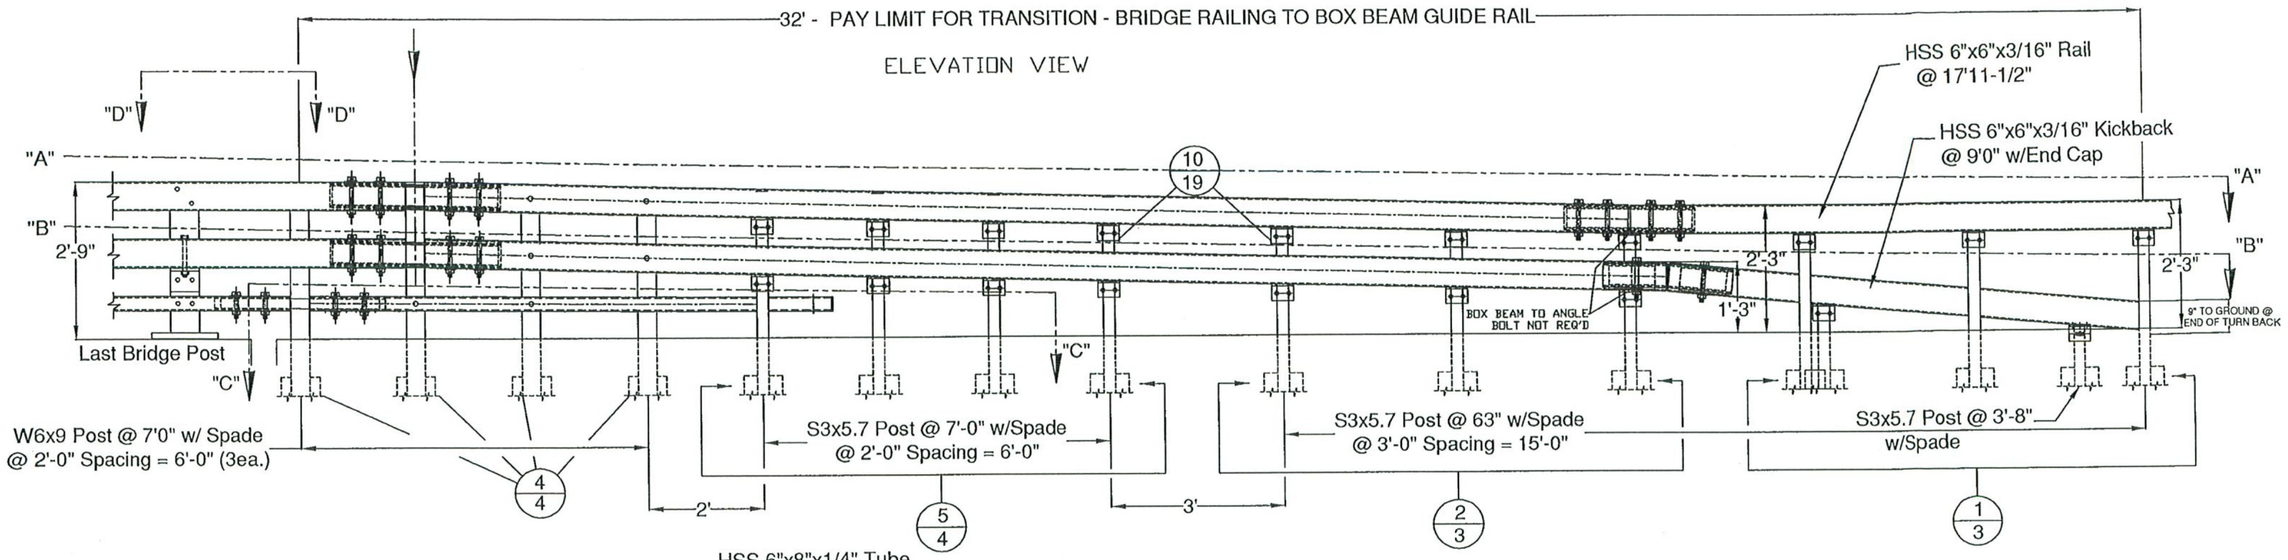

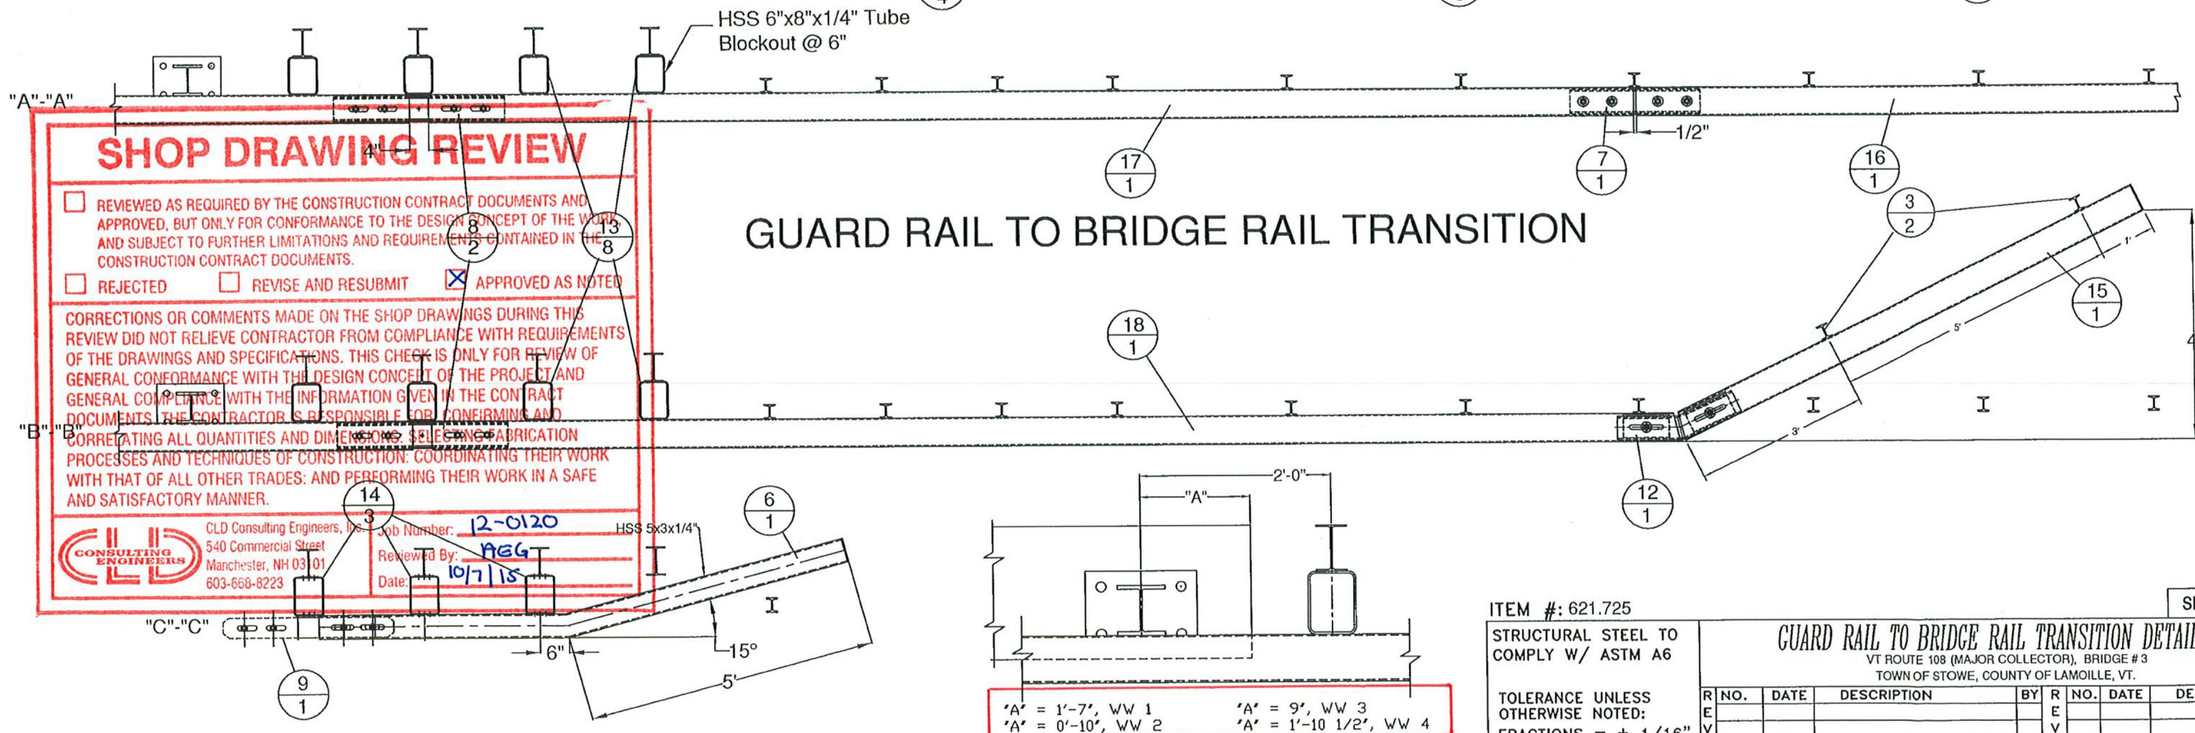



VIEW "D"-"D"

please note that these dimensions are measured at the front face of the rail

# GUARD RAIL TO BRIDGE RAIL TRANSITION

SHOP DRAWING REVIEW

☐ REVIEWED AS REQUIRED BY THE CONSTRUCTION CONTRACT DOCUMENTS AND APPROVED, BUT ONLY FOR CONFORMANCE TO THE DESIGN CONCEPT OF THE WORK AND SUBJECT TO FURTHER LIMITATIONS AND REQUIREMENTS CONTAINED IN THE CONSTRUCTION CONTRACT DOCUMENTS.

☐ REJECTED ☐ REVISE AND RESUBMIT ☒ APPROVED AS NOTED

CORRECTIONS OR COMMENTS MADE ON THE SHOP DRAWINGS DURING THIS REVIEW DID NOT RELIEVE CONTRACTOR FROM COMPLIANCE WITH REQUIREMENTS OF THE DRAWINGS AND SPECIFICATIONS. THIS CHECK IS ONLY FOR REVIEW OF GENERAL CONFORMANCE WITH THE DESIGN CONCEPT OF THE PROJECT AND GENERAL COMPLIANCE WITH THE INFORMATION GIVEN IN THE CONTRACT DOCUMENTS. THE CONTRACTOR IS RESPONSIBLE FOR CONFIRMING AND CORRELATING ALL QUANTITIES AND DIMENSIONS, SELECTING FABRICATION PROCESSES AND TECHNIQUES OF CONSTRUCTION, COORDINATING THEIR WORK WITH THAT OF ALL OTHER TRADES, AND PERFORMING THEIR WORK IN A SAFE AND SATISFACTORY MANNER.

CLD Consulting Engineers, Inc.
540 Commercial Street
Manchester, NH 03101
603-668-8223

Job Number: 12-0120
Reviewed By: AEG
Date: 10/7/15

ITEM #: 621.725

STRUCTURAL STEEL TO COMPLY W/ ASTM A6

TOLERANCE UNLESS OTHERWISE NOTED:
FRACTIONS = ± 1/16"
ANGLES = ± 1/2°
DIAMETERS = ± 1/32"

SHEET 1 OF 5

## GUARD RAIL TO BRIDGE RAIL TRANSITION DETAILS SHEET

VT ROUTE 108 (MAJOR COLLECTOR), BRIDGE # 3
TOWN OF STOWE, COUNTY OF LAMOILLE, VT.

| REV | NO. | DATE | DESCRIPTION | BY |
|---|---|---|---|---|
| | | | | |

| REV | NO. | DATE | DESCRIPTION | BY |
|---|---|---|---|---|
| | | | | |



ELDERLEE, INC.
OAKS CORNERS, NEW YORK 14518
email: dlong@elderlee.com / epeek@elderlee.com
Tel: 315-789-6670 Fax: 315-789-6616


CERTIFIED FABRICATOR

ORTHOGRAPHIC PROJECTION


| | | |
|---|---|---|
| DRAWN | E.P. | 9/1/15 |
| CHECKED | D.L. | 9/1/15 |
| APPROVED | . | . |
| SCALE | SCHEMATIC | |
| DRAWING NO. | F.R.L.-STOWE BRF 0235 (15) | |

PLAN VIEW

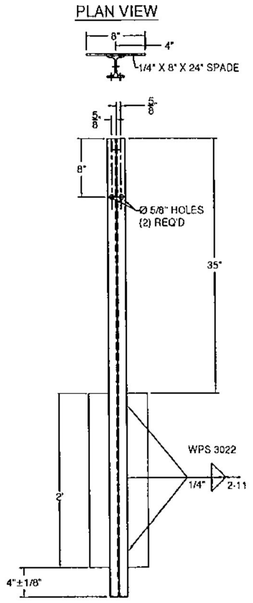


FRONT


STANDARD POST DETAIL
(POST #12)

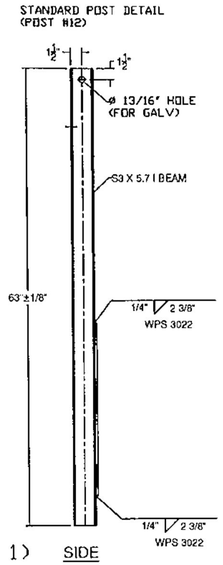


( ITEM # 1 )

SIDE


PLAN VIEW

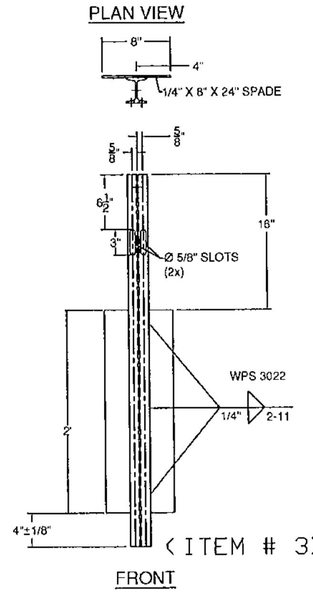


FRONT


( ITEM # 3 )

END POST DETAIL

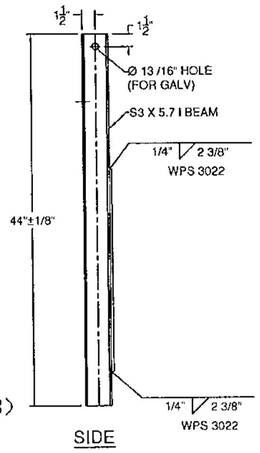


SIDE


PLAN VIEW

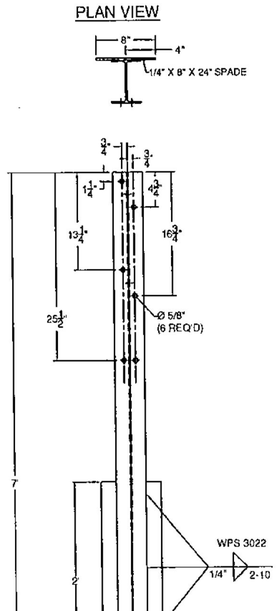


FRONT


( ITEM # 4 )

HEAVY POST DETAIL
(POST #1 ~ 4)

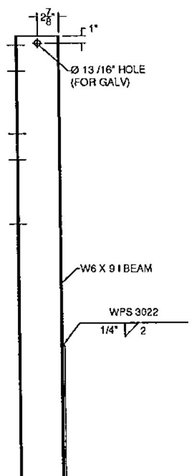


SIDE


PLAN VIEW

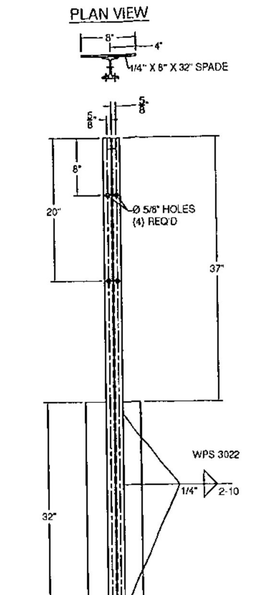


( ITEM # 5 )

FRONT

TRANSITION POST DETAIL
(POST #5 ~ 8)

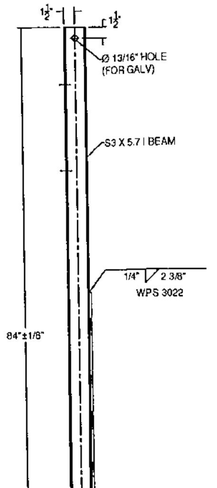



SIDE

GENERAL NOTES:

1) ALL RAILING IS TO BE FABRICATED AND ERECTED ACCORDING TO SECTION 525 OF THE STANDARD SPECIFICATIONS.
2) BOLTS SHALL BE TORQUED SNUG TIGHT (APPROXIMATELY 100 FT-LB).
3) PROTRUSIONS CAUSED BY WELDING OR GALVANIZING ARE NOT PERMITTED ON THE ADJOINING SURFACES OF THE BOX BEAM RAILS, SPLICE TUBES AND FILL PLATES.
4) BOX BEAM TUBE AND STEEL POST MATERIALS, DIMENSION SIZES AND NOTES SHALL BE THE SAME AS THOSE OF THE BRIDGE RAIL, UNLESS OTHERWISE NOTED.
5) ANY BENDING OF RAIL SHALL BE DONE AT THE FABRICATION PLANT. RADII GREATER THAN 16' TO BE CURVED ON A TUBE BENDING MACHINE, RADII EQUAL OR LESS THAN 16' TO BE "PIE CUT" AND WELDED. CURVED RAILING WIIL HAVE AN 18" LENGTH ON EACH END STRAIGHT TO ACCOMADATE SPLICES. "PIE CUTS ARE LOCATED SO AS TO NOT CONFLICT WITH POST FASTENING HOLES. PIE CUTS WILL BE WELDED ACCORDING TO PROCEDURE WPS-3026.


PLAN VIEW

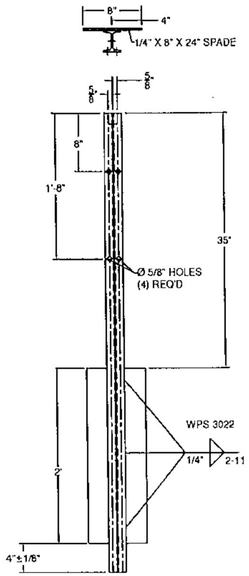


FRONT

( ITEM # 2 )

TRANSITION STANDARD
POST DETAIL
(POST #9 ~ 11)

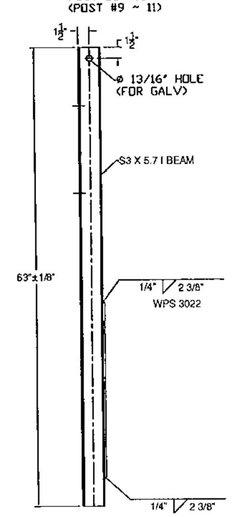


SIDE

BILL OF MATERIALS (EACH CORNER)

| ITEM # | QTY. | COMPONENT # | DESCRIPTION | MATERIAL (ASTM) |
|---|---|---|---|---|
| 1 | 3 | 0013.57021 | S3 X 5.7 POST, PUNCH 8' W/SPD @ 63" LG | ASTM A572 Gr. 50 |
| 2 | 3 | 0013.57025 | S3 X 5.7 POST, PUNCH 8', & 20' W/SPD @ 63" LG | ASTM A572 Gr. 50 |
| 3 | 2 | 0013.57060 | S3 X 5.7 END POST W/SPD @ 3'-8" LG | ASTM A572 Gr. 50 |
| 4 | 4 | 0013.09001 | W6 X 9 POST @ 7' W/SPD & 5/8" HOLES | ASTM A572 Gr. 50 |
| 5 | 4 | 0013.57010 | S3 X 5.7 POST, PUNCH 8' & 20', W/8X32" SPADE @7' | ASTM A572 Gr. 50 |
| 6 | 1 | 0033.80403 | 3 X 5' BTM TRANS RAIL W/5'-0" KB, EXP END | A500 Gr. B |
| 7 | 1 | 0033.00640 | HSS 5X5 TUBE SPLICE @27" LG W/ 1/4" SHIMS | A500 Gr. B / A572 Gr 50 |
| 8 | 2 | 0033.00730 | HSS 5x5 EXP TUBE SPLICE @ 36" LG W/ 1/4" SHIMS | A500 Gr. B / A572 Gr 50 |
| 9 | 1 | 0033.00930 | BR EXP BAR SPLICE 2-1/8" X 4-1/4" @ 36" LG | ASTM A36 |
| 10 | 19 | 0054.00050 | REG BB SHELF ANGLES @ 4-1/2" | ASTM A36 |
| 12 | 1 | 0054.00074 | HSS 5 X 5 X 5/16" DBL BEND TUBE SPL @ 27" LG, | A500 Gr. B / A572 Gr 50 |
| 13 | 8 | 0054.00563 | 6 X 8 X 1/4" TRANS. TUBE B/O @ 6" LG | A500 Gr. B |
| 14 | 3 | 0054.00565 | 6 X 8 X 1/4" TRANS. TUBE B/O @ 3" LG | A500 Gr. B |
| 15 | 1 | 0054.09000 | 6 X 6 x 3/16" BB @ 9'-0" KICKBACK, W/ CAP, & 13° MITER | A500 Gr. B / A36 |
| 16 | 1/2 | 0054.18000 | 6 X 6 x 3/16" BB @ 17'-11 1/2" (9'-0" THIS PAY ITEM), DRILL 3' CC | A500 Gr. B |
| 17 | 1 | 0054.90092 | 6 X 6 x 3/16" BB TOP TRANS @ 20'-9 5/8" LG W/EXP END | A500 Gr. B |
| 18 | 1 | 0054.90093 | 6 X 6 x 3/16" BB BTM TRANS @ 21'-4 5/8" LG W/EXP END | A500 Gr. B |
| 19 | 18 | 0080.03355 | 3/8" X 7 1/2" BOLT, NUT, & 2 FW | A307, A563 DH, F436 |
| 20 | 19 | 0080.04100 | 1/2" x 1-1/2" BOLT, NUT, & FW | A307, A563 DH, F436 |
| 21 | 22 | 0080.04120 | 1/2" x 1-1/2" BOLT, NUT, 2 FW & LW | A307, A563 DH, F436 |
| 22 | 4 | 0080.06255 | 3/4" X 4-1/2" BOLT, NUT, 2 FW | A325, A563 DH, F436 |
| 23 | 12 | 0080.06340 | 3/4" X 7-1/2" BOLT, NUT, 2 FW | A325, A563 DH, F436 |
| 24 | 6 | 0080.06370 | 3/4" X 8" CARR BOLT, NUT, FW & LW | A307, A563 DH, F436 |
| 25 | 2 | 0080.06400 | 3/4" X 8" BOLT, NUT, 2 FW, & LW | A325, A563 DH, F436 |

HARDWARE NOTES

| ITEM # | FUNCTION |
|---|---|
| 19 | BOLT RAIL TO SHELF ANGLE (ITEM #10) |
| 20 | BOLT SHELF ANGLE (ITEM #'S 10 & 11) TO POST |
| 21 | BOLT BLOCK-OUTS (ITEM #'S 13 & 14) TO HEAVY POST |
| 22 | (4) PER SPLICE BAR (ITEM #9) |
| 23 | (4) PER SPLICE TUBING (ITEM #'S 7 & 8) |
| 24 | BOLT RAIL (ITEMS #'S 6,17, & 18 TO BLOCK-OUTS (ITEM #'S 13 & 14) (WHERE FASTENED) |
| 25 | BOLT DOUBLE BEND SPLICE TUBE (ITEM #12) TO RAIL (ITEM #18) & KICKBACK (ITEM #15) |

APPLICABLE NOTES IN THE BRIDGE RAIL DRAWING SHALL ALSO BE APPLICABLE ON THESE DRAWINGS

ITEM #: 621.725

STRUCTURAL STEEL TO COMPLY W/ ASTM A6

TOLERANCE UNLESS OTHERWISE NOTED:
FRACTIONS = ± 1/16"
ANGLES = ± 1/2°
DIAMETERS = ± 1/32"

SHEET 2 OF 5

# GUARD RAIL TO BRIDGE RAIL TRANSITION DETAILS SHEET

VT ROUTE 108 (MAJOR COLLECTOR), BRIDGE # 3
TOWN OF STOWE, COUNTY OF LAMOILLE, VT.

| R E V | NO. | DATE | DESCRIPTION | BY |
|---|---|---|---|---|
| | | | | |

| R E V | NO. | DATE | DESCRIPTION | BY |
|---|---|---|---|---|
| | | | | |



ELDERLEE, INC.
OAKS CORNERS, NEW YORK 14518
email:dlong@elderlee.com / epeek@elderlee.com
Tel:315-789-6670 Fax:315-789-6616



AISC CERTIFIED FABRICATOR

ORTHOGRAPHIC PROJECTION


| | | |
|---|---|---|
| DRAWN | E.P. | 9/1/15 |
| CHECKED | D.L. | 9/1/15 |
| APPROVED | | |
| SCALE | SCHEMATIC | |
| DRAWING NO. | F.R.L.-STOWE BRF 0235 (15) | |


(ITEM # 6)

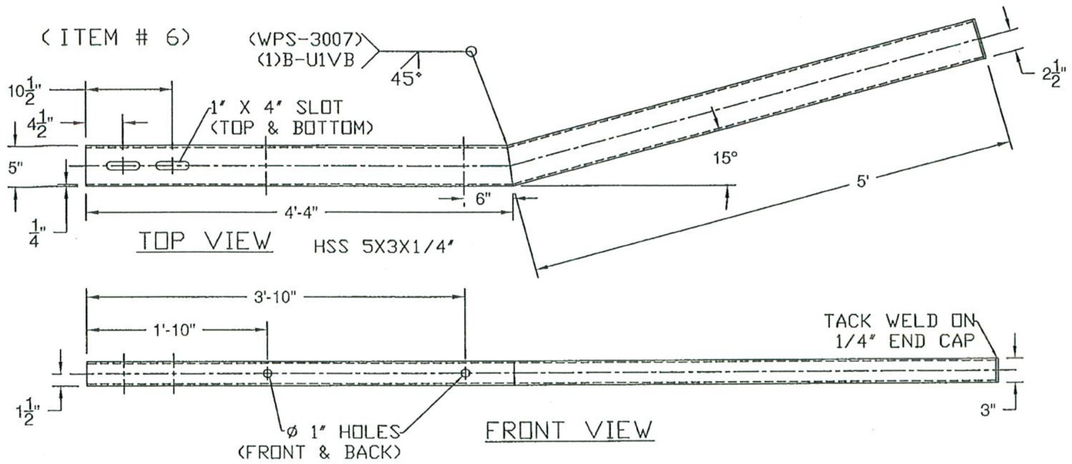

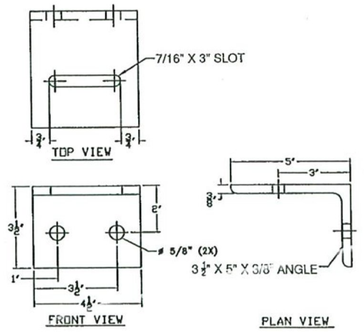
(ITEM # 10)

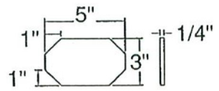




(ITEM # 12)

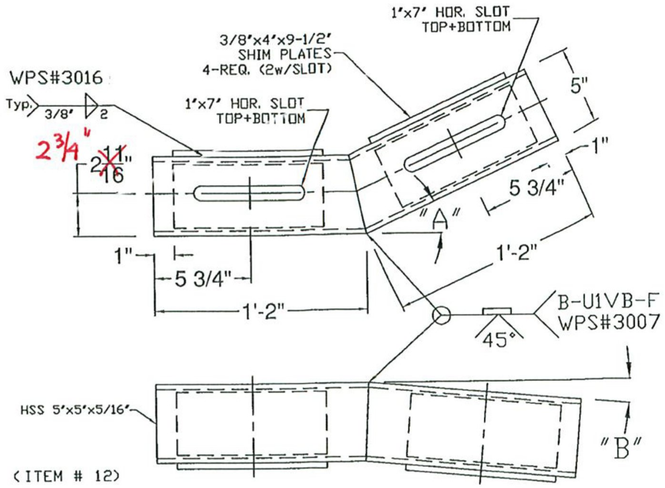"A" - 26°
"B" - TURN DOWN ANGLE SET BY THE 9" MEASURMENT AT THE END OF THE BOX BEAM.


BACK VIEW HSS 6X6X3/16"

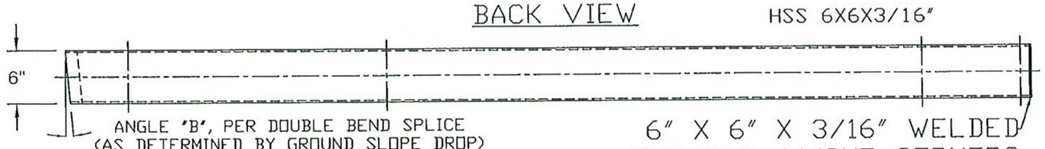



TOP VIEW

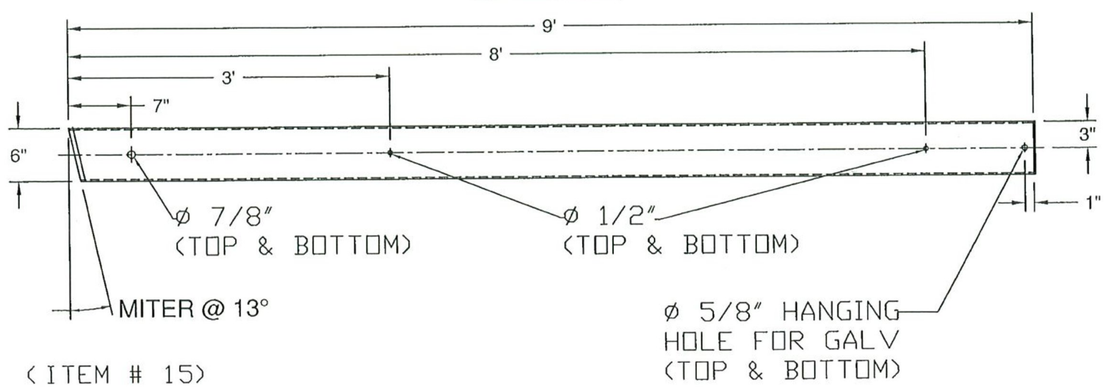



(ITEM # 15)

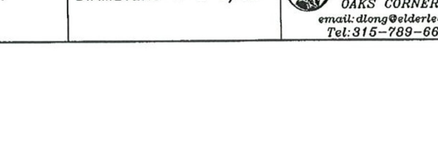


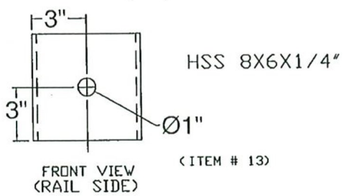

(ITEM # 13)

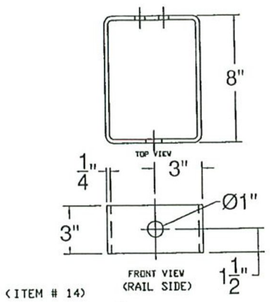


(ITEM # 14)

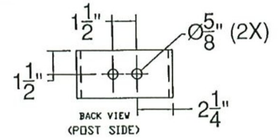


HSS 8X6X1/4"

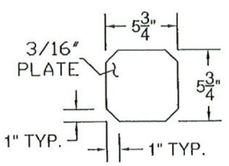


ITEM #: 621.725

STRUCTURAL STEEL TO COMPLY W/ ASTM A6

TOLERANCE UNLESS OTHERWISE NOTED:
FRACTIONS = ± 1/16"
ANGLES = ± 1/2°
DIAMETERS = ± 1/32"

SHEET 3 OF 5

# GUARD RAIL TO BRIDGE RAIL TRANSITION DETAILS SHEET

VT ROUTE 108 (MAJOR COLLECTOR), BRIDGE # 3
TOWN OF STOWE, COUNTY OF LAMOILLE, VT.

| REV | NO. | DATE | DESCRIPTION | BY |
|---|---|---|---|---|
| | | | | |


| REV | NO. | DATE | DESCRIPTION | BY |
|---|---|---|---|---|
| | | | | |



ELDERLEE, INC.
OAKS CORNERS, NEW YORK 14518
email: dlong@elderlee.com / epeek@elderlee.com
Tel: 315-789-6670 Fax: 315-789-6616


CERTIFIED FABRICATOR


ORTHOGRAPHIC PROJECTION

| | | |
|---|---|---|
| DRAWN | E.P. | 9/1/15 |
| CHECKED | D.L. | 9/1/15 |
| APPROVED | . | . |
| SCALE | SCHEMATIC | |
| DRAWING NO. | F.R.L.-STOWE BRF 0235 (15) | |

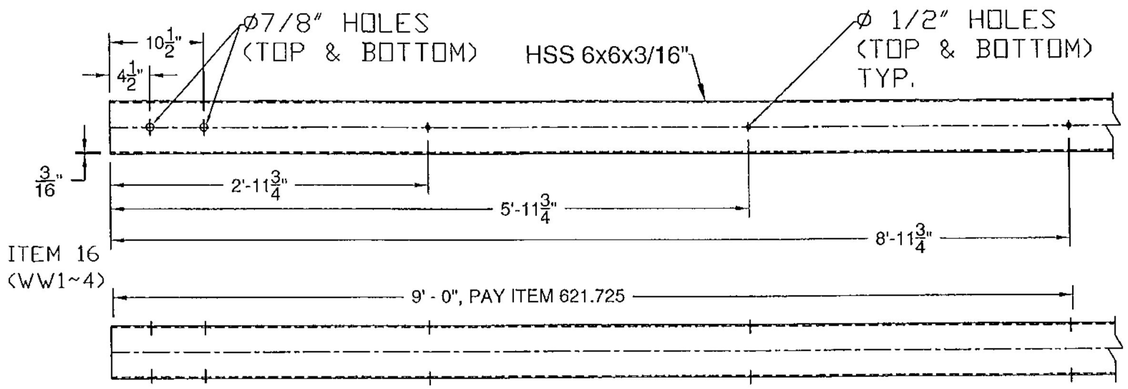

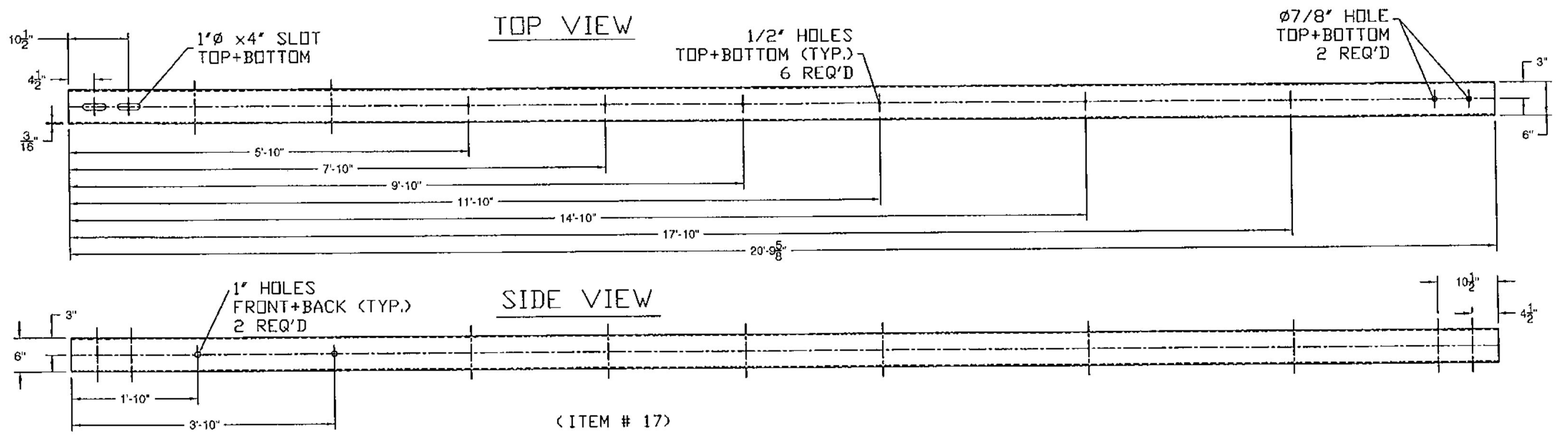
(ITEM # 17)

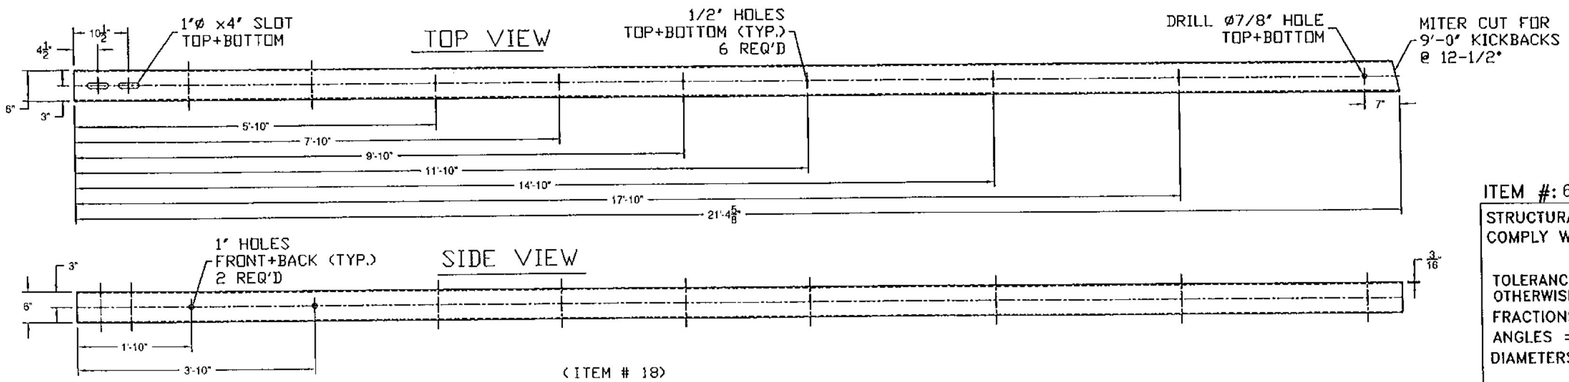


(ITEM # 18)

ITEM #: 621.725

STRUCTURAL STEEL TO COMPLY W/ ASTM A6

TOLERANCE UNLESS OTHERWISE NOTED:
FRACTIONS = ± 1/16"
ANGLES = ± 1/2°
DIAMETERS = ± 1/32"

SHEET 4 OF 5

# GUARD RAIL TO BRIDGE RAIL TRANSITION DETAILS SHEET

VT ROUTE 108 (MAJOR COLLECTOR), BRIDGE # 3
TOWN OF STOWE, COUNTY OF LAMOILLE, VT.

| REV | NO. | DATE | DESCRIPTION | BY | REV | NO. | DATE | DESCRIPTION | BY |
|---|---|---|---|---|---|---|---|---|---|
| | | | | | | | | | |

ELDERLEE, INC.
OAKS CORNERS, NEW YORK 14518
email: dlong@elderlee.com / epeck@elderlee.com
Tel: 315-789-6670 Fax: 315-789-6615


AISC CERTIFIED FABRICATOR

ORTHOGRAPHIC PROJECTION


| | | |
|---|---|---|
| DRAWN | E.P. | 9/1/15 |
| CHECKED | D.L. | 9/1/15 |
| APPROVED | . | . |
| SCALE | SCHEMATIC | |


DRAWING NO. F.R.L.-STOWE BRF 0235 (15)

## SPLICE BAR - EXPANSION

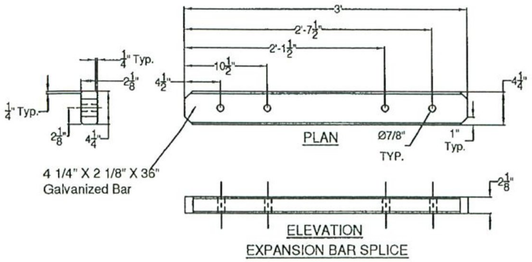



(ITEM # 9)

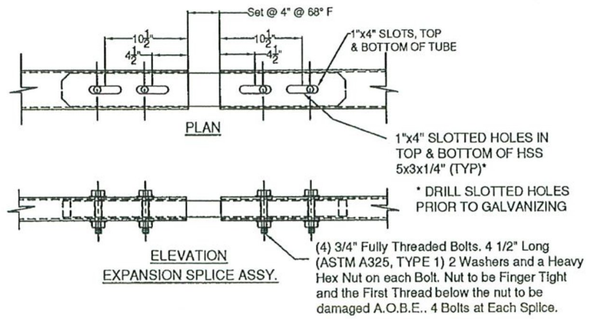


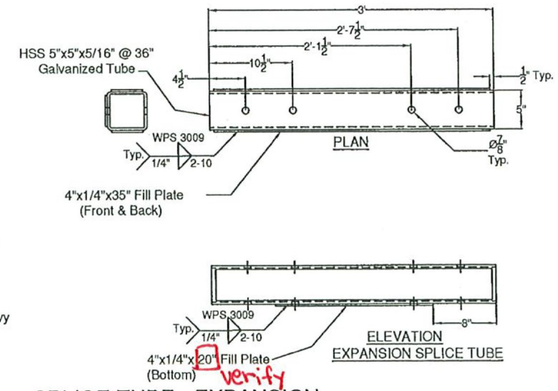


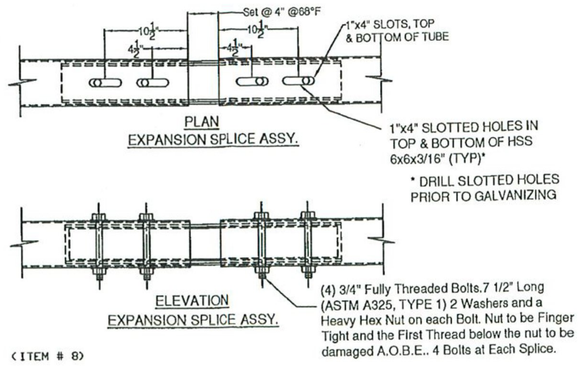

## SPLICE TUBE - EXPANSION

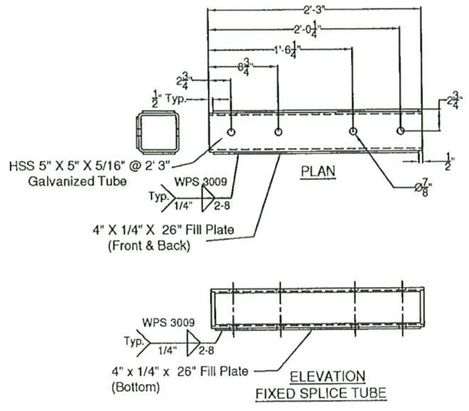


(ITEM # 8)

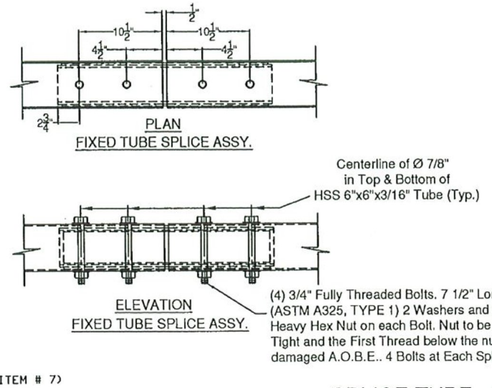


(ITEM # 7)

## SPLICE TUBE - FIXED

ITEM #: 621.725

STRUCTURAL STEEL TO COMPLY W/ ASTM A6

TOLERANCE UNLESS OTHERWISE NOTED:
FRACTIONS = ± 1/16"
ANGLES = ± 1/2°
DIAMETERS = ± 1/32"

SHEET 5 OF 5

# GUARD RAIL TO BRIDGE RAIL TRANSITION DETAILS SHEET

VT ROUTE 108 (MAJOR COLLECTOR), BRIDGE # 3
TOWN OF STOWE, COUNTY OF LAMOILLE, VT.

| R E V | NO. | DATE | DESCRIPTION | BY | R E V | NO. | DATE | DESCRIPTION | BY |
|---|---|---|---|---|---|---|---|---|---|
| | | | | | | | | | |


ELDERLEE, INC.
OAKS CORNERS, NEW YORK 14518
email: dlong@elderlee.com / speek@elderlee.com
Tel: 315-789-6670 Fax: 315-789-6616


AISC CERTIFIED FABRICATOR

ORTHOGRAPHIC PROJECTION

| | | |
|---|---|---|
| DRAWN | E.P. | 9/1/15 |
| CHECKED | D.L. | 9/1/15 |
| APPROVED | . | . |
| SCALE | SCHEMATIC | |
| DRAWING NO. | F.R.L.-STOWE BRF 0235 (15) | |


## WELDING PROCEDURE SPECIFICATION

PQR ELDERLEE#3

| | |
|---|---|
| Material Specification | A500 GR B to A572 GR 50 |
| Welding Process | FCAW-G |
| Manual or Machine | SEMAUTOMATIC |
| Position of Welding | FLAT/HORIZONTAL |
| Filler Metal Specification | A5.29 |
| Filler Metal Classification | E81T1-Ni1C-JH4 |
| Flux | N/A |
| Shielding Gas | CO 2 Dew Point -40DEG F Flow Rate 50CFH |
| Single or Multiple Pass | SINGLE |
| Single or Multiple Arc | SINGLE |
| Welding Current | DC |
| Polarity | REVERSE ELECTRODE POSITIVE |
| Welding Progression | STRINGER |
| Root Treatment | PER D1.5 |
| Preheat and Interpass Temperature | PER D1.5 |
| Postheat Temperature | NONE |
| Heat Input | Min _____ Max _____ |

### WELDING PROCEDURE

| Pass no. | Electrode size | Welding Current | | Travel speed | Joint detail |
|---|---|---|---|---|---|
| | | Amperes | Volts | | |
| 1 | 1/16 | 310 | 25 | 11 | |
| Variable | LIMITS | 341 TO 269 | 27 TO 23 | 12 TO 10 | |

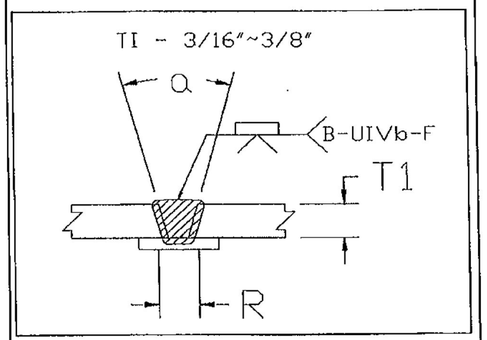


This procedure may vary due to fabrication sequence, fit-up, pass size, etc., within the limitation of variables given in Section 5.

Procedure No. 3007
Revision No. _____


Contractor Elderlee, Inc.
Authorized By RANDY SCOTT
Date 7/28/2014

## WELDING PROCEDURE SPECIFICATION

PQR ELDERLEE #3

| | |
|---|---|
| Material Specification | A709 TO A500 GR B |
| Welding Process | FCAW-G |
| Manual or Machine | SEMAUTOMATIC |
| Position of Welding | FLAT/HORIZONTAL |
| Filler Metal Specification | A5.29 |
| Filler Metal Classification | E81T1-Ni1C-JH4 |
| Flux | N/A |
| Shielding Gas | CO 2 Dew Point -40DEG F Flow Rate 50CFH |
| Single or Multiple Pass | SINGLE |
| Single or Multiple Arc | SINGLE |
| Welding Current | DC |
| Polarity | REVERSE ELECTRODE POSITIVE |
| Welding Progression | STRINGER |
| Root Treatment | D1.5 |
| Preheat and Interpass Temperature | D1.5 |
| Postheat Temperature | NONE |
| Heat Input | Min _____ Max _____ |

### WELDING PROCEDURE
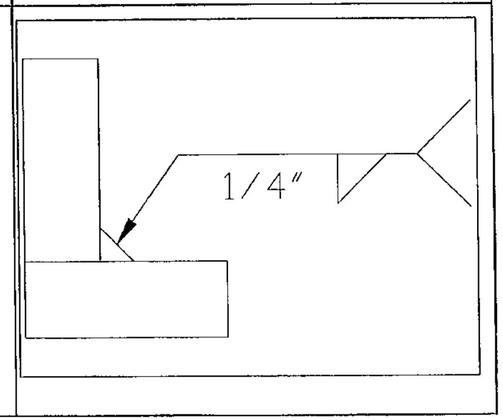
| Pass no. | Electrode size | Welding Current Amperes | Welding Current Volts | Travel speed | Joint detail |
|---|---|---|---|---|---|
| 1 | 1/16 | 310 | 25 | 11 |  |
| Variable | LIMITS | 341 TO 269 | 27 TO 23 | 12 TO 10 | |



This procedure may vary due to fabrication sequence, fit-up, pass size, etc., within the limitation of variables given in Section 5.

Procedure No. 3009

Revision No. _____

Contractor Elderlee, Inc.

Authorized By RANDY SCOTT

Date 3/20/2014


## WELDING PROCEDURE SPECIFICATION

PQR ELDERLEE #3

| | | | |
|---|---|---|---|
| Material Specification | A500 TO A572 GR 50 | | |
| Welding Process | FCAW-G | | |
| Manual or Machine | SEMAUTOMATIC | | |
| Position of Welding | FLAT/HORIZONTAL | | |
| Filler Metal Specification | A5.29 | | |
| Filler Metal Classification | E81T1-Ni1C-JH4 | | |
| Flux | N/A | | |
| Shielding Gas | CO 2 | Dew Point -40DEG F Flow Rate | 50CFH |
| Single or Multiple Pass | SINGLE | | |
| Single or Multiple Arc | SINGLE | | |
| Welding Current | DC | | |
| Polarity | REVERSE | | |
| Welding Progression | STRINGER | | |
| Root Treatment | PER D1.5 | | |
| Preheat and Interpass Temperature | PER D1.5 | | |
| Postheat Temperature | NONE | | |
| Heat Input | Min | Max | |

### WELDING PROCEDURE

| Pass no. | Electrode size | Welding Current Amperes | Welding Current Volts | Travel speed | Joint detail |
|---|---|---|---|---|---|
| 1 | 1/16 | 310 | 25 | 11 | |
| Variable | LIMITS | 341 TO 269 | 27 TO 23 | 12 TO 10 | |

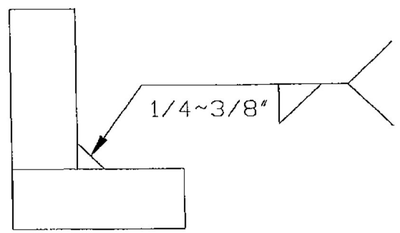


This procedure may vary due to fabrication sequence, fit-up, pass size, etc., within the limitation of variables given in Section 5.

Procedure No. 3016

Revision No.

Contractor Elderlee, Inc.

Authorized By RANDY SCOTT


Date 8/4/2014

## WELDING PROCEDURE SPECIFICATION

| | |
|---|---|
| Material Specification | A572 GR 50 |
| Welding Process | GMAW |
| Manual or Machine | SEMIAUTOMATIC/ROBOTIC |
| Position of Welding | FLAT/HORIZONTAL |
| Filler Metal Specification | A5.18 |
| Filler Metal Classification | L-56 LINCOLN |
| Flux | N/A |
| Shielding Gas | 90% ARGON /10% CO2 Dew Point -40DEG F Flow Rate 45CFH |
| Single or Multiple Pass | SINGLE |
| Single or Multiple Arc | SINGLE |
| Welding Current | DC |
| Polarity | REVERSE |
| Welding Progression | STRINGER |
| Root Treatment | PER D1.5 |
| Preheat and Interpass Temperature | PER D1.5 |
| Postheat Temperature | NONE |
| Heat Input | Min _____ Max _____ |

### WELDING PROCEDURE

| Pass no. | Electrode size | Welding Current Amperes | Welding Current Volts | Travel speed | Joint detail |
|---|---|---|---|---|---|
| | .045 | 190 | 22 | 19 | |
| Variable | LIMITS | 171 TO 209 | 20 TO 24 | 17 TO 21 | |

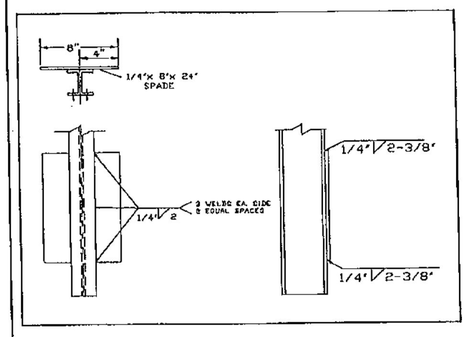


This procedure may vary due to fabrication sequence, fit-up, pass size, etc., within the limitation of variables given in Section 5.

Procedure No. 3022
Revision No. _____

Contractor Elderlee, Inc.
Authorized By RANDY SCOTT
Date 3/20/2014