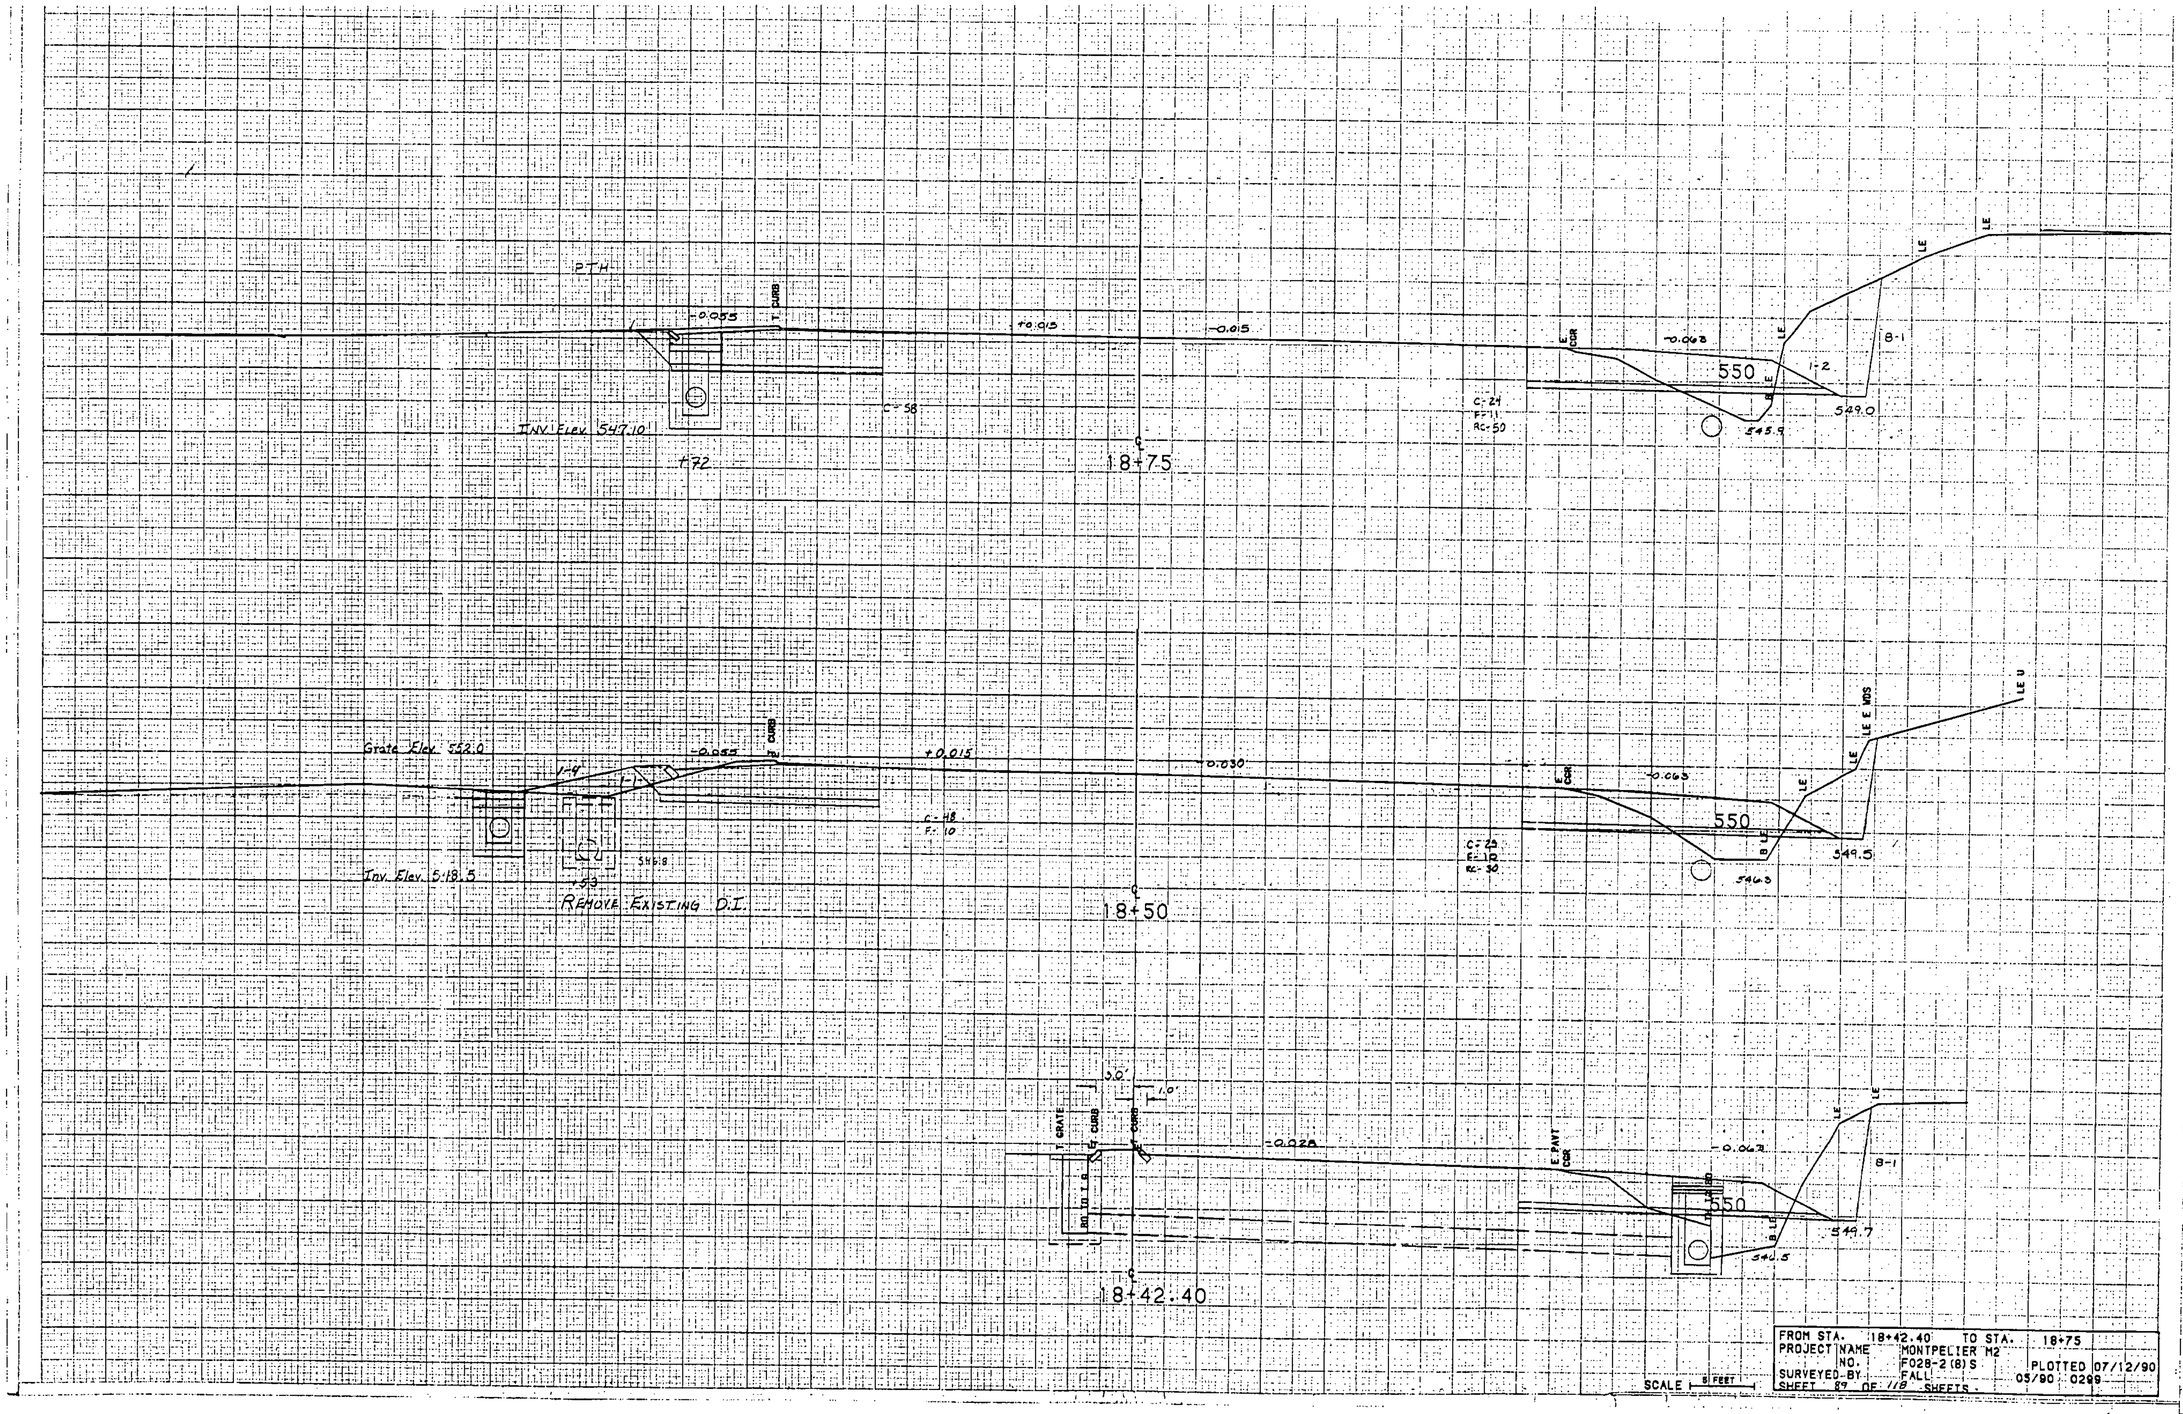

FROM STA. 18+42.40	TO STA. 18+75		
PROJECT NAME	MONTPELIER M2		
NO.	F028-2 (8) S		PLOTTED 07/12/90
SURVEYED-BY	FALL		05/90 0299
SHEET 89 OF 118 SHEETS			