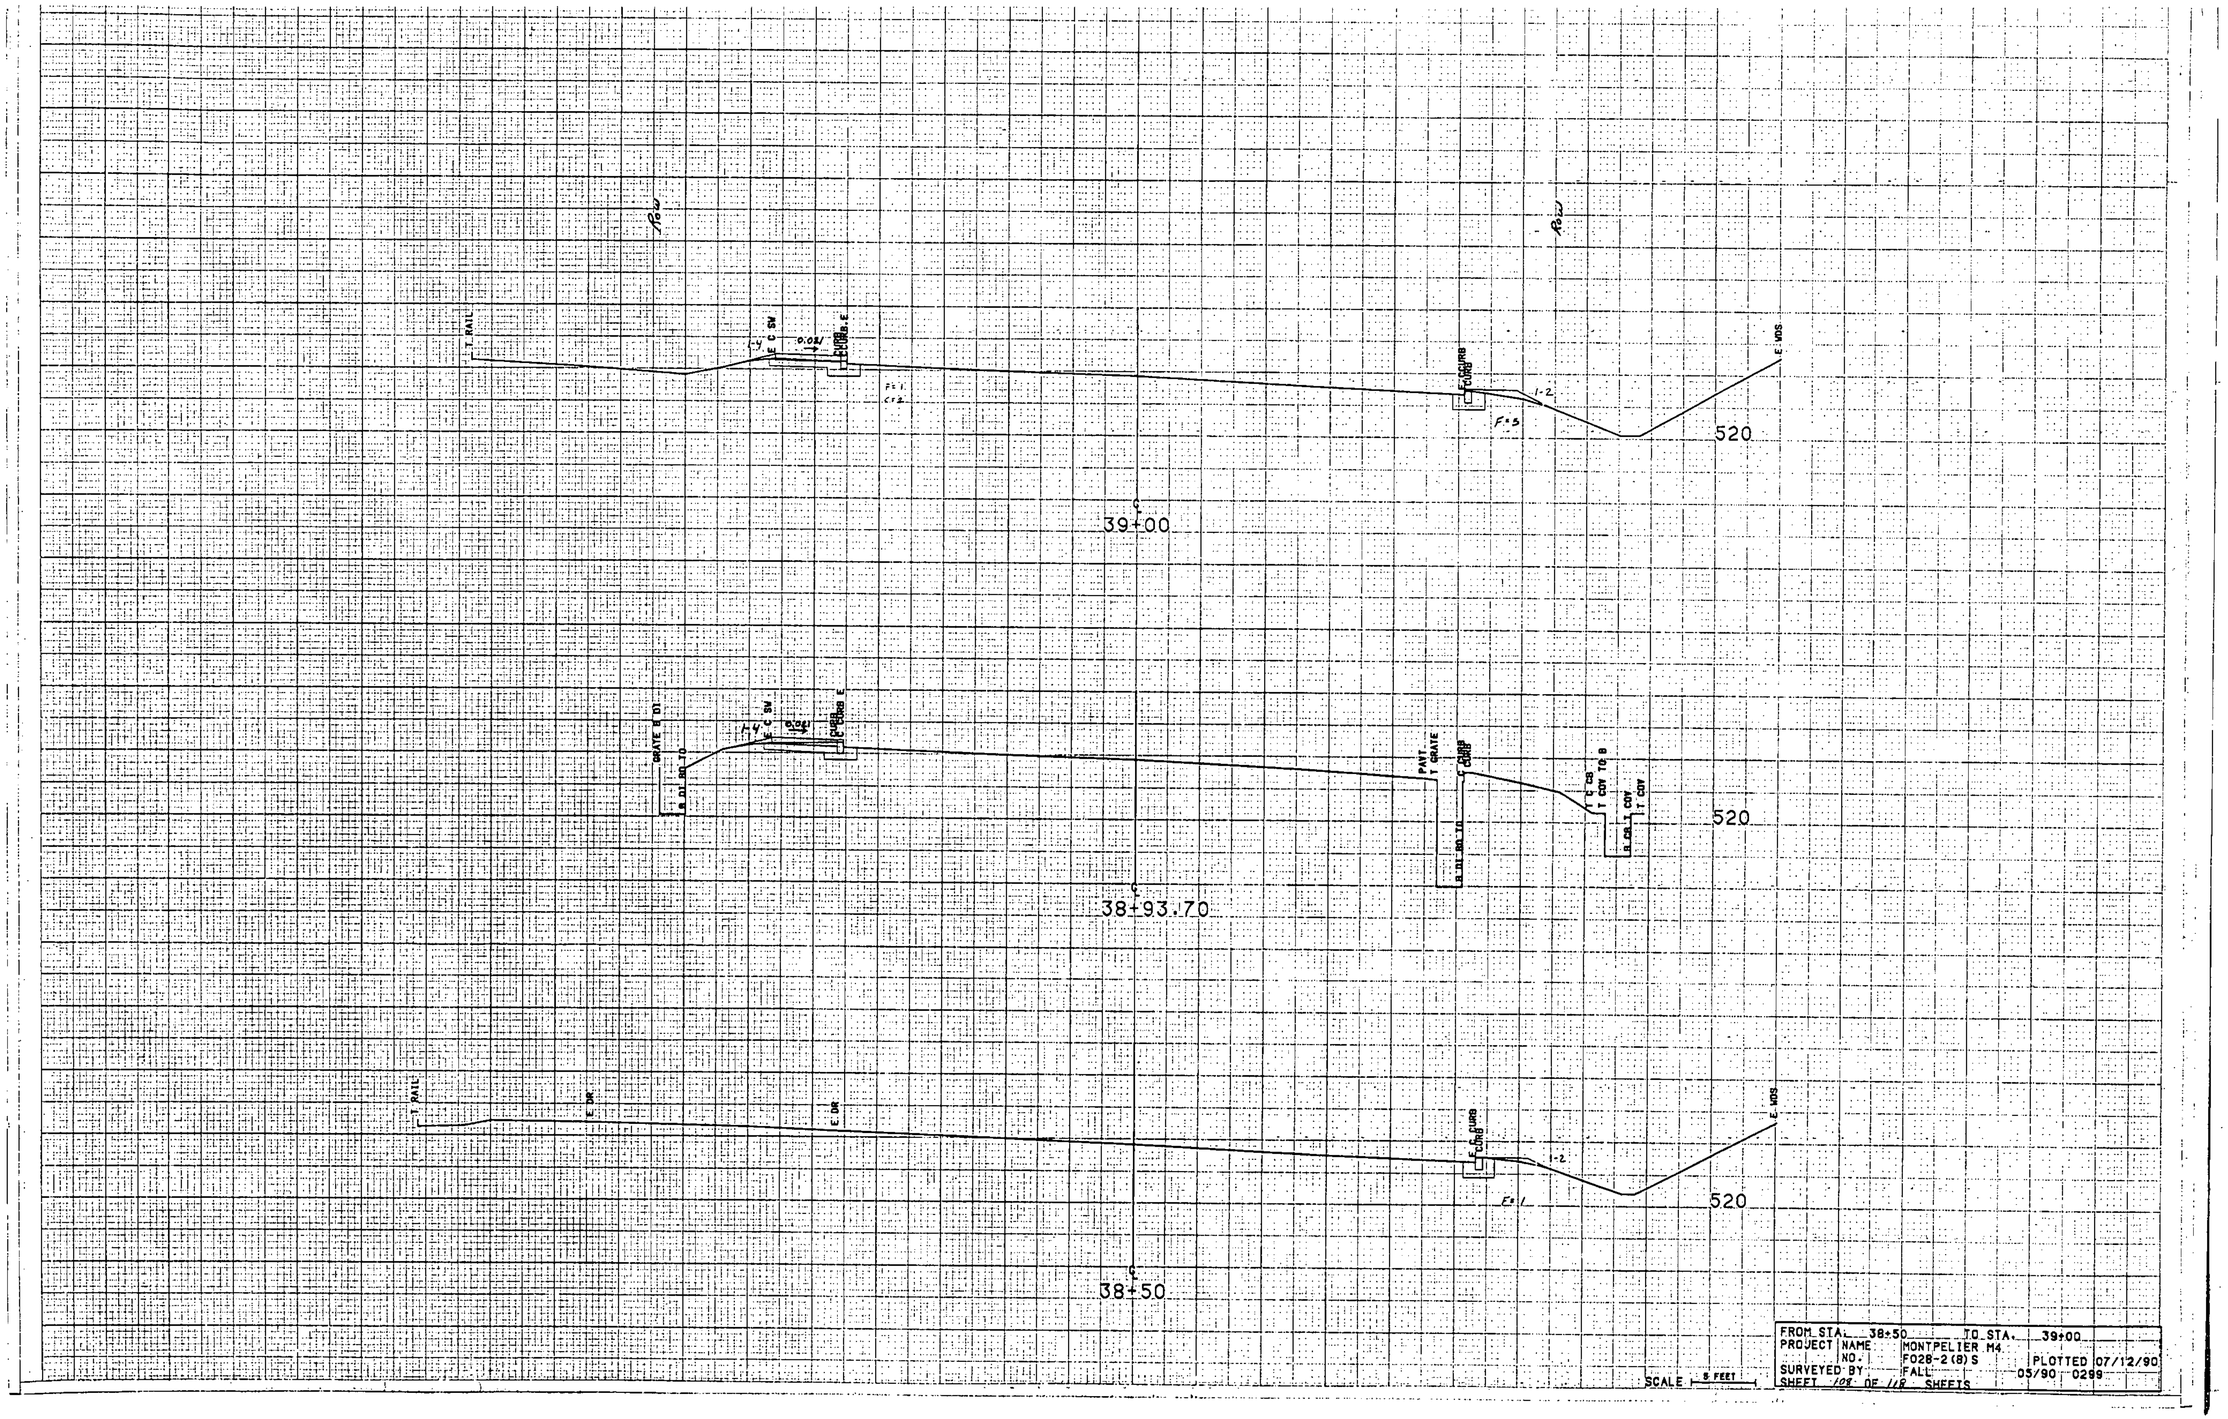

FROM STA. 38+50		TO STA. 39+00	
PROJECT	NAME	MONTPELIER M4	
	NO.	F028-2(8)S	PLOTTED 07/12/90
SURVEYED BY		FALL	05/90 0299
SHEET 108 OF 118 SHEETS			

SCALE 5 FEET