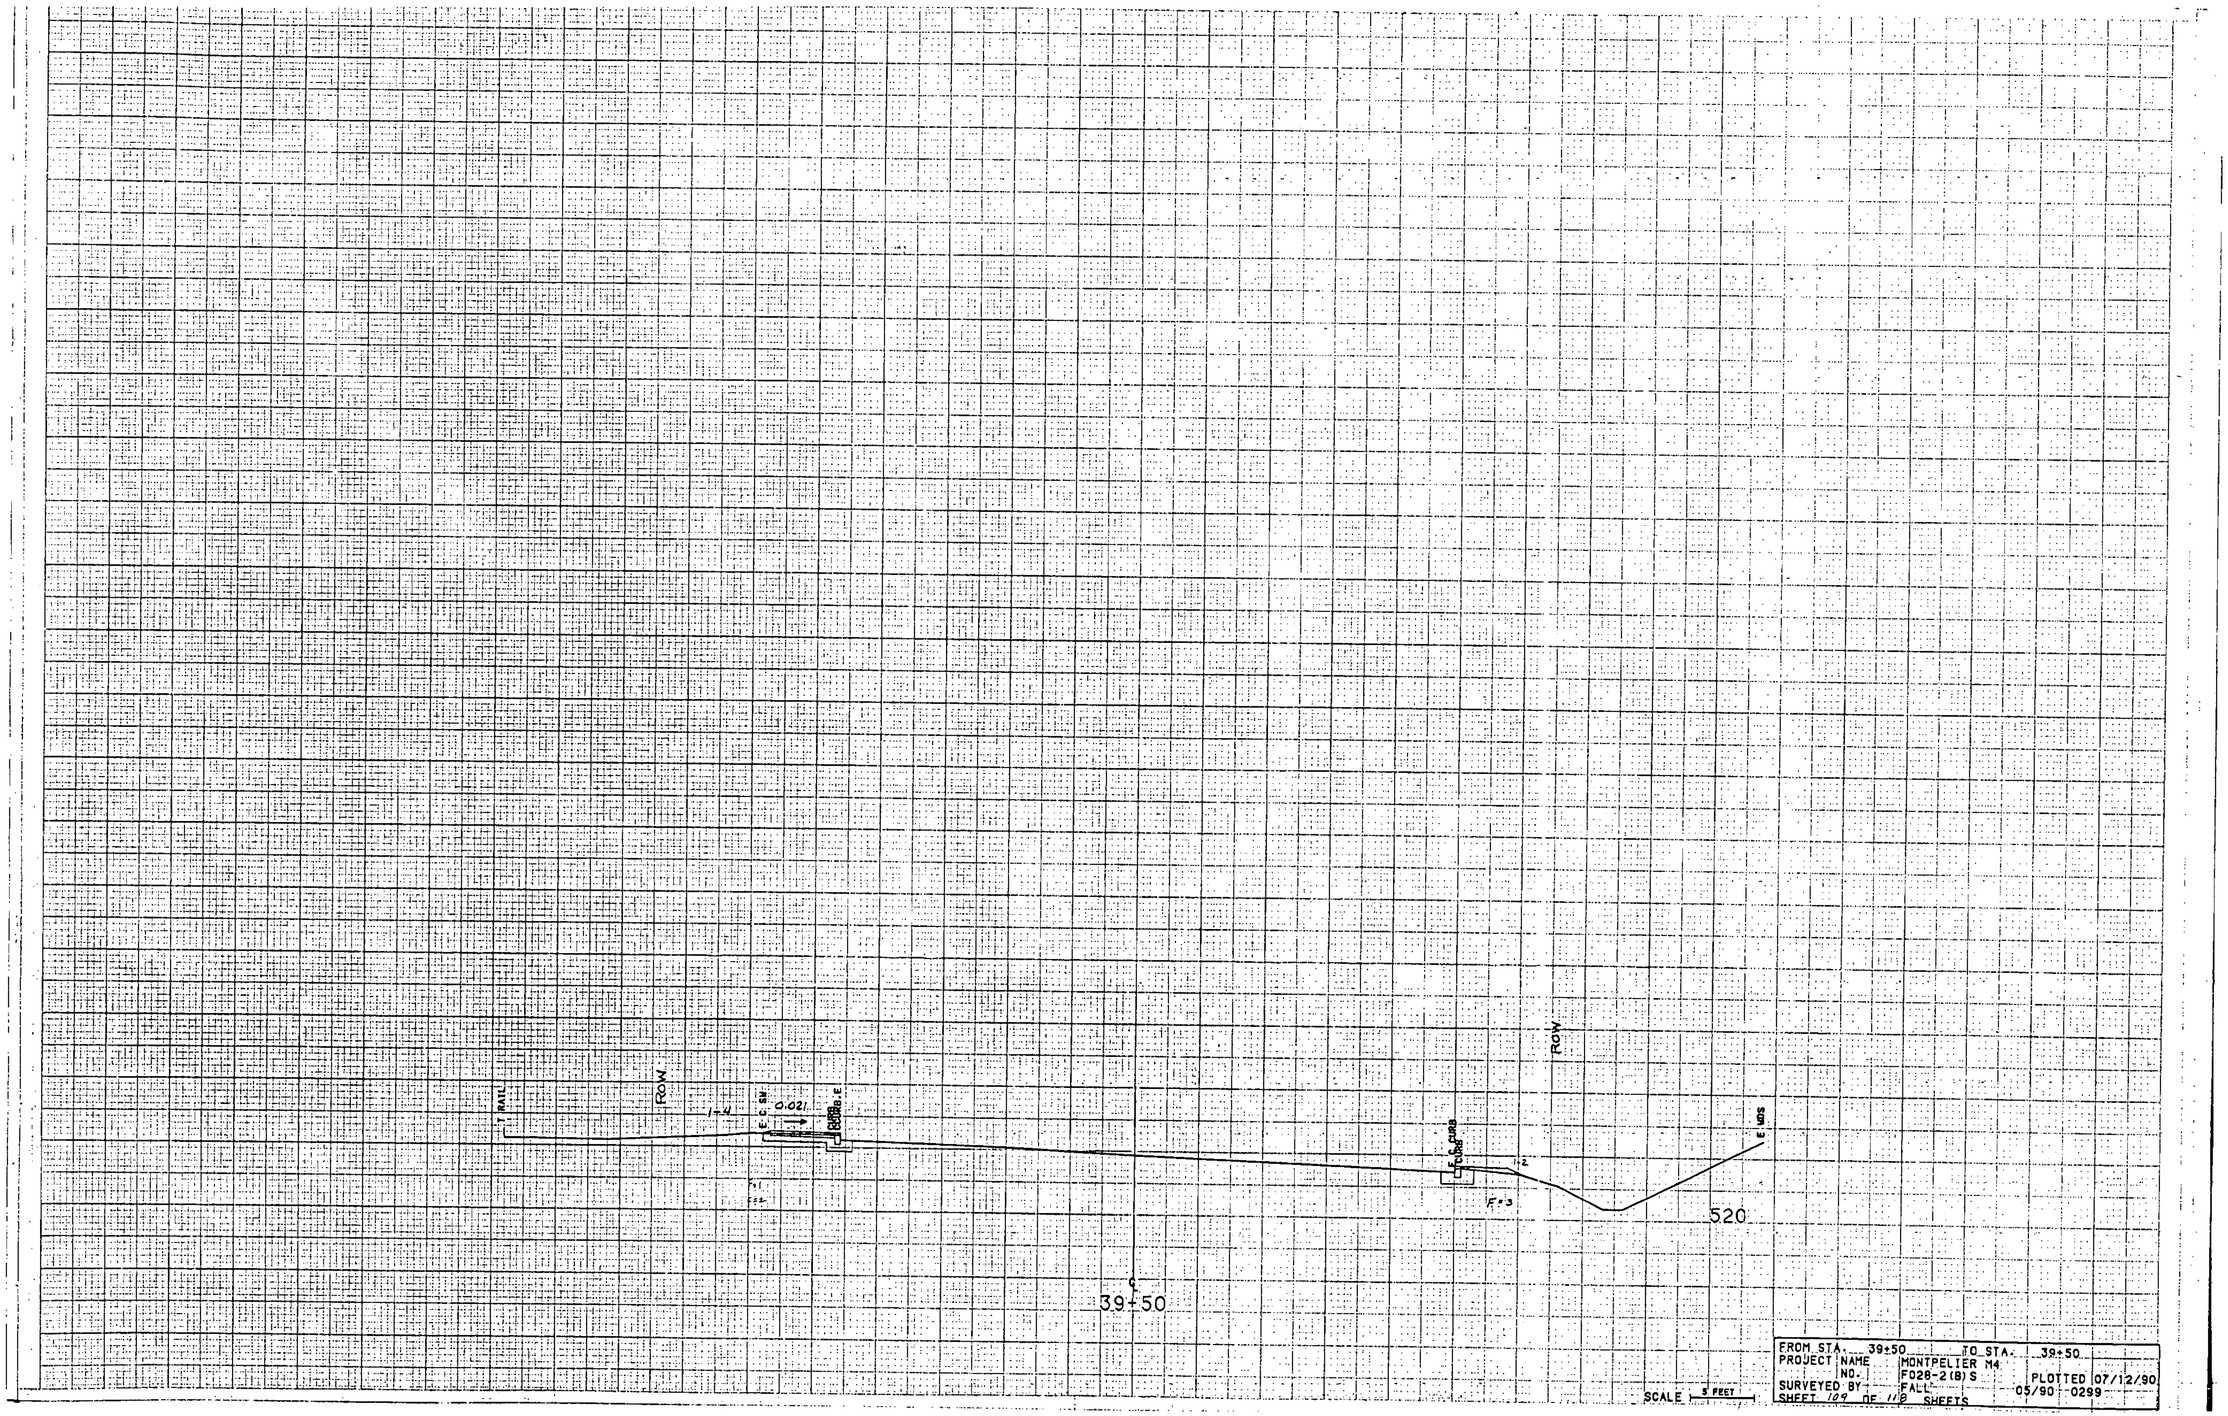
T RAIL
ROW
1+4
E.C. BK.
0.021
BCORB.E
1:1
1:4
39+50
E.C.CURB
1:2
1+3
ROW
520
E. WDS
SCALE 5 FEET
FROM STA. 39+50 TO STA. 39+50
PROJECT NAME MONTPELIER M4
NO. F028-2(8)S
SURVEYED BY FALL PLOTTED 07/12/90
05/90 0299
SHEET 109 OF 118 SHEETS