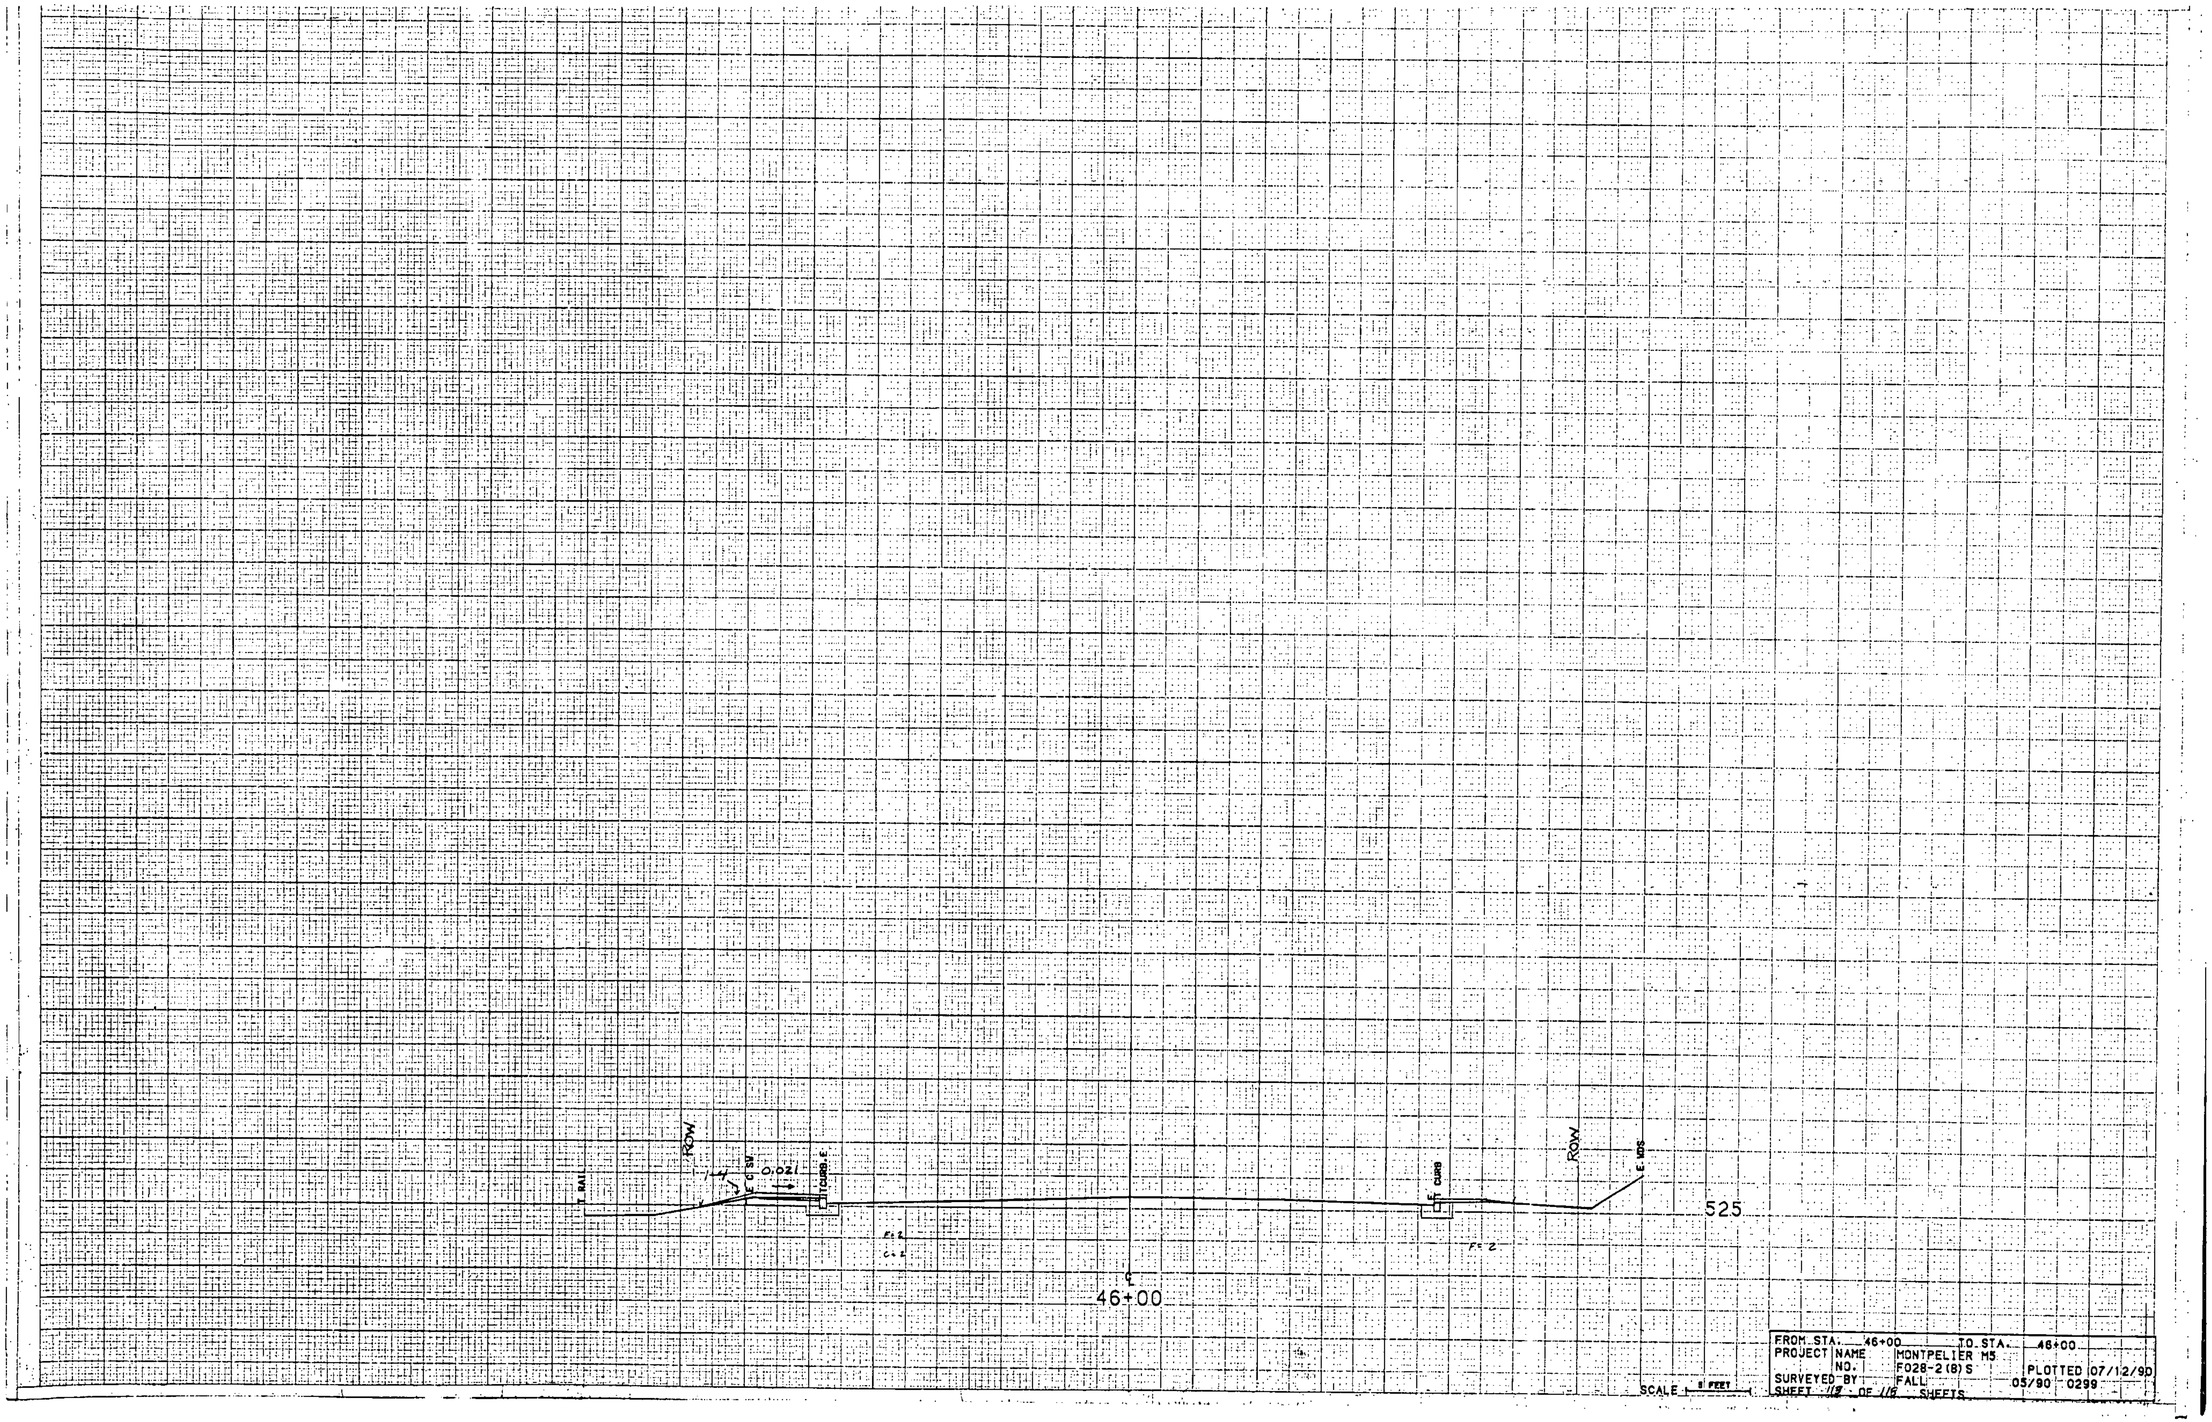

FROM STA. 46+00		TO STA. 46+00	
PROJECT NAME	MONTPELIER M5		
NO.	F028-2(8)S		PLOTTED 07/12/90
SURVEYED BY	FALL		05/90 0299
SHEET 118 OF 116 SHEETS			

SCALE 1" = 5 FEET