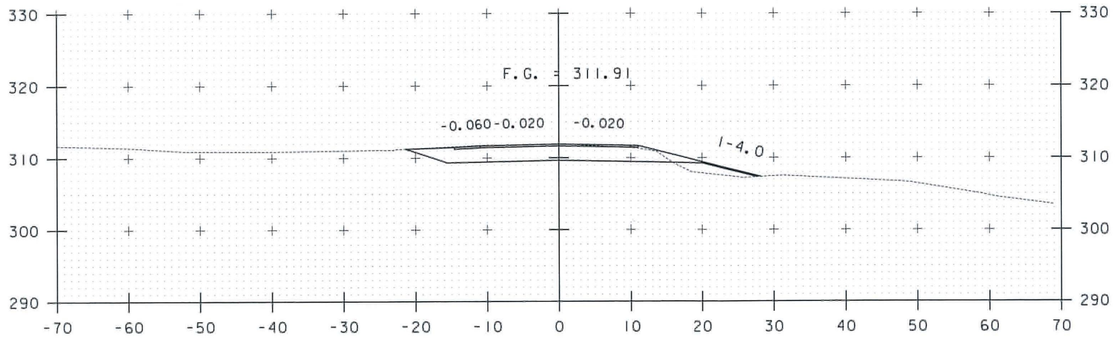

JB 126+50

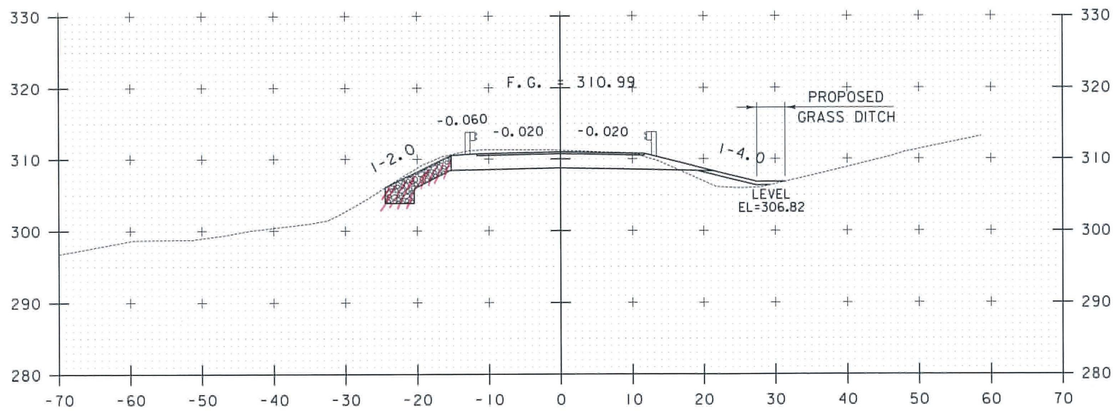

JB 126+00

X Reviewed
Rejected
Furnish As Corrected
Revise and Resubmit

This review is only for general conformance with the design concept and the information given in the Construction Documents. Corrections or comments made on the shop drawings during the review do not relieve the Contractor from compliance with the requirements of the Plans and Specifications. Review of a specific item shall not exclude review of an assembly of which an item is a component. The Contractor is responsible for dimensions to be confirmed and corrected at the job site, information that pertains solely to the fabrication process or to the means, methods, techniques, sequences and procedures of construction, coordination of the Work with that of other trades and performing all Work in a safe and satisfactory manner.

McFarland Johnson

Date: August 31, 2011

By: J. Santacruce

0 10 20

SCALE IN FEET

CROSS SECTIONS SHEET #23

PROJECT NAME: RICHMOND

PROJECT NUMBER: STP-RS 0284(11)

FILE NAME: z90c092_XSI_14.dgn
PROJECT LEADER: D.E.G.
DESIGNED BY: B.T.H.
DWG. NO.: XS-23

PLOT DATE: 8/25/2011
DRAWN BY: C.A.K.
CHECKED BY: D.E.G.
SHEET 45 OF 46

FILE NAME = u:\projects\eng\k2\22076\ceadd_mstn\mbs (1-14) roadway design\z90c092_xsections_johnnybrook_14.dgn
DATE/TIME = 8/25/2011
USER = 3006