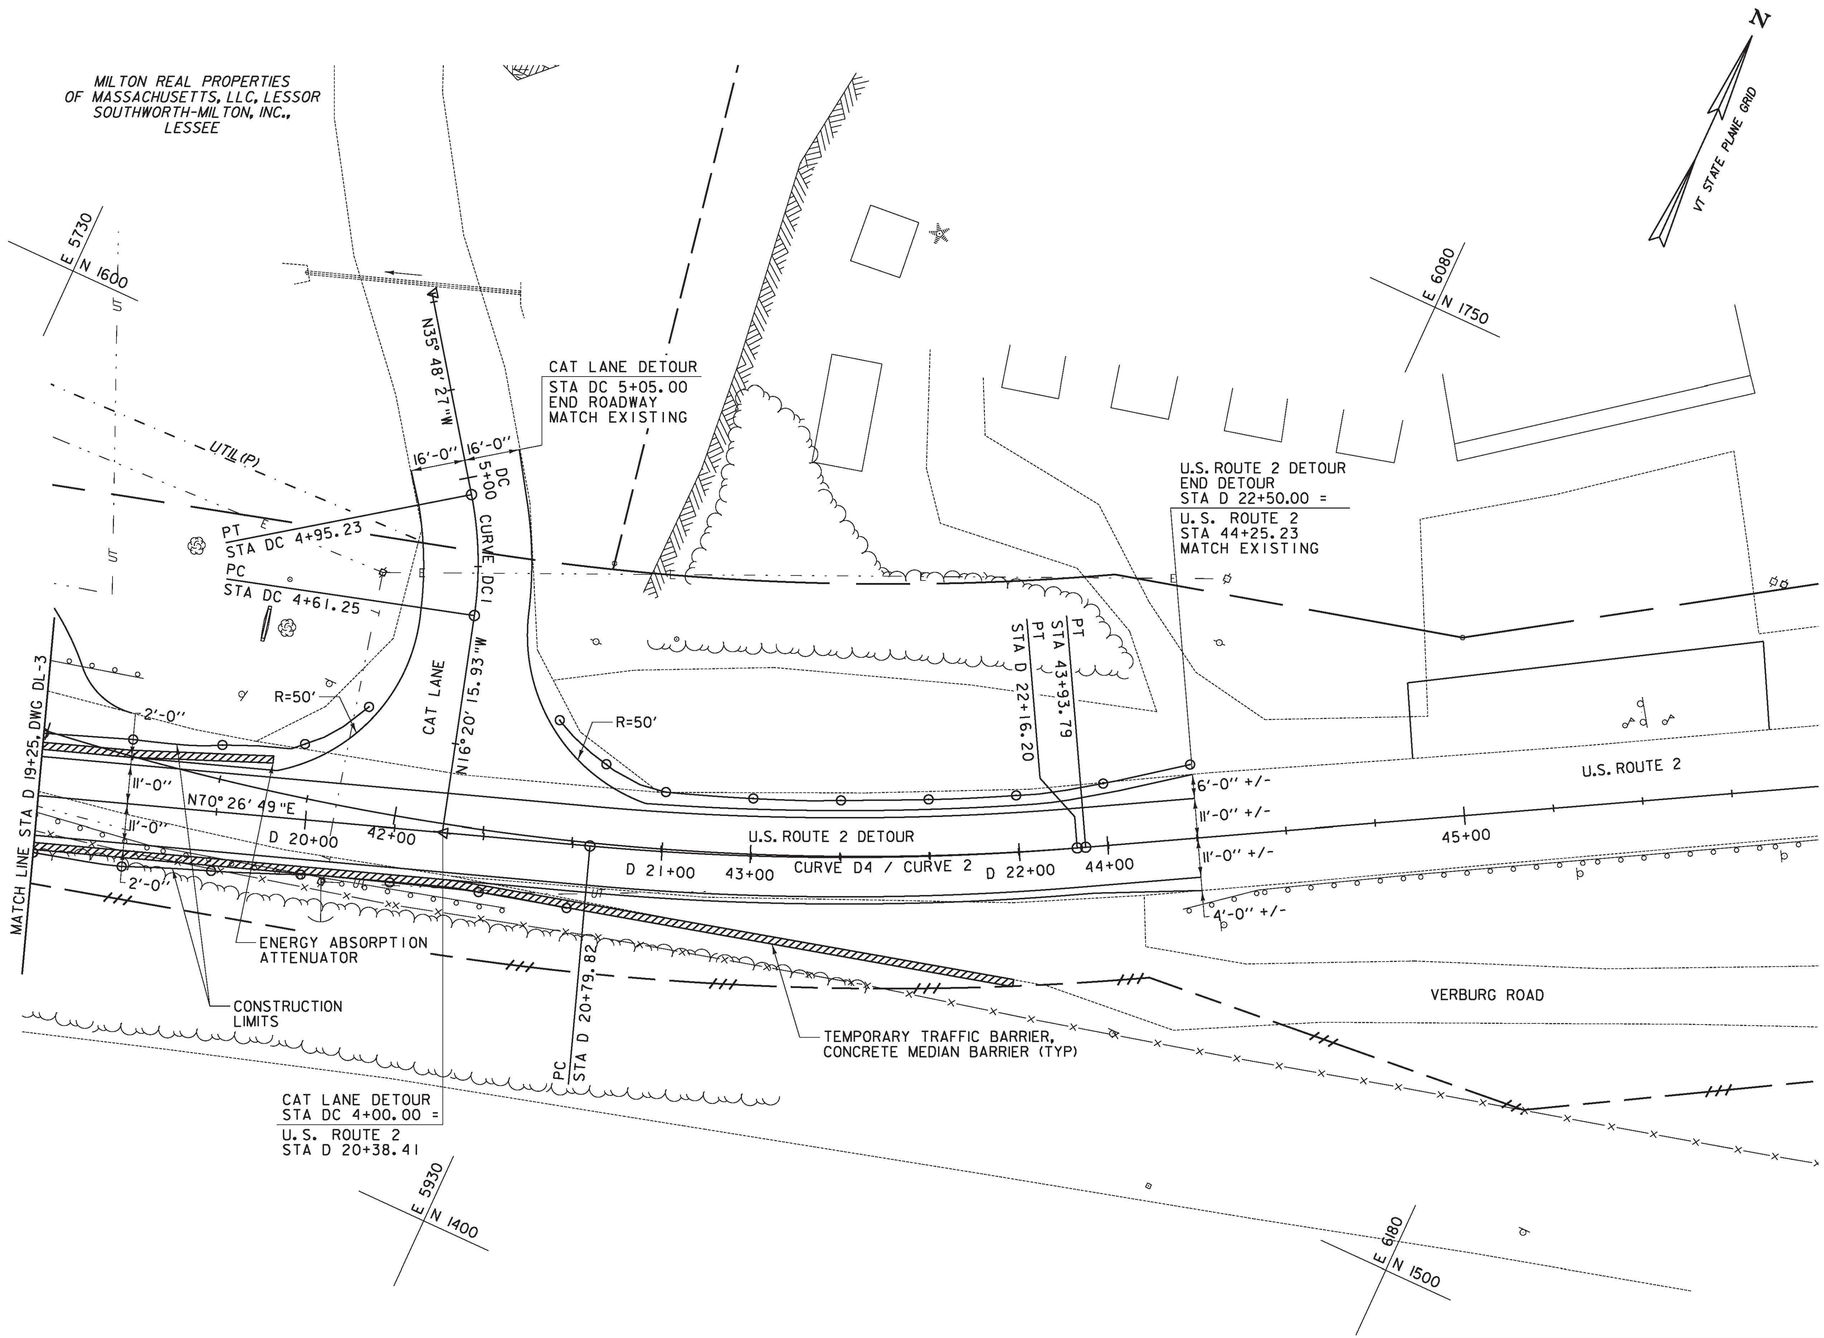

CURVE 2	CURVE DC1	CURVE D4
DELTA = 33°30' 38"	DELTA = 19°28' 11"	DELTA = 9°53' 26"
D = 7°32' 20"	D = 57°17' 45"	D = 7°15' 09"
R = 760.00'	R = 100.00'	R = 790.00'
T = 228.81'	T = 17.16'	T = 68.36'
L = 444.50'	L = 33.98'	L = 136.38'
E = 32.70'	E = 1.46'	E = 2.95'

621.80 REMOVAL AND DISPOSAL OF GUARDRAIL
RICHMOND:
STA 41+00.0 - STA 41+21.8 LT (21.8 LF)
STA 41+00.0 - STA 42+33.8 RT (133.8 LF)

0 20 40
SCALE IN FEET

DETOUR LAYOUT SHEET #4

PROJECT NAME: RICHMOND
PROJECT NUMBER: STP-RS 0284(11)

FILE NAME: z90c092_L04_13.dgn
PROJECT LEADER: D.E.G.
DESIGNED BY: B.T.H.
DWG. NO.: DL-4

PLOT DATE: 6/20/2011
DRAWN BY: C.A.K.
CHECKED BY: D.E.G.
SHEET 7 OF 29

FILE NAME = V:\Projects\ANY\X2\22076\CADD_MSTN\WBS (1-13) DETOUR\z90c092_L04_13.dgn
DATE/TIME = 6/20/2011
USER = 3086