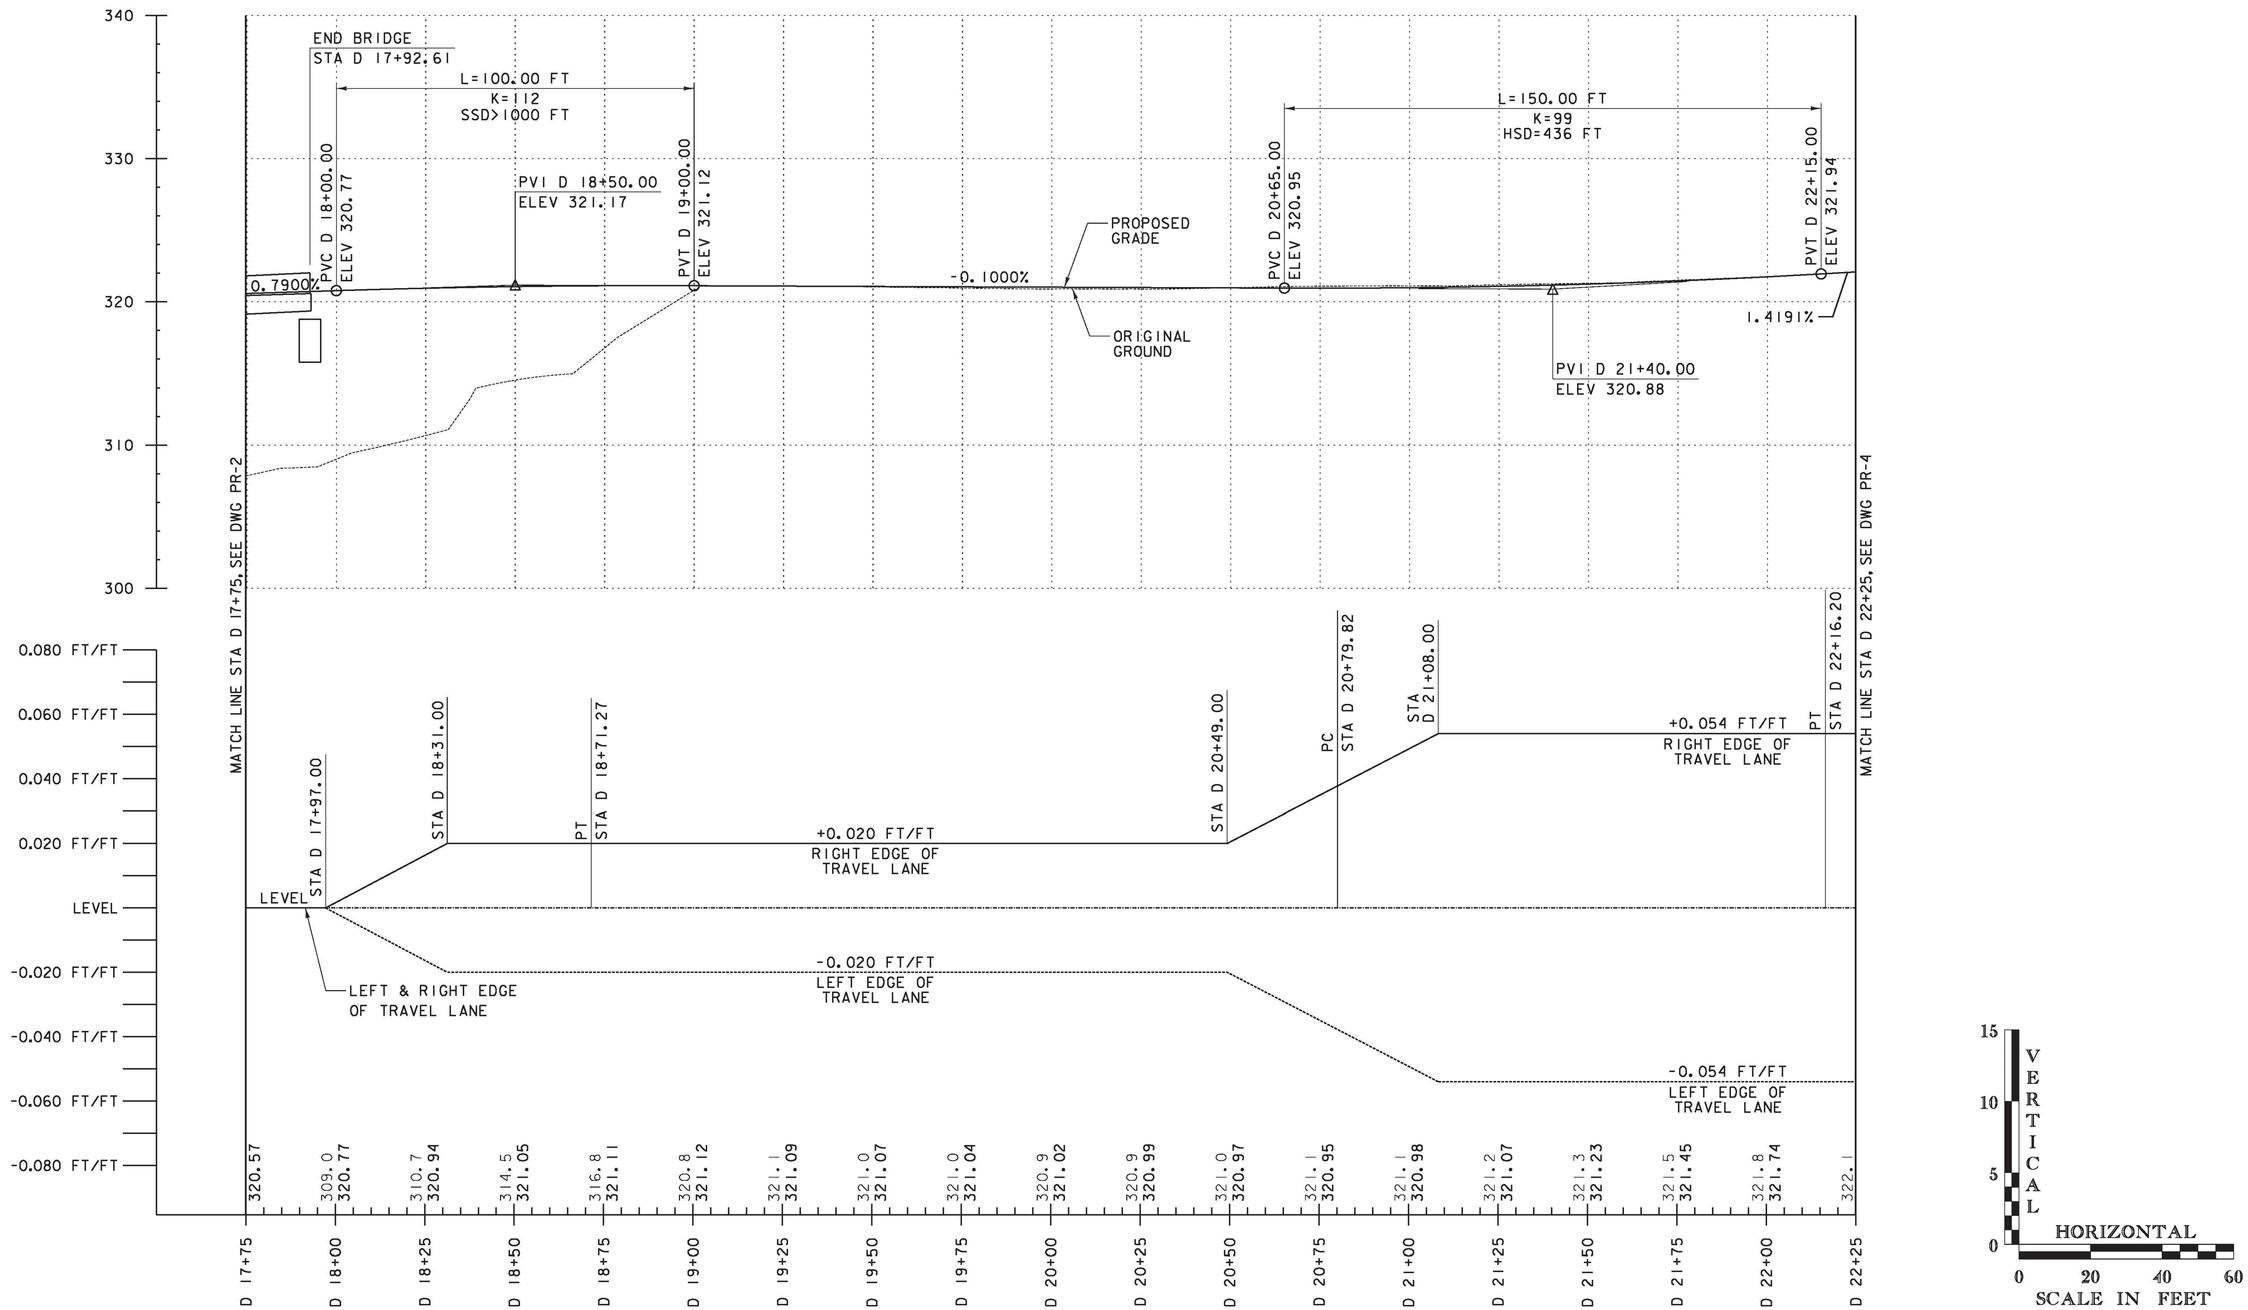

U.S. ROUTE 2 DETOUR

PROFILE SHEET #3

PROJECT NAME: RICHMOND

PROJECT NUMBER: STP-RS 0284(11)

FILE NAME: z90c092_pro_03_13.dgn
PROJECT LEADER: D.E.G.
DESIGNED BY: B.T.H.
DWG. NO.: PR-3

PLOT DATE: 6/17/2011
DRAWN BY: C.A.K.
CHECKED BY: D.E.G.
SHEET 11 OF 29

FILE NAME = V:\Projects\ANY\K22076\CADD_MSTN\WBS (1-13) DETOUR\z90c092_pro_03_13.dgn
DATE/TIME = 6/17/2011
USER = 3806