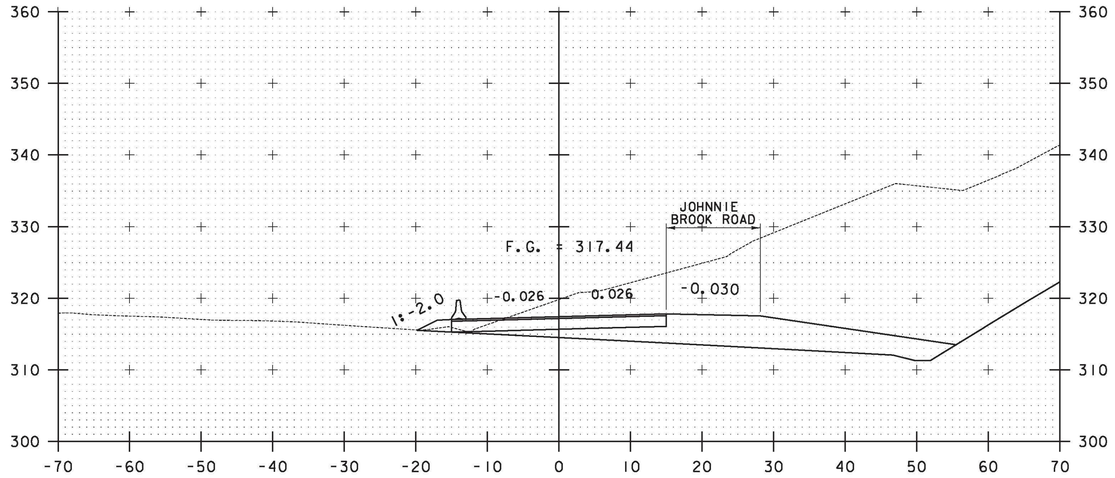

D 13+50

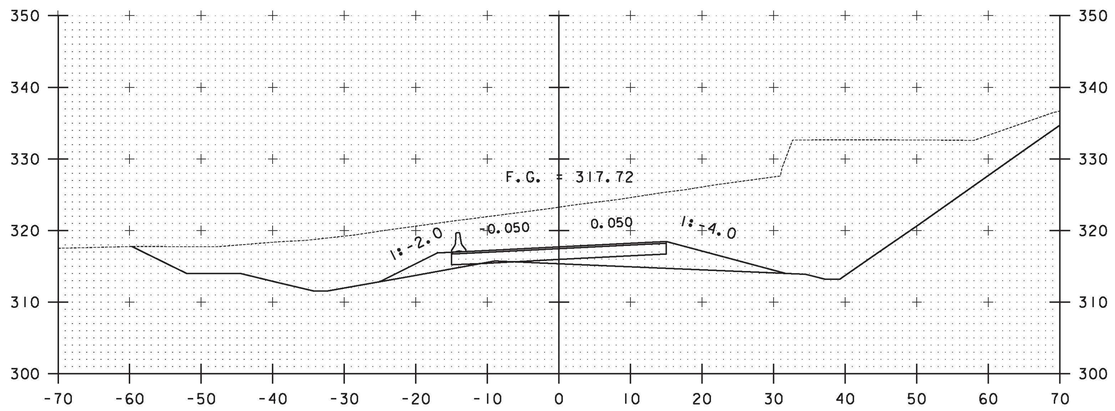

D 13+00

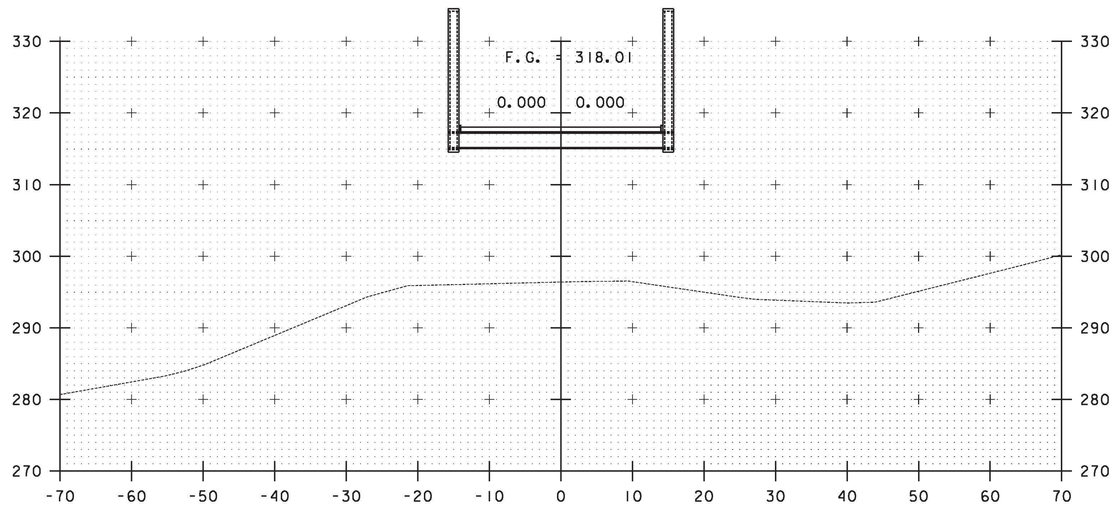

D 14+50

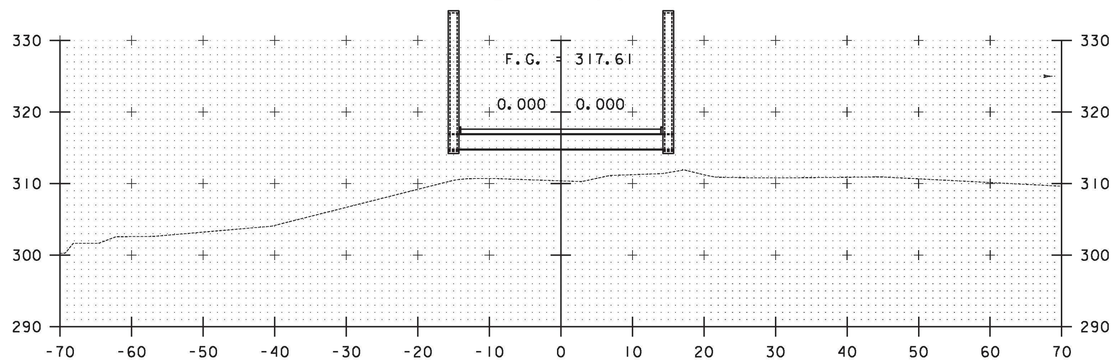

D 14+00

0 10 20
SCALE IN FEET

CROSS SECTIONS SHEET #3

PROJECT NAME: RICHMOND

PROJECT NUMBER: STP-RS 0284(11)

FILE NAME: z90c092_XSI_13.dgn
PROJECT LEADER: D.E.G.
DESIGNED BY: B.T.H.
DWG. NO.: XS-3

PLOT DATE: 6/20/2011
DRAWN BY: C.A.K.
CHECKED BY: D.E.G.
SHEET 22 OF 29

FILE NAME = V:\Projects\ANY\K2\22076\CADD_MSTN\MBS (1-13) DETOUR\z90c092_xs1_13.dgn
DATE/TIME = 6/20/2011
USER = JOBS