646.406 DURABLE 4 INCH WHITE LINE, RECESSED POLYUREA
(ALL LINES WILL INCLUDE EDGE LINE BREAKS AND RADIUS FOR TOWN HIGHWAYS)
RICHMOND:
STA 36+50.00 - STA 41+00.00 EDGE LINE LT & RT

646.416 DURABLE 4 INCH YELLOW LINE, RECESSED POLYUREA
(ALL LINES WILL INCLUDE C/L BREAKS FOR TOWN HIGHWAYS) S=SOLID, D=DASHED

RICHMOND:	LT	℄	RT
STA 36+50.00 - STA 41+00.00	S	-	S

646.602 TEMPORARY 4 INCH WHITE LINE, PAINT
(ALL LINES WILL INCLUDE EDGE LINE BREAKS AND RADIUS FOR TOWN HIGHWAYS)
RICHMOND:
STA 36+50.00 - STA 41+00.00 EDGE LINE LT & RT

646.612 TEMPORARY 4 INCH YELLOW LINE, PAINT
(ALL LINES WILL INCLUDE C/L BREAKS FOR TOWN HIGHWAYS) S=SOLID, D=DASHED

RICHMOND:	LT	℄	RT
STA 36+50.00 - STA 41+00.00	S	-	S

675.50 REMOVING SIGNS
AS SHOWN - 2

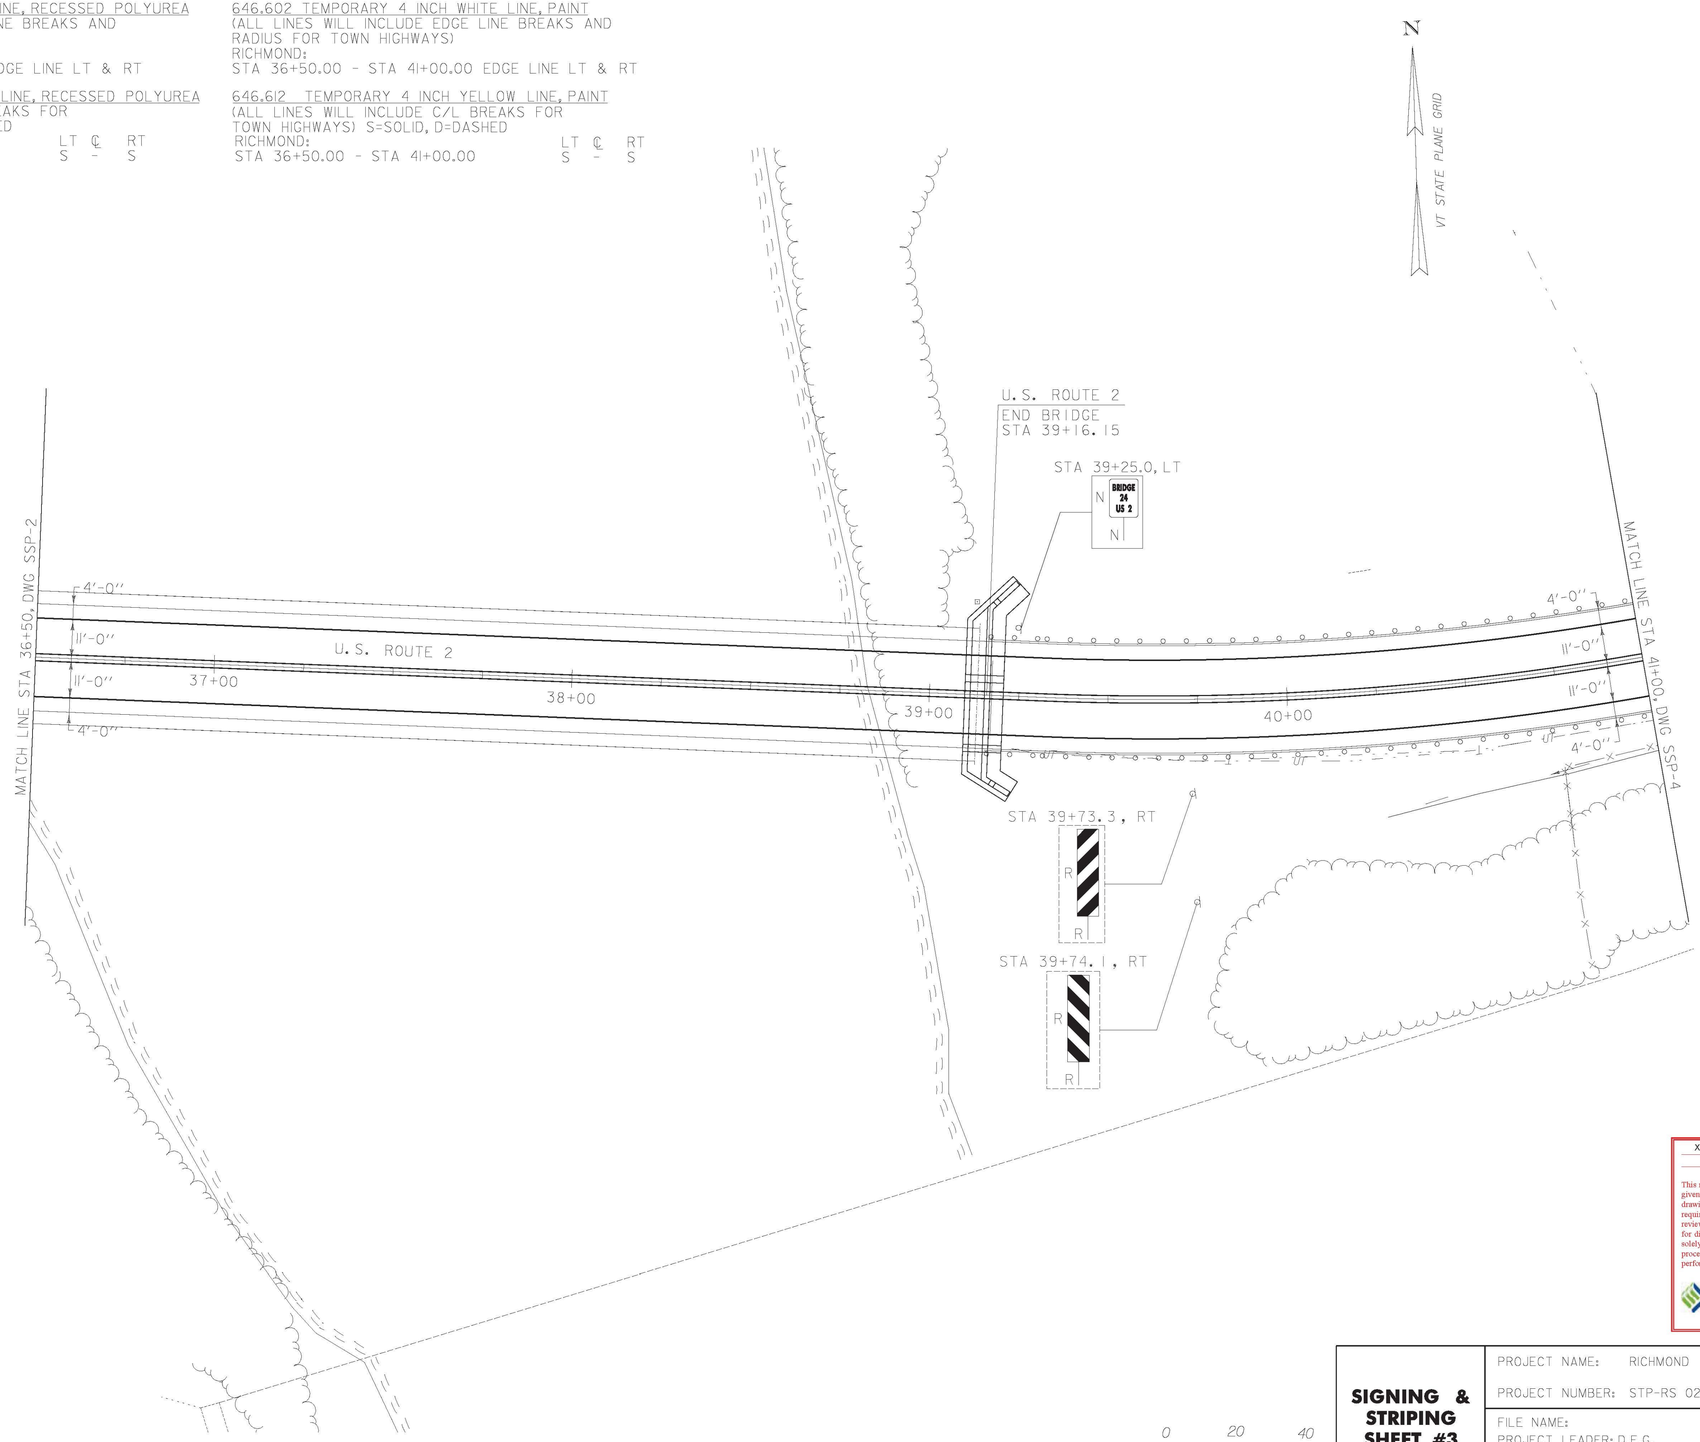

SIGN LEGEND
R = REMOVE
S = SALVAGE
N = NEW
RET = RETAIN
B-B = BACK TO BACK
EXISTING = ----------
NEW = ——————

0 20 40
SCALE IN FEET

X Reviewed
Rejected
Furnish As Corrected
Revise and Resubmit

This review is only for general conformance with the design concept and the information given in the Construction Documents. Corrections or comments made on the shop drawings during the review do not relieve the Contractor from compliance with the requirements of the Plans and Specifications. Review of a specific item shall not include review of an assembly of which an item is a component. The Contractor is responsible for dimensions to be confirmed and corrected at the job site; information that pertains solely to the fabrication process or to the means, methods, techniques, sequences and procedures of construction; coordination of the Work with that of other trades and performing all Work in a safe and satisfactory manner.

McFarland Johnson

Date Apr 21, 2011
By J. Santacruce

SIGNING & STRIPING SHEET #3

PROJECT NAME: RICHMOND
PROJECT NUMBER: STP-RS 0284(11)

FILE NAME:
PROJECT LEADER: D.E.G.
DESIGNED BY: B.T.H.
DWG. NO.: SSP-3

PLOT DATE: 4/20/2011
DRAWN BY: C.A.K.
CHECKED BY: D.E.G.
SHEET 4 OF 11

FILE NAME = v:\projects\any\k2\22076\coadd_mstn\sbs (1-18) striping\x298s092_ssp_03.18.dgn
DATE/TIME = 4/20/2011
USER = SBS