STATE OF VERMONT
AGENCY OF TRANSPORTATION

INDEX OF SHEETS

1	TITLE SHEET
2	TEMPORARY BRIDGE PLAN & ELEVATION
3	TEMPORARY BRIDGE PROFILE
4	MABEY BRIDGE SPAN 1 AND 2
5	MABEY BRIDGE DETAILS
6	TYPICAL SECTION SPAN 3
7	SPAN 3 FRAMING PLAN LAYOUT DIAGRAM
8	DECK LAYOUT PLAN
9	WEST TOWER DETAILS
10	WEST TOWER FOOTING PLAN AND PILE LAYOUT
11	SPAN 1 RIPRAP LIMIT PLAN
12	SPAN 3 SECTION AT PIER 2
13	TOWER DETAILS
14	TEMPORARY NORTHEAST TOWER
15	TEMPORARY SOUTHEAST TOWER
16	SPAN 3 SECTION AT EAST ABUTMENT
17	SUBSTRUCTURE DETAILS

PROPOSED IMPROVEMENT
BRIDGE PROJECT
TOWN OF RICHMOND
COUNTY OF CHITTENDEN
U.S. ROUTE 2
BRIDGE NO. 24
WBS 1-15 TEMPORARY BRIDGE

PROJECT LOCATION: BEGINNING ON U.S. ROUTE 2 APPROXIMATELY 0.568 MILE EASTERLY OF THE WILLISTON/RICHMOND TOWN LINE AND EXTENDING EASTERLY 0.331 MILE (1,750 FEET).

PROJECT DESCRIPTION: PROJECT CONSISTS OF REHABILITATING AND WIDENING EXISTING TRUSS BRIDGE NO. 24 OVER THE WINOOSKI RIVER, PLACEMENT OF A NEW PRECAST CONCRETE BOX WITH RELATED ROADWAY WORK AND INCIDENTAL ITEMS.

LENGTH OF STRUCTURE: 356.00 FEET
LENGTH OF ROADWAY: 1,394.00 FEET
LENGTH OF PROJECT: 1,750.00 FEET

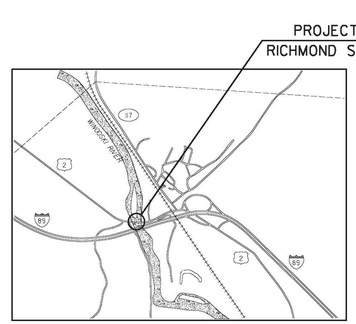

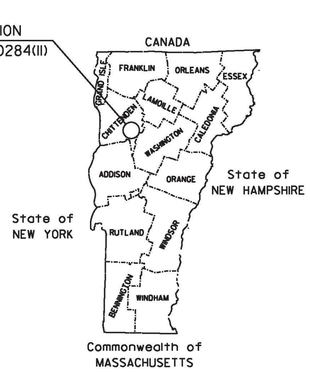

TRAFFIC DATA

2007 ADT	=	4000
2027 ADT	=	5300
2027 ADTT	=	340
2027 DHV	=	600
T	=	4%
D	=	64%
V	=	40 MPH

2007 ~ 2027 CUM. ESALS = 1,101,000
2007 ~ 2047 CUM. ESALS = 2,787,000
MAJOR COLLECTOR

RECORD PLANS

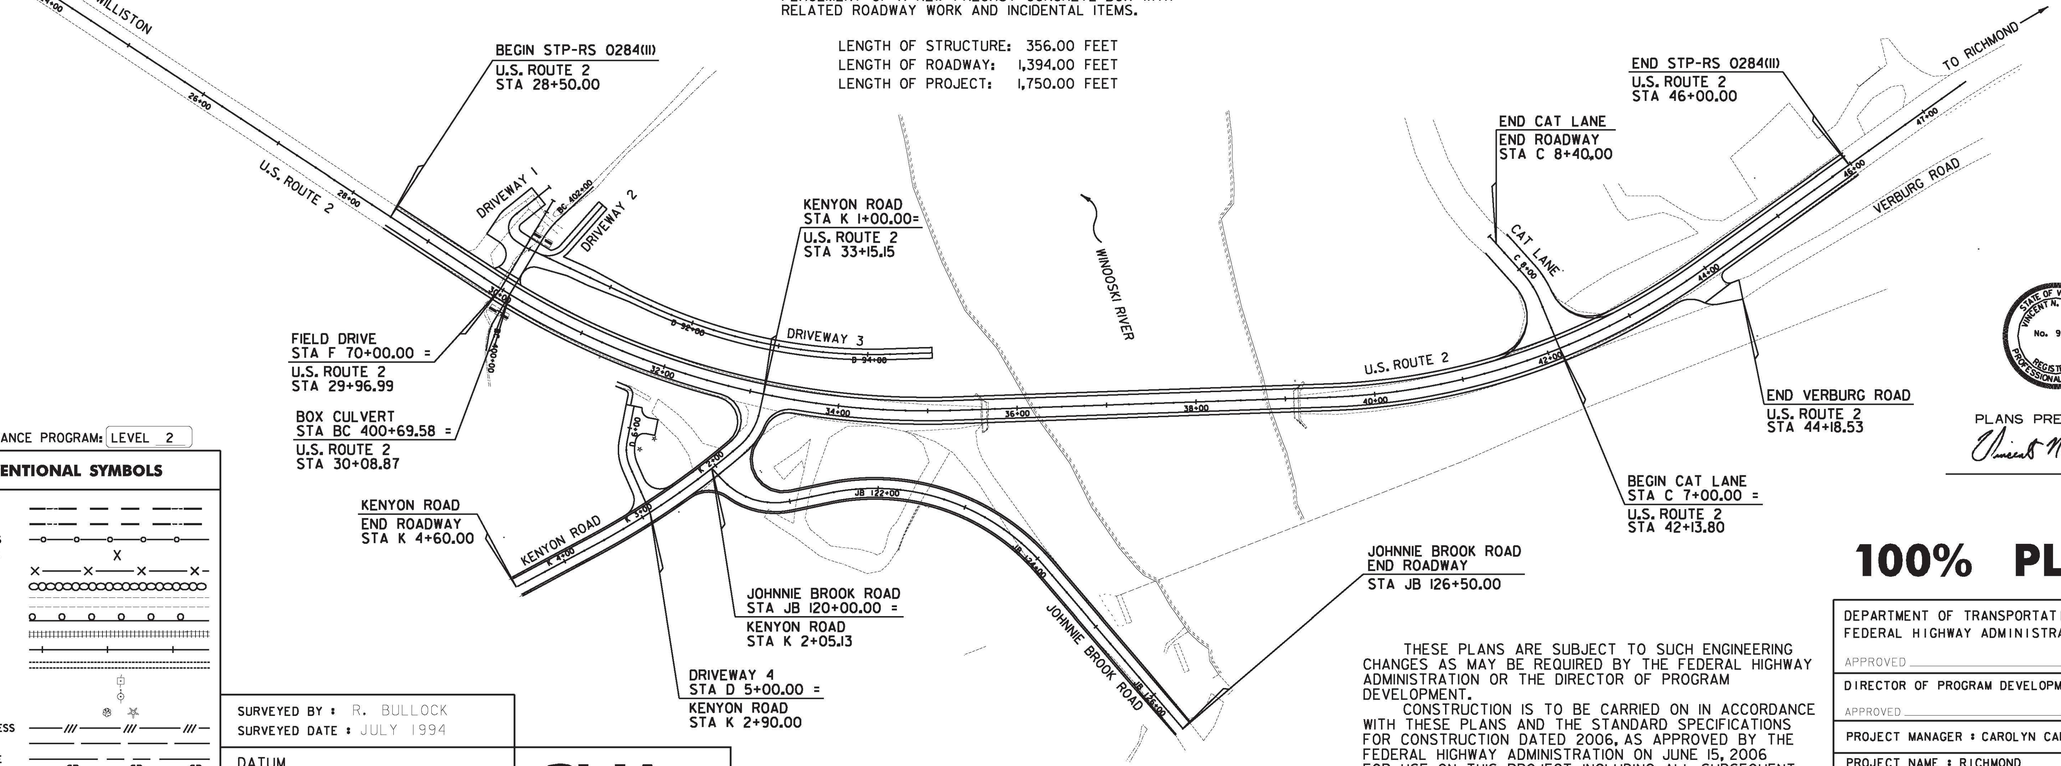

QUALITY ASSURANCE PROGRAM: LEVEL 2

CONVENTIONAL SYMBOLS

COUNTY LINE
TOWN LINE
LIMITS OF ACCESS
POINT OF ACCESS
FENCE LINE
STONE WALL
TRAVELED WAY
GUARD RAIL
RAILROAD
SURVEY LINE
CULVERT
POWER POLE
TELEPHONE POLE
TREES
CONTROL OF ACCESS
PROPERTY LINE
R.O.W. TAKING LINE
SLOPE RIGHTS (SR SR SR)
TOP OF CUT
TOE OF SLOPE

SURVEYED BY : R. BULLOCK
SURVEYED DATE : JULY 1994

DATUM
VERTICAL NAVD 88
HORIZONTAL NAD 83

CHA

PLANS PREPARED BY
Vincent N. Campisi

100% PLANS

DEPARTMENT OF TRANSPORTATION
FEDERAL HIGHWAY ADMINISTRATOR
APPROVED _____ DATE _____

DIRECTOR OF PROGRAM DEVELOPMENT
APPROVED _____ DATE _____

PROJECT MANAGER : CAROLYN CARLSON

PROJECT NAME : RICHMOND

PROJECT NUMBER : STP-RS 0284(11)

SHEET 1 OF 17 SHEETS

THESE PLANS ARE SUBJECT TO SUCH ENGINEERING CHANGES AS MAY BE REQUIRED BY THE FEDERAL HIGHWAY ADMINISTRATION OR THE DIRECTOR OF PROGRAM DEVELOPMENT.
CONSTRUCTION IS TO BE CARRIED ON IN ACCORDANCE WITH THESE PLANS AND THE STANDARD SPECIFICATIONS FOR CONSTRUCTION DATED 2006, AS APPROVED BY THE FEDERAL HIGHWAY ADMINISTRATION ON JUNE 15, 2006 FOR USE ON THIS PROJECT, INCLUDING ALL SUBSEQUENT REVISIONS AND SUCH REVISED SPECIFICATIONS AND SPECIAL PROVISIONS AS ARE INCORPORATED IN THESE PLANS.

FILE NAME = v:\projects\any\x21276\CADD_MSTN\BRIDGE WORK\WBS (1-15) TEMPORARY BRIDGE\x90s892_cov_15.dgn
DATE/TIME = 6/7/2011
USER = SEMS