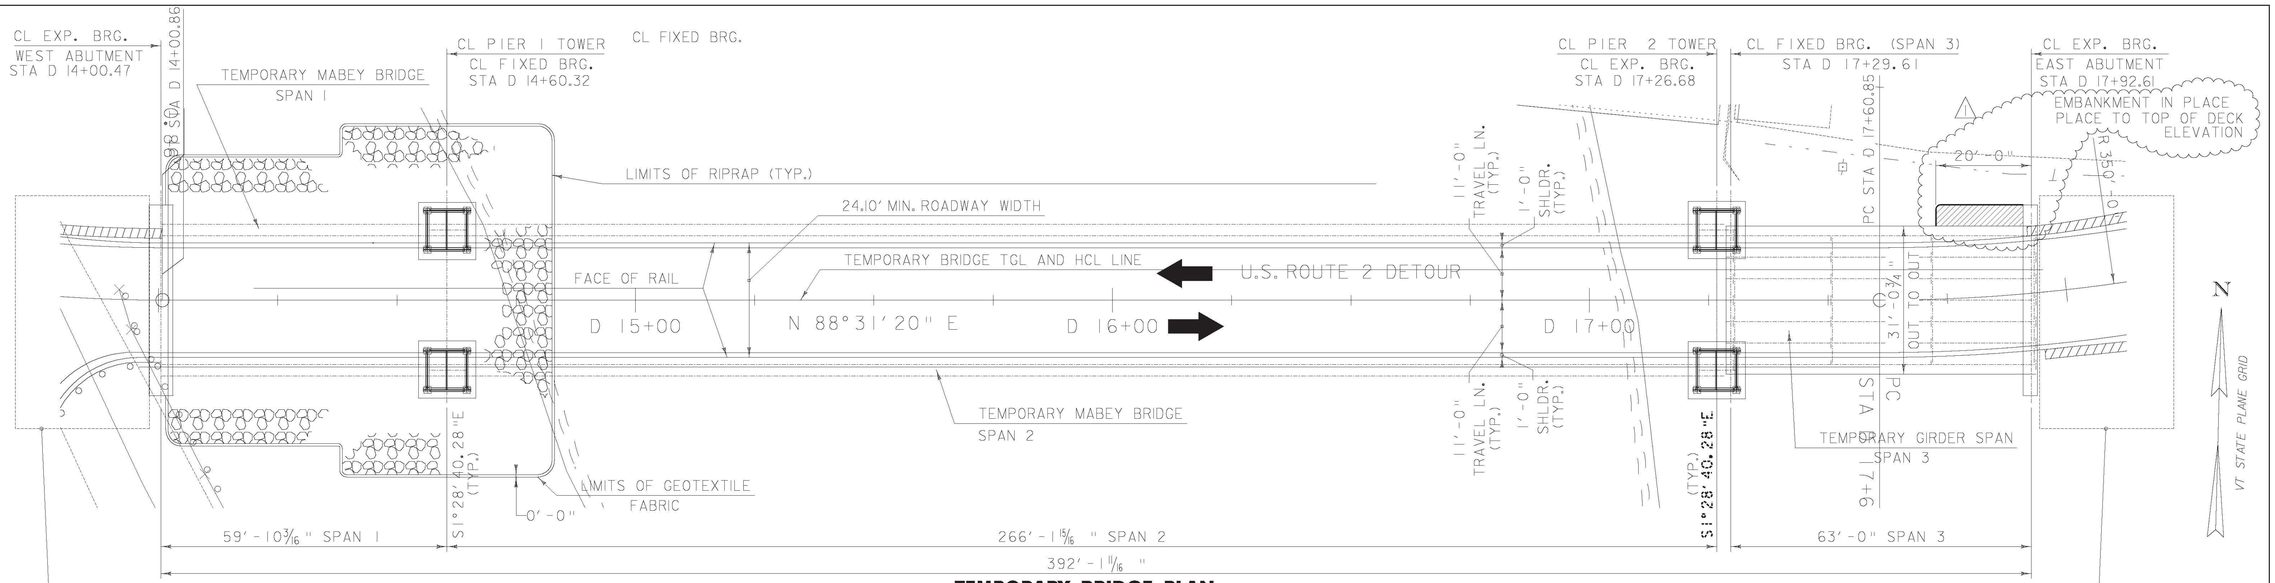

TEMPORARY BRIDGE PLAN

0 15 30
SCALE IN FEET

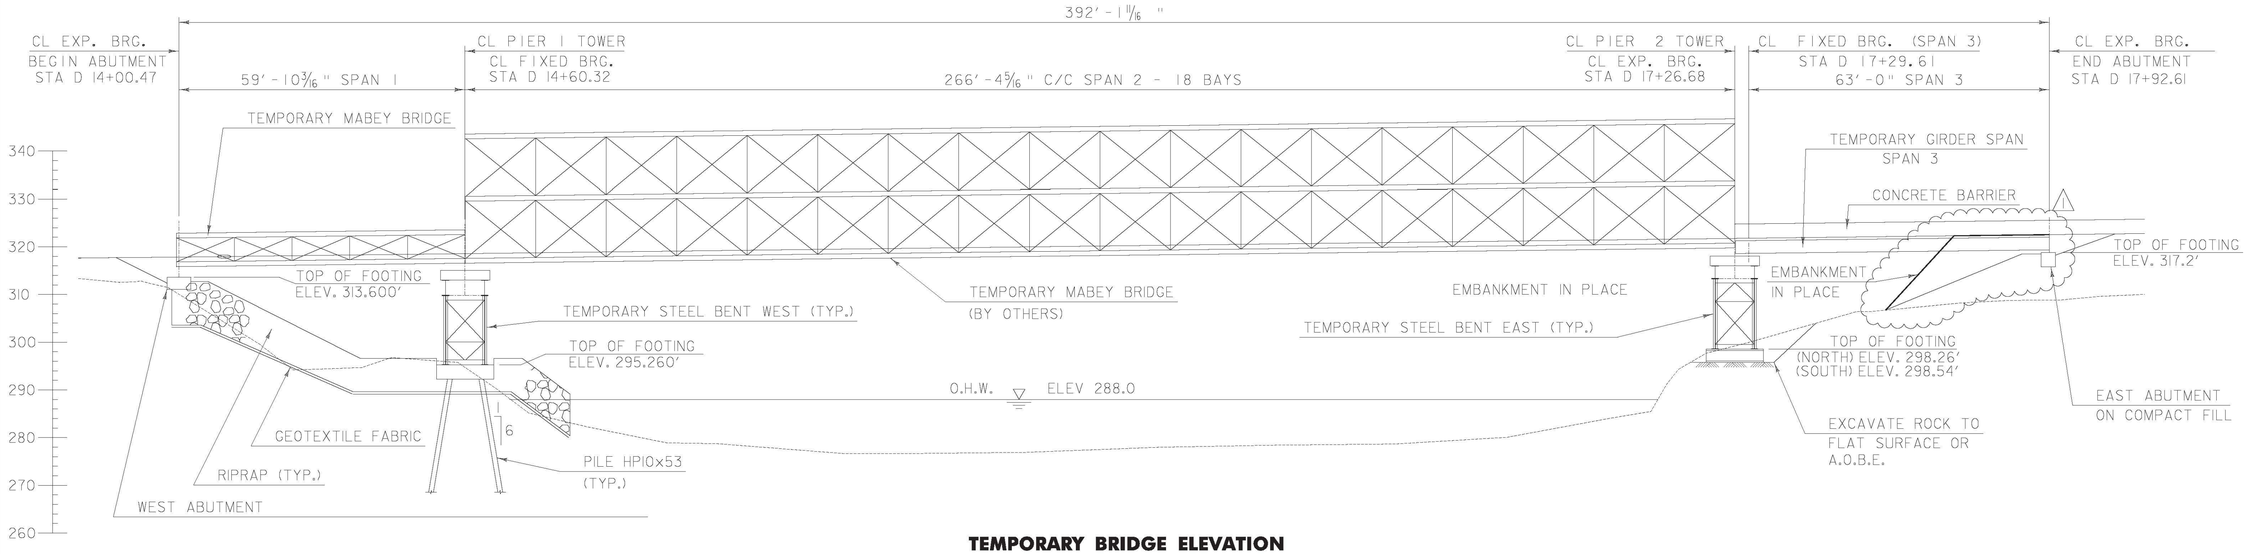

TEMPORARY BRIDGE ELEVATION

0 15 30
SCALE IN FEET

TEMPORARY BRIDGE PLAN & ELEVATION	PROJECT NAME: RICHMOND PROJECT NUMBER: STP-RS 0284(11)
	FILE NAME: z90c092 TMP BRDG PLN.dgn PROJECT LEADER: DJV DESIGNED BY: DJV DWG. NO.: 2 PLOT DATE: 6/21/2011 DRAWN BY: PKR CHECKED BY: VC/KM SHEET 2 OF XX

FILE NAME = v:\projects\any\k2\22076\cadd_msn\bridge work\wbs (1-15) temporary bridge\z90c092_TMP_BRDG_PLN.dgn
DATE/TIME = 6/21/2011
USER = 92073