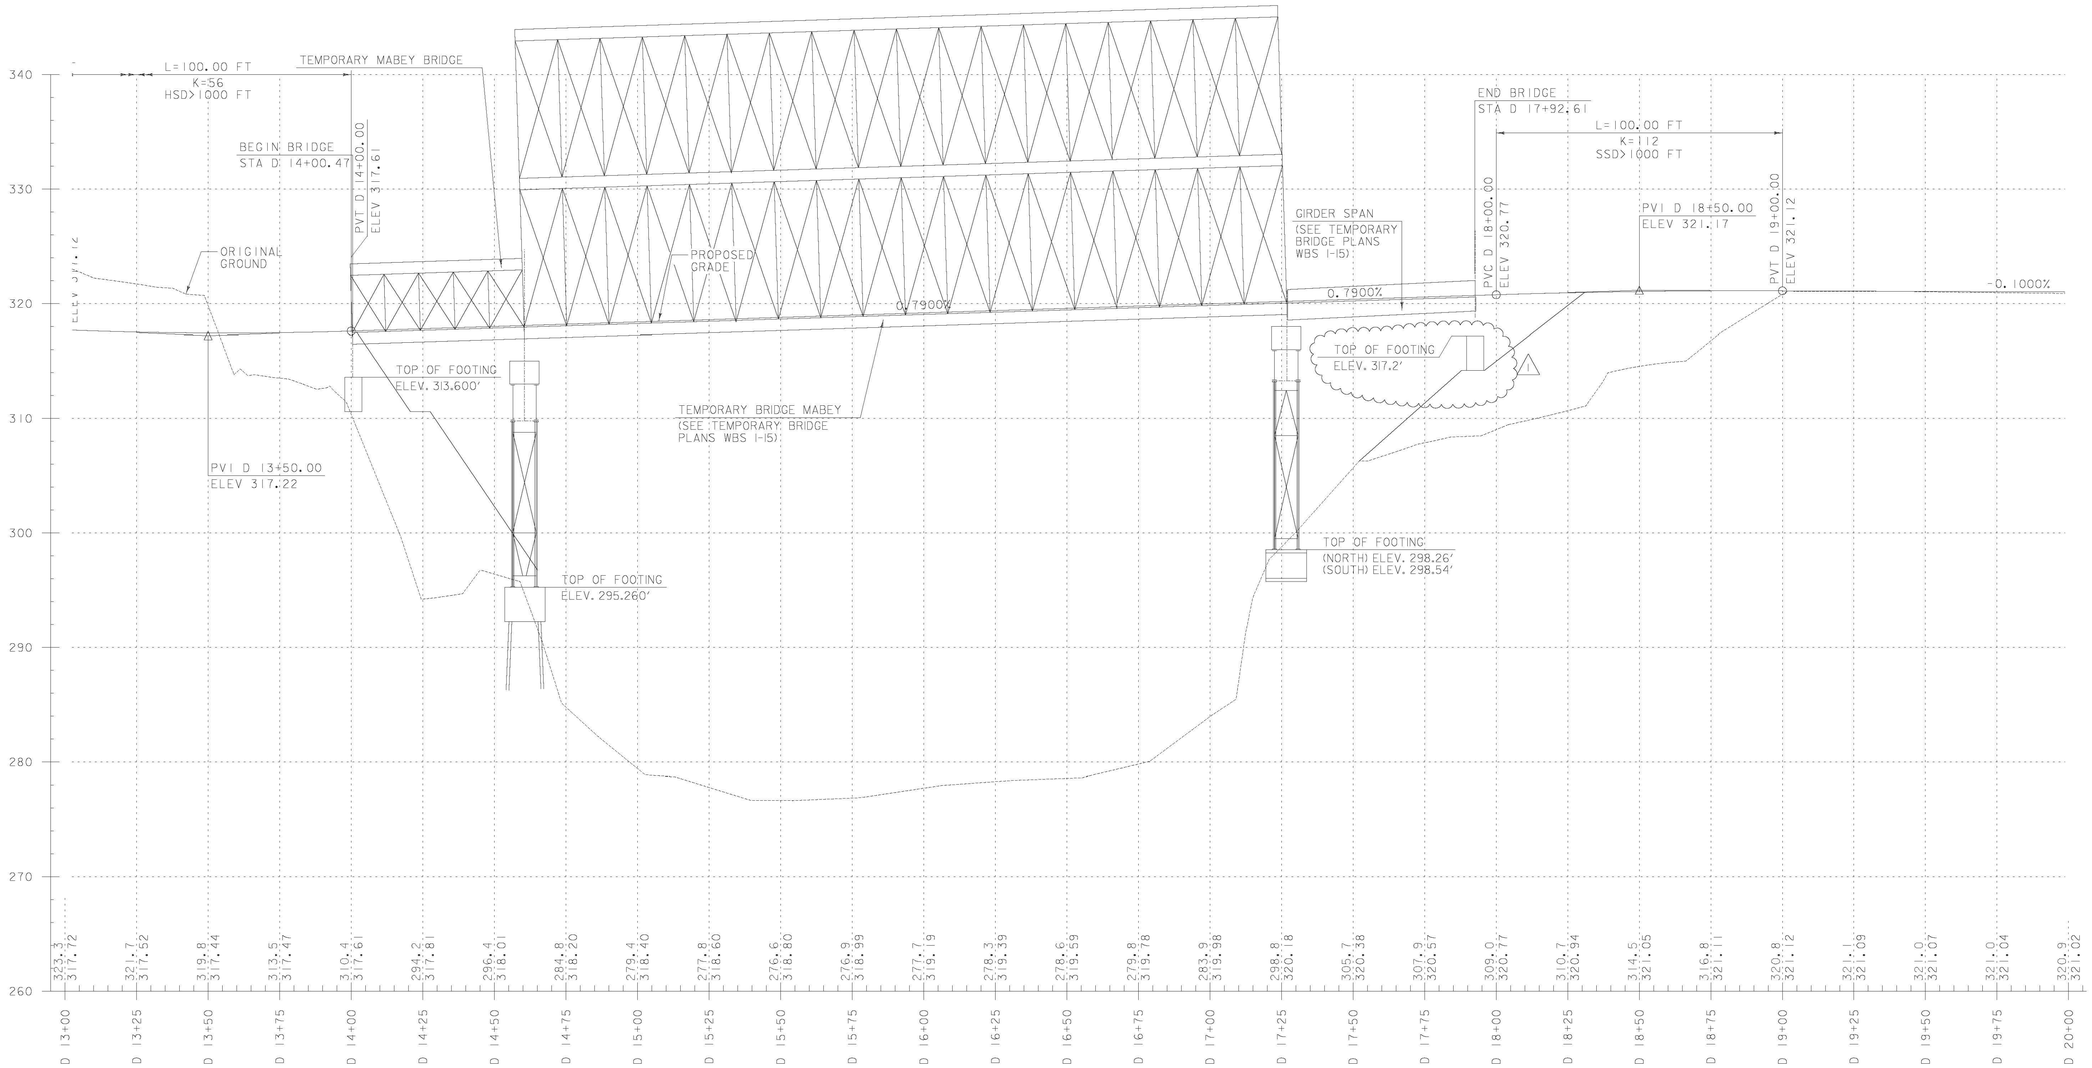

PROFILE

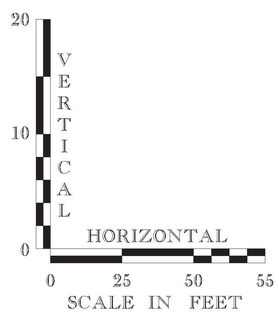

TEMPORARY BRIDGE PROFILE	PROJECT NAME: RICHMOND	
	PROJECT NUMBER: STP-RS 0284(11)	
	FILE NAME: z90c092 TMP PRO.dgn PROJECT LEADER: DJV DESIGNED BY: DJV DWG. NO.: 3	PLOT DATE: 6/21/2011 DRAWN BY: PKR CHECKED BY: VC/KM SHEET 3 OF XX

FILE NAME = v:\projects\any\k2\22076\cadd_msm\bridge work\wbs (1-15) temporary bridge\z90c092_TMP_PRO.dgn
DATE/TIME = 6/21/2011
USER = 9293