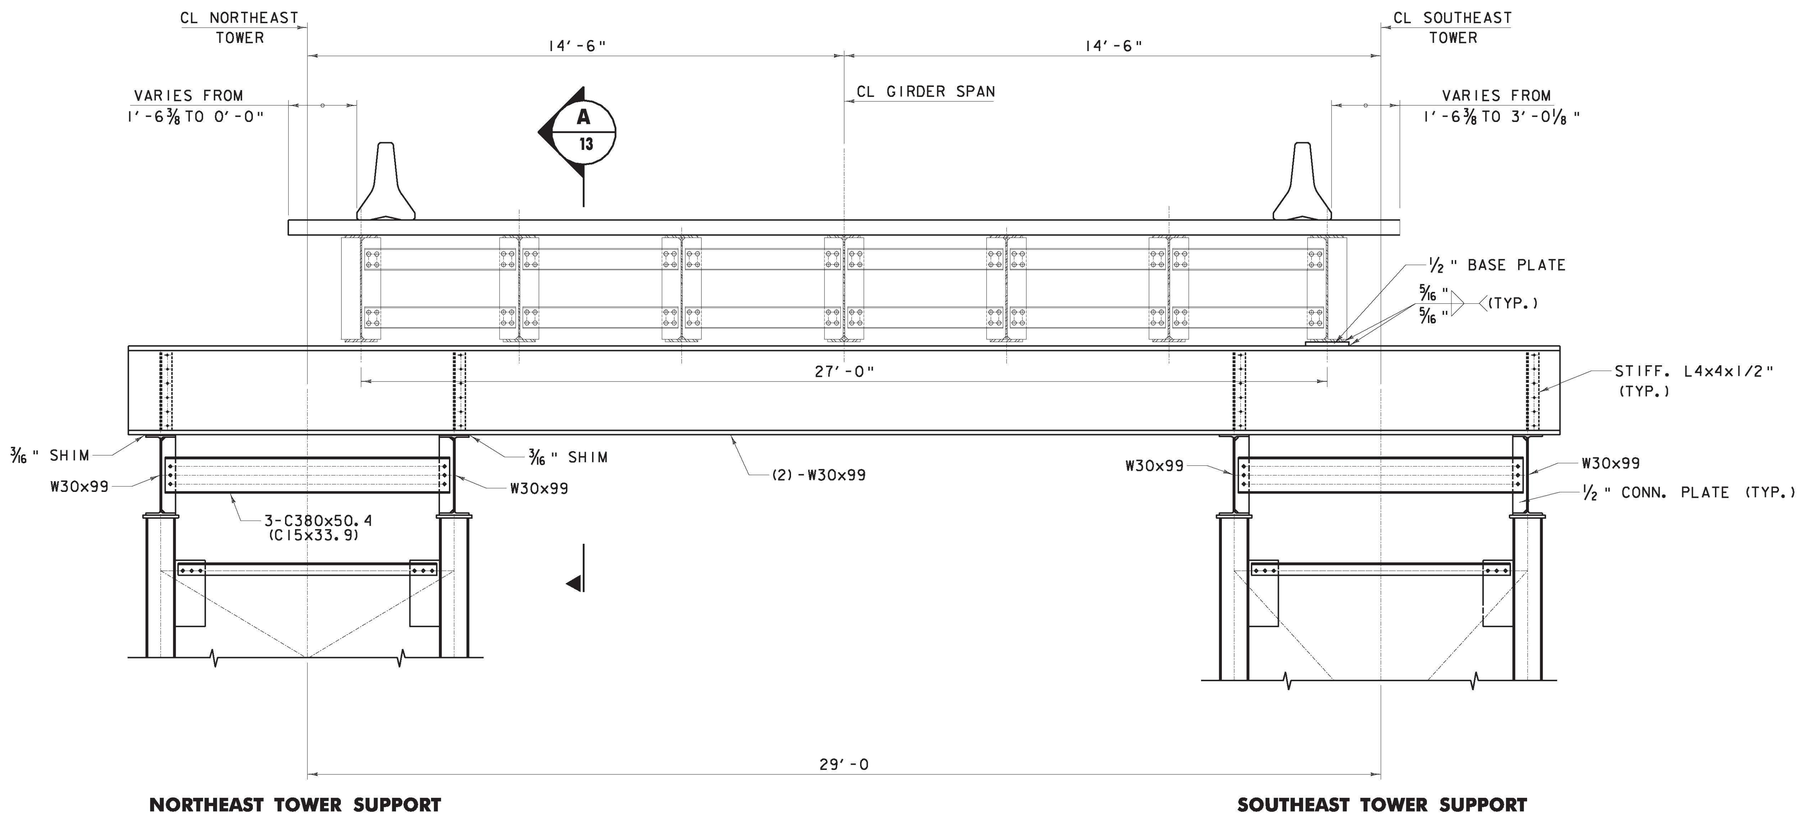

SPAN 3 SECTION AT PIER 2

SPAN 3 SECTION AT PIER 2	PROJECT NAME: RICHMOND PROJECT NUMBER: STP-RS 0284(11)
	FILE NAME: z90c092 EAST TWR LYOUT.dgn PROJECT LEADER: DJV DESIGNED BY: DJV DWG. NO.: 12 PLOT DATE: 6/1/2011 DRAWN BY: PKR CHECKED BY: VC/KM SHEET 12 OF XX

FILE NAME = w:\projects\eng\k2\22076\cadd_msm\bridge work\wbs (1-15) temporary bridge\z90c092_EAST_TWR LYOUT.dgn
DATE/TIME = 6/1/2011
USER = 3293