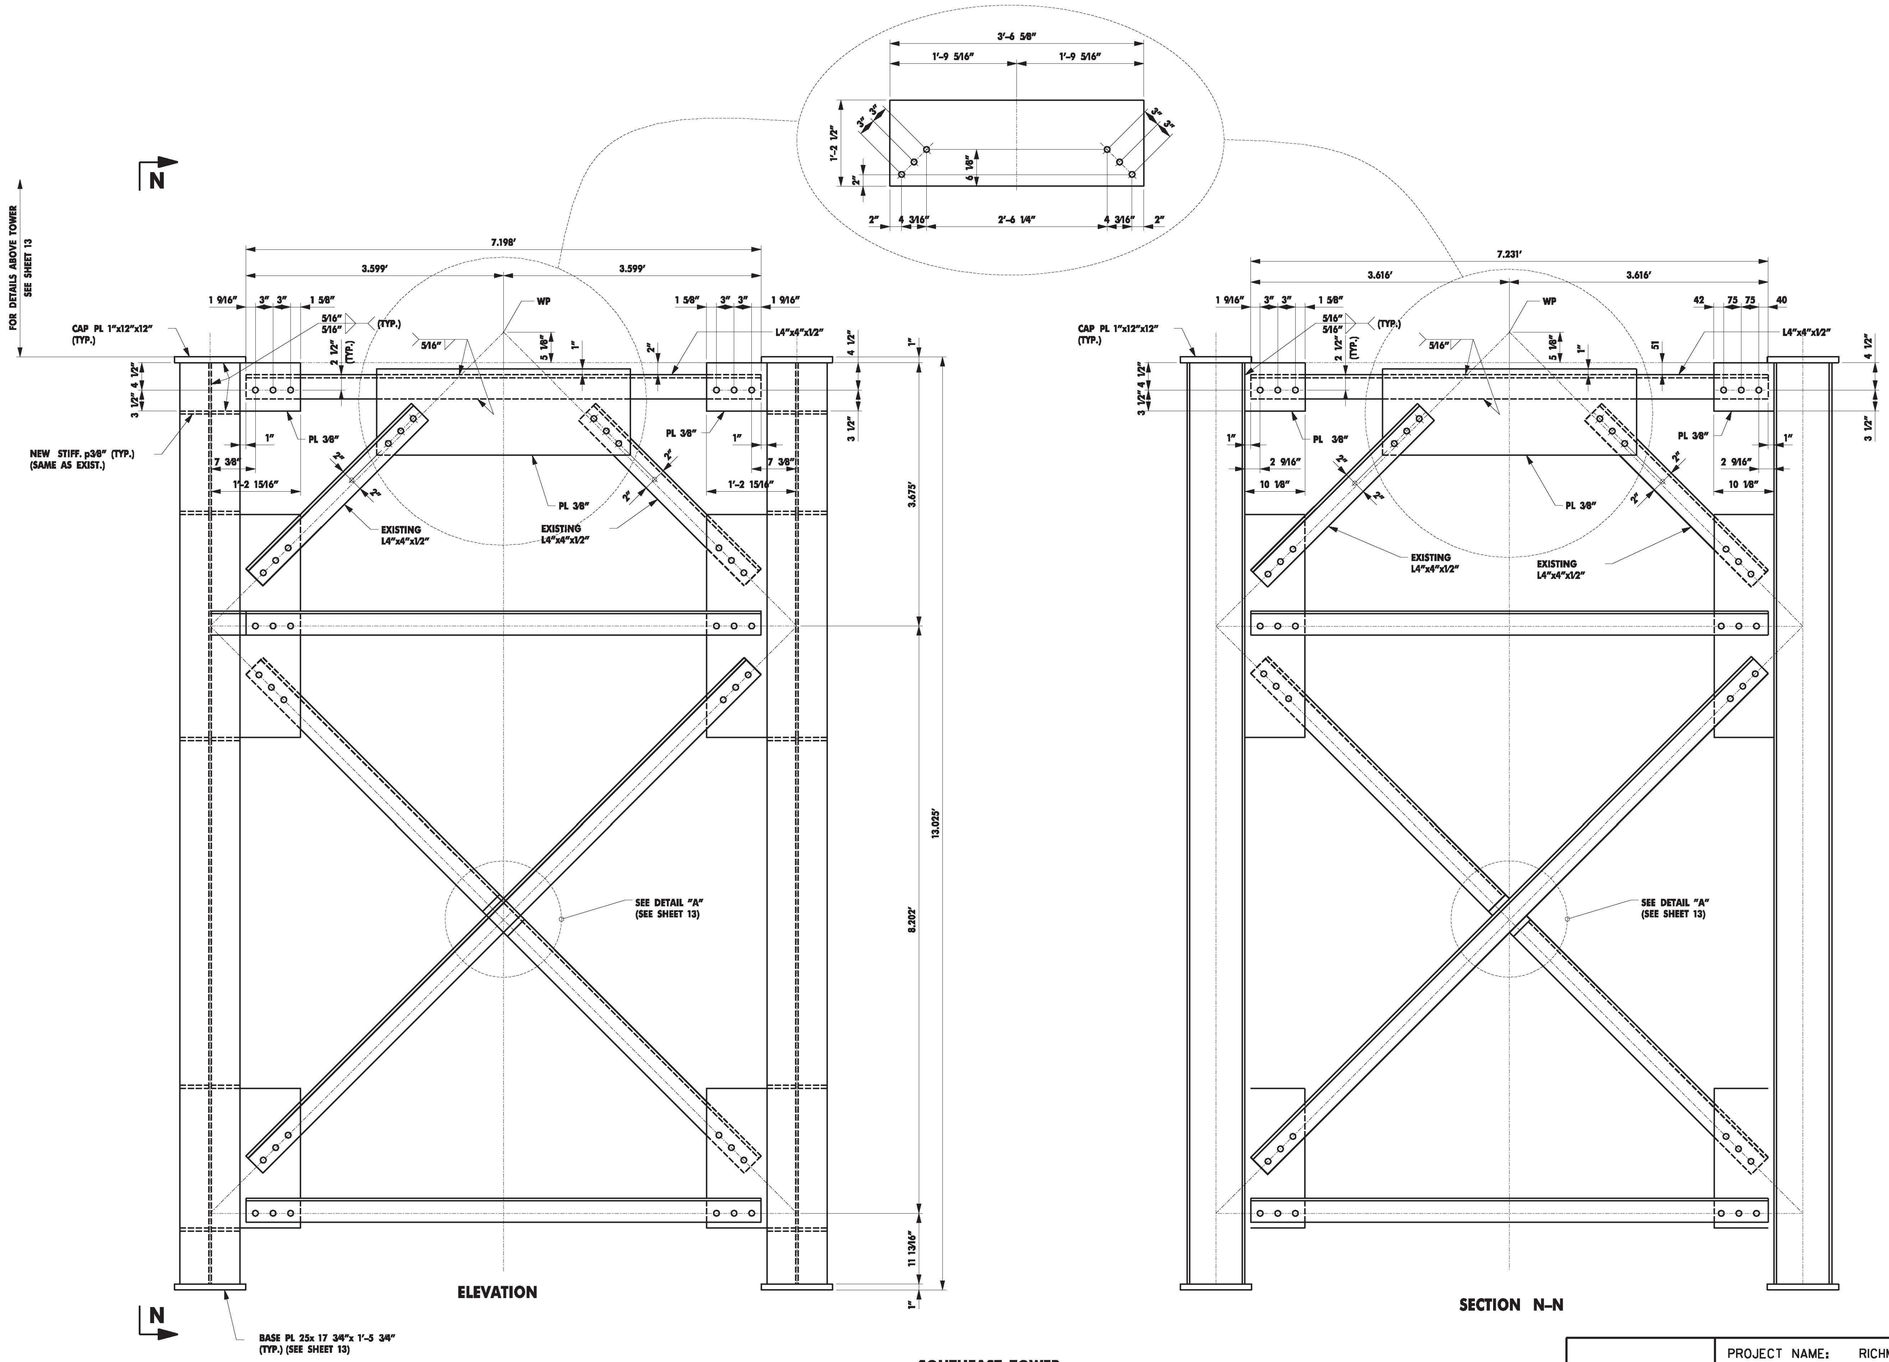

SOUTHEAST TOWER

(CUT FROM BOTTOM OF EXISTING TOWER)

TEMPORARY SOUTHEAST TOWER	PROJECT NAME: RICHMOND	
	PROJECT NUMBER: STP-RS 0284(11)	
	FILE NAME: z90c092_SOUTHEAST TOWERS.dgn	PLOT DATE: 6/1/2011
	PROJECT LEADER: DJV	DRAWN BY: PKR
	DESIGNED BY: DJV	CHECKED BY: VC/KM
	DWG. NO.: 15	SHEET 15 OF XX

FILE NAME = v:\projects\eng\k2\22076\cadd_msm\bridge work\vbs (1-15) temporary bridge\z98c092_SOUTHEAST TOWERS.dgn
DATE/TIME = 6/1/2011
USER = 3273