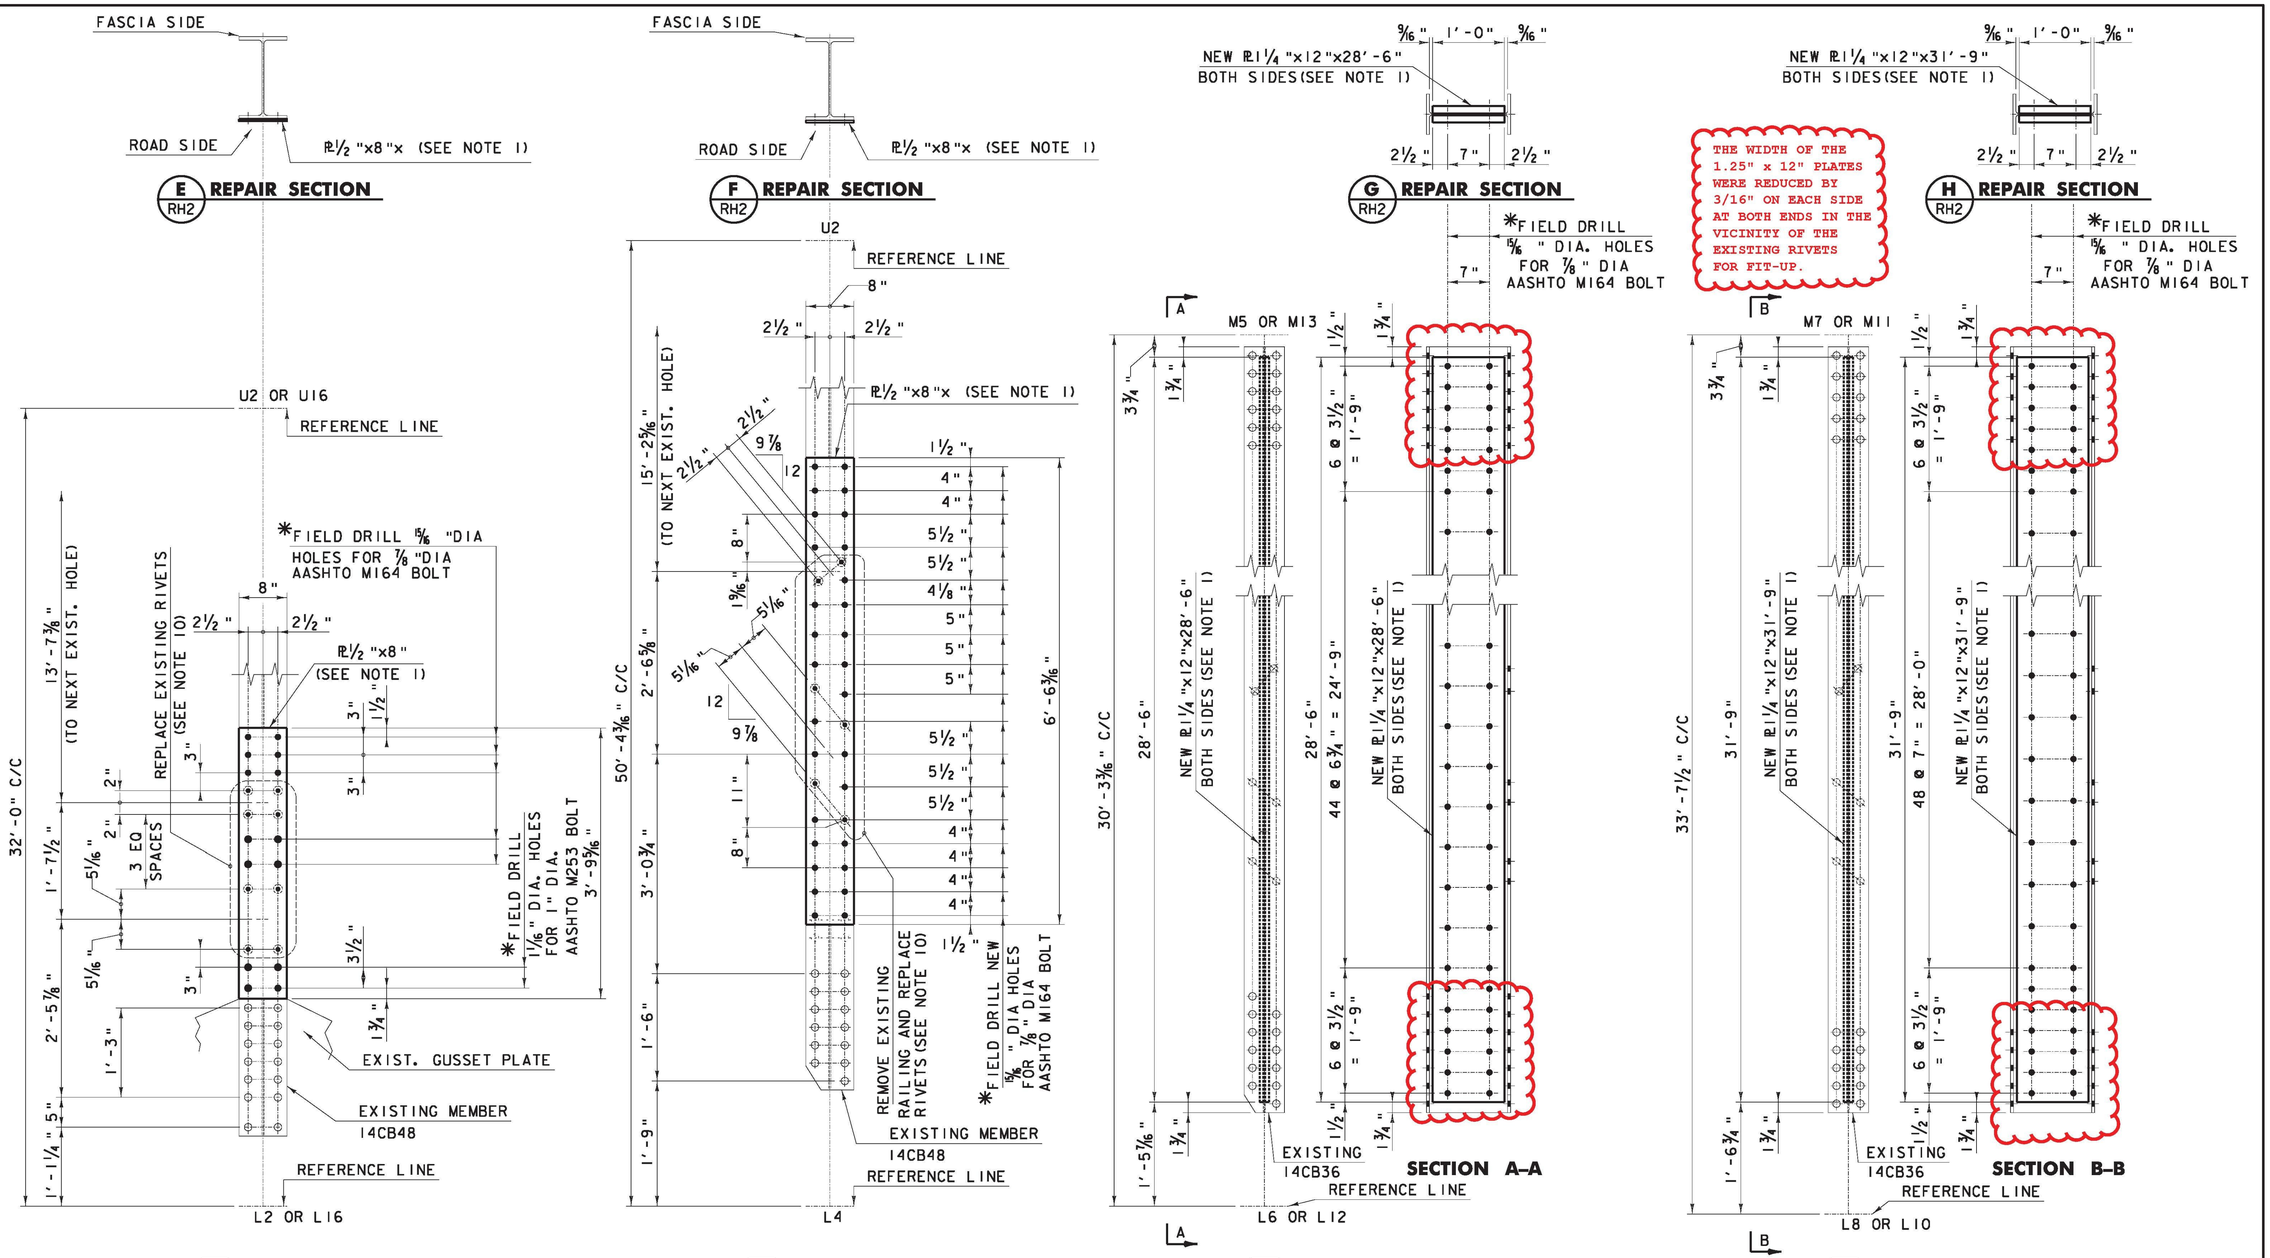

NOTES:

FOR STRUCTURAL STEEL NOTES SEE DWG RH1.

* -SEE "CONNECTION INSTALLATION MOTHODS" ON DWG RH1.

TRUSS REPAIR DETAILS	PROJECT NAME: RICHMOND PROJECT NUMBER: STP-RS 0284(11)	
	FILE NAME: z90c092 truss rehab 02.dgn PROJECT LEADER: DJV DESIGNED BY: CTA DWG. NO.: RH2	PLOT DATE: 4/5/2012 DRAWN BY: PKR CHECKED BY: VC/KM SHEET 3 OF 3

FILE NAME = V:\Projects\ANY\K2\22076\CADD_MSTN\BRIDGE WORK\WBS (2-1) TRUSS REHAB\z90c092_truss rehab_02.dgn
DATE/TIME = 4/5/2012
USER = 5273