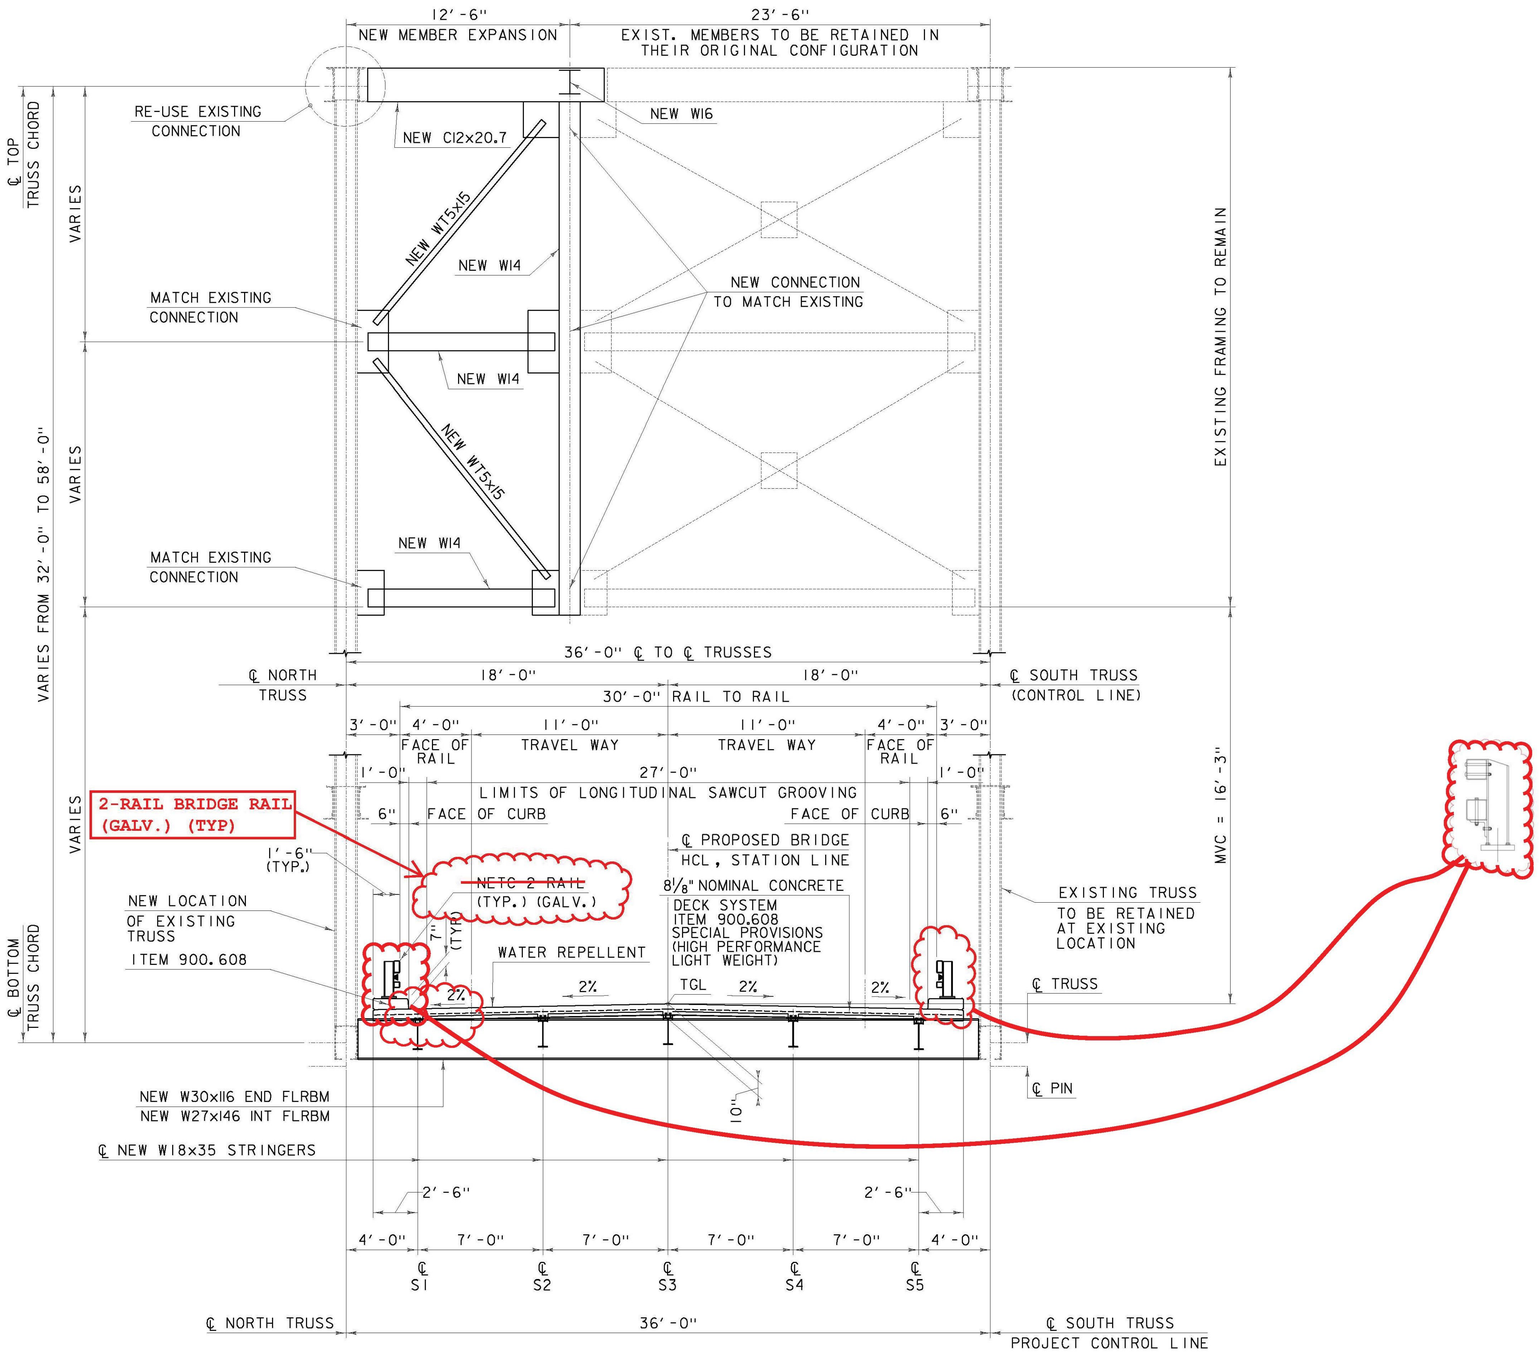

PROPOSED BRIDGE SECTION

0 4 8

SCALE 1/4" = 1'-0"

LEGEND

-------- -DENOTES EXISTING MEMBER

——— -DENOTES PROPOSED MEMBER

TYPICAL SECTION	PROJECT NAME: RICHMOND	
	PROJECT NUMBER: STP-RS 0284(11)	
	FILE NAME: z90c092_brdg-sect_01.dgn	PLOT DATE: 3/14/2013
	PROJECT LEADER: VNC	DRAWN BY: PKR
	DESIGNED BY: DJV	CHECKED BY: DJV
	DWG. NO.: S5	SHEET 4 OF 20

FILE NAME = V:\Projects\ANY\KC\22876\CADD_MSTN\BRIDGE WORK\WBS (1-16) BRIDGE DESIGN\z90c092_brdg-sect_01.dgn
DATE/TIME = 3/14/2013
USER = 3293