ANCHOR FOR STEEL BEAM GUARD RAIL
STA. 6+606.4, LT.

REMOVAL AND DISPOSAL OF GUARD RAIL
STA. 6+500.0 TO 6+534.2, RT.

STEEL BEAM GUARD RAIL(MOD. W/2.4 M POSTS)
~~STA. 6+500.0 TO 6+534.2, RT.~~
STA. 6+500.0 TO 6+606.4, LT.

MODIFIED ECCENTRIC LOADER TERMINAL
STA. STA. ~~6+534.2~~, RT.
6+604.0 LT.

VT ROUTE 15
UNDERHILL
STA. 7+029.61 = MM 4.368
END STP 9469(1)S

Metric

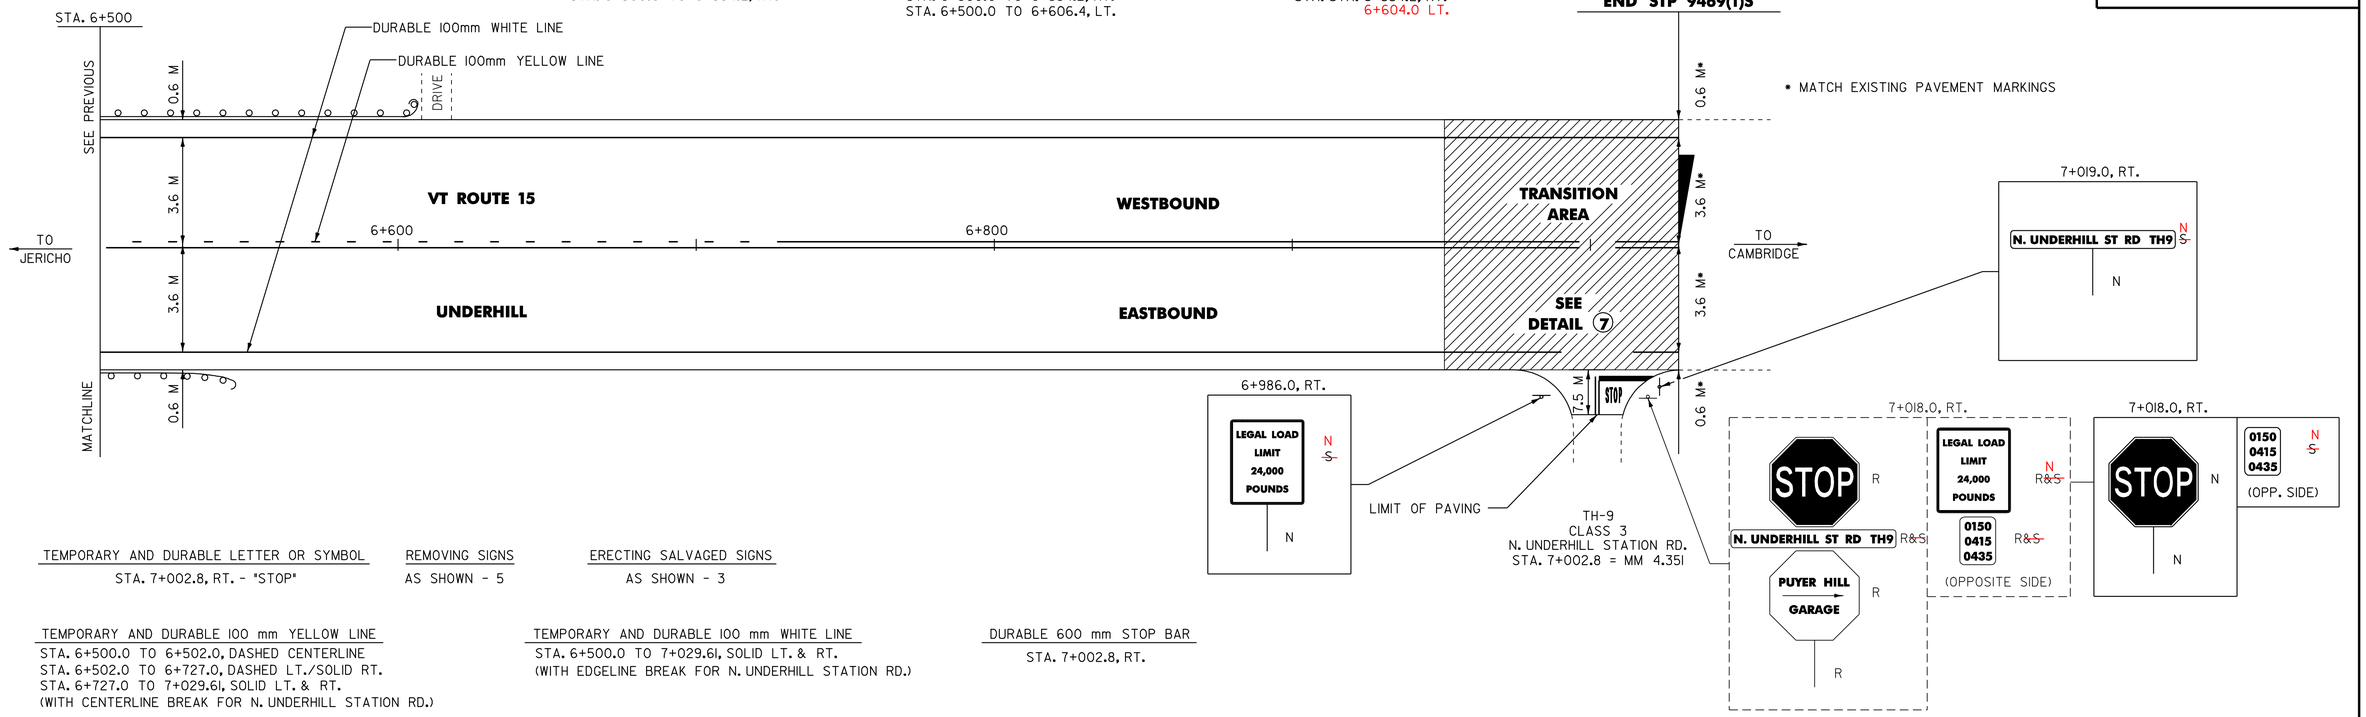

TEMPORARY AND DURABLE LETTER OR SYMBOL
STA. 7+002.8, RT. - "STOP"

REMOVING SIGNS
AS SHOWN - 5

ERECTING SALVAGED SIGNS
AS SHOWN - 3

TEMPORARY AND DURABLE 100 mm YELLOW LINE
STA. 6+500.0 TO 6+502.0, DASHED CENTERLINE
STA. 6+502.0 TO 6+727.0, DASHED LT./SOLID RT.
STA. 6+727.0 TO 7+029.61, SOLID LT. & RT.
(WITH CENTERLINE BREAK FOR N. UNDERHILL STATION RD.)

TEMPORARY AND DURABLE 100 mm WHITE LINE
STA. 6+500.0 TO 7+029.61, SOLID LT. & RT.
(WITH EDGELINE BREAK FOR N. UNDERHILL STATION RD.)

DURABLE 600 mm STOP BAR
STA. 7+002.8, RT.

TEMPORARY AND DURABLE 100 mm YELLOW LINE
STA. 10+495.0, DOUBLE SOLID RT. (ALLEN MARTIN DR.)
STA. 10+501.0 TO 10+507.0, SOLID RT. (ALLEN MARTIN DR.)

TEMPORARY AND DURABLE 100 mm WHITE LINE
STA. 10+498.5, SOLID RT. (ALLEN MARTIN DR.)
STA. 10+498.5 TO 10+515.0, RT. (ALLEN MARTIN DR.)

TEMPORARY AND DURABLE 200 mm WHITE LINE
STA. 10+498.5 TO 10+515.0, RT. (TRANSVERSE LINES)

INTERSECTION DETAIL
VT ROUTE 15 & ALLEN MARTIN DR.

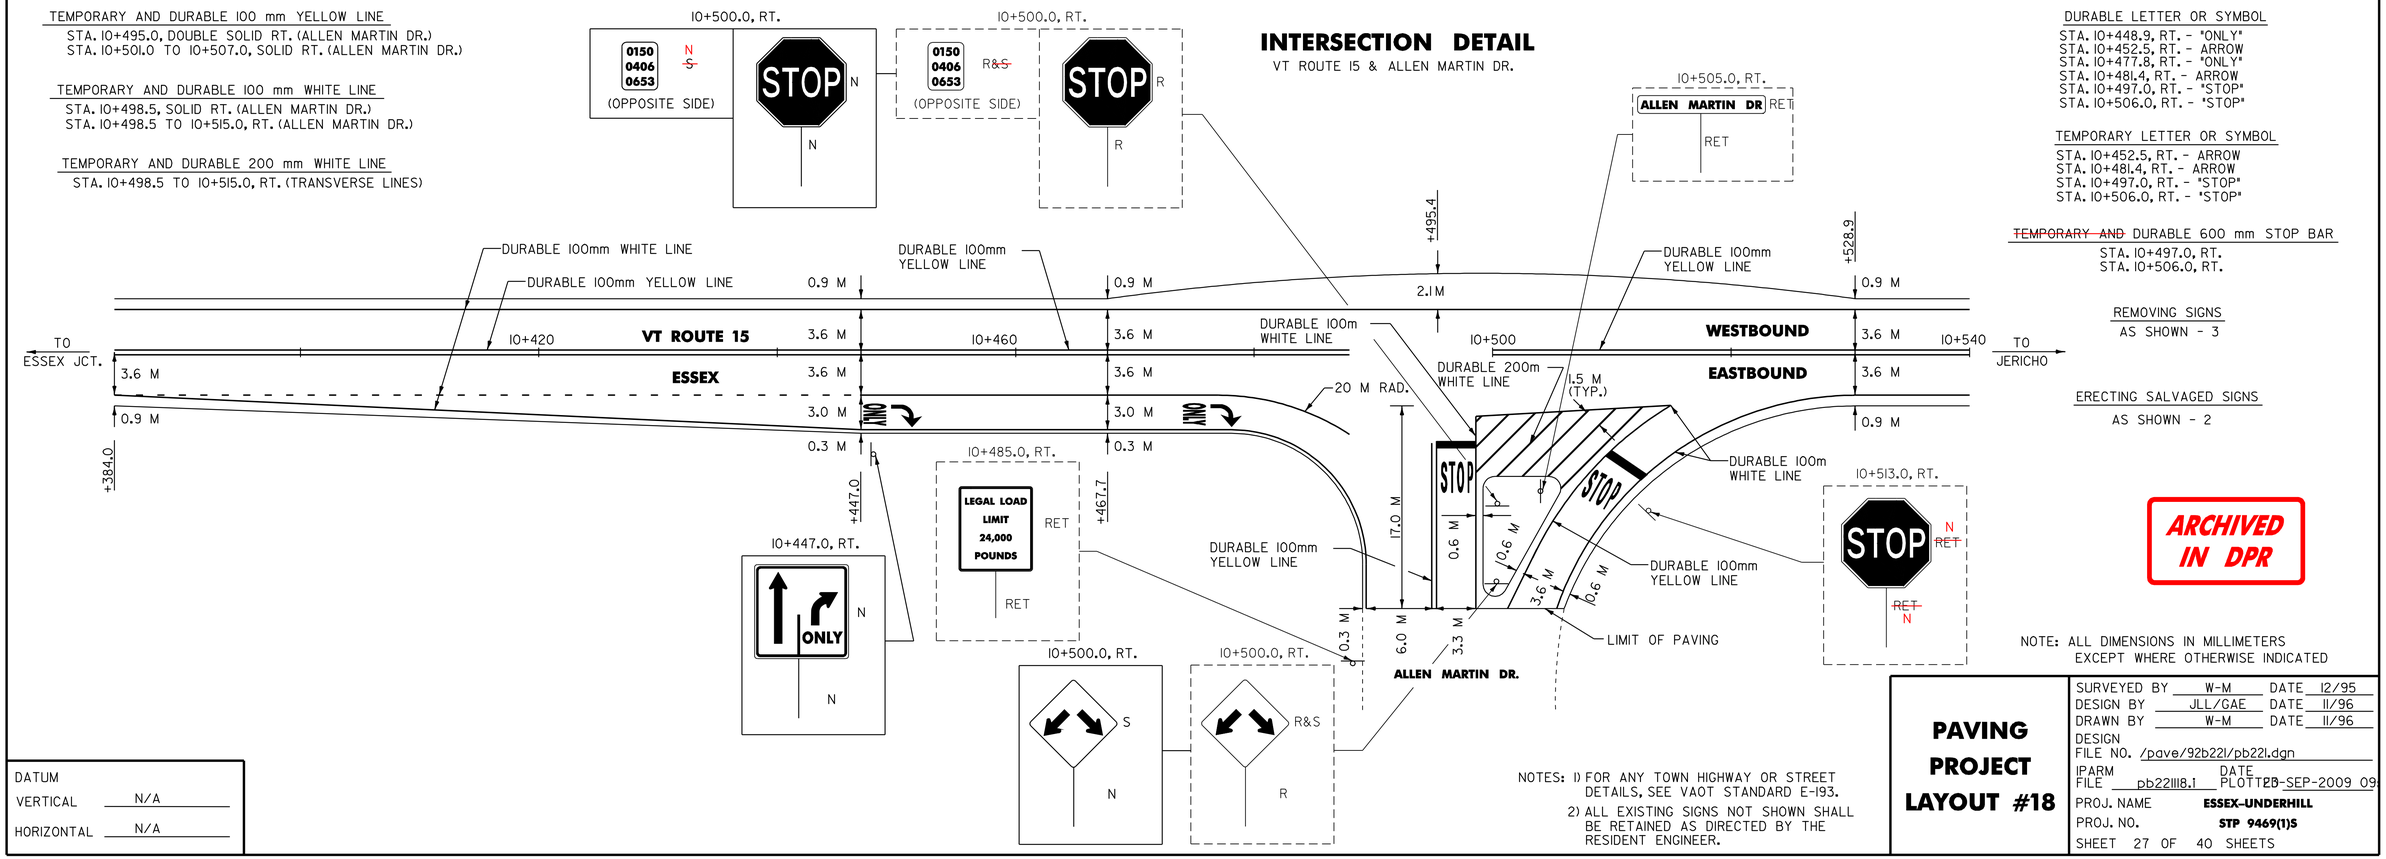

DURABLE LETTER OR SYMBOL
STA. 10+448.9, RT. - "ONLY"
STA. 10+452.5, RT. - ARROW
STA. 10+477.8, RT. - "ONLY"
STA. 10+481.4, RT. - ARROW
STA. 10+497.0, RT. - "STOP"
STA. 10+506.0, RT. - "STOP"

TEMPORARY LETTER OR SYMBOL
STA. 10+452.5, RT. - ARROW
STA. 10+481.4, RT. - ARROW
STA. 10+497.0, RT. - "STOP"
STA. 10+506.0, RT. - "STOP"

TEMPORARY AND DURABLE 600 mm STOP BAR
STA. 10+497.0, RT.
STA. 10+506.0, RT.

REMOVING SIGNS
AS SHOWN - 3

ERECTING SALVAGED SIGNS
AS SHOWN - 2

ARCHIVED IN DPR

NOTE: ALL DIMENSIONS IN MILLIMETERS EXCEPT WHERE OTHERWISE INDICATED

NOTES: 1) FOR ANY TOWN HIGHWAY OR STREET DETAILS, SEE VAOT STANDARD E-193.
2) ALL EXISTING SIGNS NOT SHOWN SHALL BE RETAINED AS DIRECTED BY THE RESIDENT ENGINEER.

DATUM
VERTICAL N/A
HORIZONTAL N/A

PAVING PROJECT LAYOUT #18

SURVEYED BY W-M DATE 12/95
DESIGN BY JLL/GAE DATE 11/96
DRAWN BY W-M DATE 11/96
DESIGN FILE NO. /pave/92b221/pb221.dgn
IPARM FILE pb22111B.1 DATE PLOTTED 28-SEP-2009 09
PROJ. NAME **ESSEX-UNDERHILL**
PROJ. NO. **STP 9469(1)S**
SHEET 27 OF 40 SHEETS