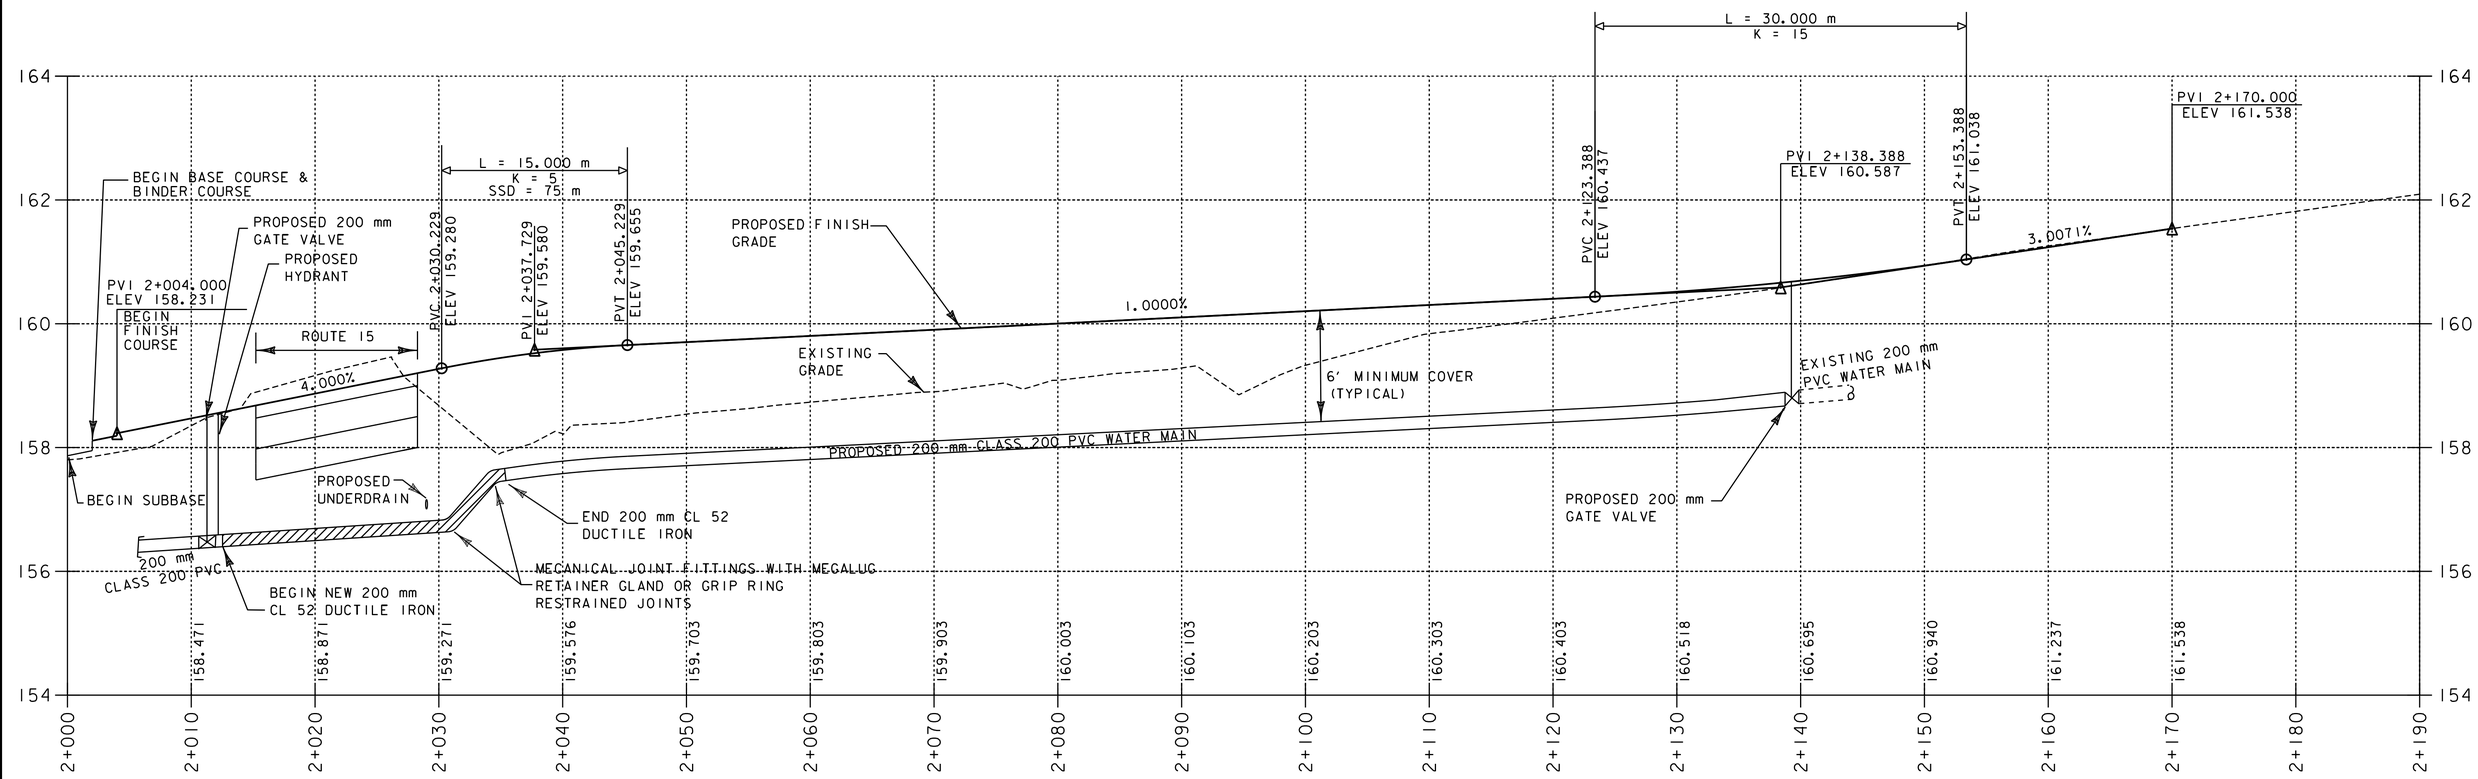

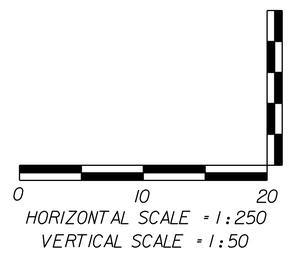

OLD STAGE ROAD PROFILE

PROJECT NAME: ESSEX
PROJECT NUMBER: STP 030-1(17)S

PLOT FILE NAME: zstp030-1(17)swrk8.dgn
L&D PROJECT NUMBER: 00-074
DESIGNED BY: LAMOUREUX & DICKINSON CONSULTING ENGINEERS, INC.
DRAWN BY: PLC
CHECKED BY: RJD
SHEET 11