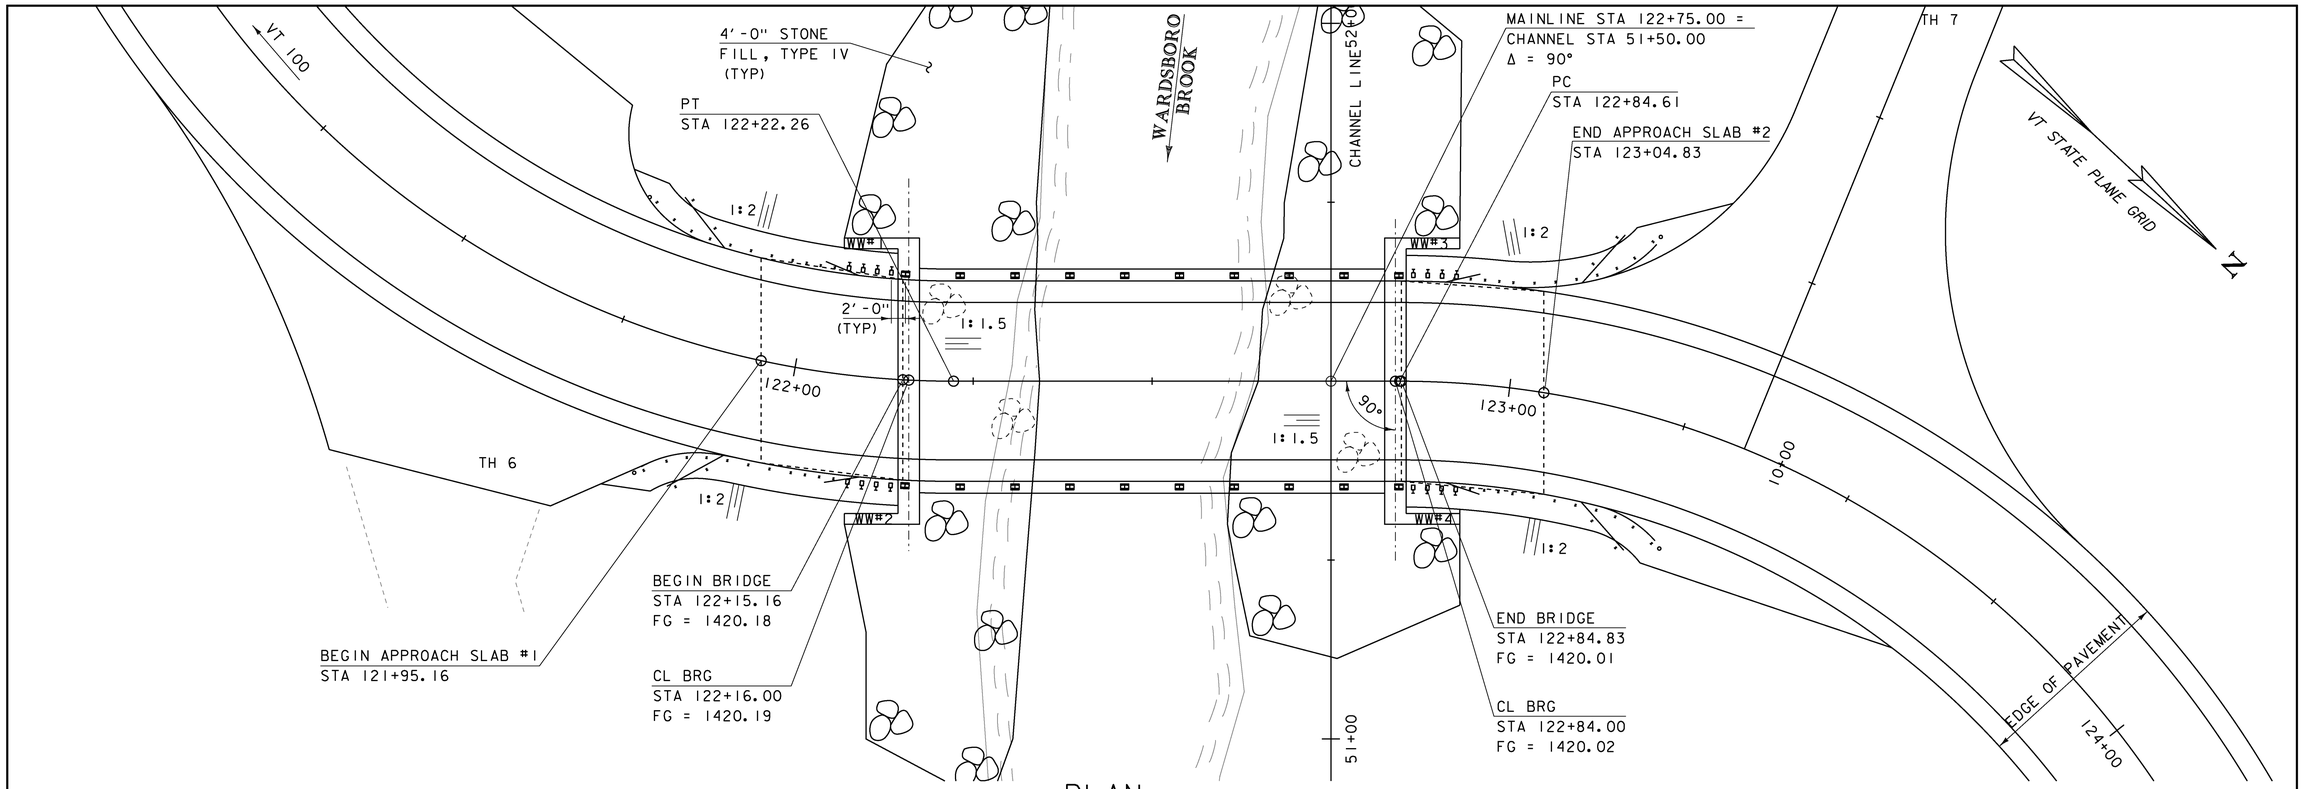

PLAN

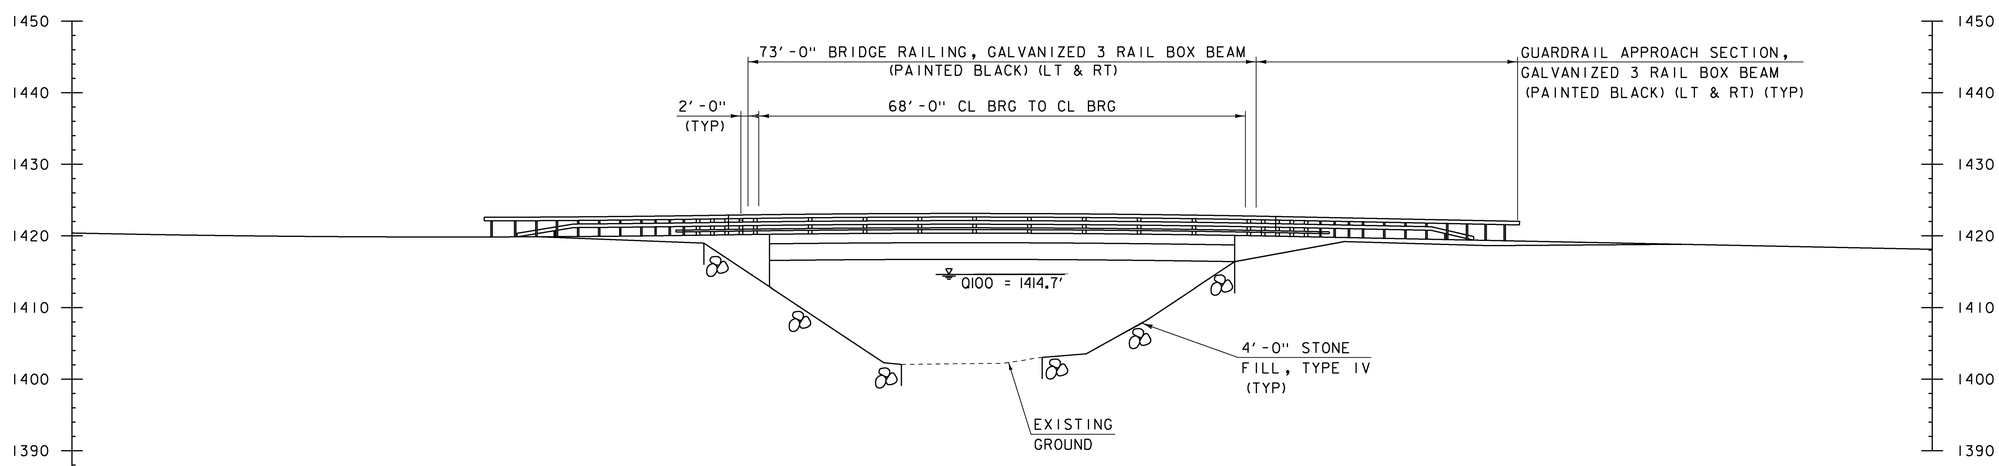

ELEVATION

SCALE 1" = 10'-0"
10 0 10

PROJECT NAME: WARDSBORO	
PROJECT NUMBER: BRF 013-1(15)	
FILE NAME: s92b283pe.dgn	PLOT DATE: 15-JUL-2015
PROJECT LEADER: C. CARLSON	DRAWN BY: R. PELLETT
DESIGNED BY: D. PETERSON	CHECKED BY: D. PETERSON
PLAN AND ELEVATION	SHEET 24 OF 51