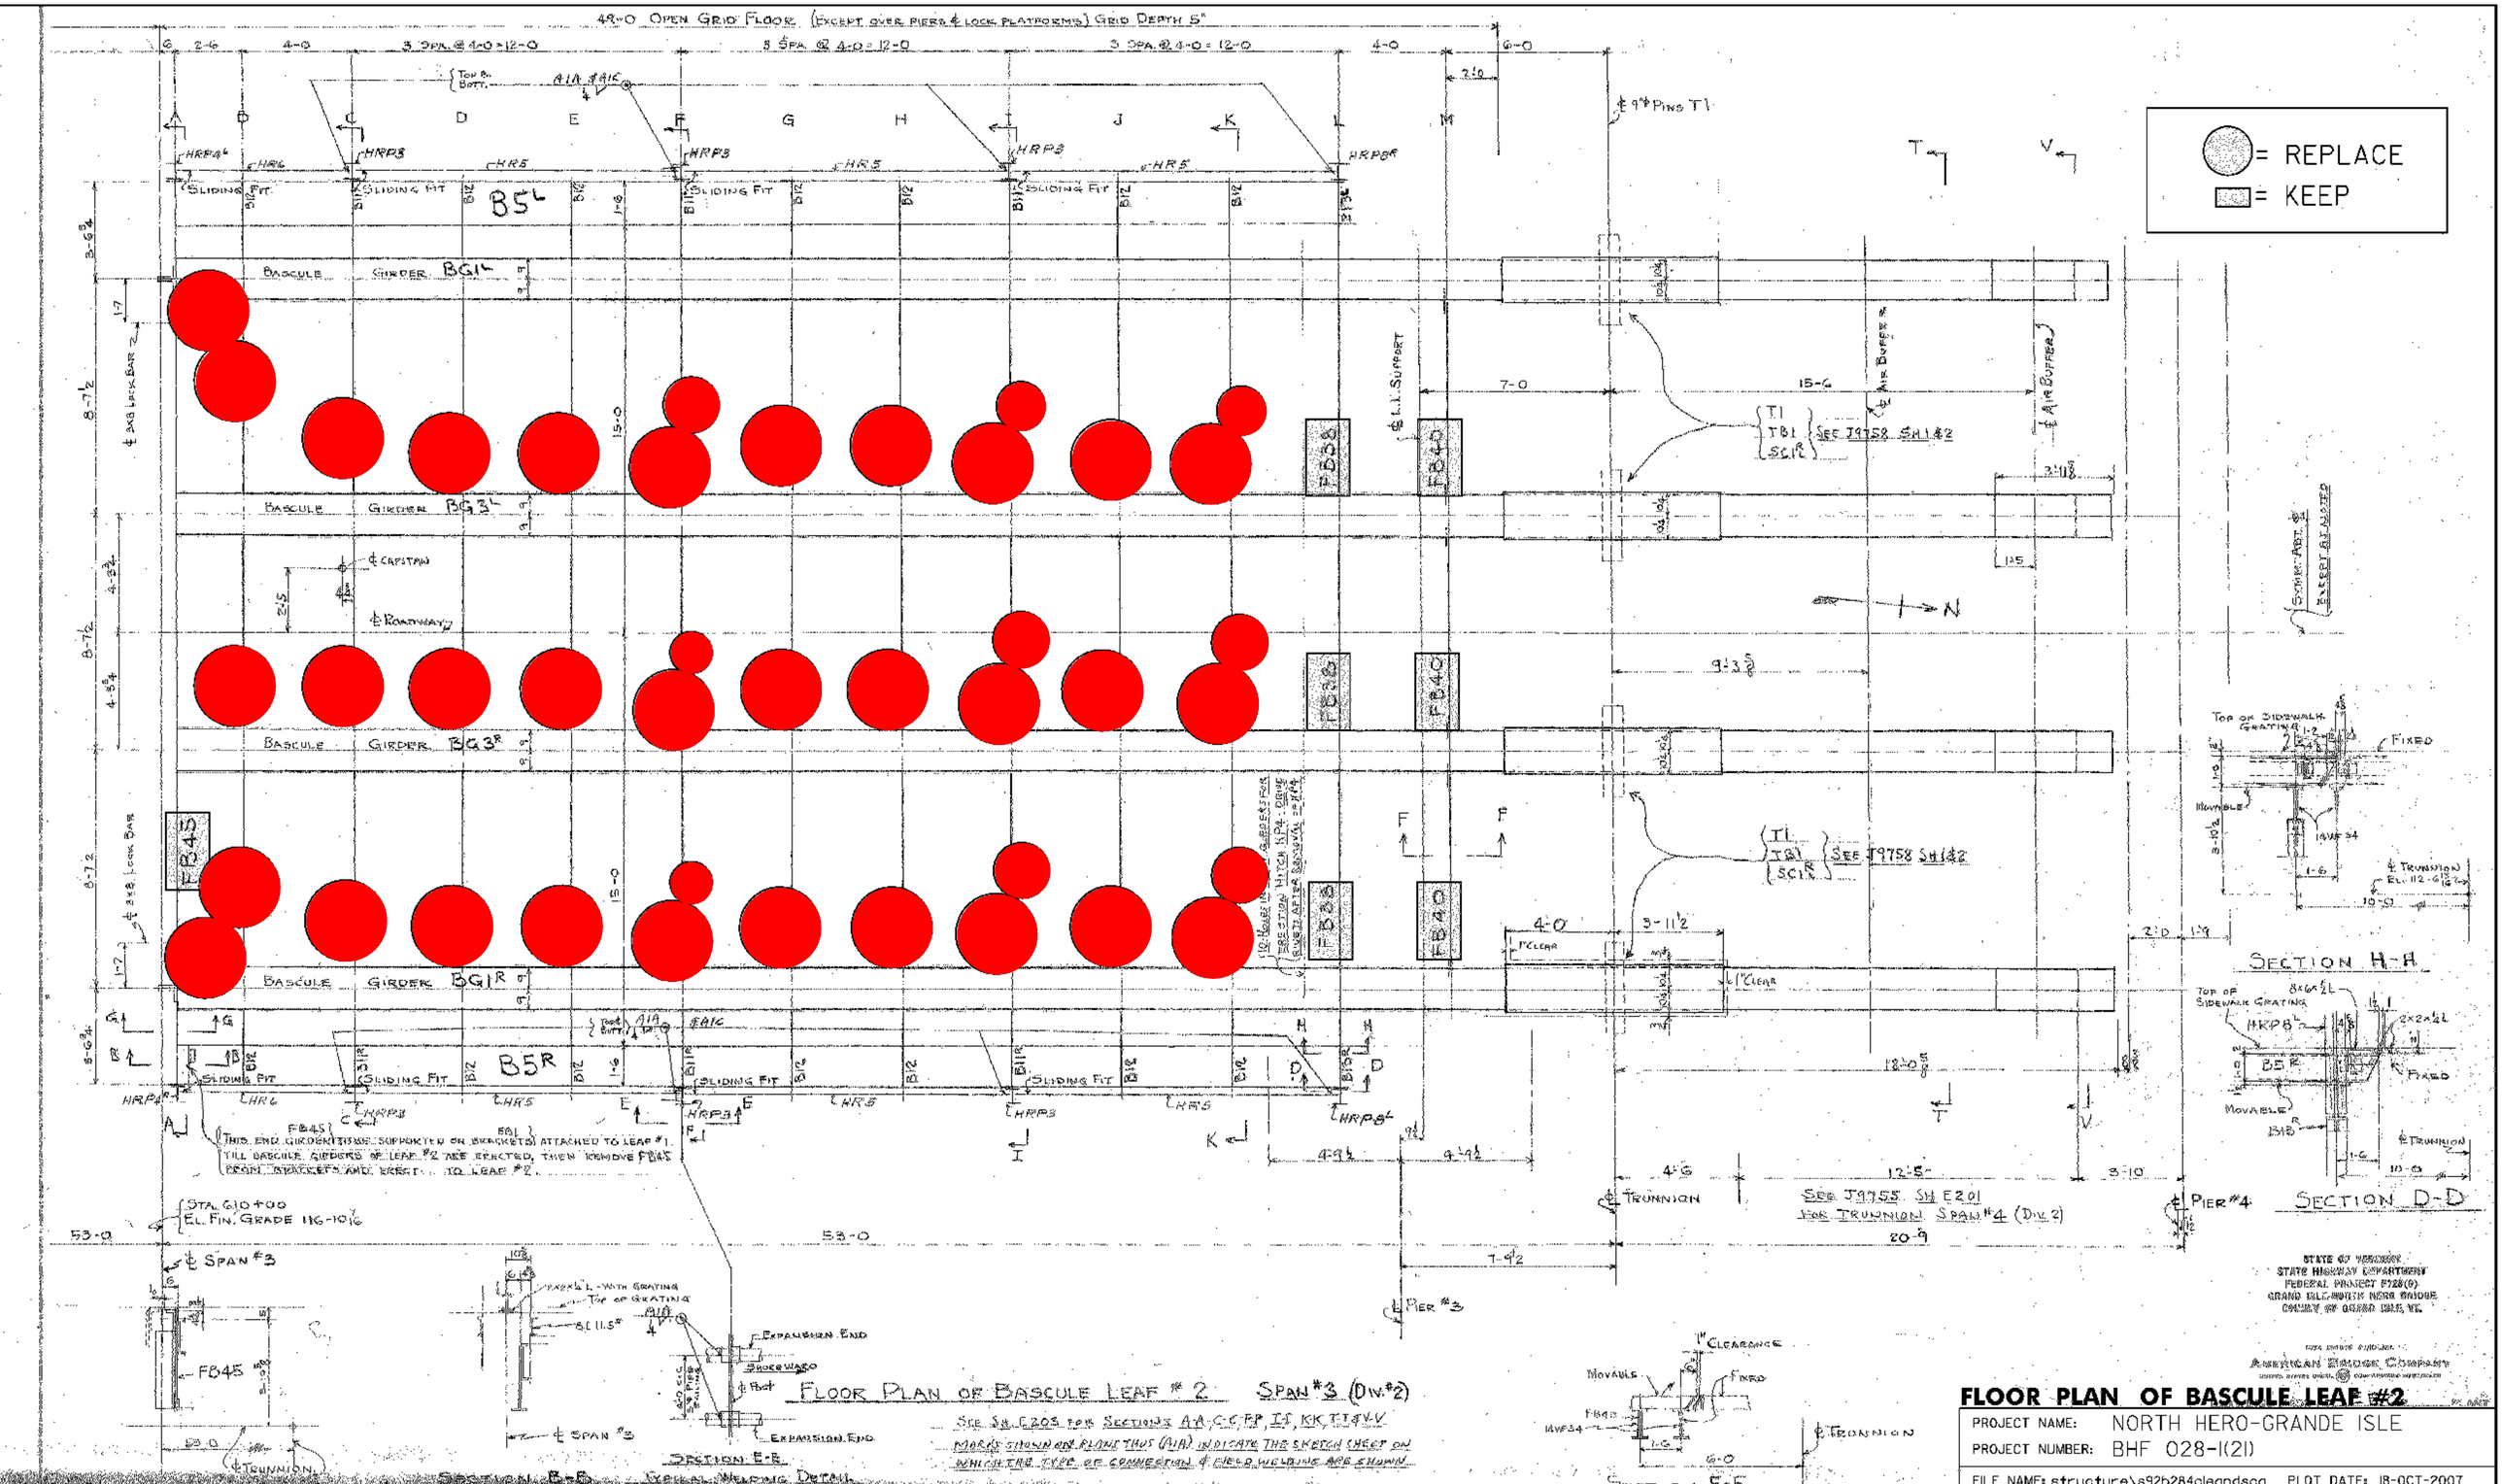

FLOOR PLAN OF BASCULE LEAF #2 SPAN #3 (DW. #2)

SEE SH. E203 FOR SECTIONS AA, C-C, FF, II, KK, TT & V-V

MARKS SHOWN ON PLANS THUS (AIA) INDICATE THE SKETCH SHEET ON WHICH THE TYPE OF CONNECTION & FIELD WELDING ARE SHOWN

FLOOR PLAN OF BASCULE LEAF #2

PROJECT NAME: NORTH HERO-GRANDE ISLE	
PROJECT NUMBER: BHF 028-1(21)	
FILE NAME: structure\s92b284cleandsca	PLOT DATE: 18-OCT-2007
PROJECT LEADER: M. EVANS-MONGEON	DRAWN BY: L. DUQUETTE
DESIGNED BY: S. SCRIBNER	CHECKED BY: S. SCRIBNER
	SHEET 11 OF 41