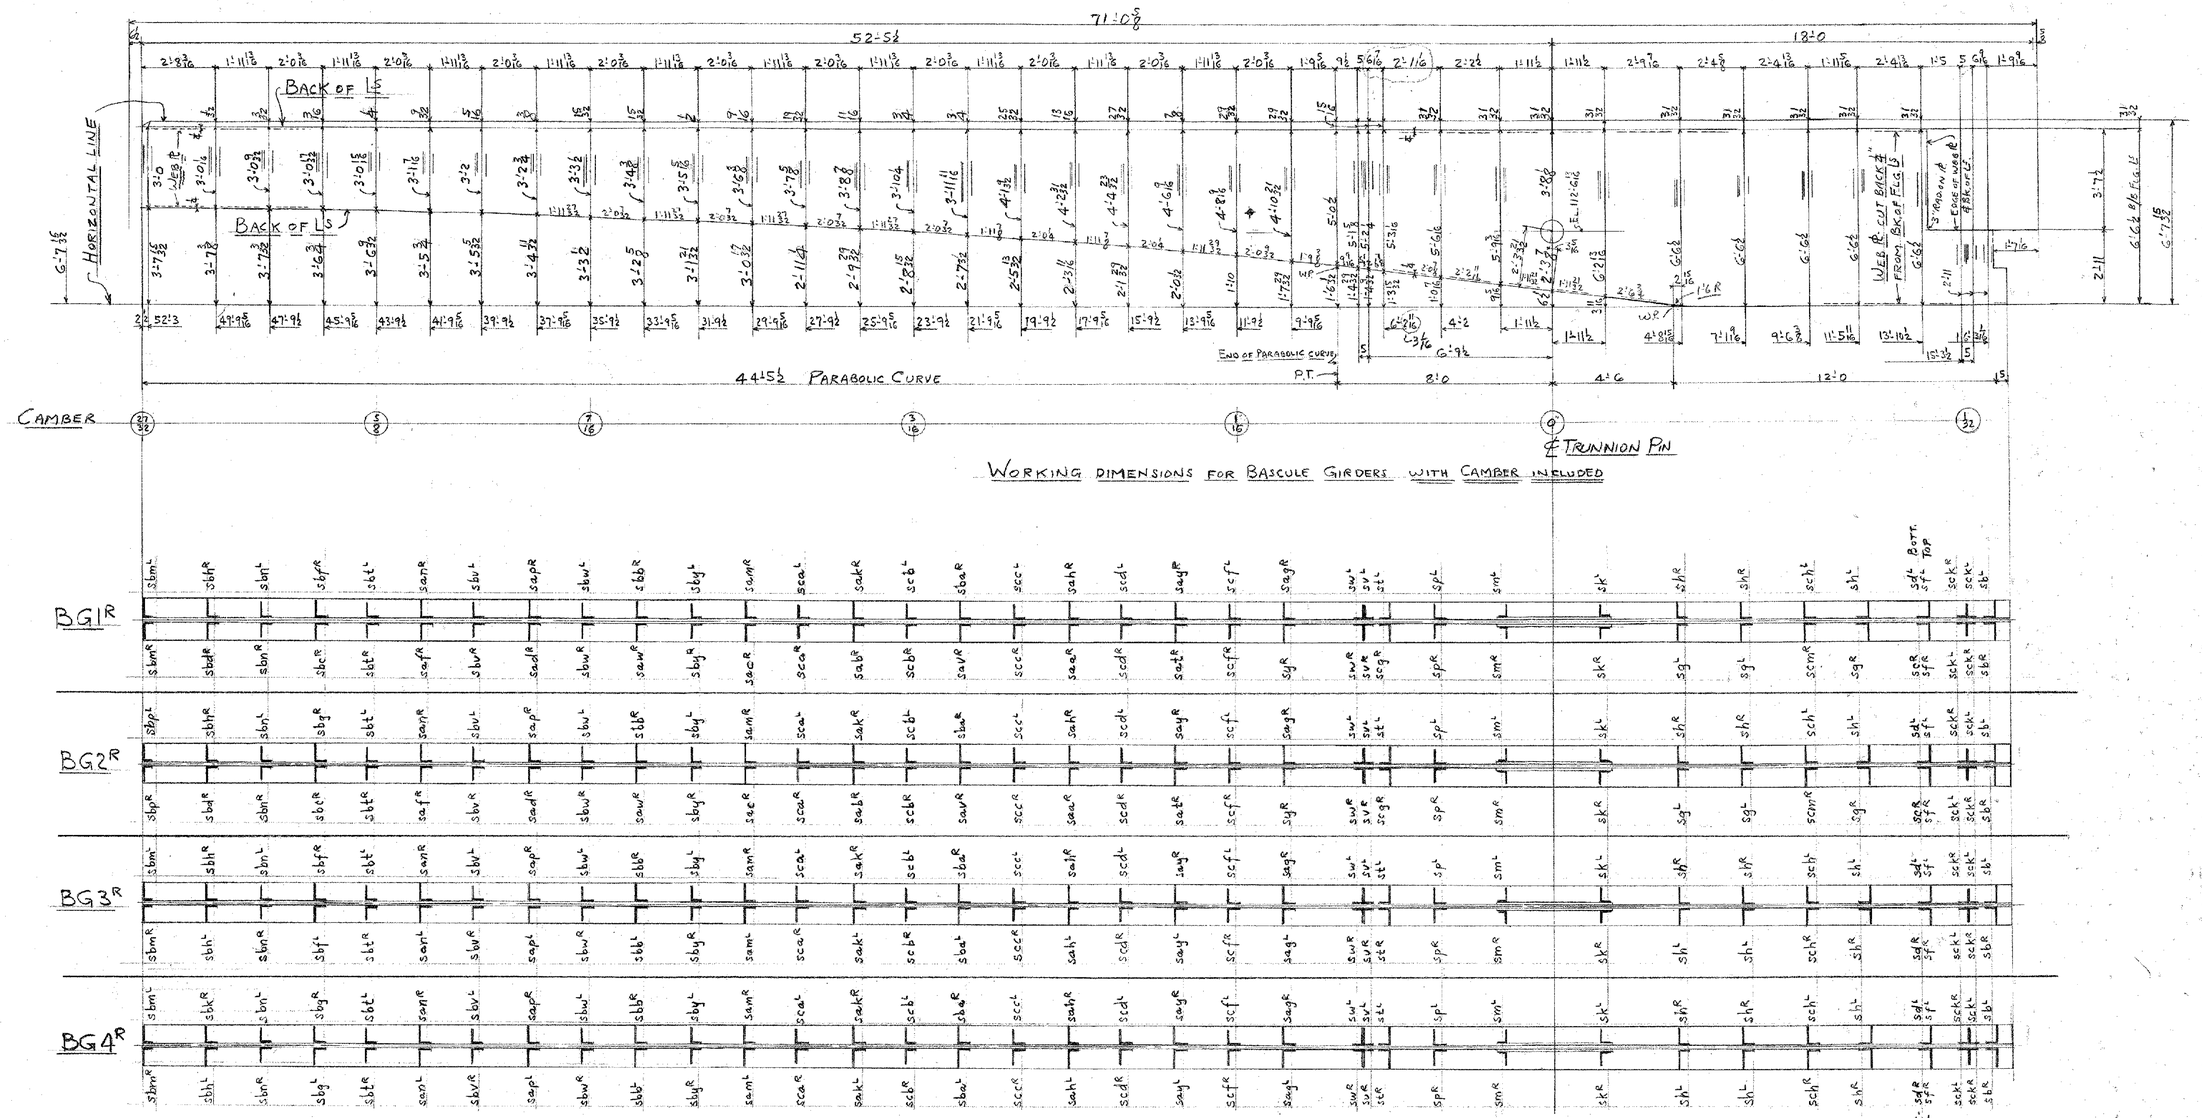

WORKING DIMENSIONS FOR BASCULE GIRDERS WITH CAMBER INCLUDED

BOTTOM FLANGES OF GIRDERS SHOWING STIFFENERS

STATE OF VERMONT
STATE HIGHWAY DEPARTMENT
FEDERAL PROJECT F128(9)
GRAND ISLE-NORTH HERO BRIDGE
COUNTY OF GRAND ISLE, VT.

GIRDERS BG1R-BG2R BG3R & BG4R

AMERICAN BRIDGE COMPANY
UNITED STATES STEEL

REFERENCE SHEET

PROJECT NAME: NORTH HERO-GRANDE ISLE
PROJECT NUMBER: BHF 028-1(21)

FILE NAME: structure\s92b284cleandsca
PROJECT LEADER: M. EVANS-MONGEON
DESIGNED BY: S. SCRIBNER

PLOT DATE: 18-OCT-2007
DRAWN BY: L. DUQUETTE
CHECKED BY: S. SCRIBNER
SHEET 30 OF 41