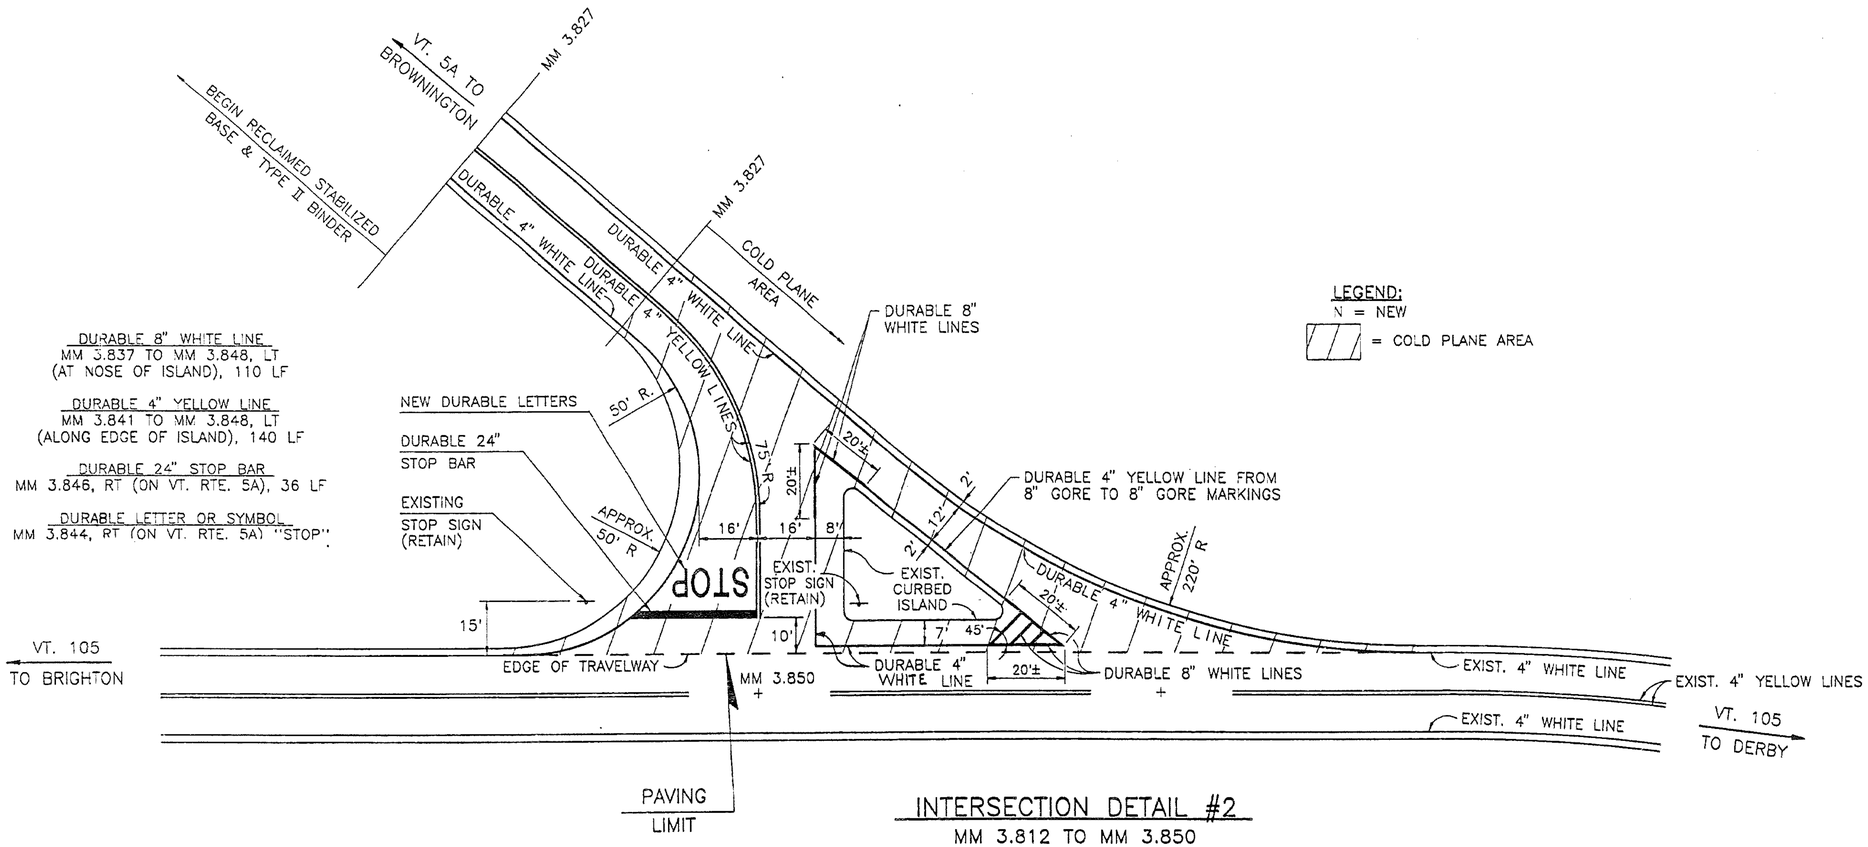

INTERSECTION DETAIL #2

MM 3.812 TO MM 3.850

SCALE: 1" = 20'

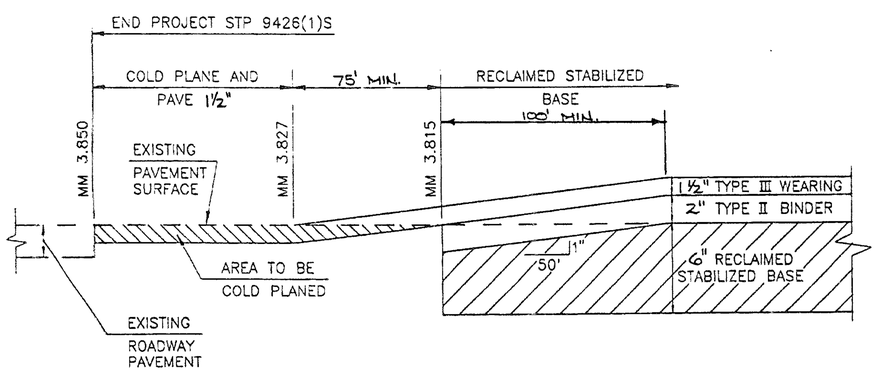

RECLAIMED STABILIZED BASE TRANSITION DETAIL

NOT TO SCALE

DATUM
VERTICAL N/A
HORIZONTAL N/A

INTERSECTION DETAIL SHEET

HTA FILE: BRNINTS2

SURVEYED BY N/A DATE N/A
DRAWN BY WBL DATE 03/93
SQUAD LEADER
DESIGN FILE NO.
IPARM FILE DATE PLOTTED
PROJ. NAME BROWNINGTON-CHARLESTON
PROJ. NO. STP 9426(1)S
SHEET 10 OF SHEETS