VAOT Metric

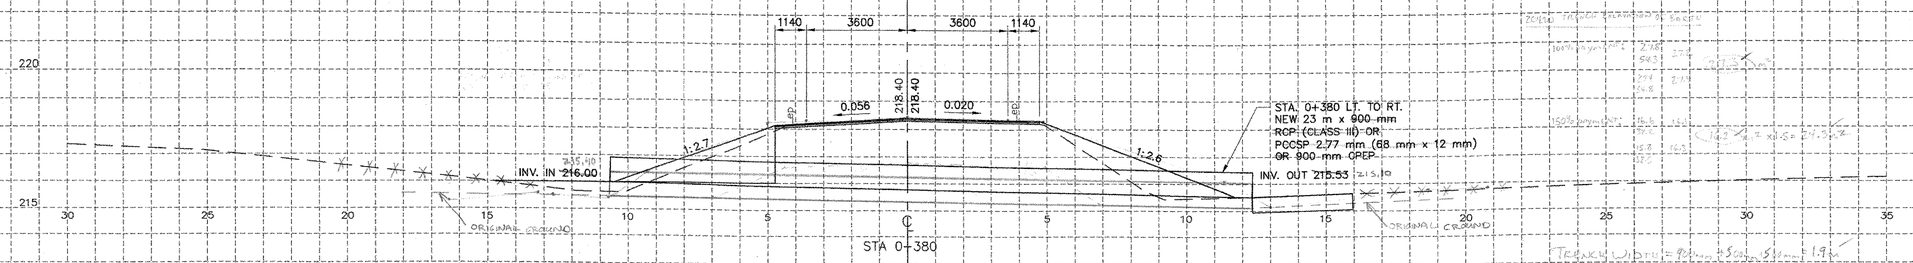

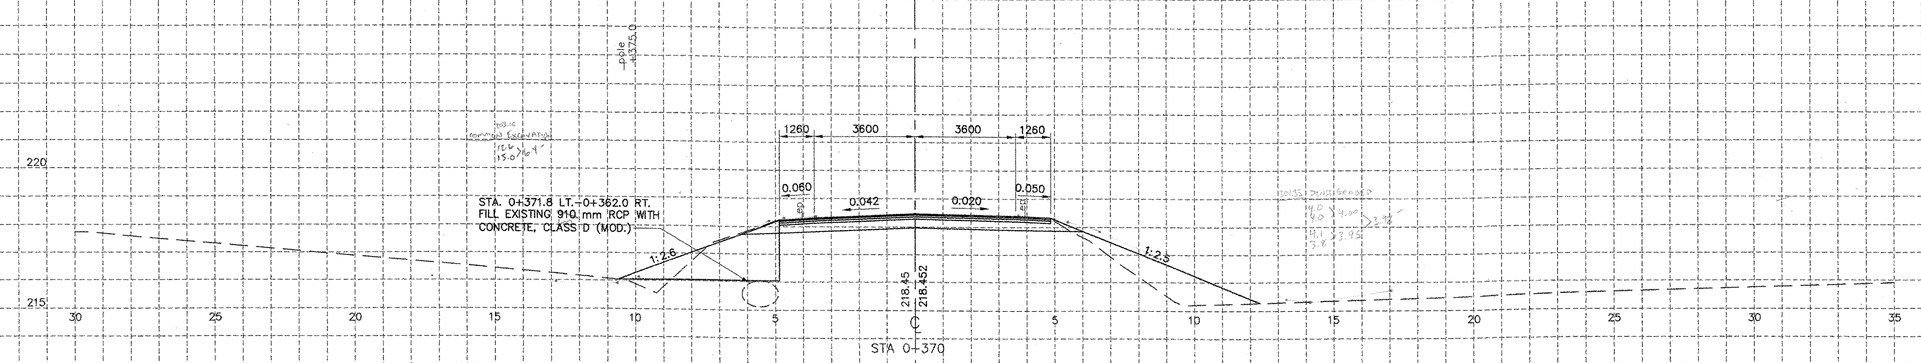

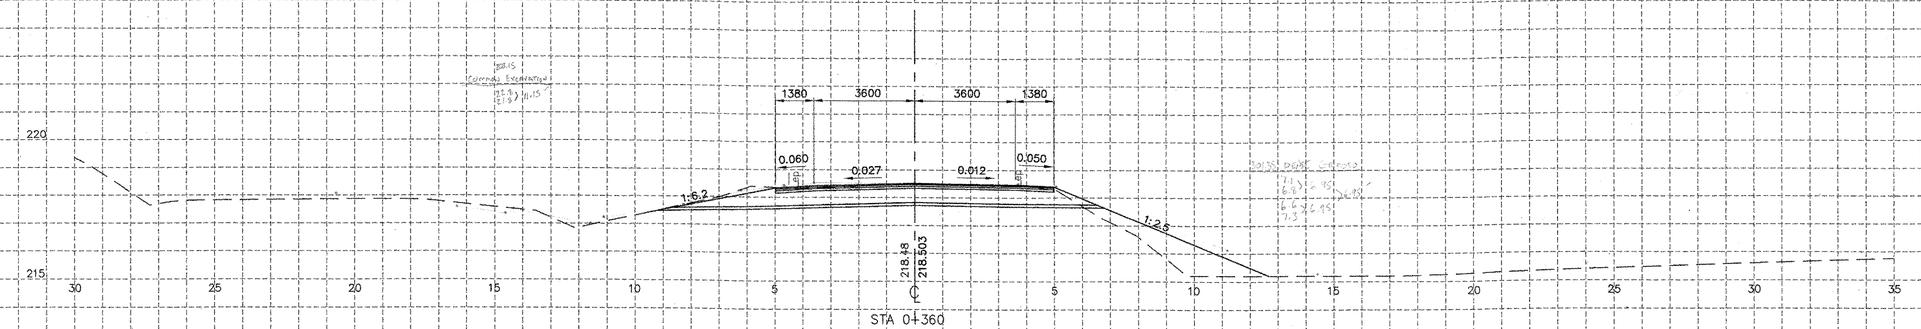

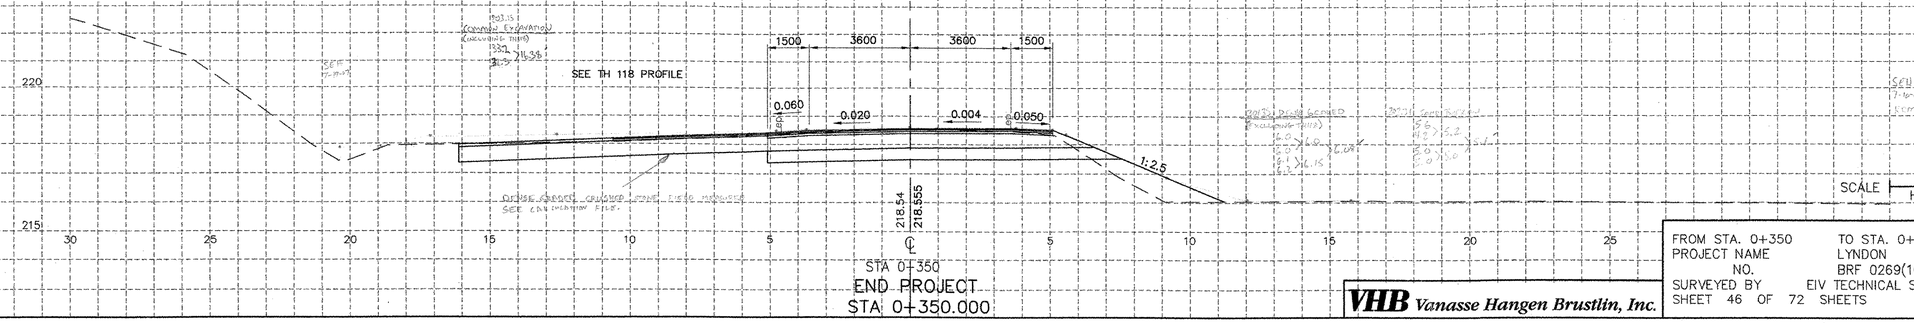

SCALE 5 METERS HORZ. & VERT.

VHB Vanasse Hangen Brustlin, Inc.

FROM STA. 0+350	TO STA. 0+380	VT 114
PROJECT NAME	LYNDON	
NO.	BRF 0269(10)	
SURVEYED BY	EIV TECHNICAL SERVICES, LLC 11/95	
SHEET 46 OF 72 SHEETS		

50544XS PLOTTED 3-14-2006